

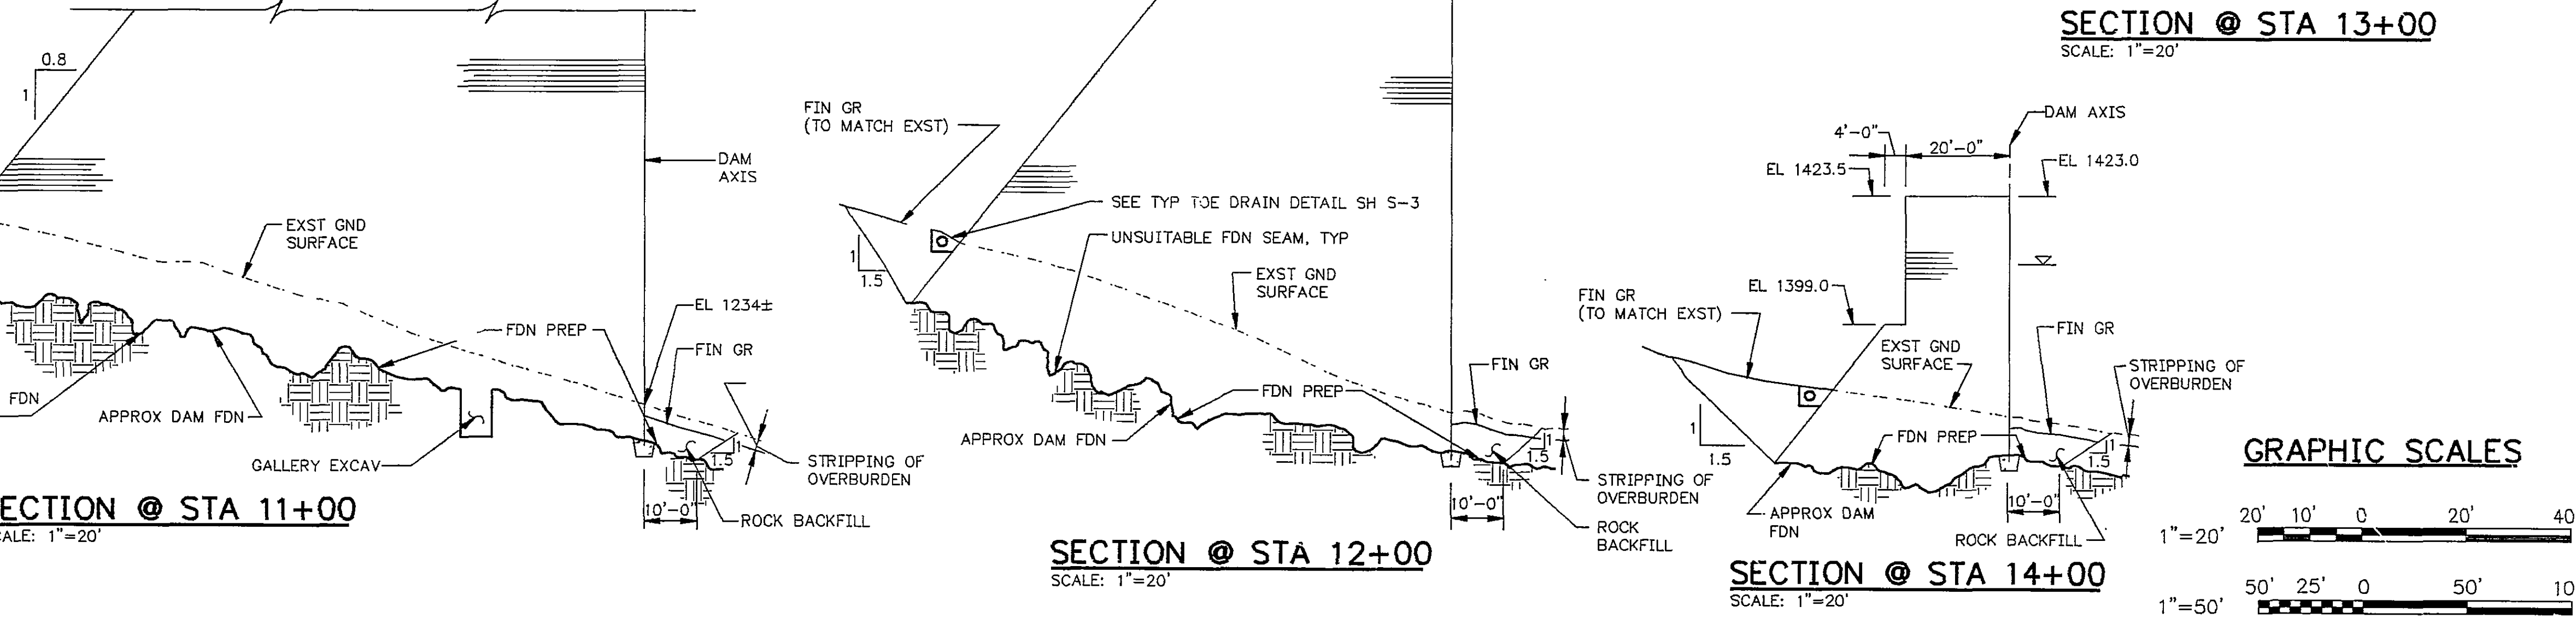
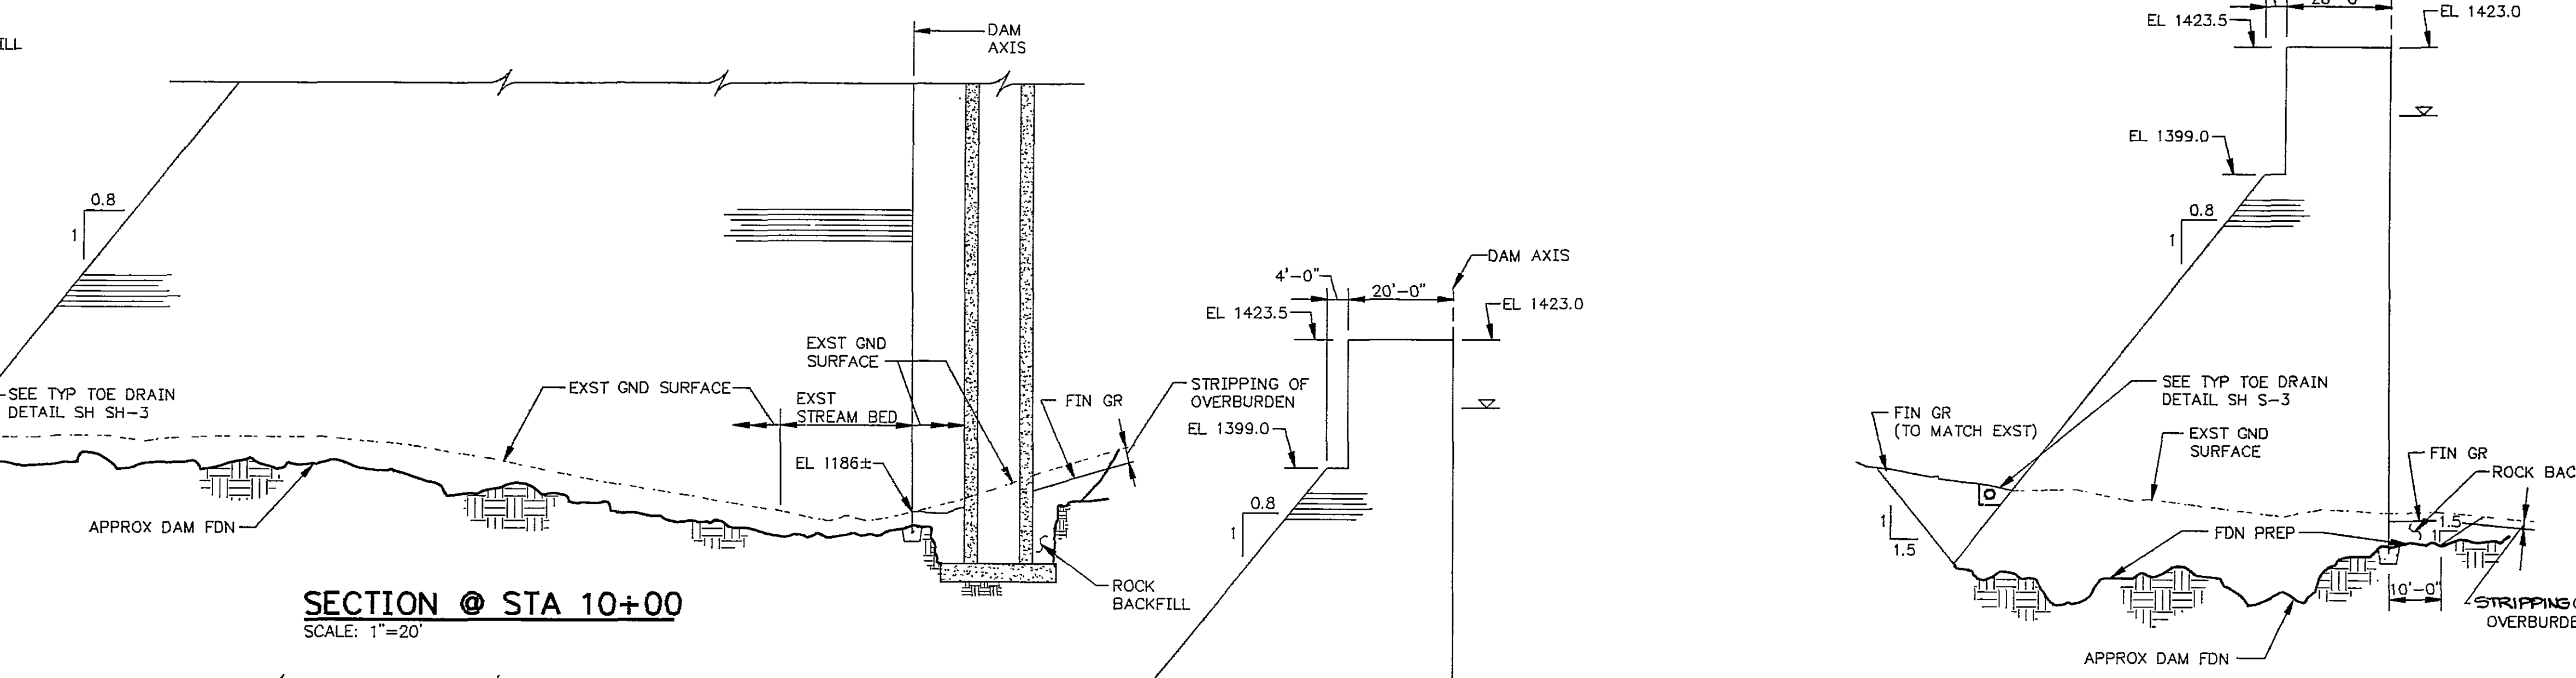
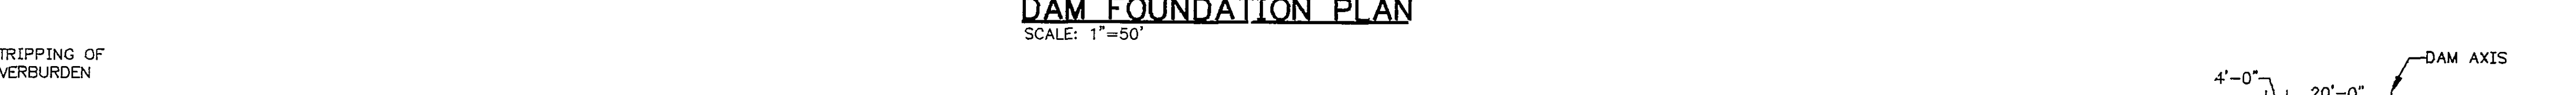
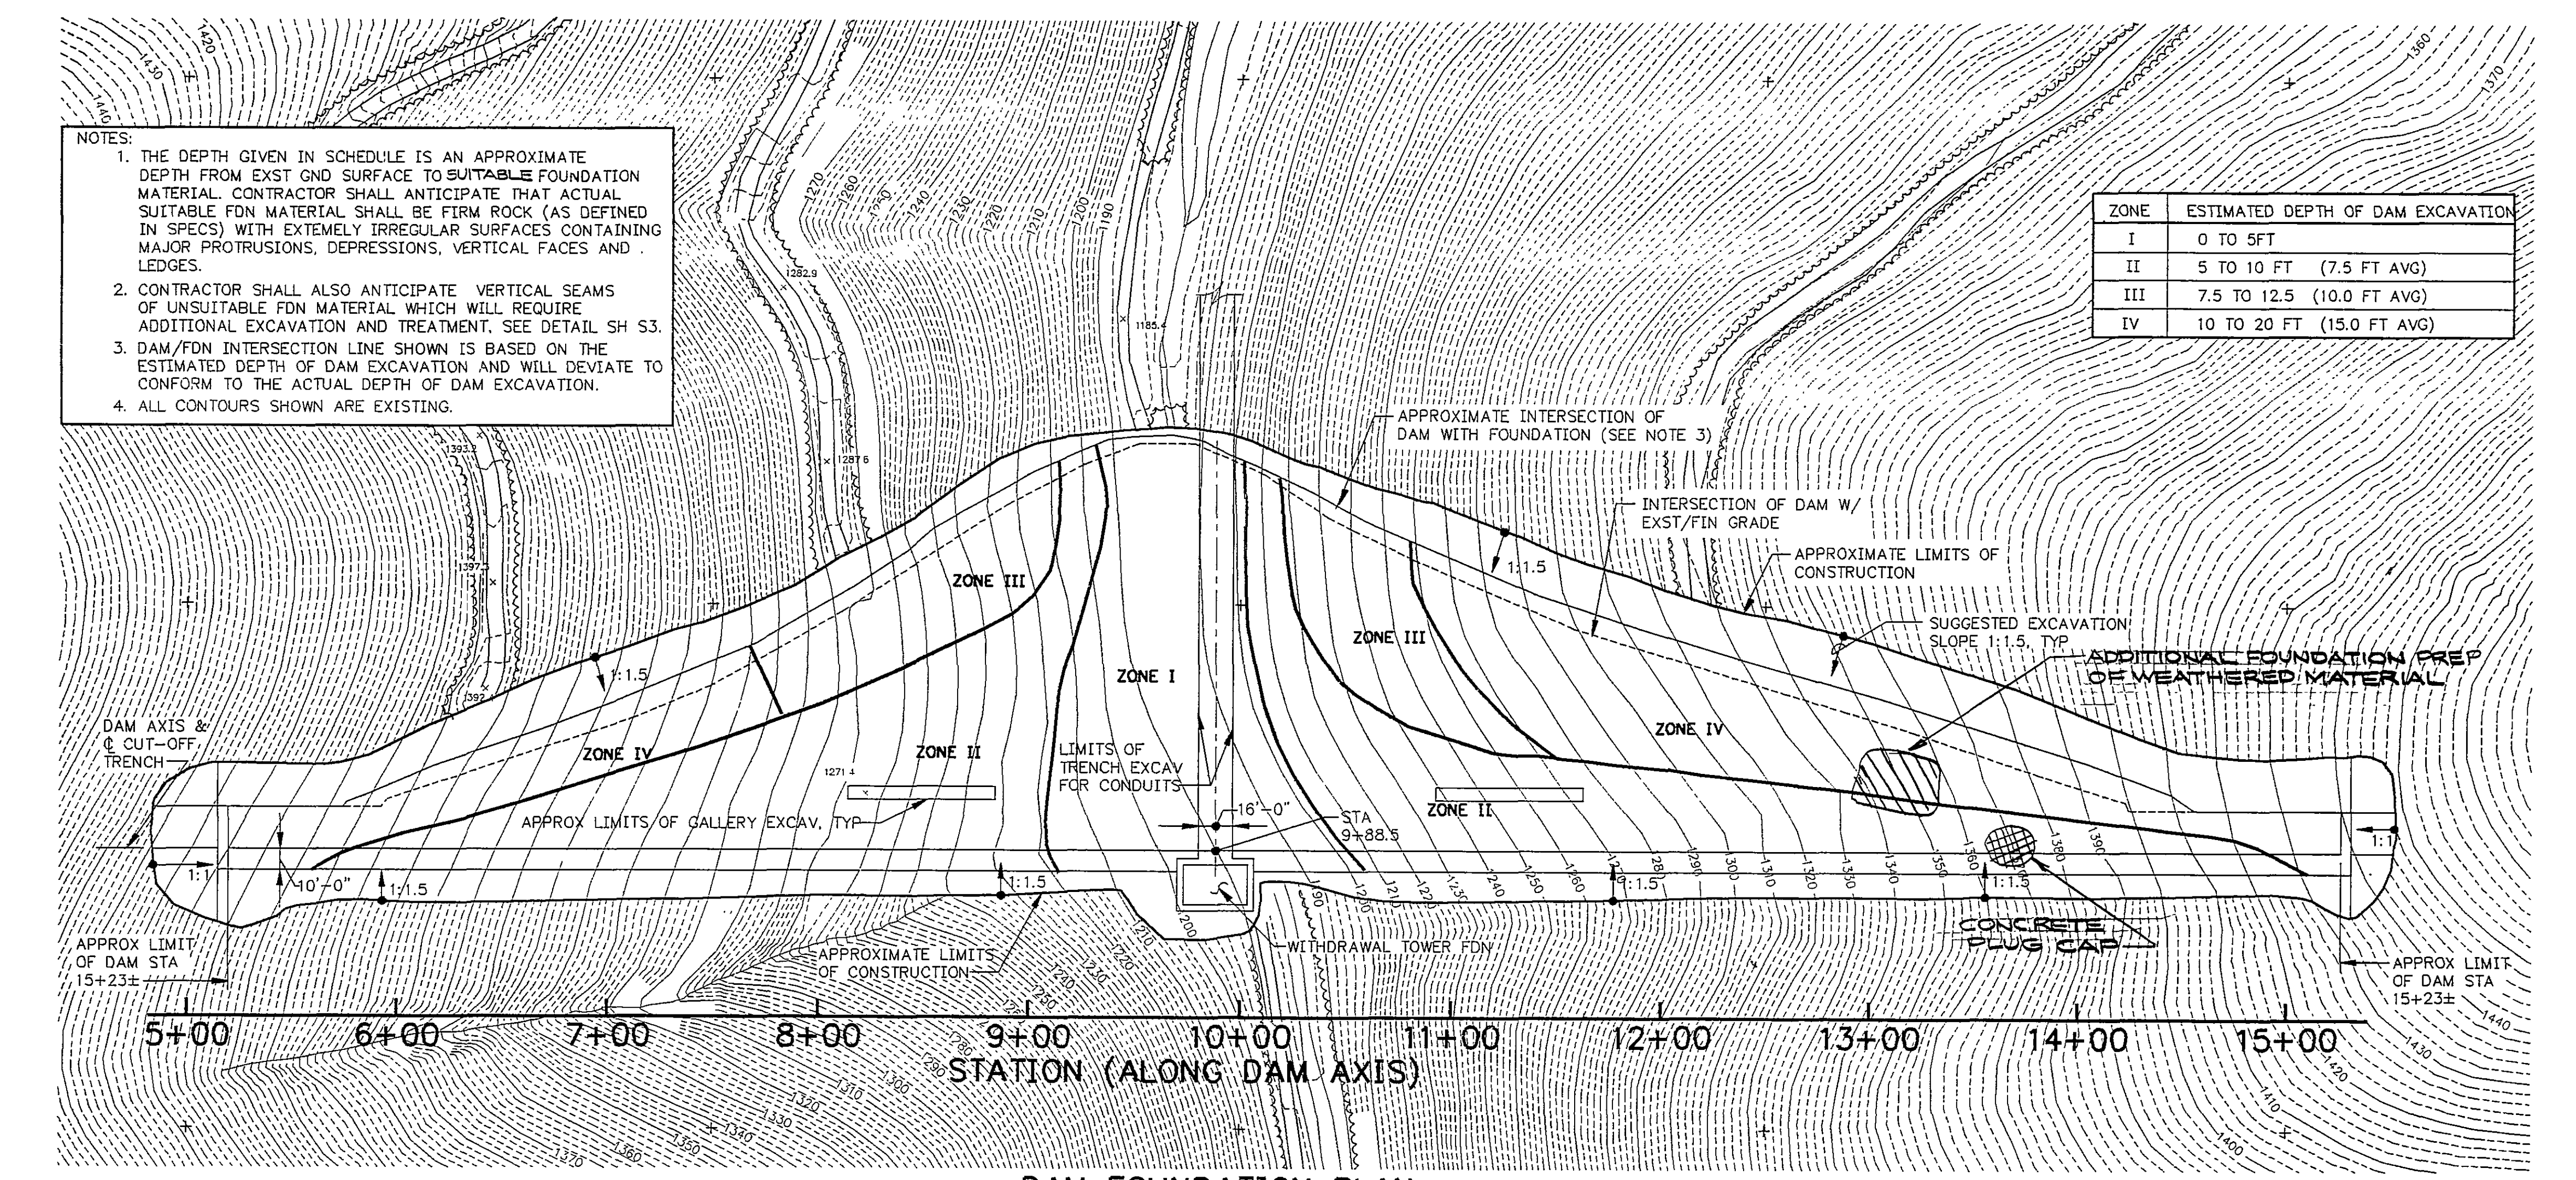
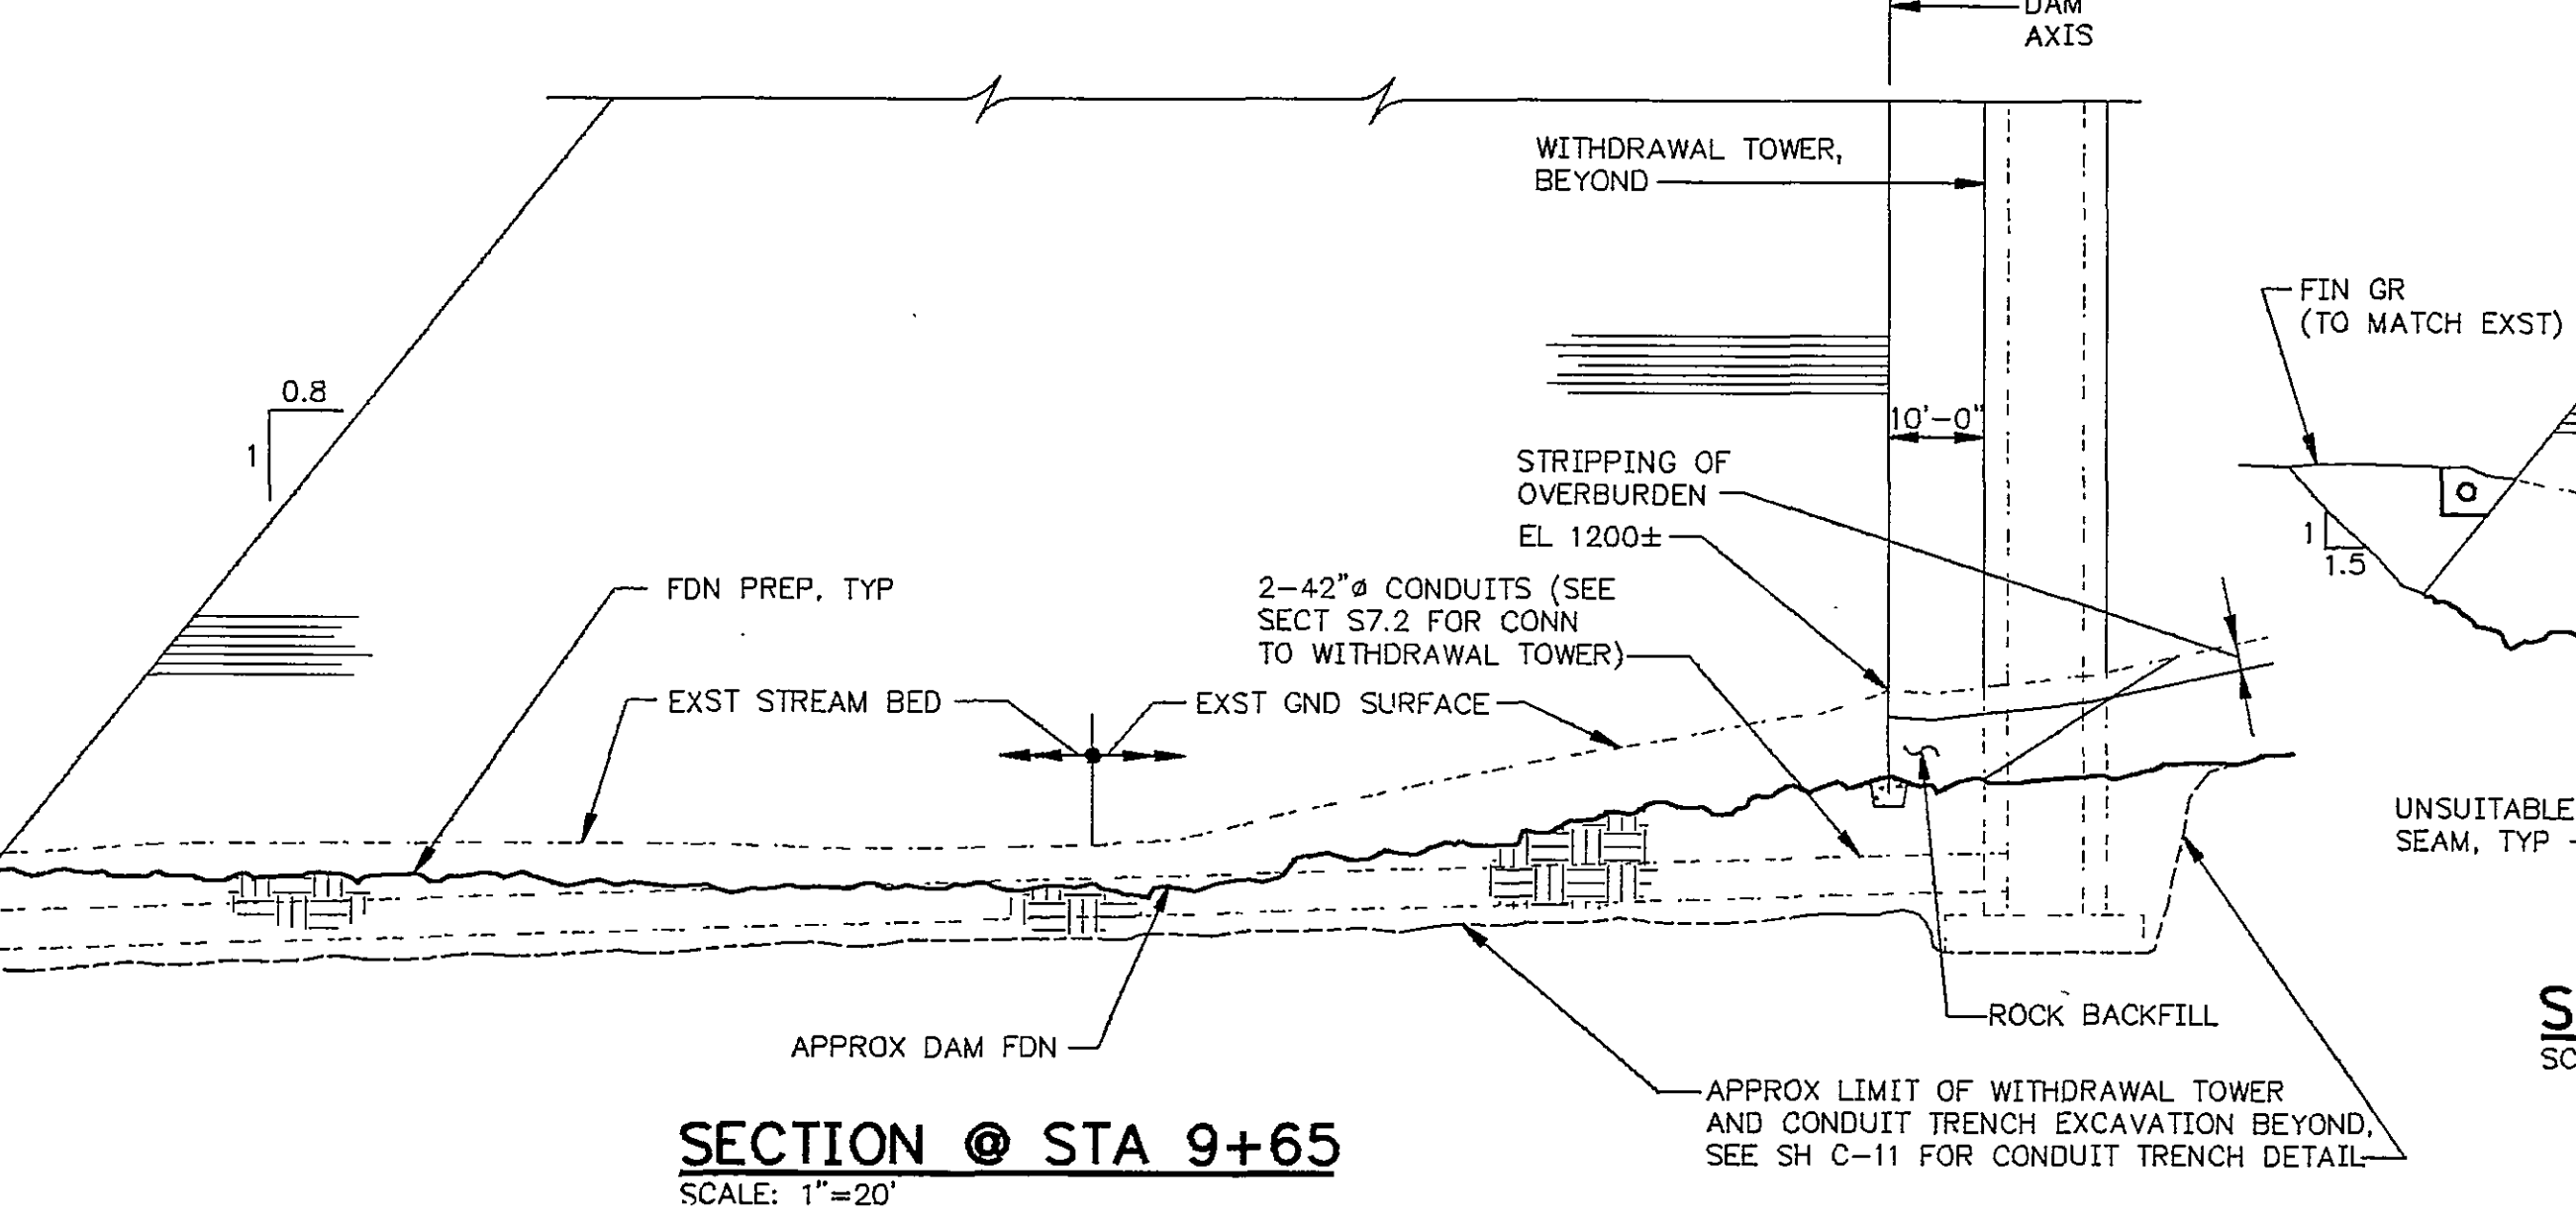
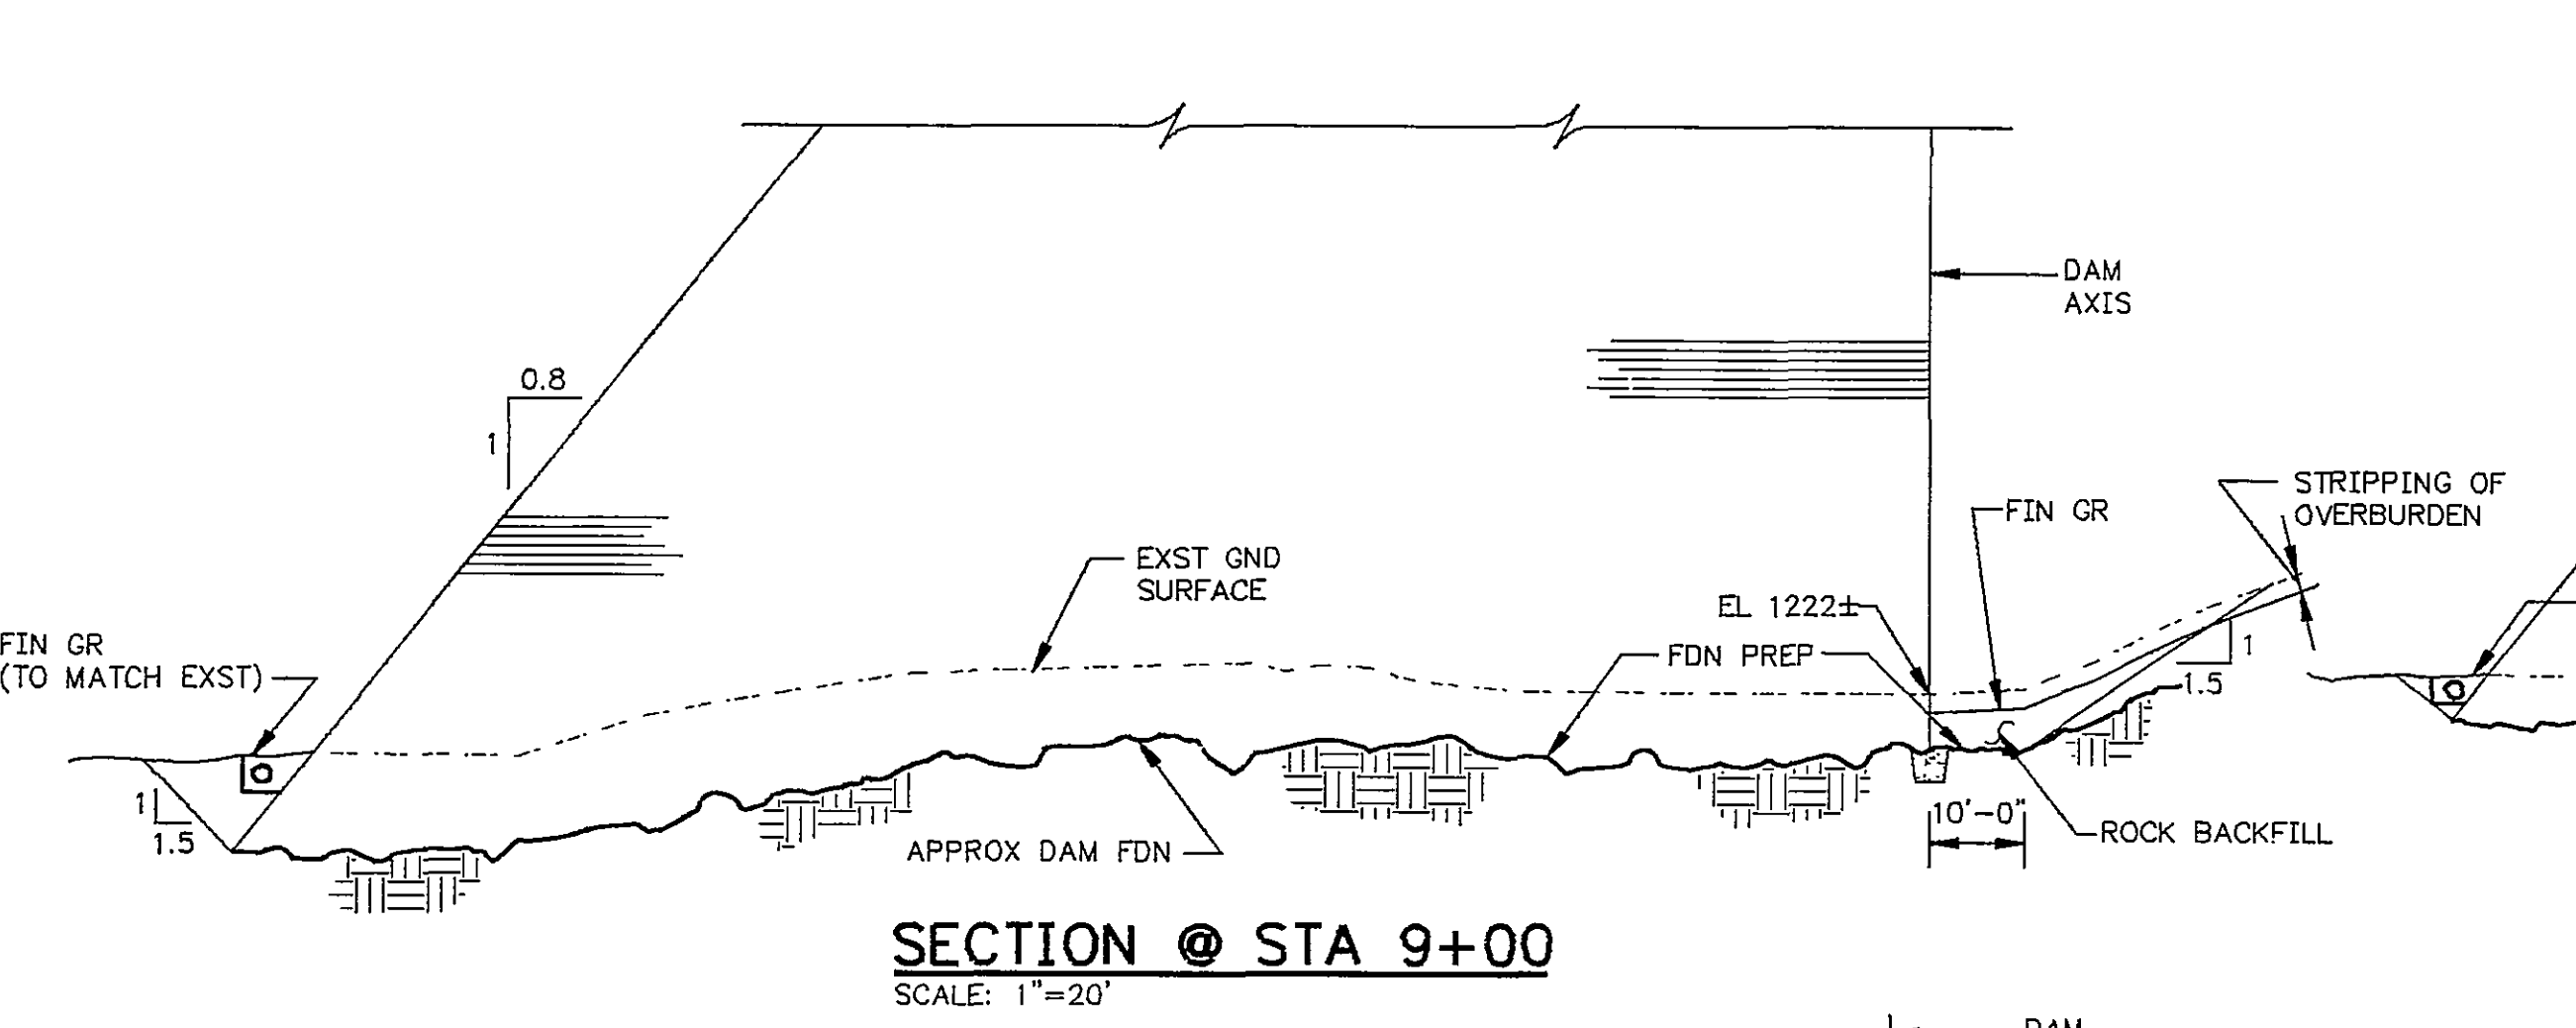
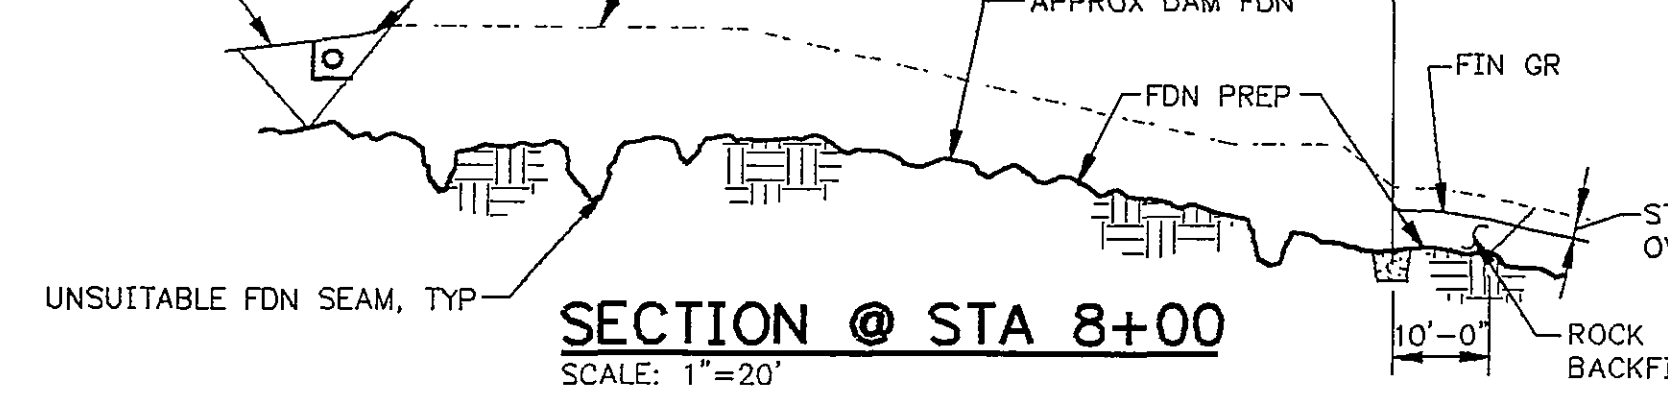
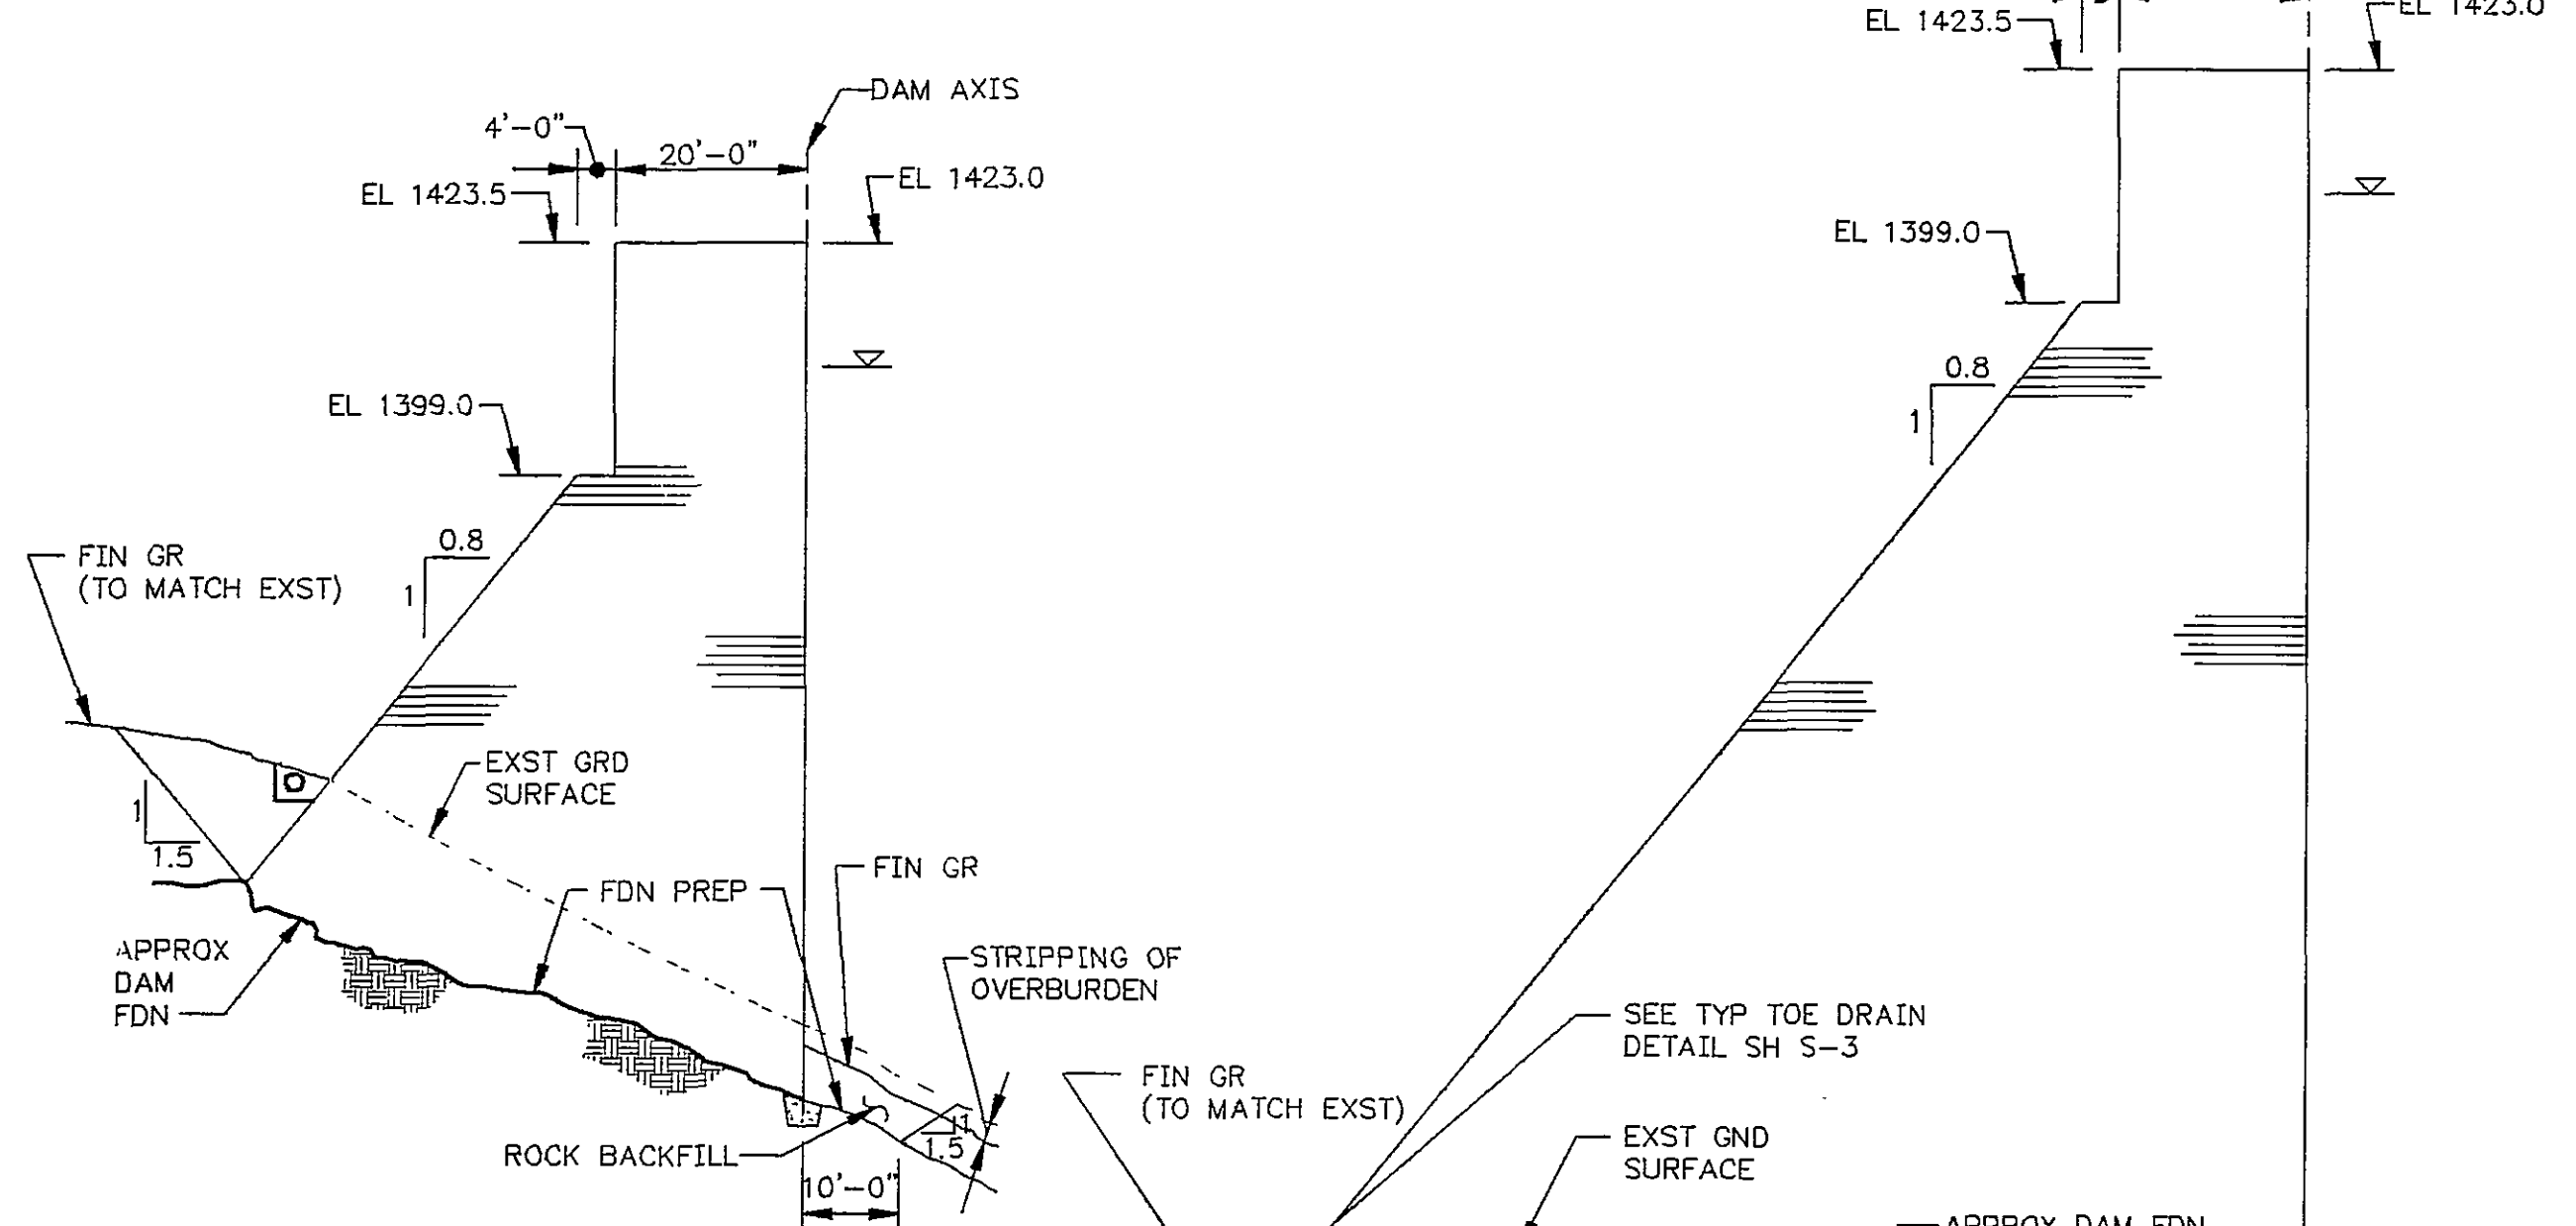
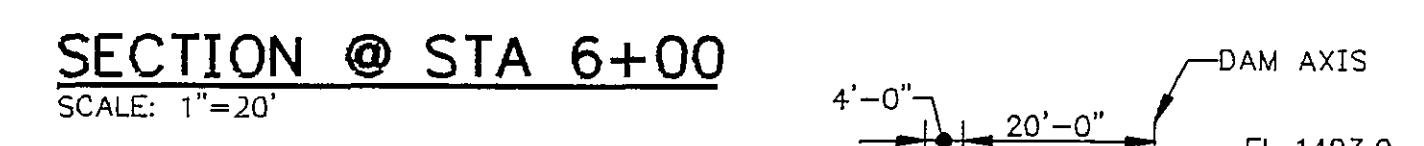
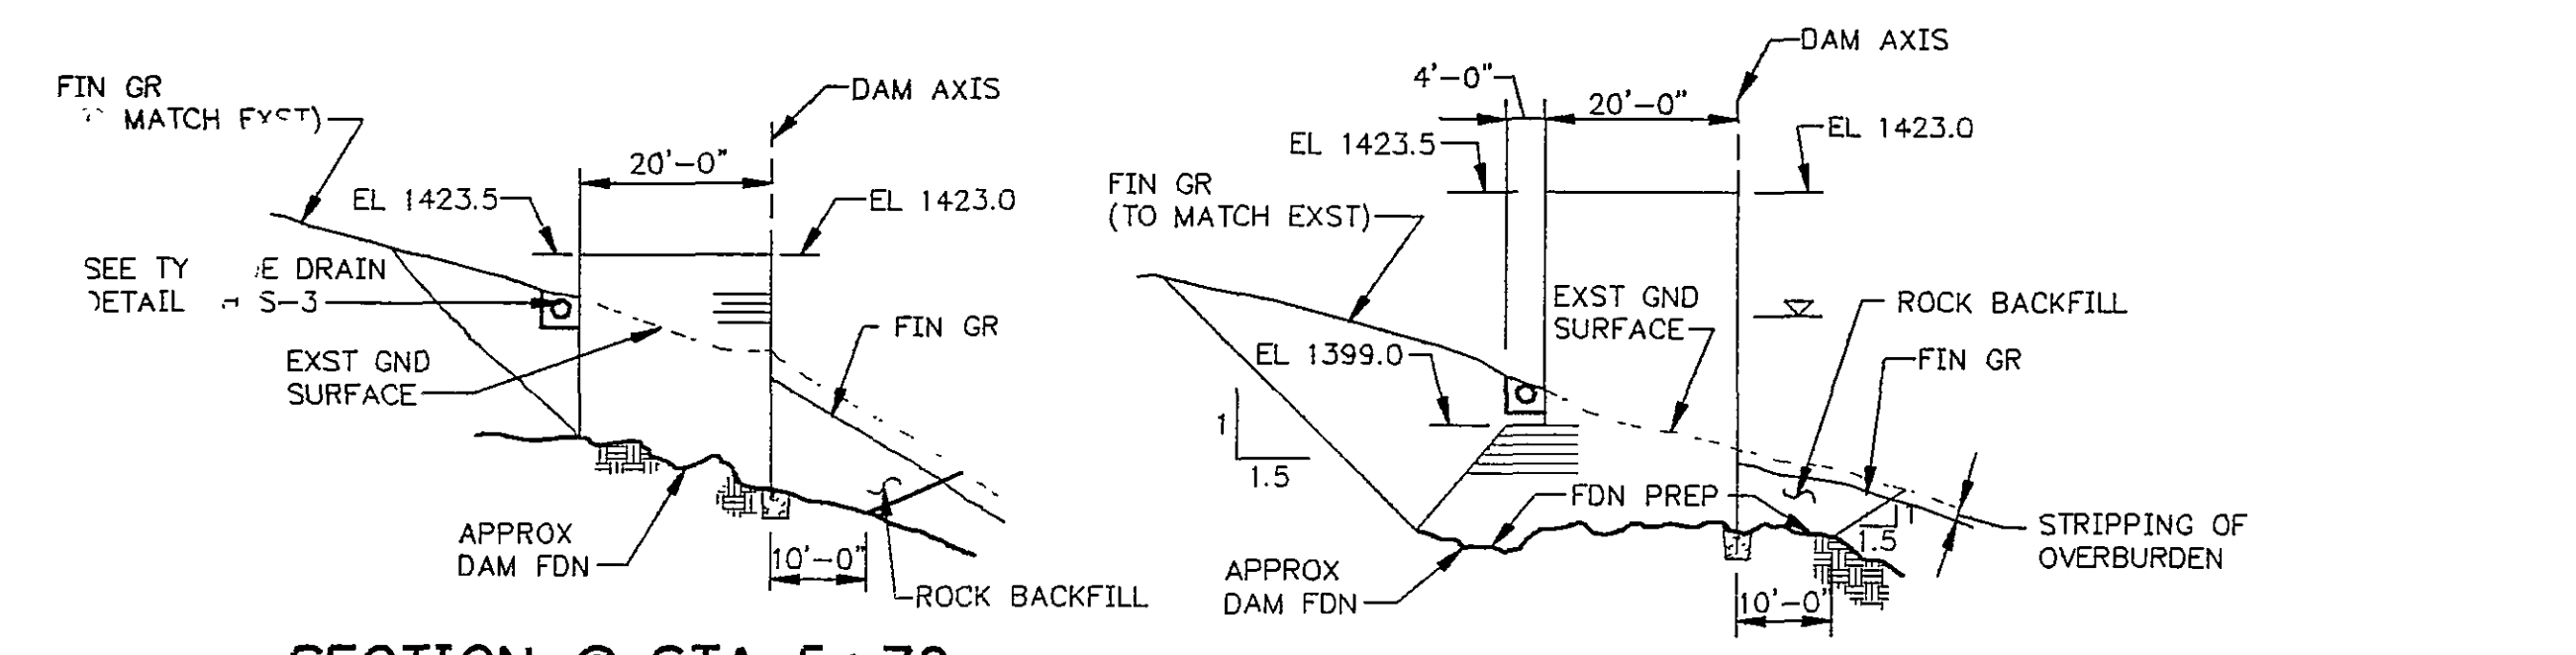


DESIGNED	LA, RWF, G	DATE	4/26/91
DRAWN	DAB	DATE	4/26/91
CHECKED	HWP	DATE	4/26/91
APPROVED	BY	DATE	4/26/91
ISSUED	APB	DATE	8/21/91

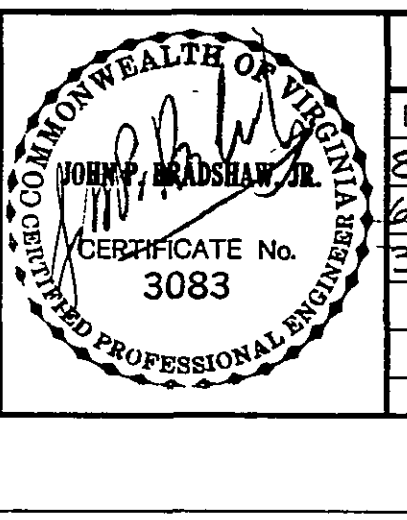

DATE	BY	DESCRIPTION	DATE	BY	DESCRIPTION
8-15-94	BA	PER CONTR RECORD DWG			
12-25-94	JBH	ISSUED TO VA. DAM SAFETY			
3-31-97	RWF	RECORD DRAWING			

RECORD DRAWINGS
 THESE DRAWINGS RECORDED ON THE BASIS OF INFORMATION FURNISHED BY THE CONTRACTOR OR SPECIFICALLY KNOWN TO HSM. NO OTHER REPRESENTATIONS ARE MADE OR IMPLIED.
 Date: 6-5-95

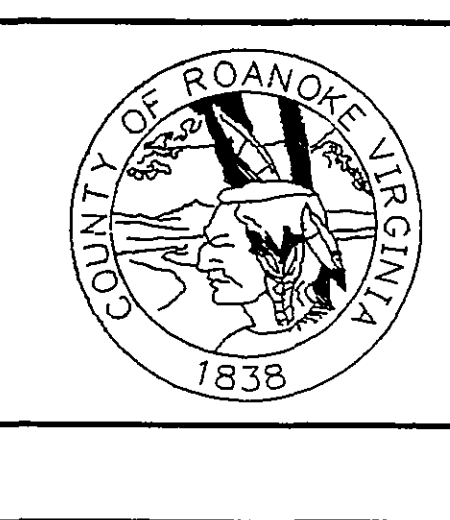

SPRING HOLLOW RESERVOIR
ROANOKE COUNTY, VIRGINIA
 HAYES, SEAY, MATTERN & MATTERN, INC.
 ARCHITECTS - ENGINEERS - PLANNERS
 ROANOKE, VIRGINIA

STRUCTURAL DAM FOUNDATION PLAN AND SECTIONS				
SCALE	DATE	COMM	SHEET	DWG
AS NOTED	8/4/91	4194E	S-2	31