

WITHDRAWAL
TOWER

42" DIA DIP
RESTRAINED JT


FILL LINE
OUTLET

RESERVOIR
SHORELINE

DESIGNED _____ DATE _____
DRAWN _____ DATE _____
CHECKED _____ DATE _____
APPROVED _____ DATE _____
ISSUED _____ DATE _____

DATE		BY	DESCRIPTION	DATE		BY	DESCRIPTION
8-15-94		BA	PER CONTR RECORD DWG				
6-5-95		JBH	ISSUED TO VA, DAM SAFETY				
8-31-97		RWF	RECORD DRAWING				

RECORD DRAWINGS
THESE DRAWINGS RECORDED ON THE BASIS OF
"INFORMATION FURNISHED BY THE CONTRACTOR
OR SPECIFICALLY KNOWN TO HSM. NO OTHER
REPRESENTATIONS ARE MADE OR IMPLIED
Date: 8-5-95

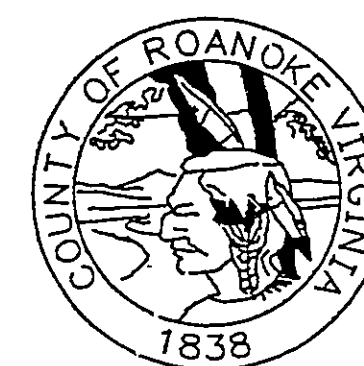

SPRING HOLLOW RESERVOIR
ROANOKE COUNTY, VIRGINIA

HAYES, SEAY, MATTERN & MATTERN, INC.
ARCHITECTS - ENGINEERS - PLANNERS
ROANOKE, VIRGINIA

CIVIL
RESERVOIR FILL LINE

SCALE	DATE	COMM	SHEET
1" = 100'	20 APRIL 1992	4194 JC	C-15 43