



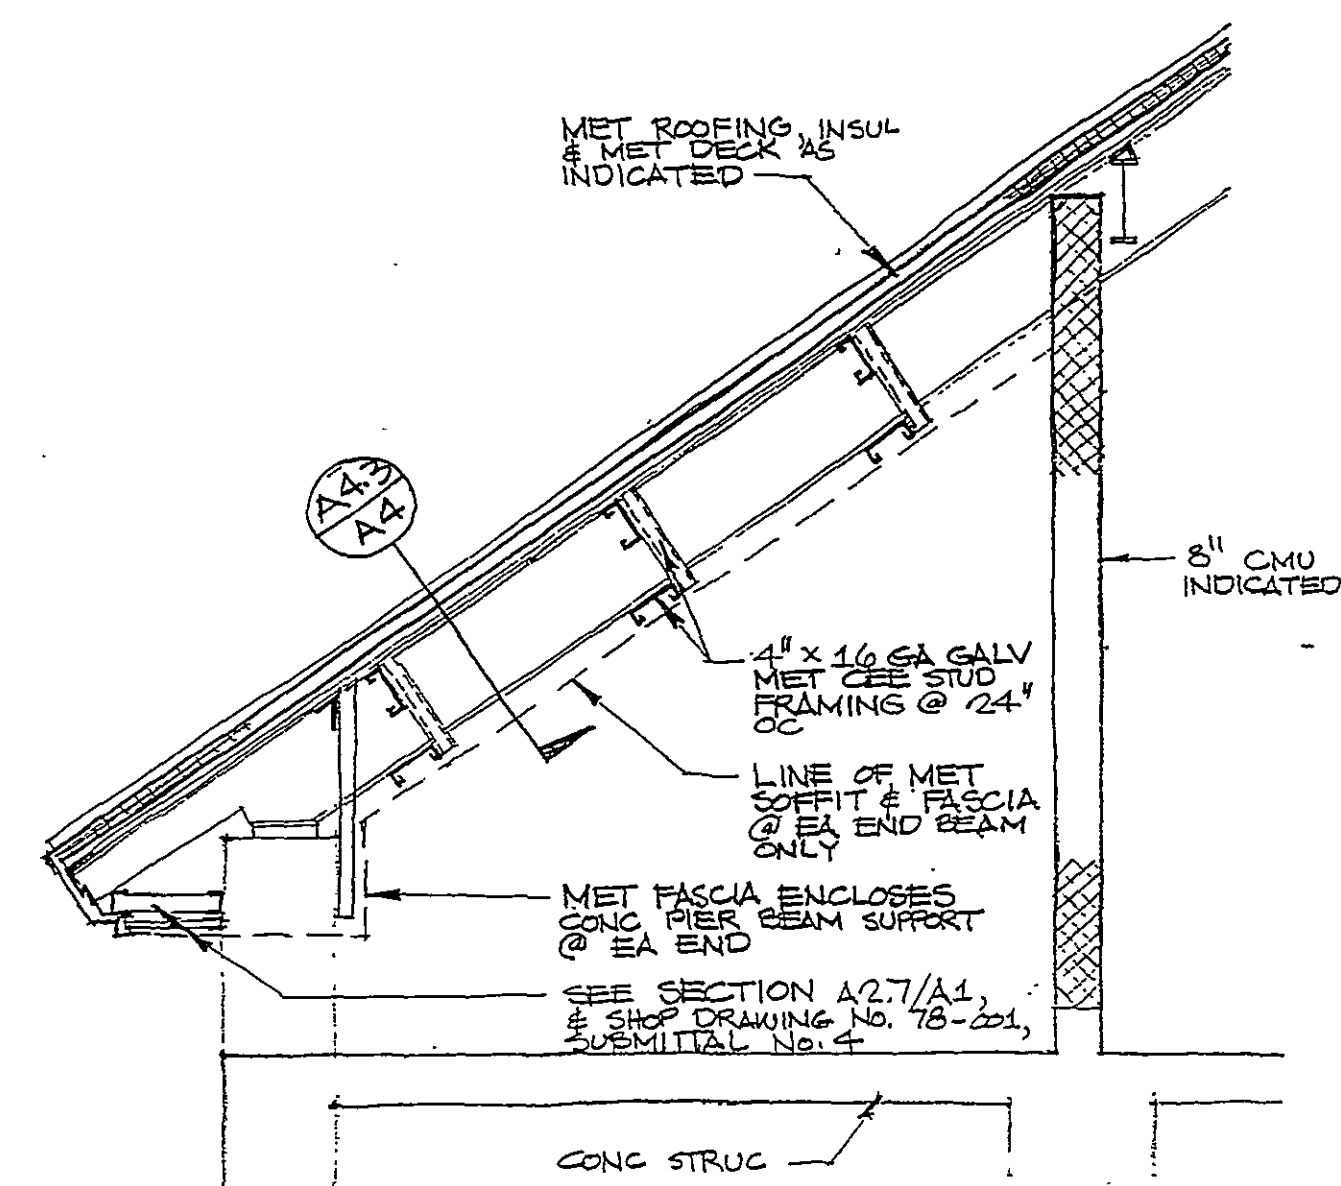

PARTIAL SECTION OF SOFFIT/FASCIA FRAMING

SCALE: 3/4" = 1' - 0"


A4.1
A2

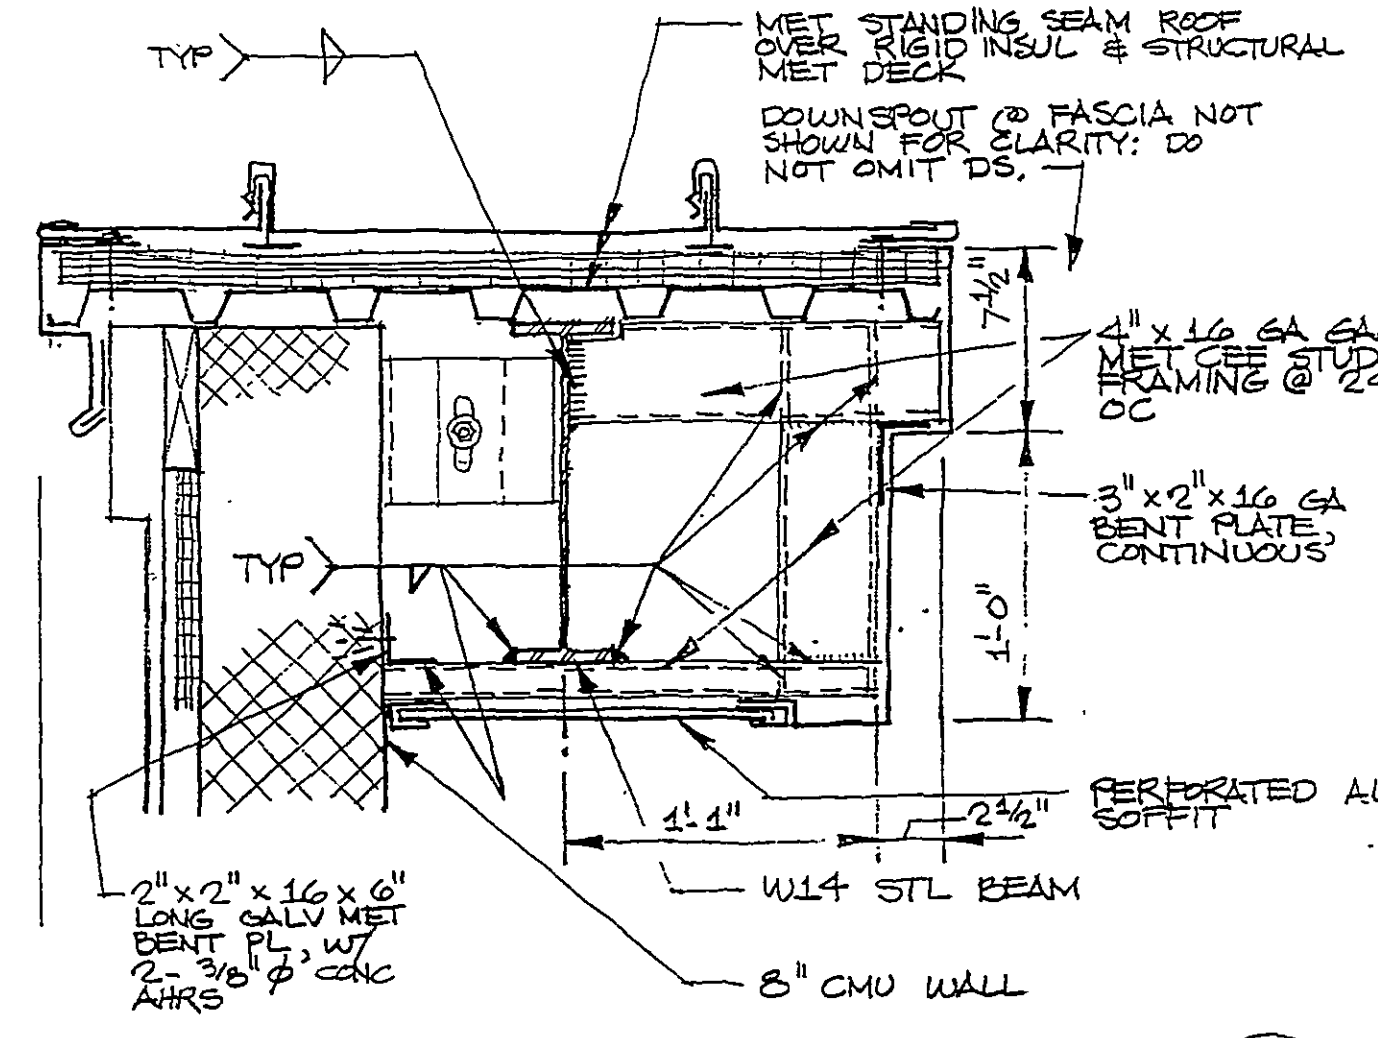

SOFFIT SUPPORT DETAIL

SCALE: 1 1/2" = 1' - 0"


A4.3
A4

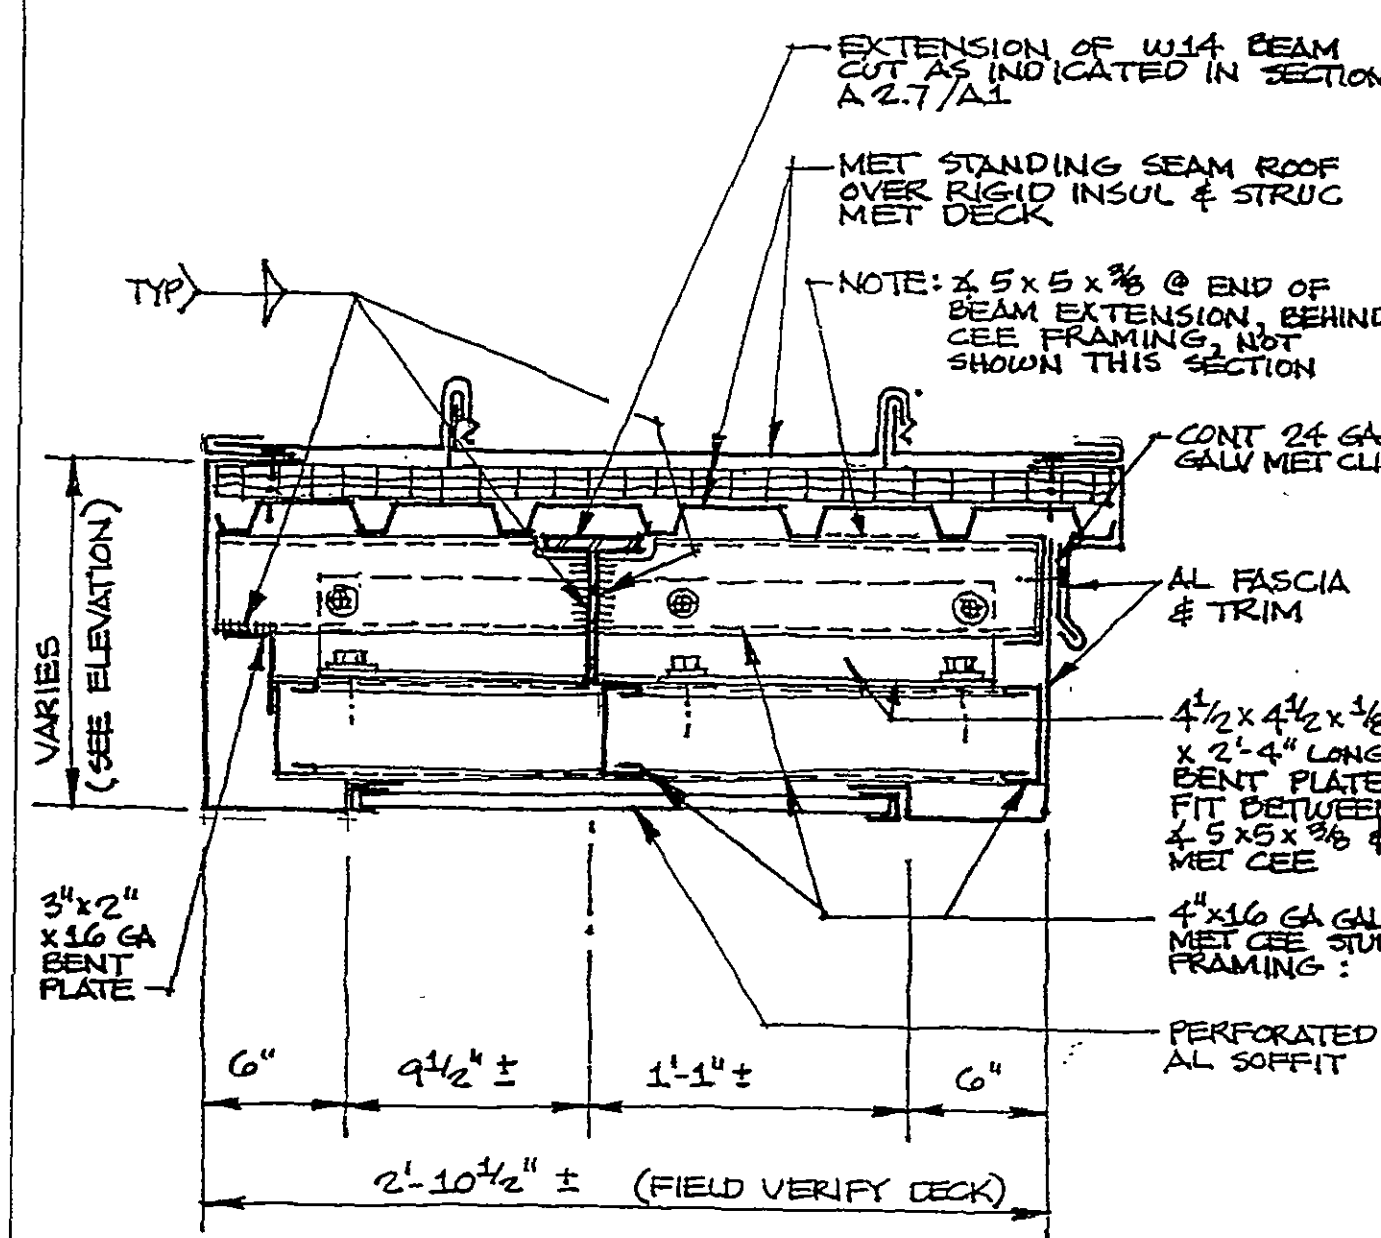

SOFFIT SUPPORT DETAIL

SCALE: 1 1/2" = 1' - 0"

A4.4
A2

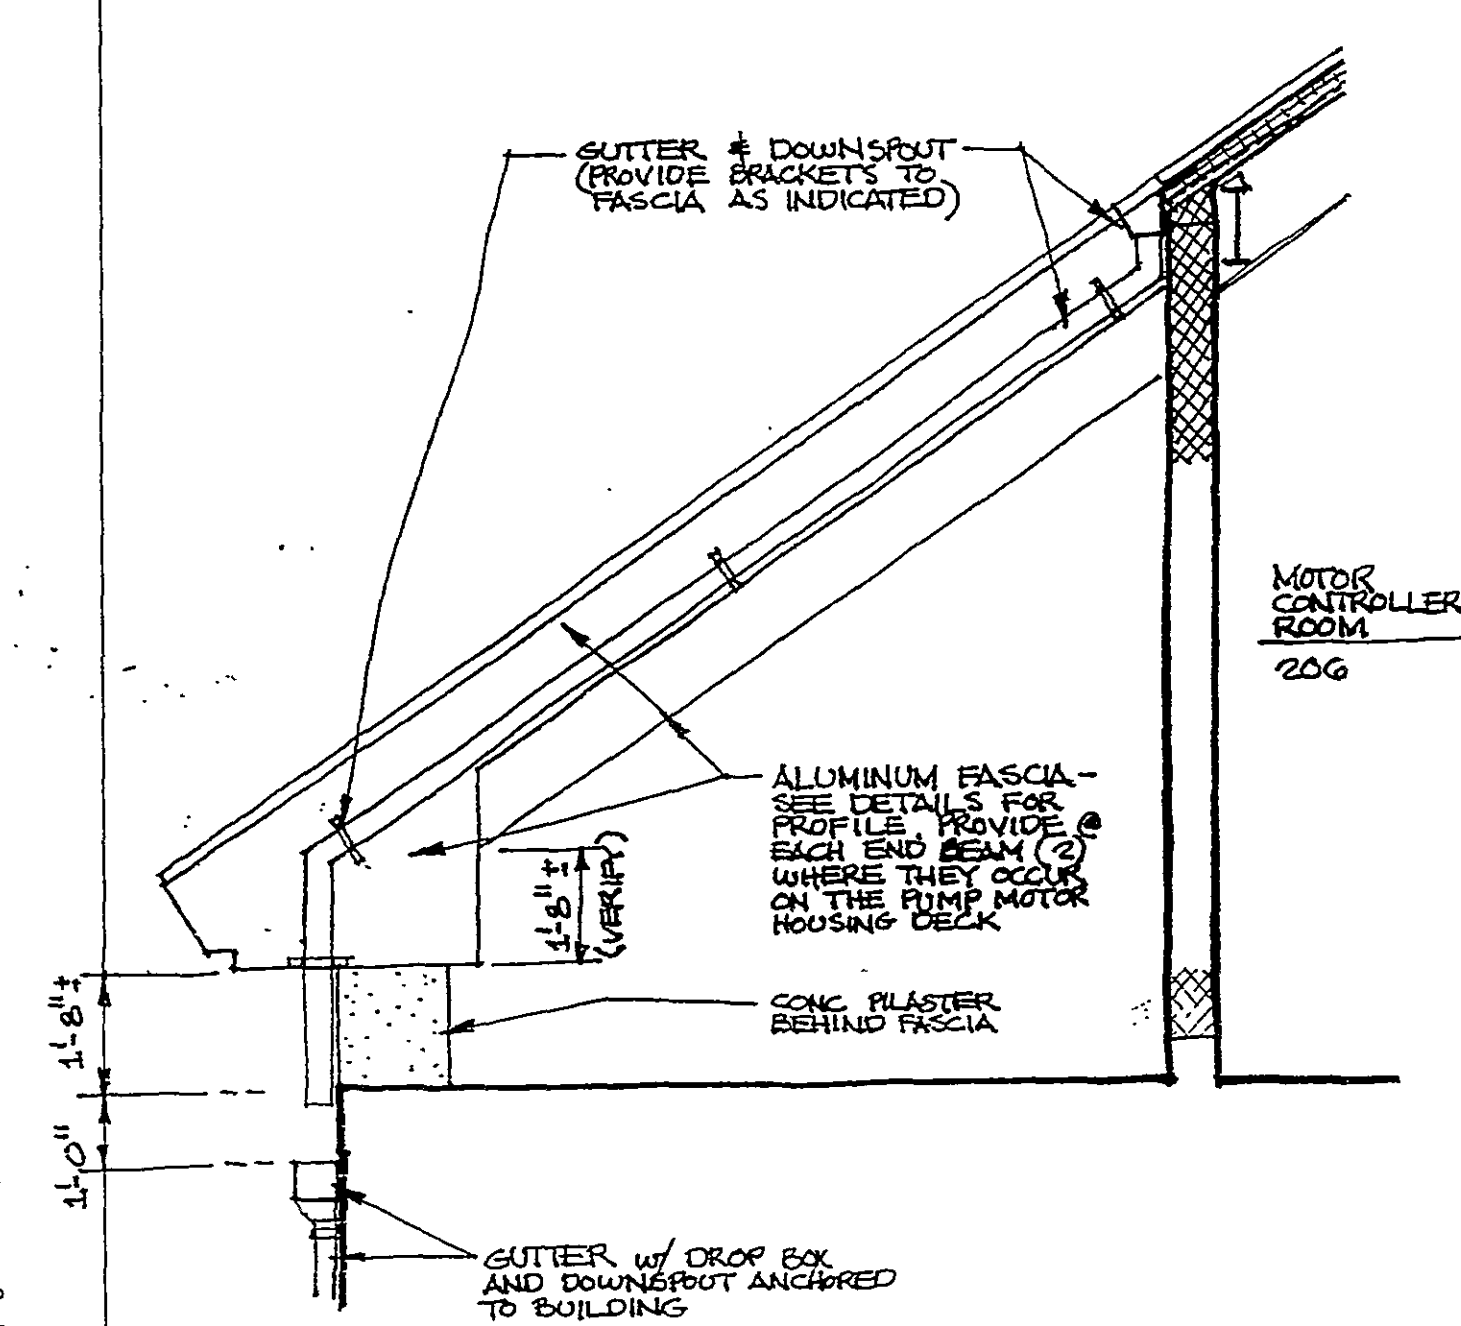

PARTIAL SECTION / FASCIA ELEVATION


SCALE: 3/8" = 1' - 0"

A4.2
A2

RECORD DRAWINGS
THESE DRAWINGS RECORDED ON THE BASIS OF INFORMATION FURNISHED BY THE CONTRACTOR OR SPECIFICALLY KNOWN TO HSM. NO OTHER REPRESENTATIONS ARE MADE OR IMPLIED
Date: 6-5-95

DESIGNED	_____	DATE	_____
DRAWN	_____	DATE	_____
CHECKED	_____	DATE	_____
APPROVED	_____	DATE	_____
ISSUED	_____	DATE	_____

REVISIONS			
DATE	BY	DESCRIPTION	
8-15-94	BA	PER CONTR RECORD DWG	
6-5-95	JBH	ISSUED TO VA. DAM SAFETY	
3-31-97	RWF	RECORD DRAWING	

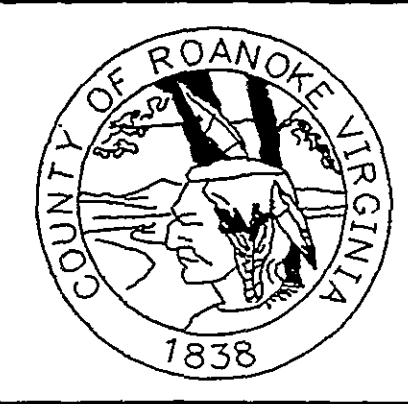

SPRING HOLLOW RESERVOIR
ROANOKE COUNTY, VIRGINIA

HAYES, SEAY, MATTERN & MATTERN, INC.
ARCHITECTS - ENGINEERS - PLANNERS
ROANOKE, VIRGINIA

ARCHITECTURAL SECTIONS AND DETAILS				
SCALE	DATE	COMM	SHEET	DWG
AS NOTED		41941	A-4	45