




DESIGNED	R.D. WELLS	DATE	7-6-93
DRAWN	D.N. FOSTER	DATE	7-6-93
CHECKED		DATE	
APPROVED		DATE	
ISSUED		DATE	

DATE	BY	DESCRIPTION	DATE	BY	DESCRIPTION
8-15-94	BA	PER CONTR RECORD DWG			
6-5-95	JBH	ISSUED TO VA. DAM SAFETY			
3-17-97	WVF	RECORD DRAWING			

DATE	BY	DESCRIPTION	DATE	BY	DESCRIPTION

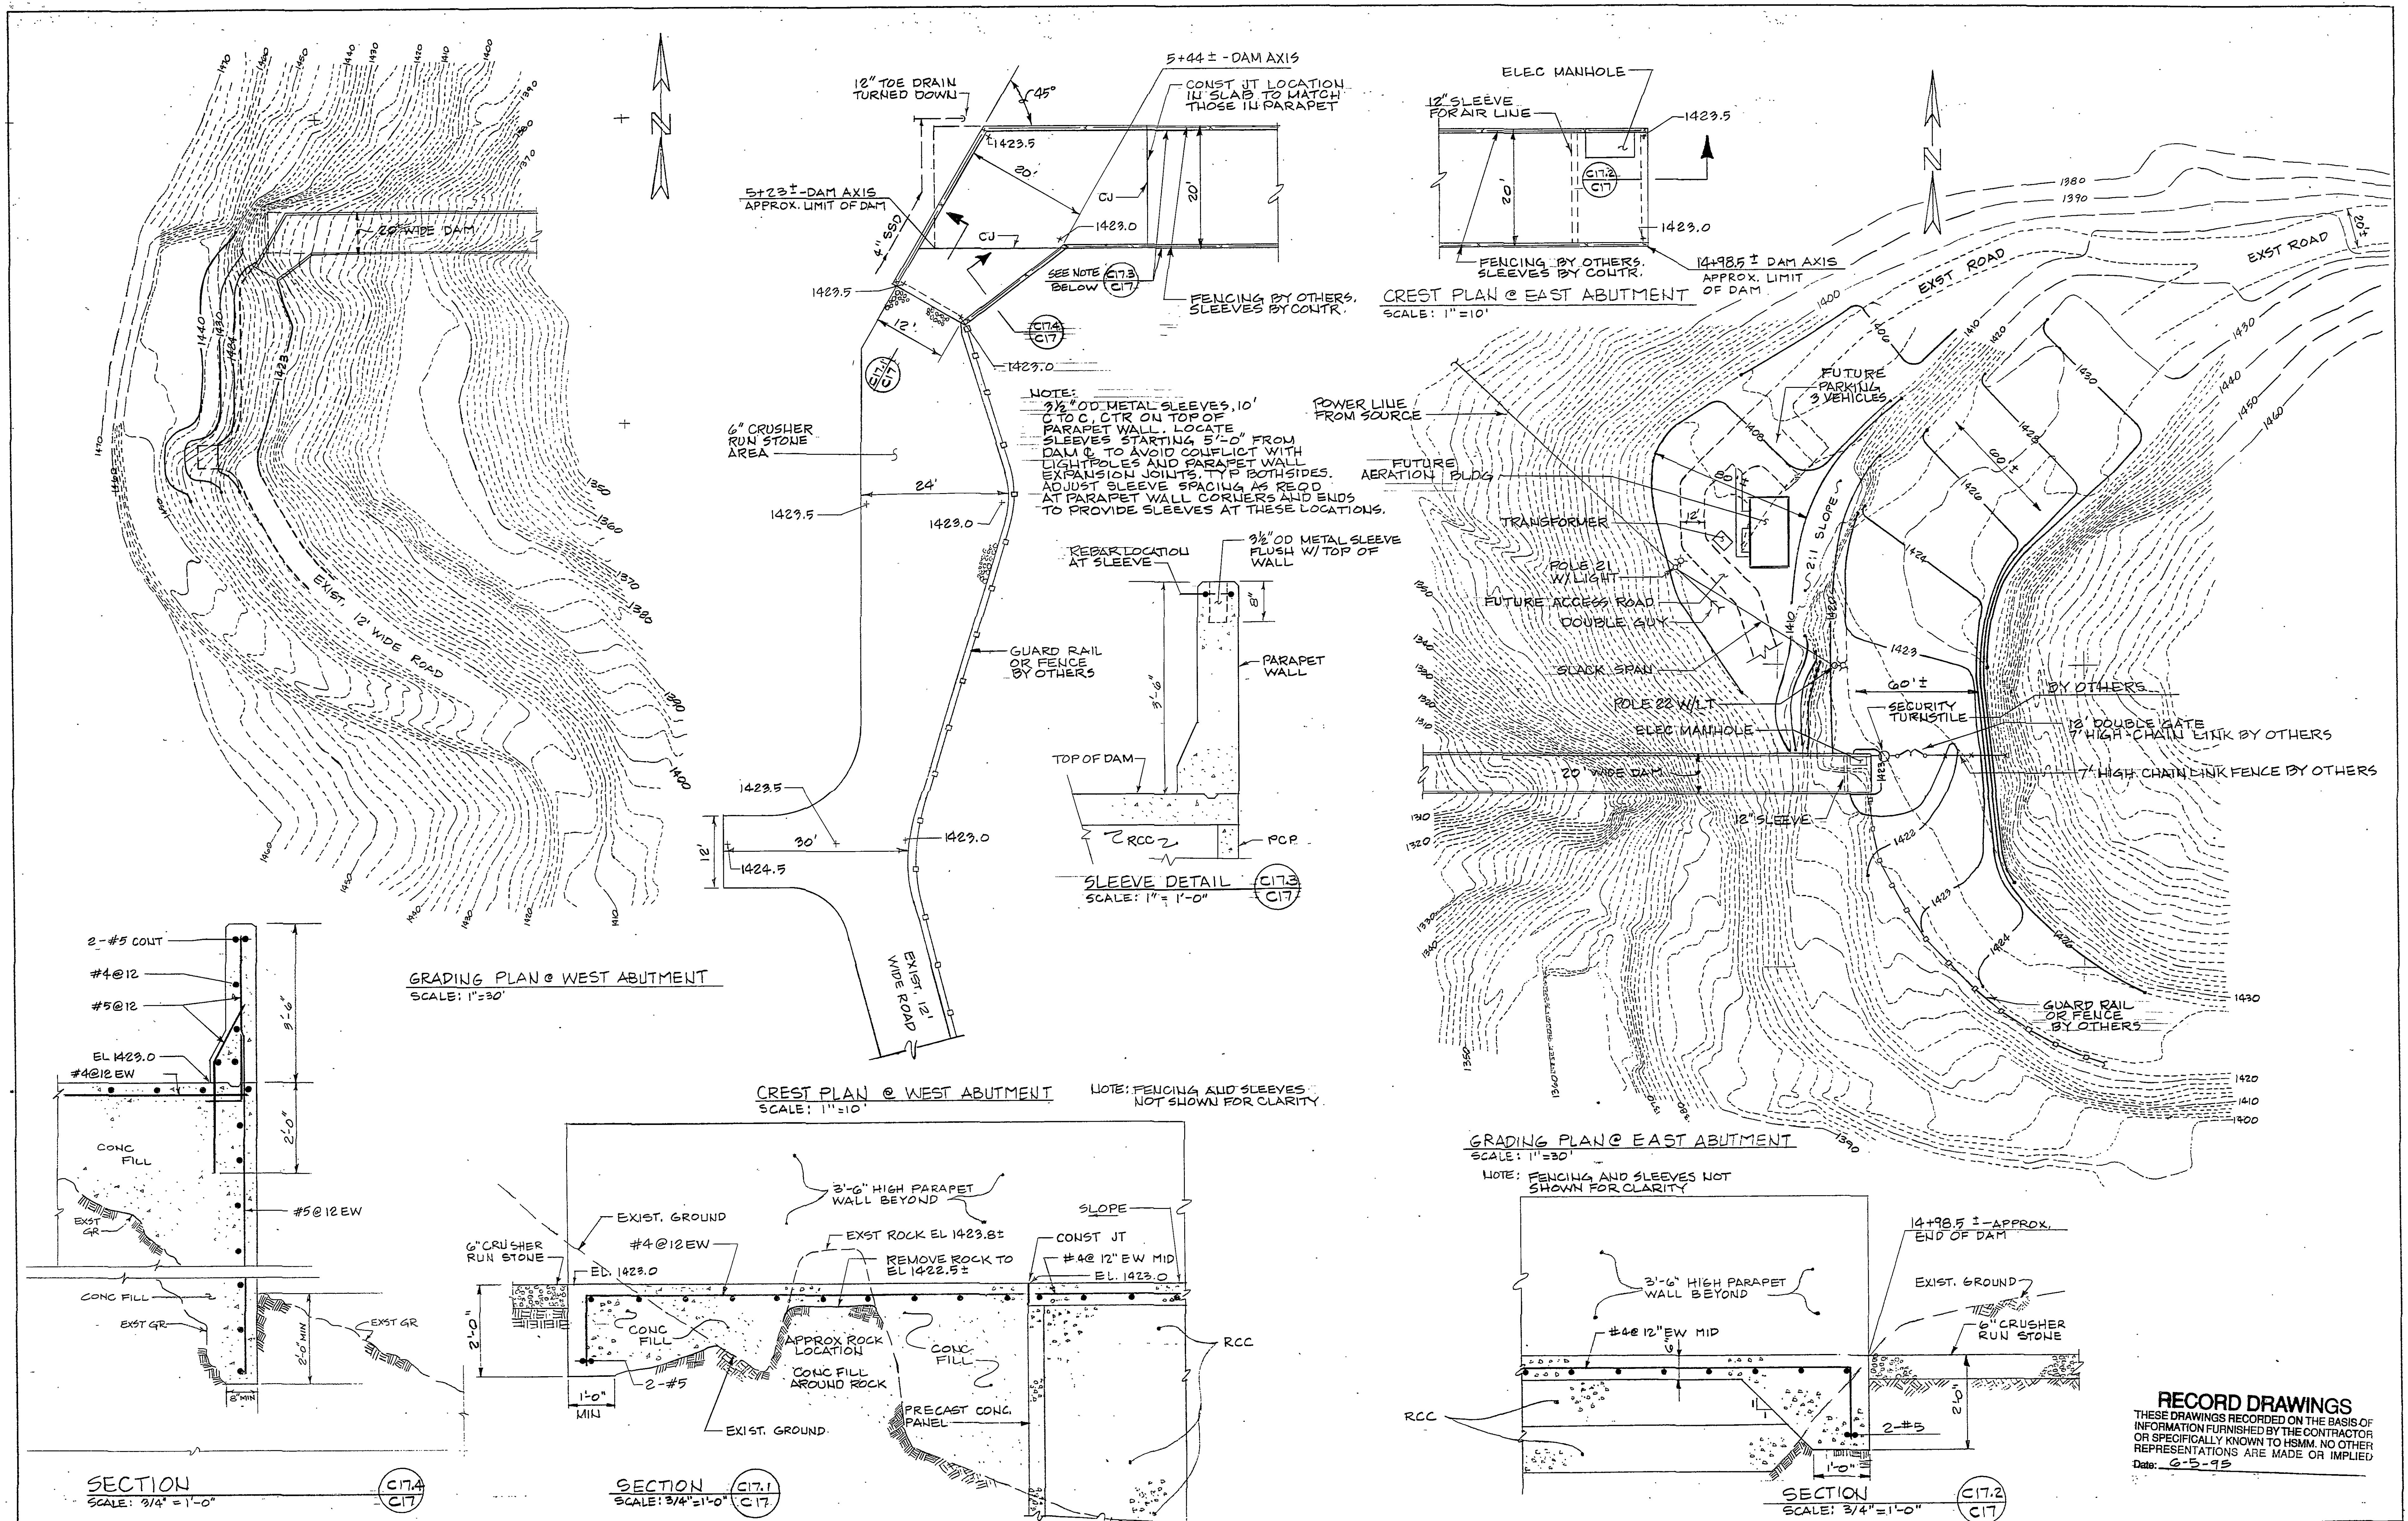

SPRING HOLLOW RESERVOIR
ROANOKE COUNTY, VIRGINIA

HAYES, SEAY, MATTERN & MATTERN, INC.
ARCHITECTS - ENGINEERS - PLANNERS
ROANOKE, VIRGINIA

CIVIL REVISIONS TO EAST & WEST ABUTMENT GRADING		SCALE	DATE	COMM	SHEET	DWG
		AS NOTED	30 JULY 1993	41941	C-17	46

RECORD DRAWINGS
THESE DRAWINGS RECORDED ON THE BASIS OF INFORMATION FURNISHED BY THE CONTRACTOR OR SPECIFICALLY KNOWN TO HSM. NO OTHER REPRESENTATIONS ARE MADE OR IMPLIED
Date: 6-5-95