
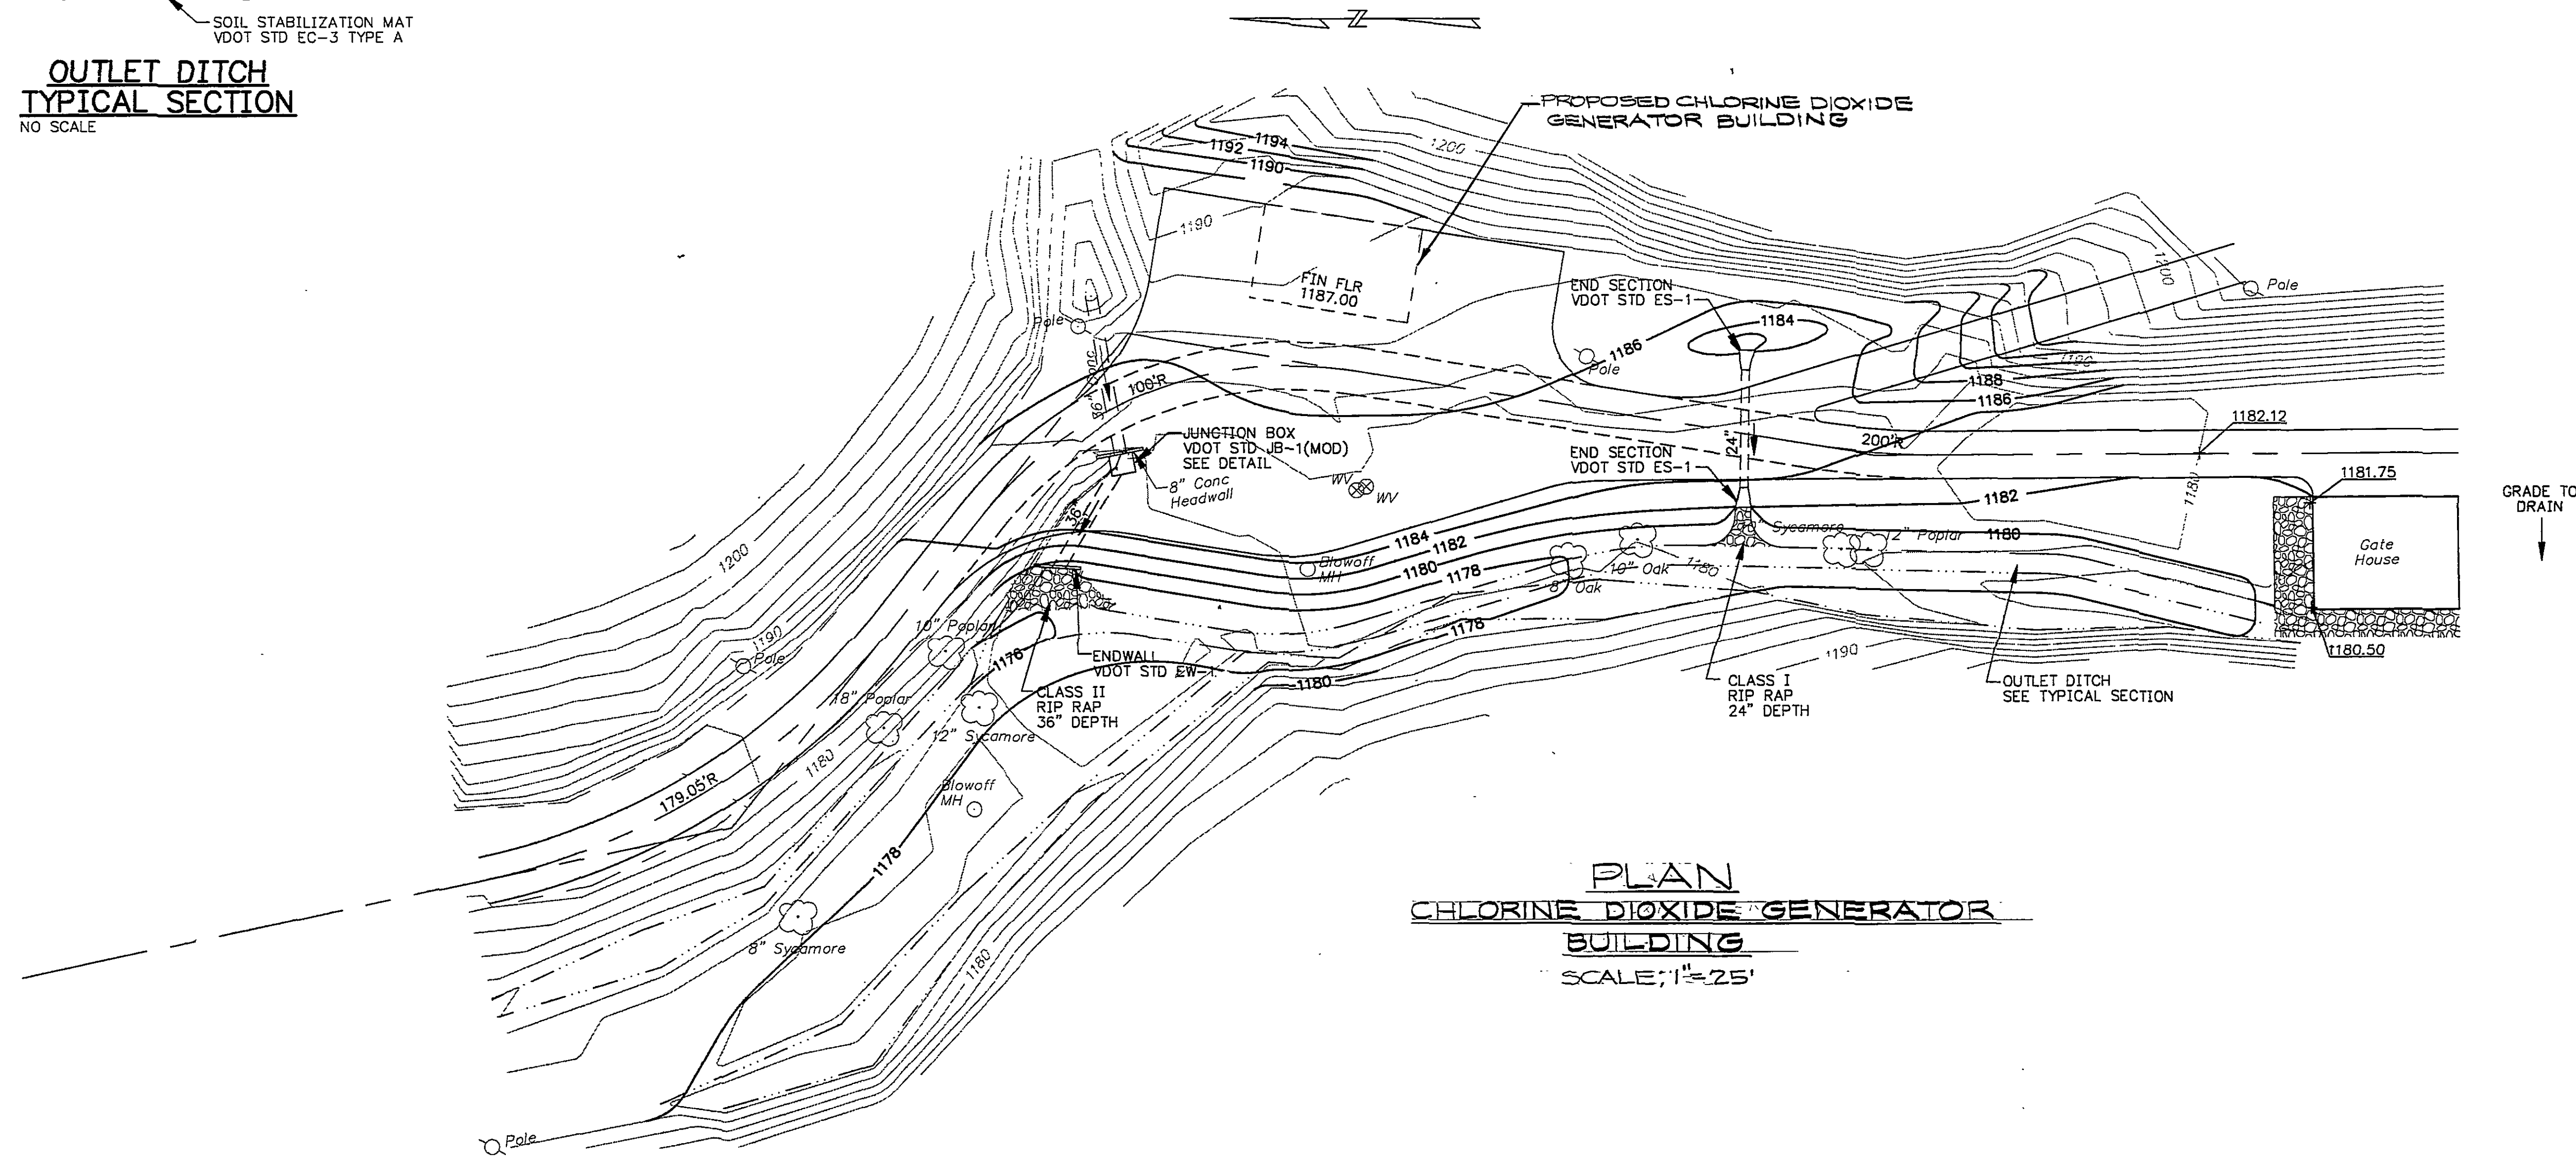


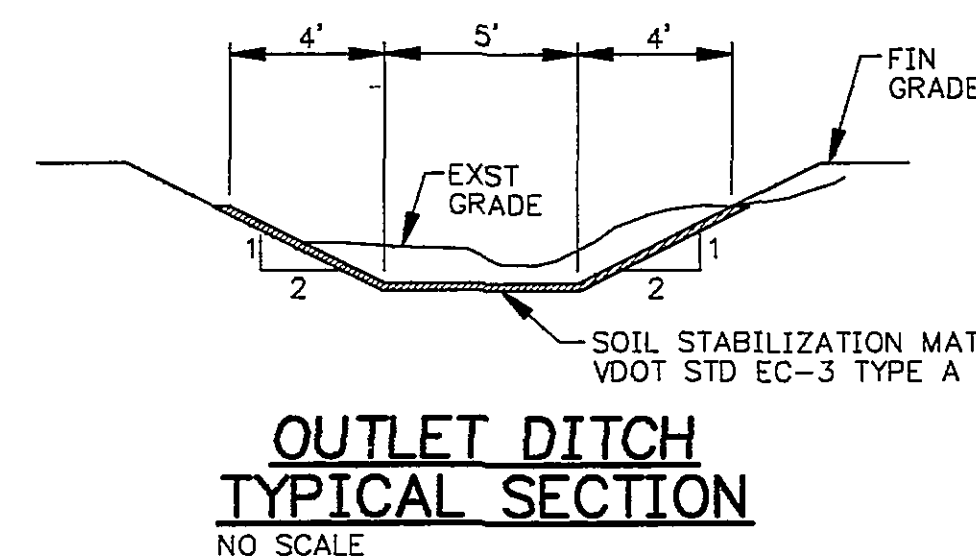


PLAN
CHLORINE DIOXIDE GENERATOR
BUILDING
SCALE: 1"=25'

BM
1186.41

CP-3
IP/BTL/CAP

RECORD DRAWINGS
THESE DRAWINGS RECORDED ON THE BASIS OF
INFORMATION FURNISHED BY THE CONTRACTOR
OR SPECIFICALLY KNOWN TO HSM. NO OTHER
REPRESENTATIONS ARE MADE OR IMPLIED
Date: 6-2-95

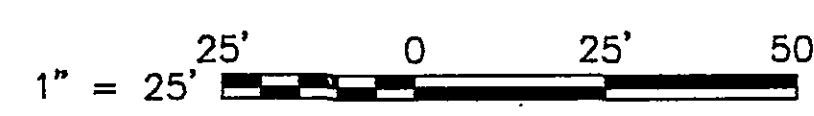

DESIGNED	DATE
DRAWN	DATE
CHECKED	DATE
APPROVED	DATE
ISSUED	DATE

REVISIONS					
DATE	BY	DESCRIPTION	DATE	BY	DESCRIPTION
8-15-94	BA	PER CONTR RECORD DWG			
6-5-95	JBA	ISSUED TO VA. DAM SAFETY			
3-31-97	RWF	RECORD DRAWING			



SPRING HOLLOW RESERVOIR
ROANOKE COUNTY, VIRGINIA

HAYES, SEAY, MATTERN & MATTERN, INC.
ARCHITECTS - ENGINEERS - PLANNERS
ROANOKE, VIRGINIA

CIVIL PLAN-CHLORINE DIOXIDE GENERATOR BUILDING				
SCALE AS NOTED	DATE	COMM 41941	SHEET C-18	DWG 48