



DATE: 03-21-95
 DRAWN: PZZ
 CHECKED: [Signature]
 APPROVED: [Signature]
 DESIGNED: JSW

TANK DESCRIPTION:
 2.0-MG CLEAR WELL

TANK DIMENSIONS:
 112'0" ID x 28'0" SWD

TANK BUILDER:
 THE CROM CORPORATION
 GAINESVILLE, FLORIDA

OWNER:
 COUNTY OF
 ROANOKE
 VIRGINIA

CONSULTING ENGINEER:
 ROANOKE COUNTY
 UTILITY DEPARTMENT

REV.	DESCRIPTION	DATE CK. BY



WHERE STANDARD SPECIFICATIONS ARE IN CONFLICT WITH CROM CORPORATION SPECIFICATIONS OR WITH GOOD PRE-STRESSING OR SHOTCRETE PRACTICES THE STANDARD SPECIFICATIONS SHALL BE SUBORDINATED. THIS DESIGN AND DRAWING ORIGINATED BY AND THE EXCLUSIVE PROPERTY OF THE CROM CORPORATION.

BAR IS ONE INCH ON ORIGINAL DRAWINGS 0 1"



SCALE:
 AS NOTED

FILE NO. 9449.2


SHEET 8 OF 19

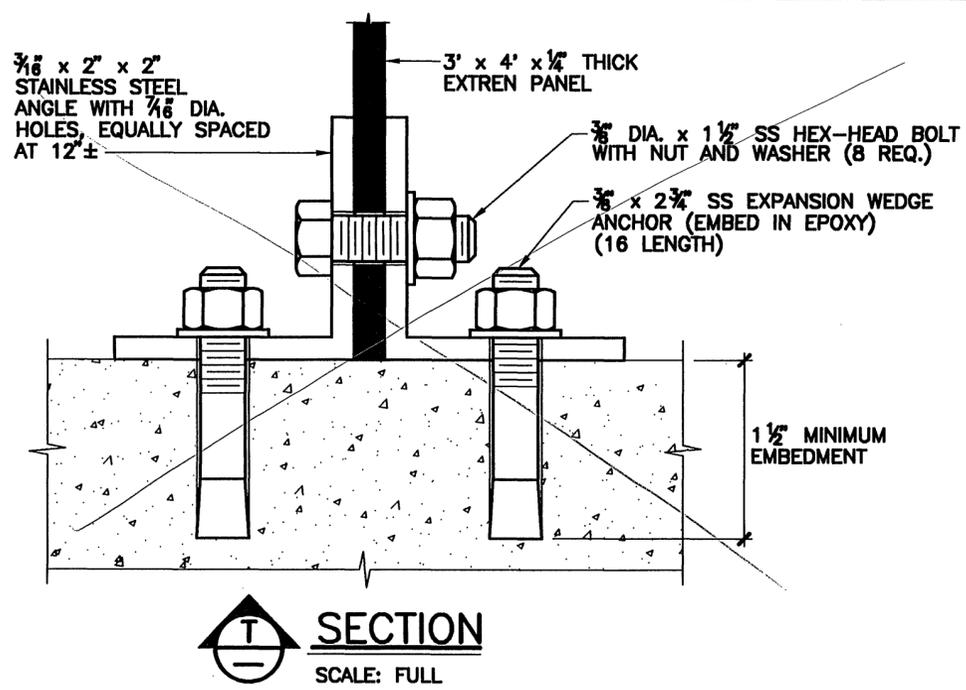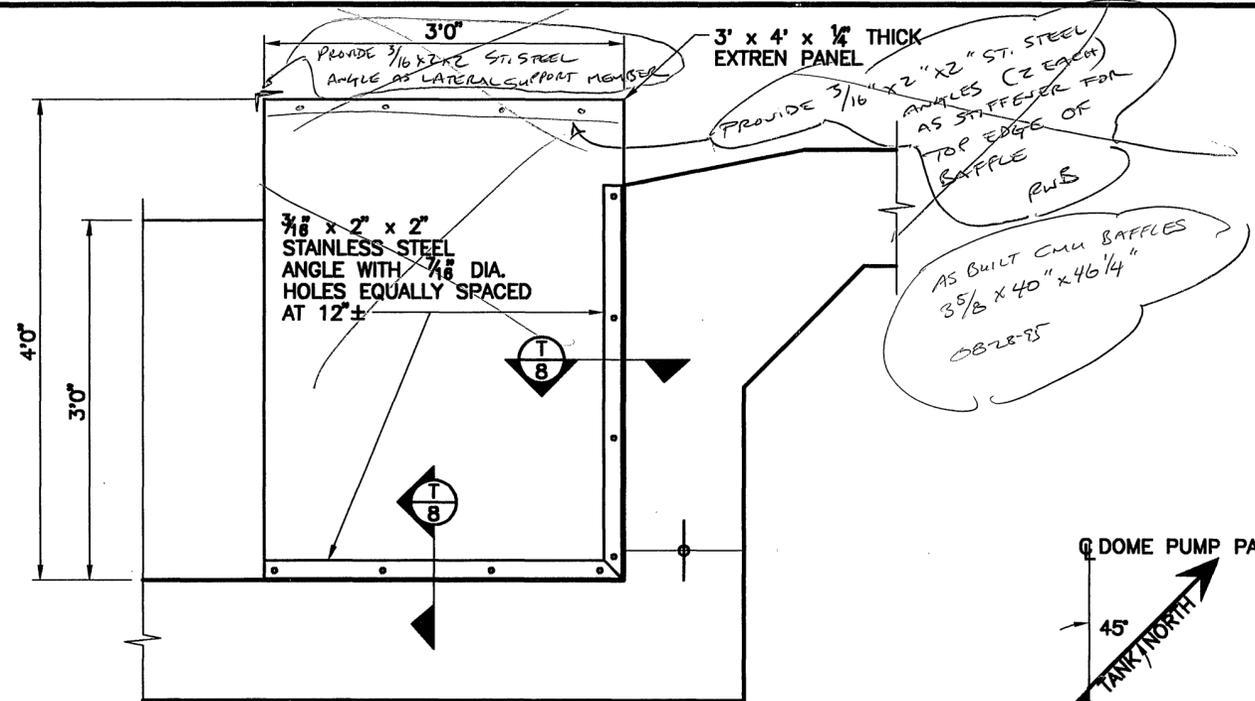

9 FIBERGLASS PUMP INTAKE BAFFLE (5 REQ.)

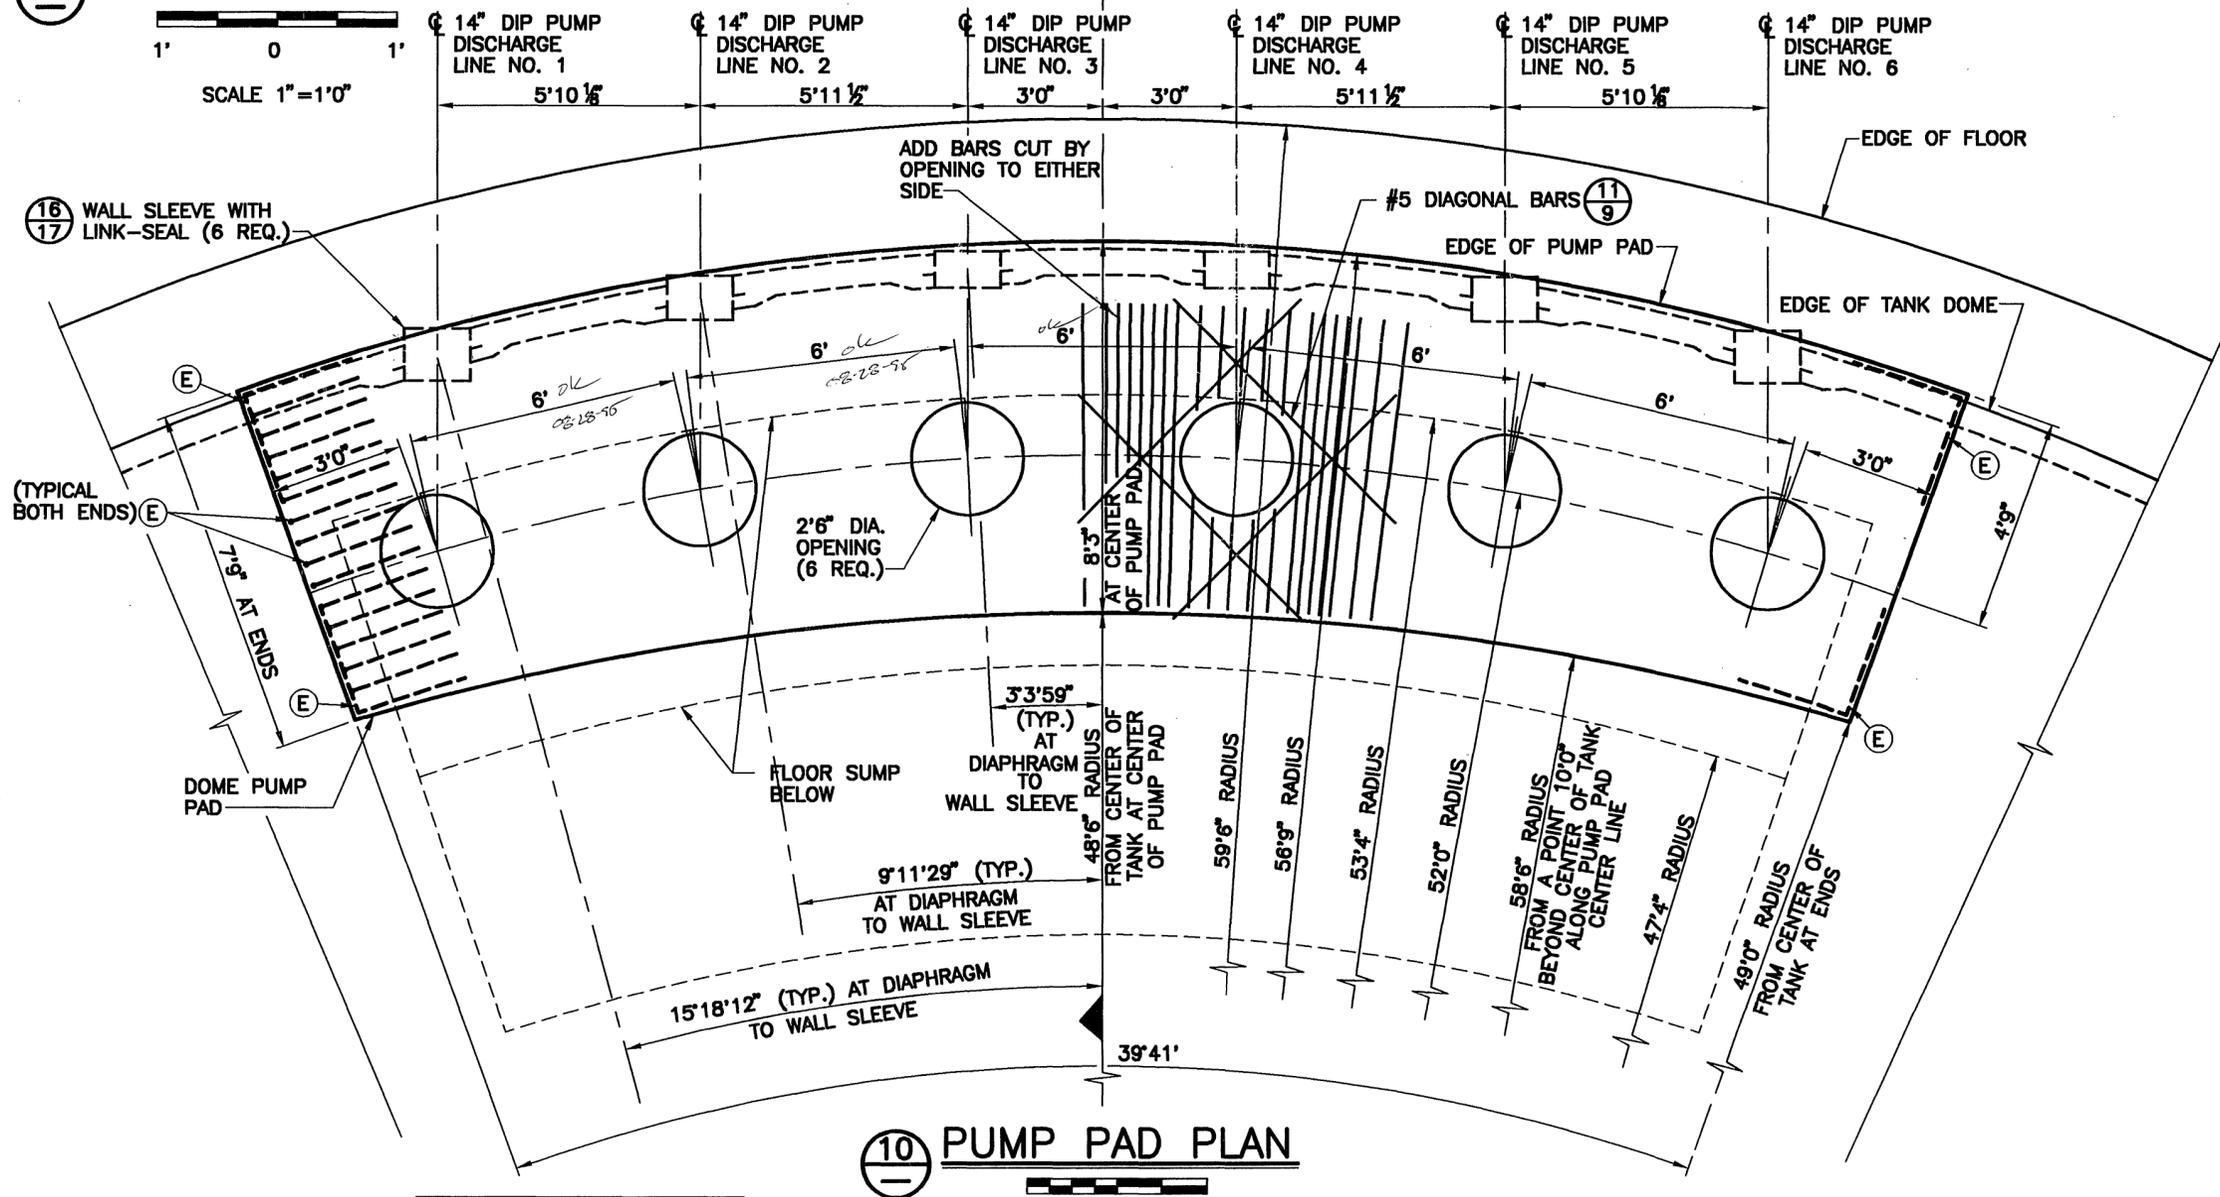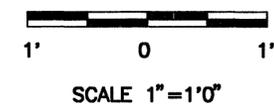

10 PUMP PAD PLAN

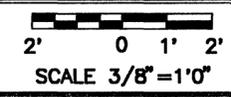

NOTE: SEE SHEET 9 FOR PUMP PAD RESTEEL SCHEDULE