



SITE LOCATION INDEX
 SCALE 1" = 100'-0"

INSPECTOR'S AS-BUILTS 1995

WWW ID# 8LDLJZ

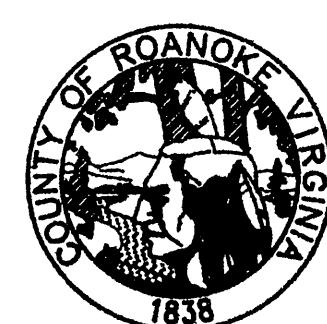

ROANOKE COUNTY WATER TREATMENT FACILITY

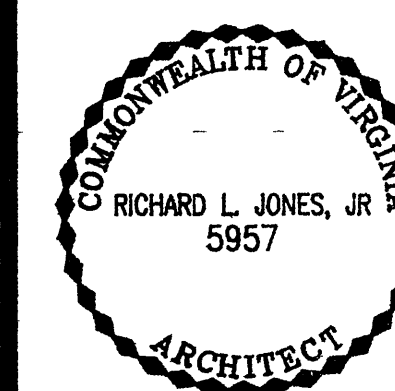

SITE LOCATION INDEX

PROJECT ARCHITECT
 RLJ JR

COMMISSION NUMBER
 1913

TECHNICIAN
 RMT

DATE
 22 SEPT 1994

I