


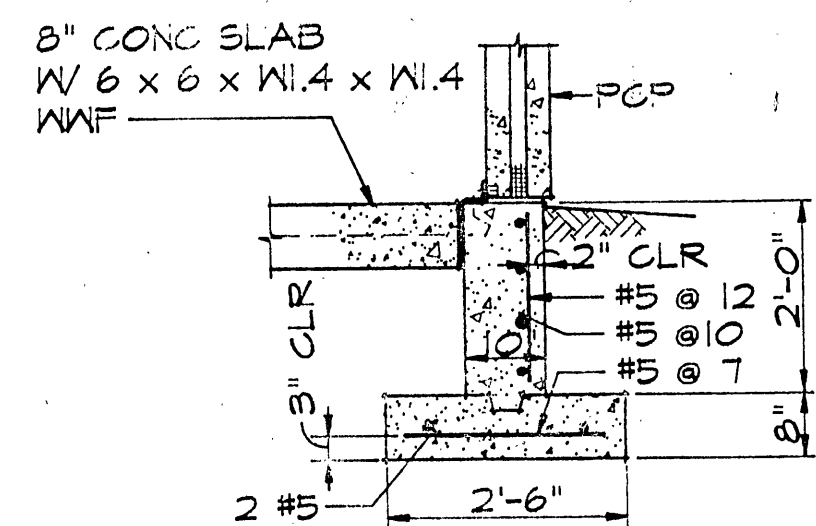


SECTION

SCALE 1/2" = 1'-0"

PLANTER AND POOL NOT SHOWN

CONCRETE FLOOR AND METAL DECK
NOTE REINFORCE STEEL JOIST AS NECESSARY OVER BEARING

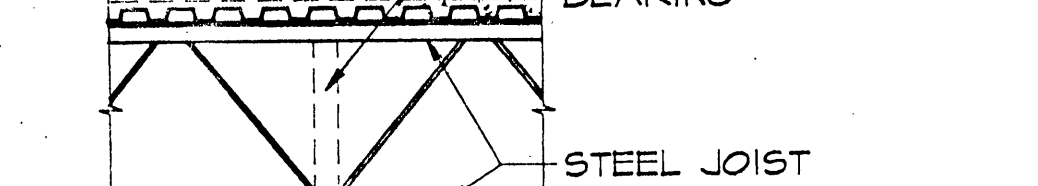

STEEL JOIST
#12 x 19
1/4" x 5 x 10 TOP PL


3" PIPE STD
COMPRESSIBLE FILLER
1/2" x 6" ANCHOR BOLTS
W/ 2 NUTS EACH

4 - #4 EN
CONCRETE FOOTING

SECTION S2.2
SCALE 1/2" = 1'-0"

- ① DIMENSION CLARIFICATION - FROM OUTSIDE OF THE FOOTING CORNER TO EQUIPMENT ROOM 107 IS 68'-8"
- ② CLARIFICATION - DETAIL S2.2/S2 IS CORRECT. THE BEAMS ARE PERPENDICULAR TO THE STEEL JOISTS. THE JOISTS WERE MUST BE REINFORCED.


BY: JYKE
IF ENCLOSURES ARE NOT AS INDICATED, PLEASE INFORM US IMMEDIATELY

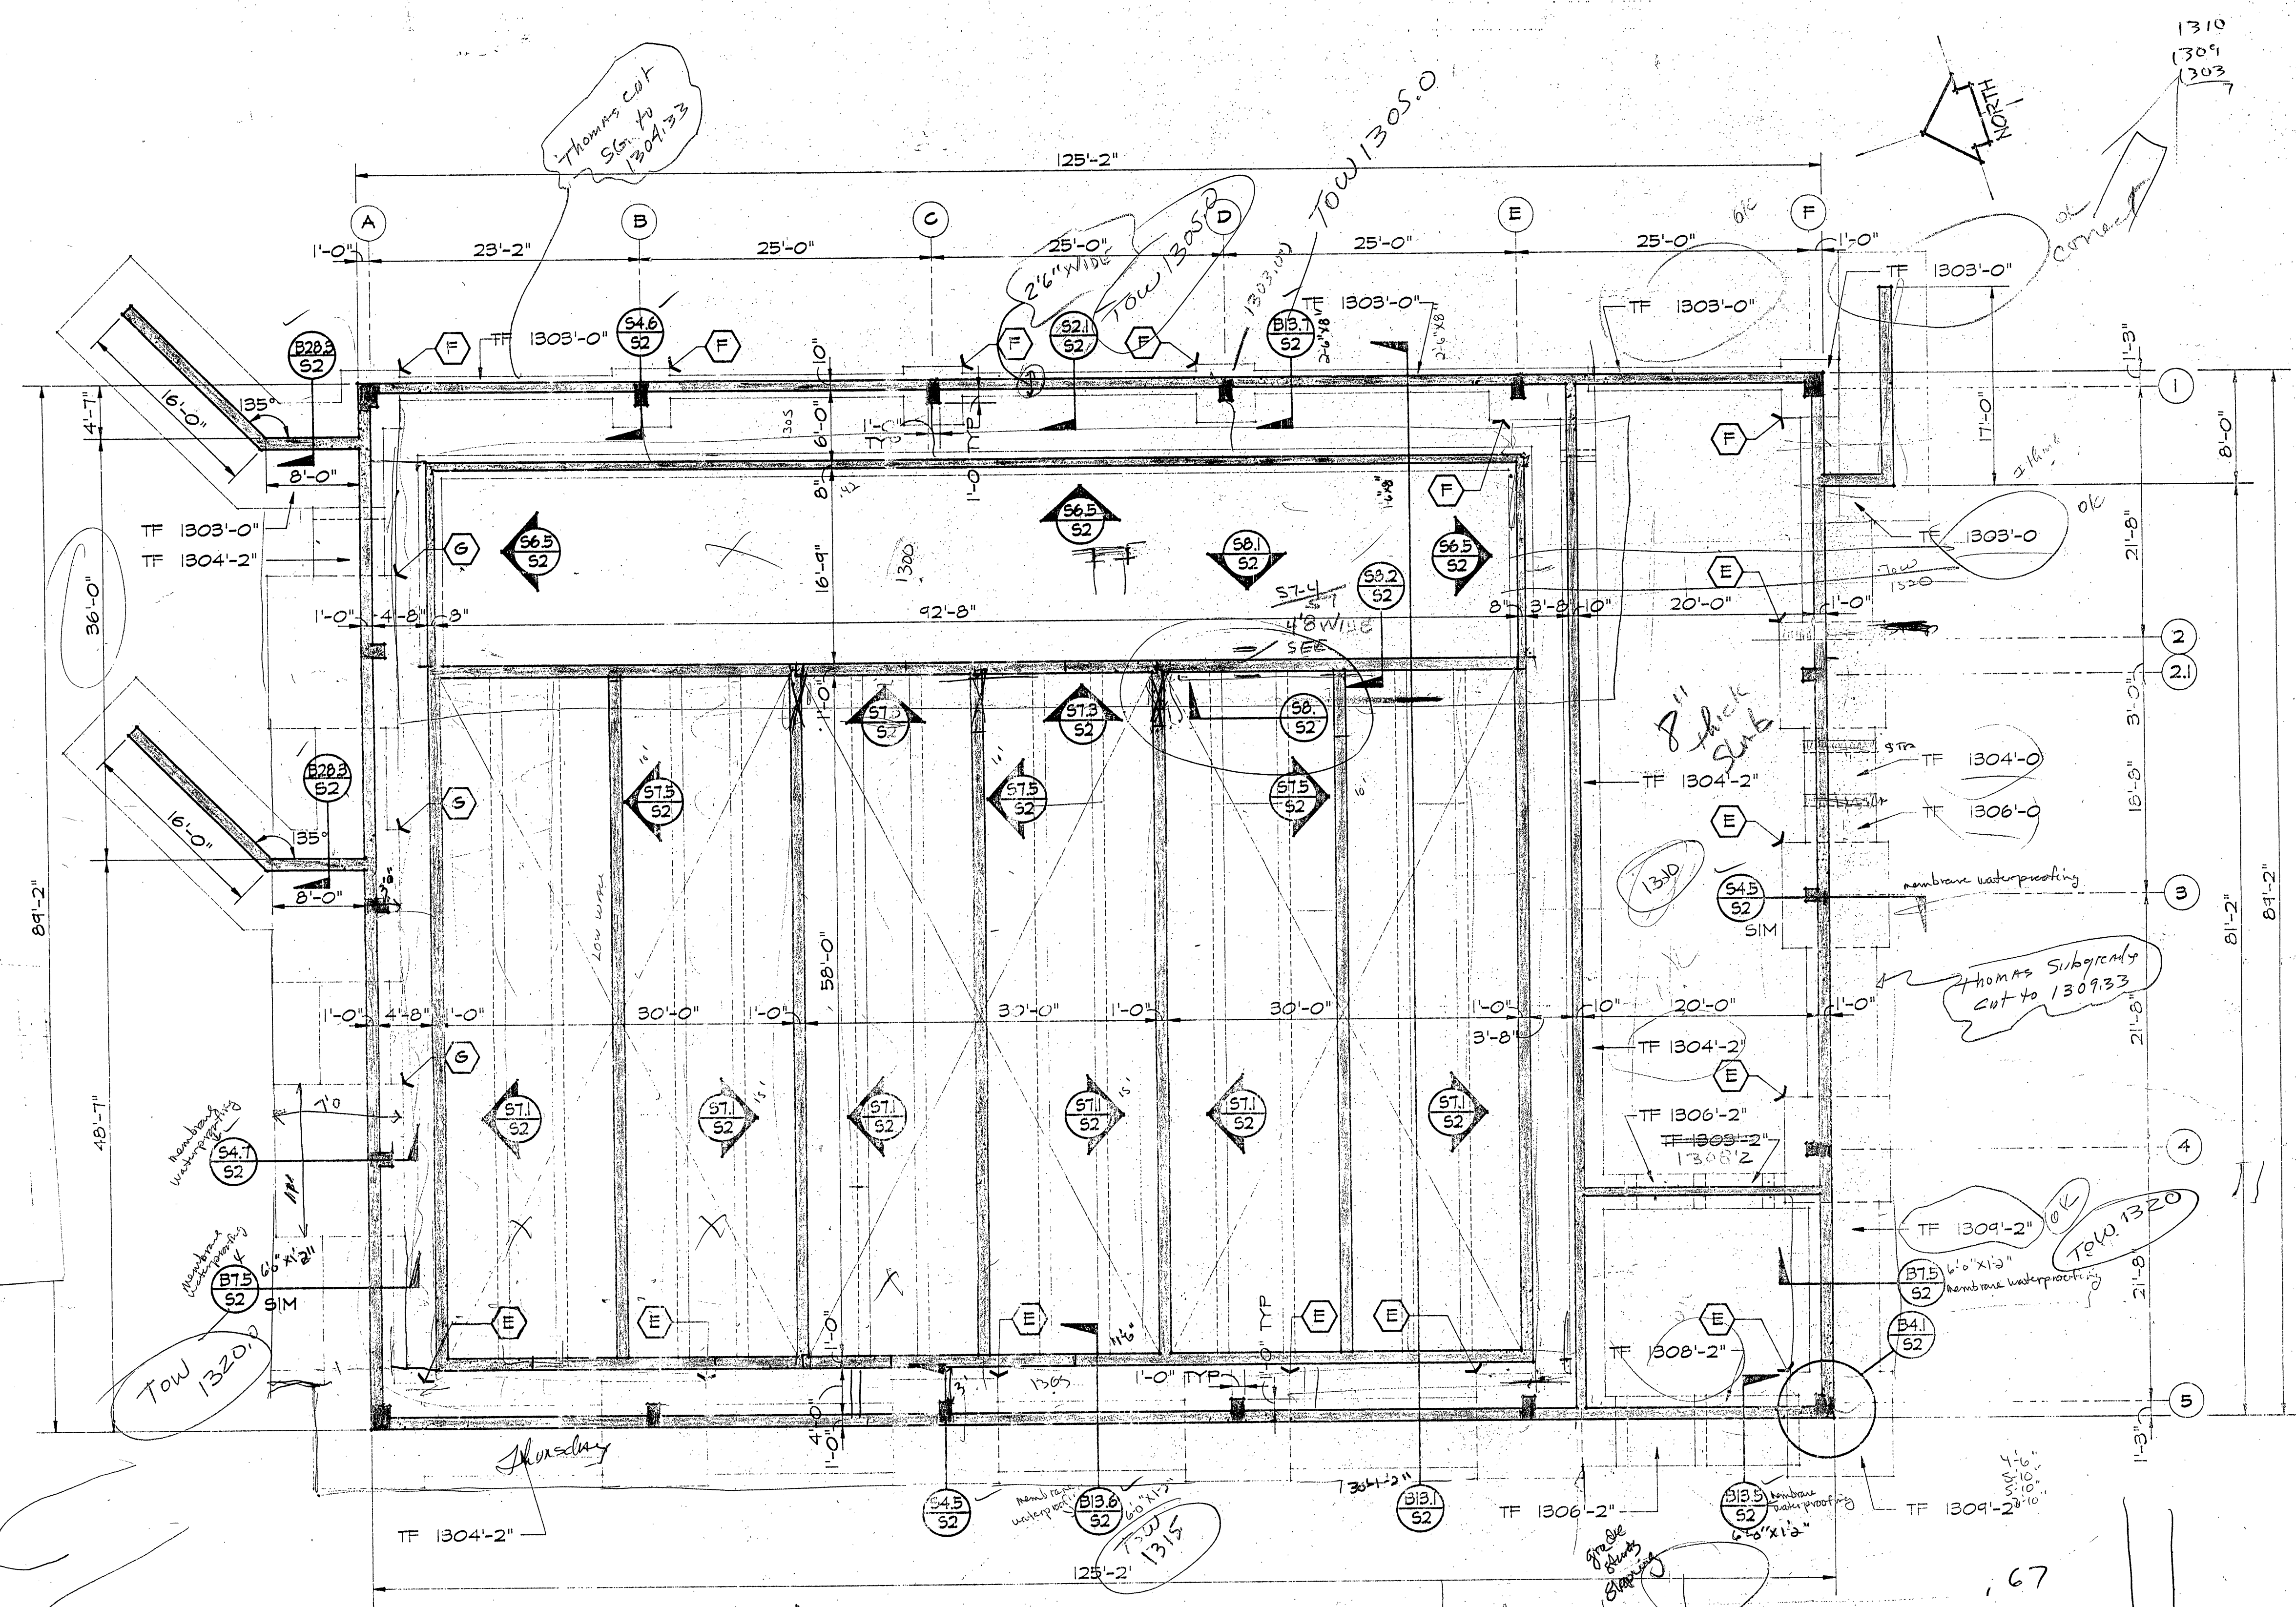

FOOTING AND FOUNDATION PLAN - GAC BUILDING
SCALE 1/8" = 1'-0"



ROANOKE COUNTY
WATER TREATMENT
FACILITY

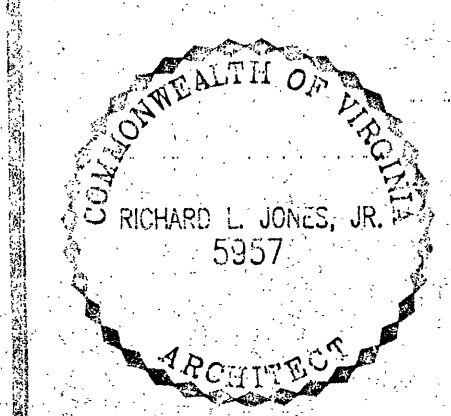

FOOTING AND FOUNDATION PLAN	
PROJECT ARCHITECT RLJ/R	DESIGNATION NUMBER 1913
TECHNICIAN RJT	DATE 22 SEPT 1994

S2

INSPECTOR'S AS-BUILTS 1995
WWW.ID# 8LDLZ