

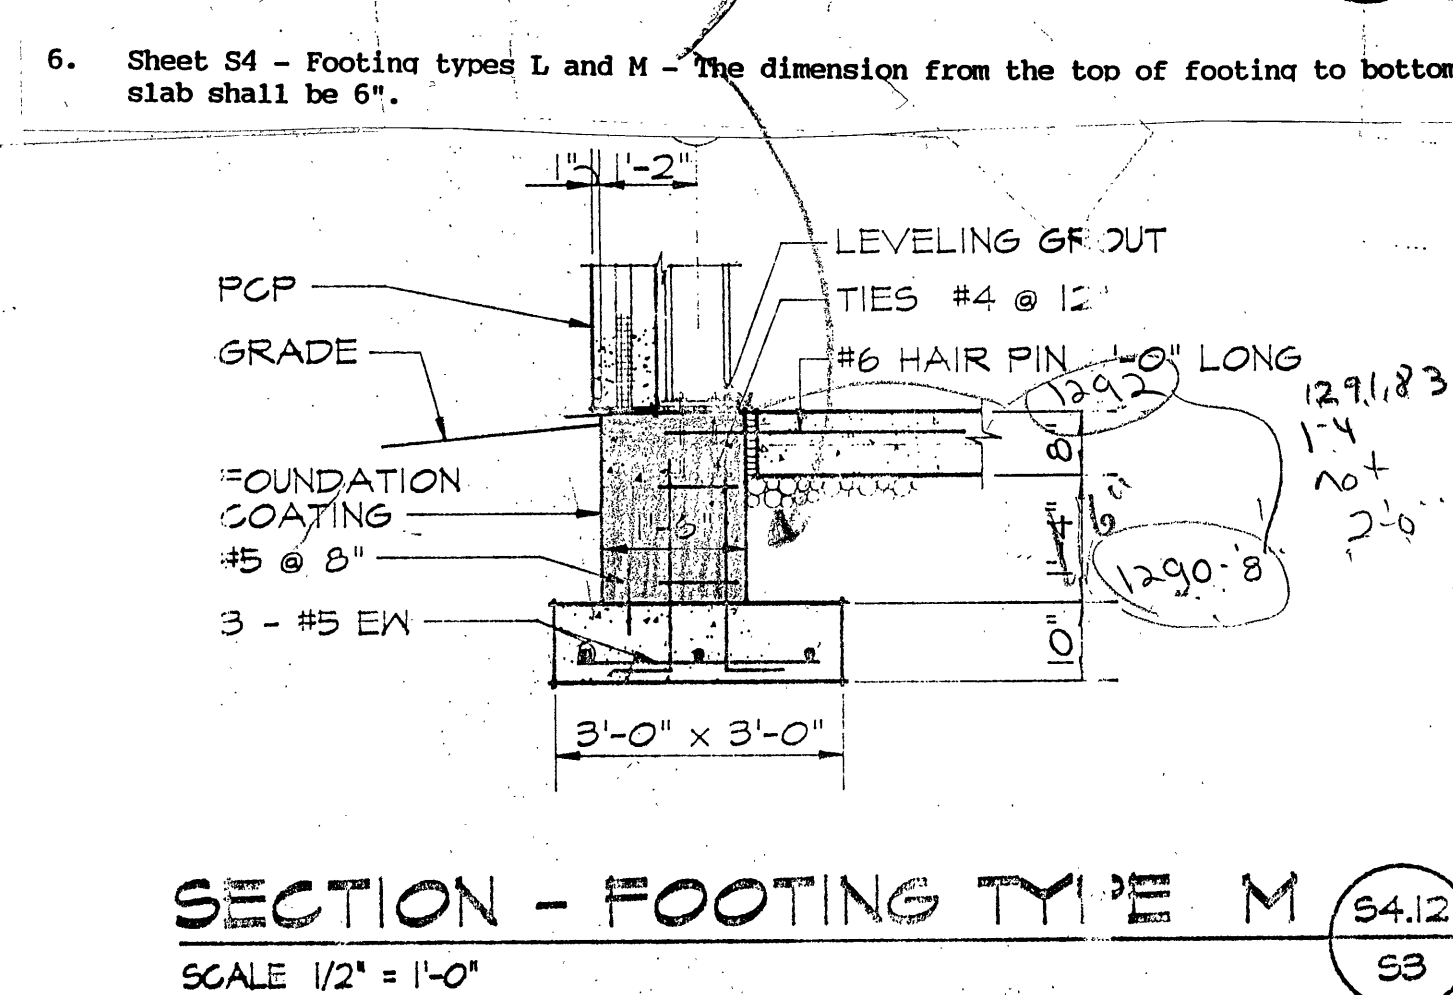
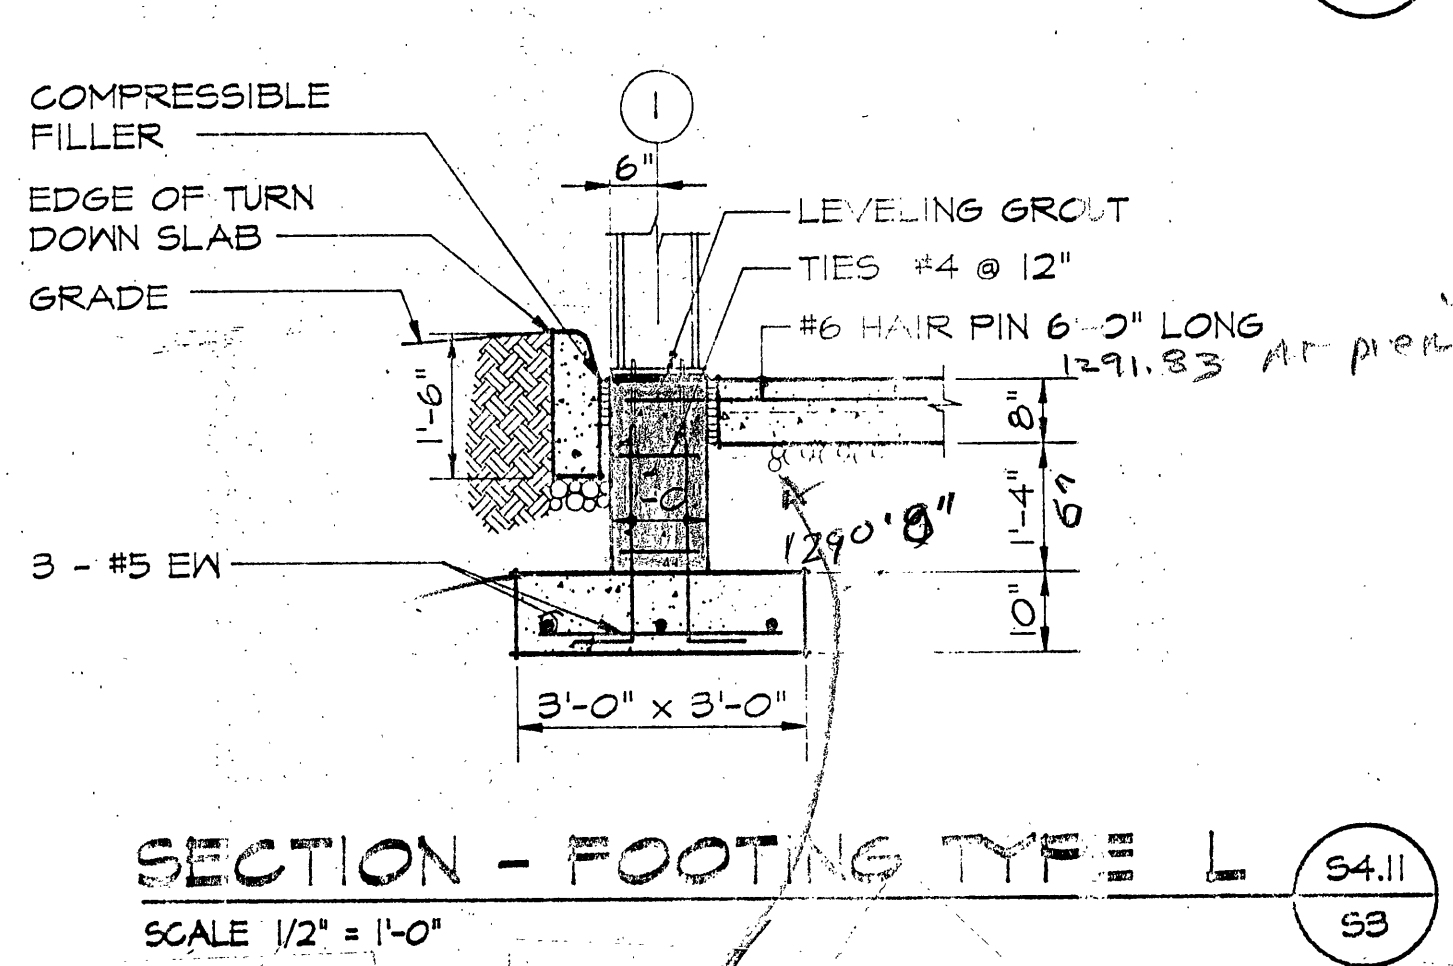
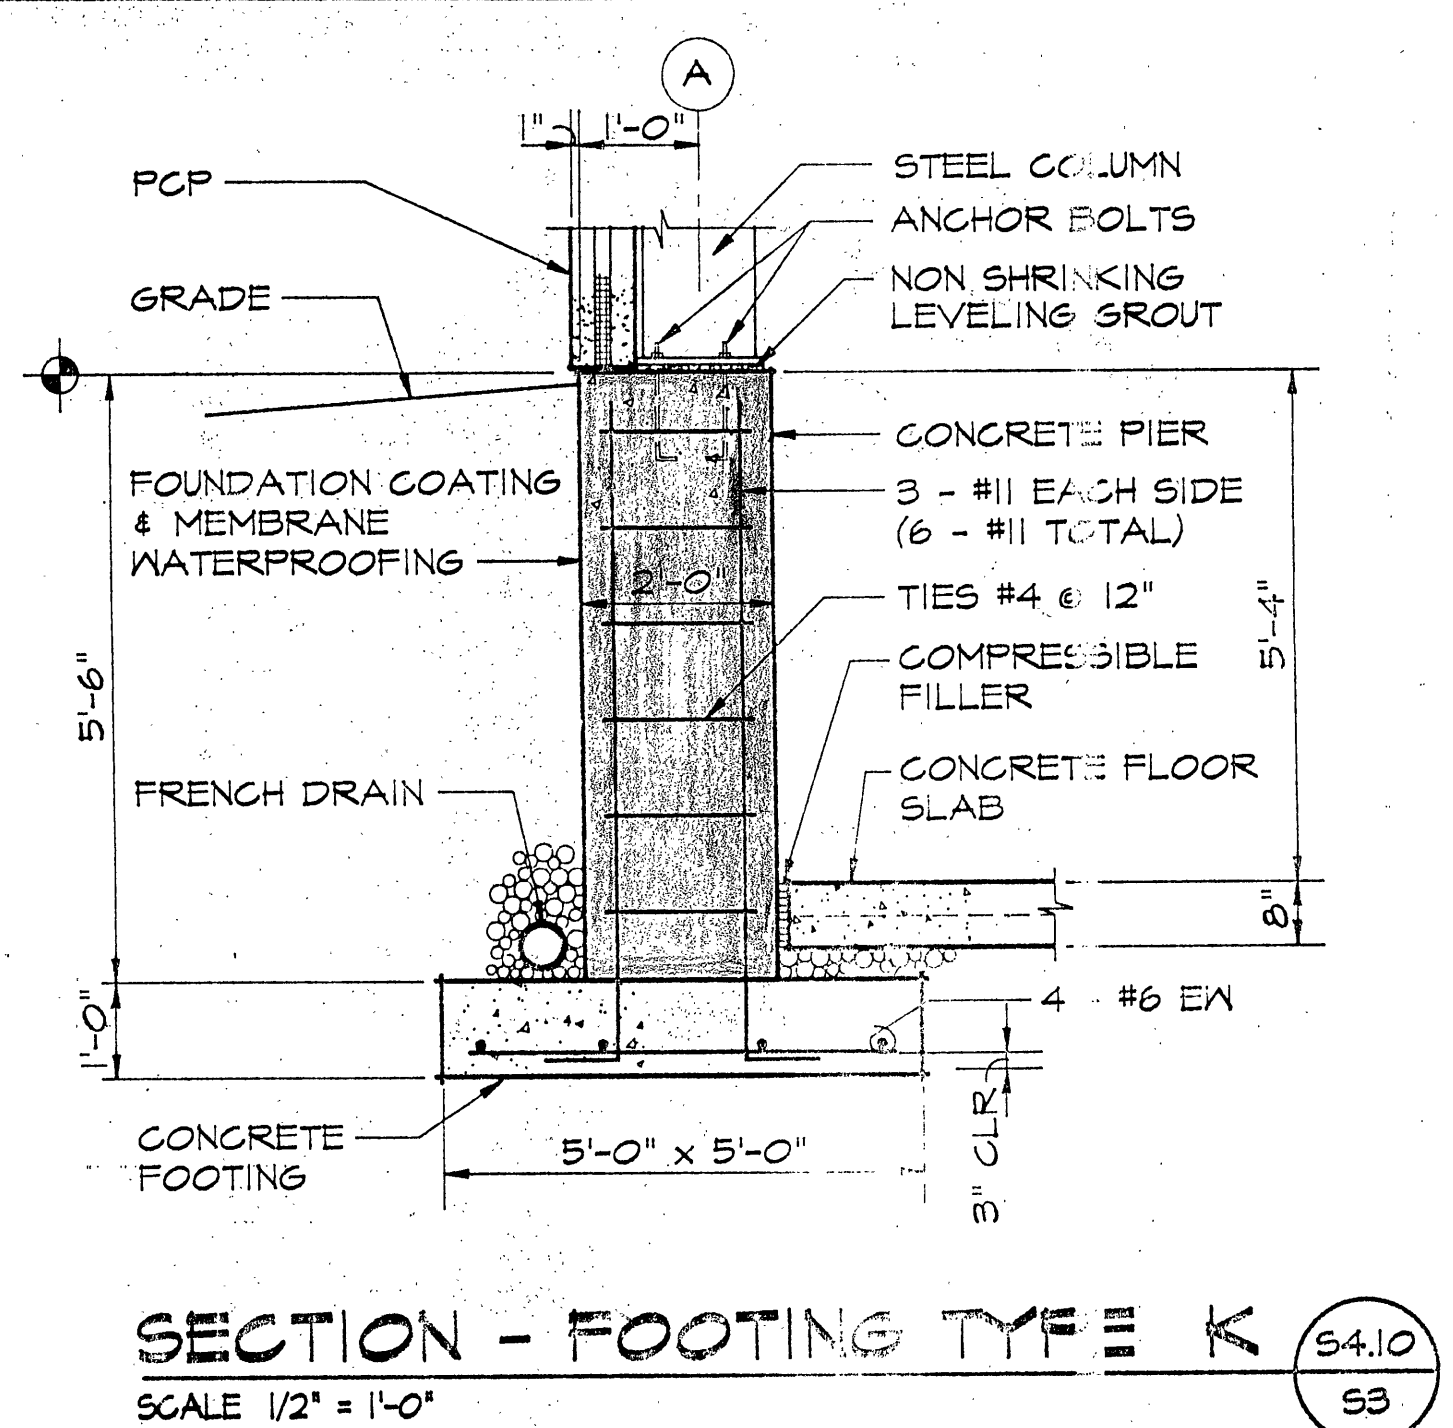
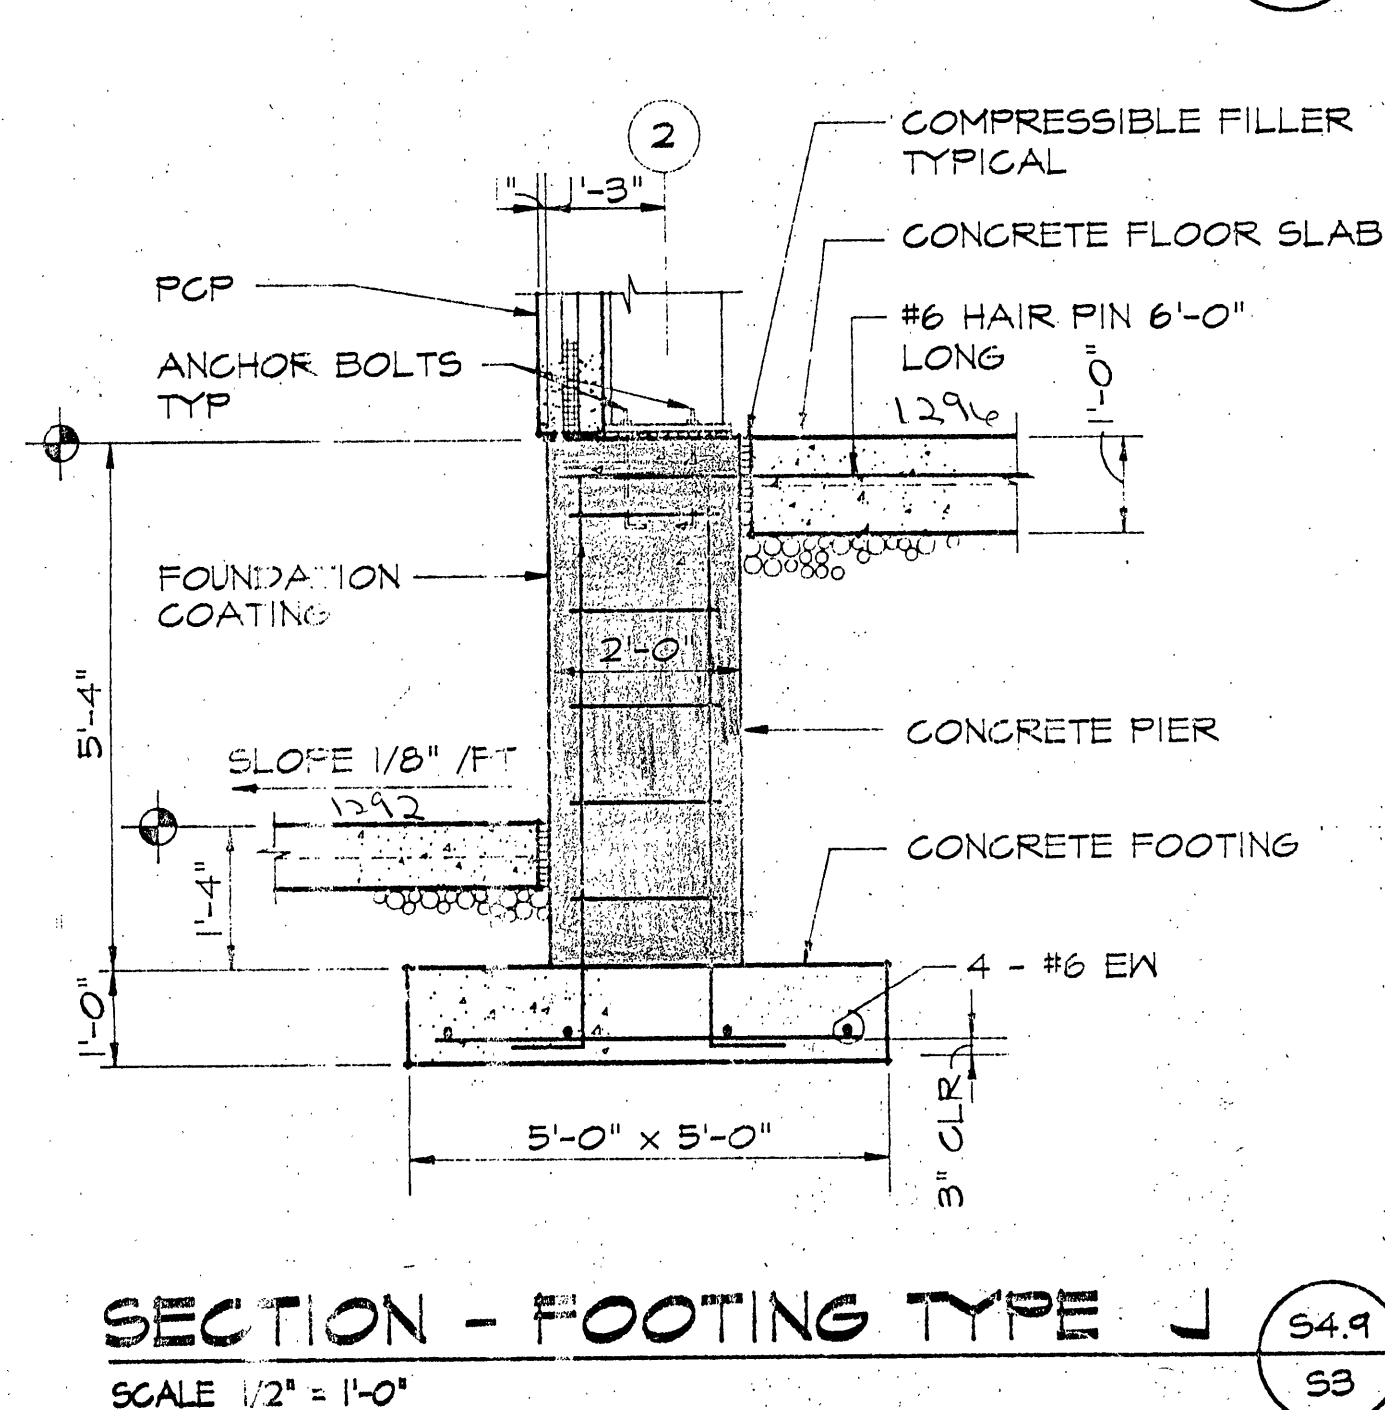
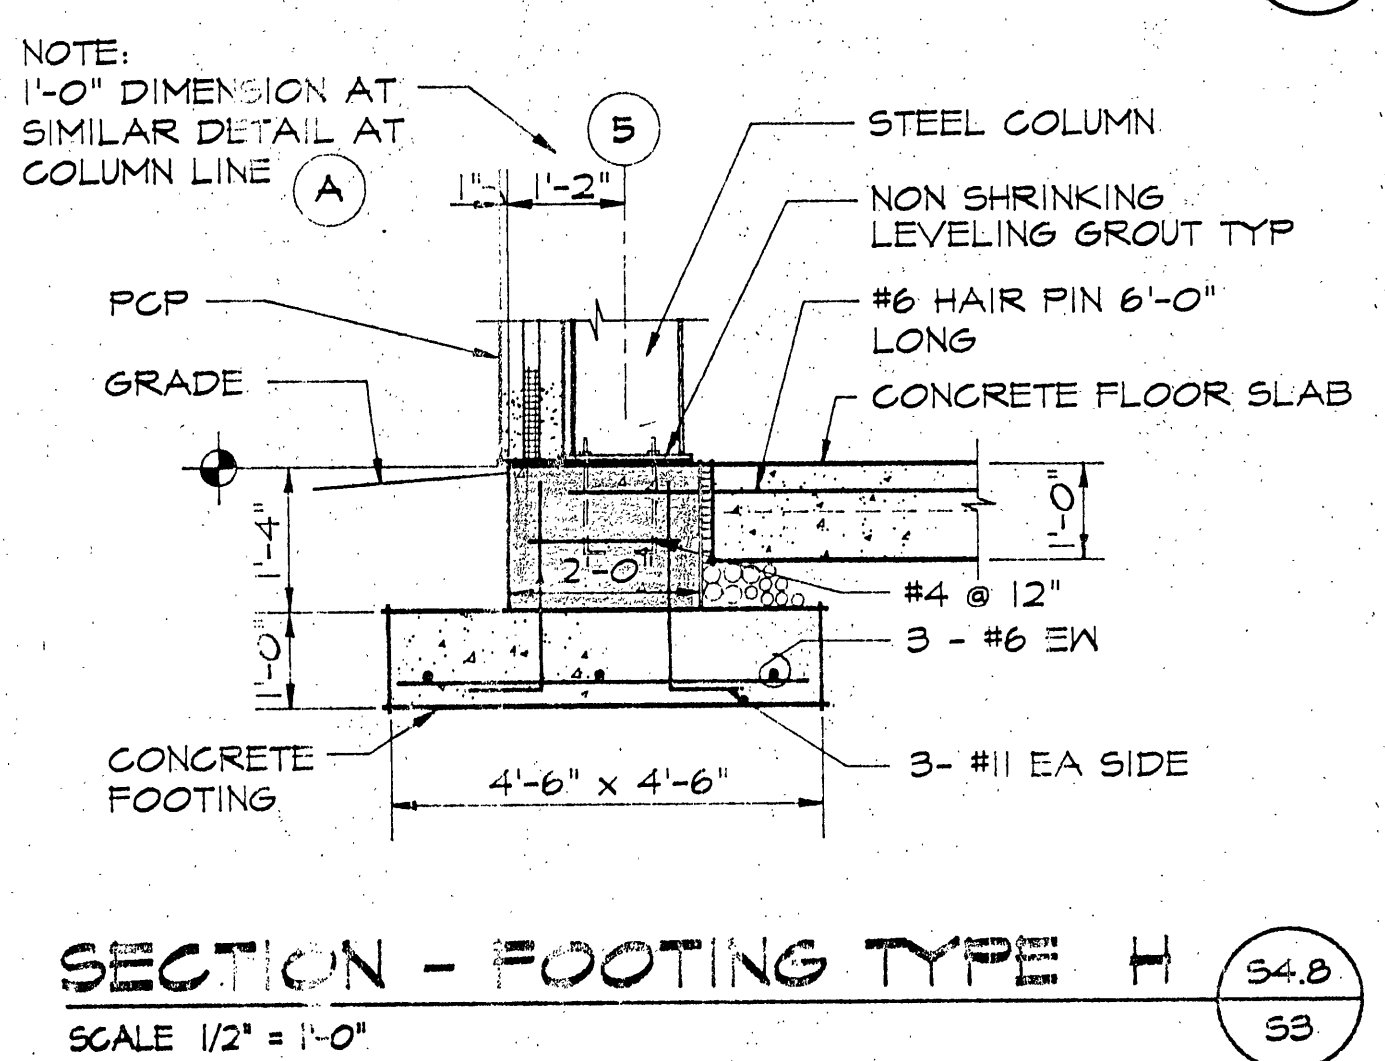
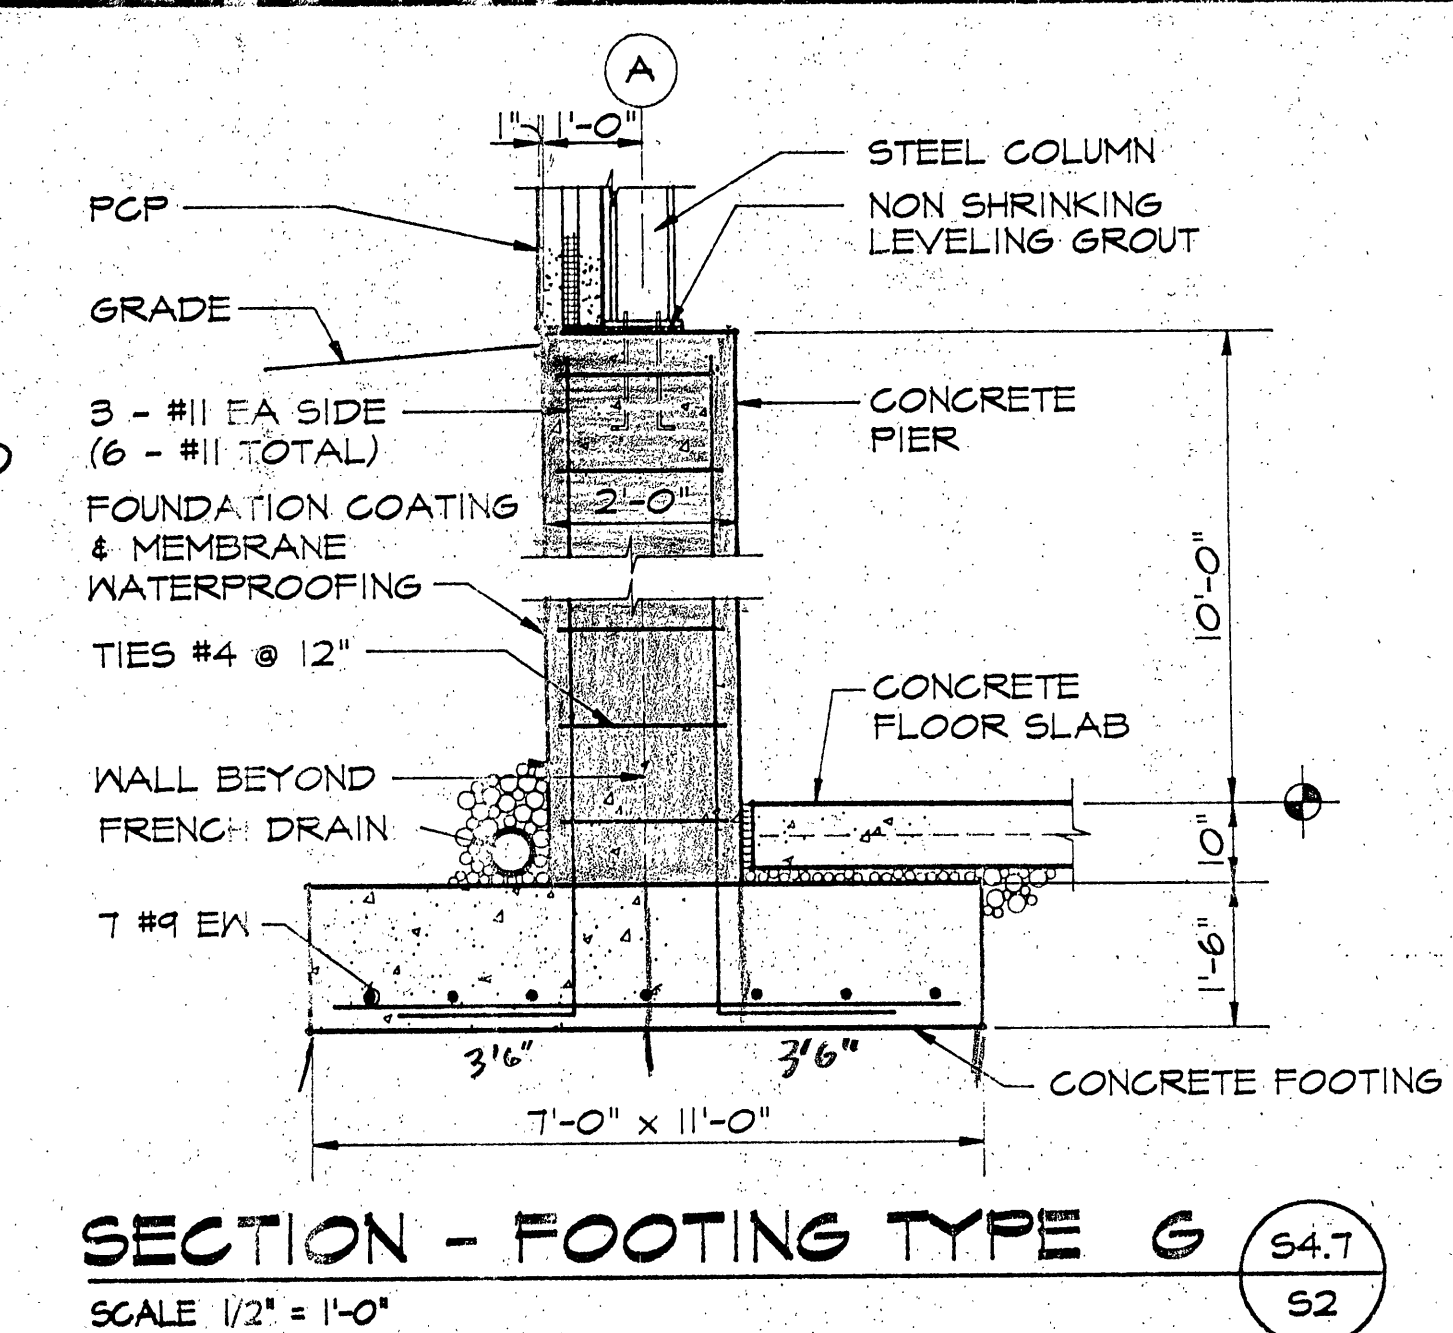
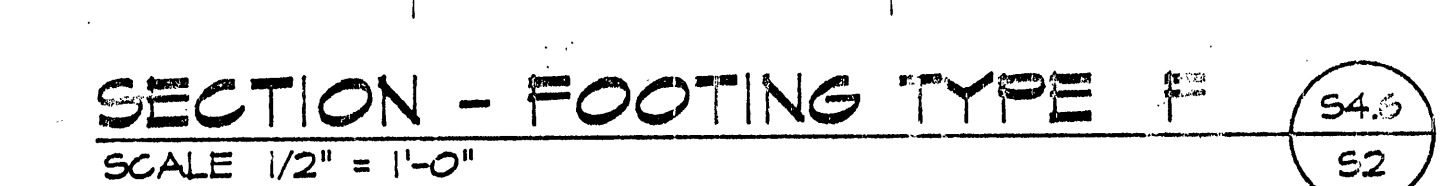
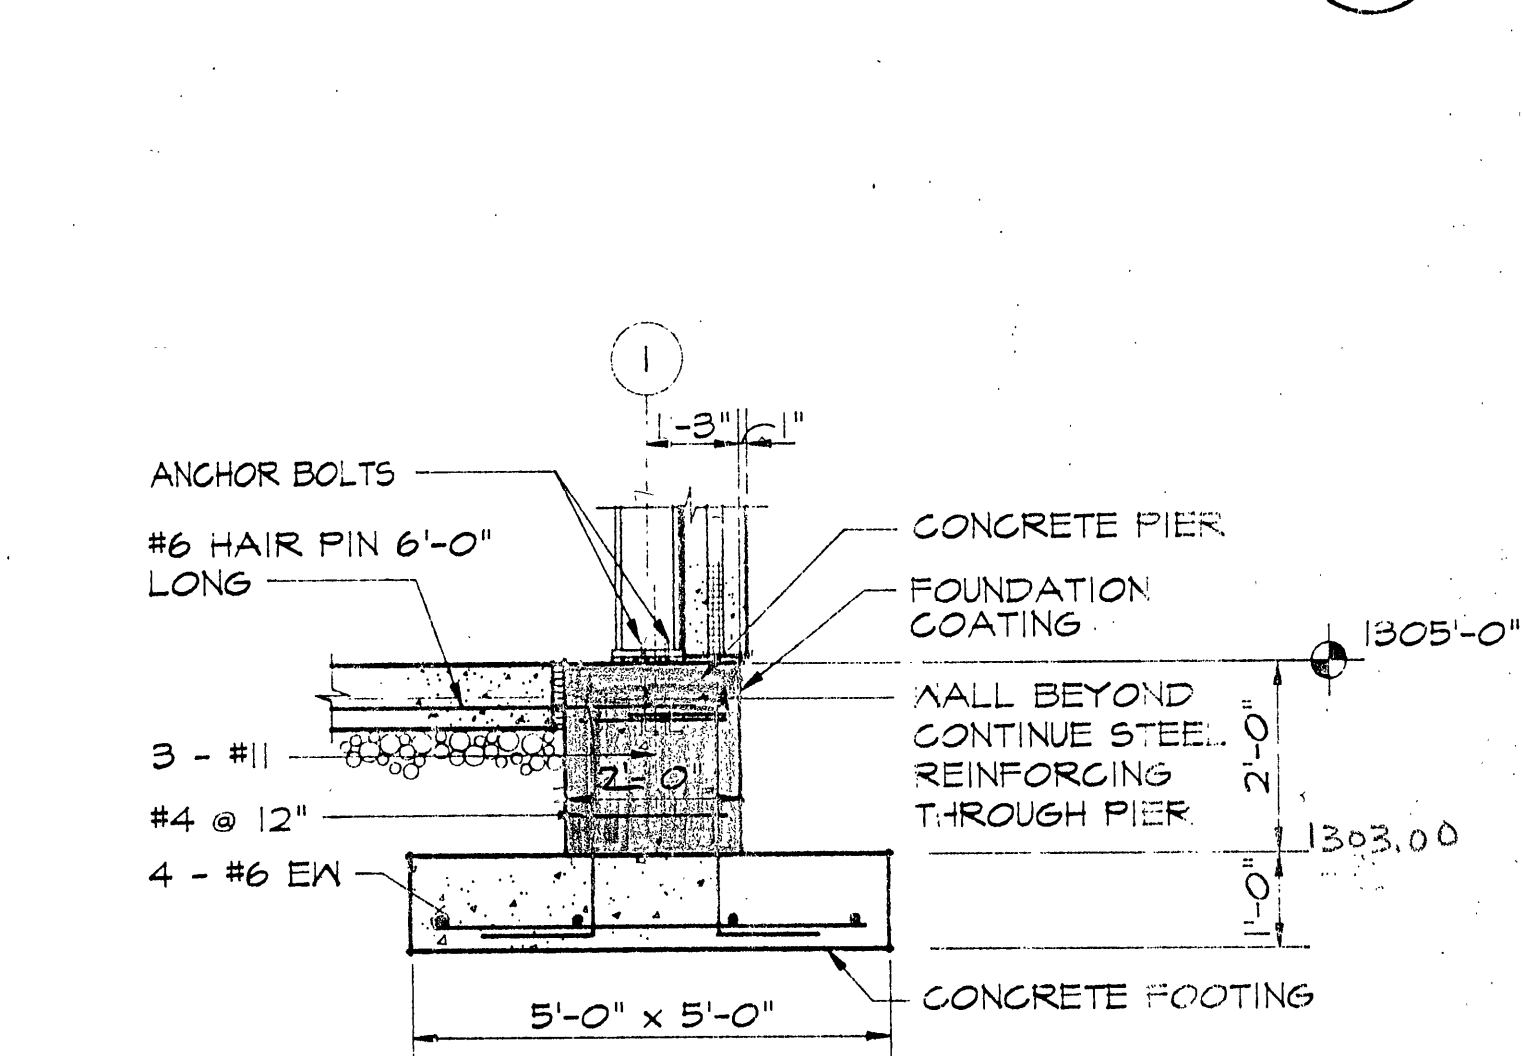
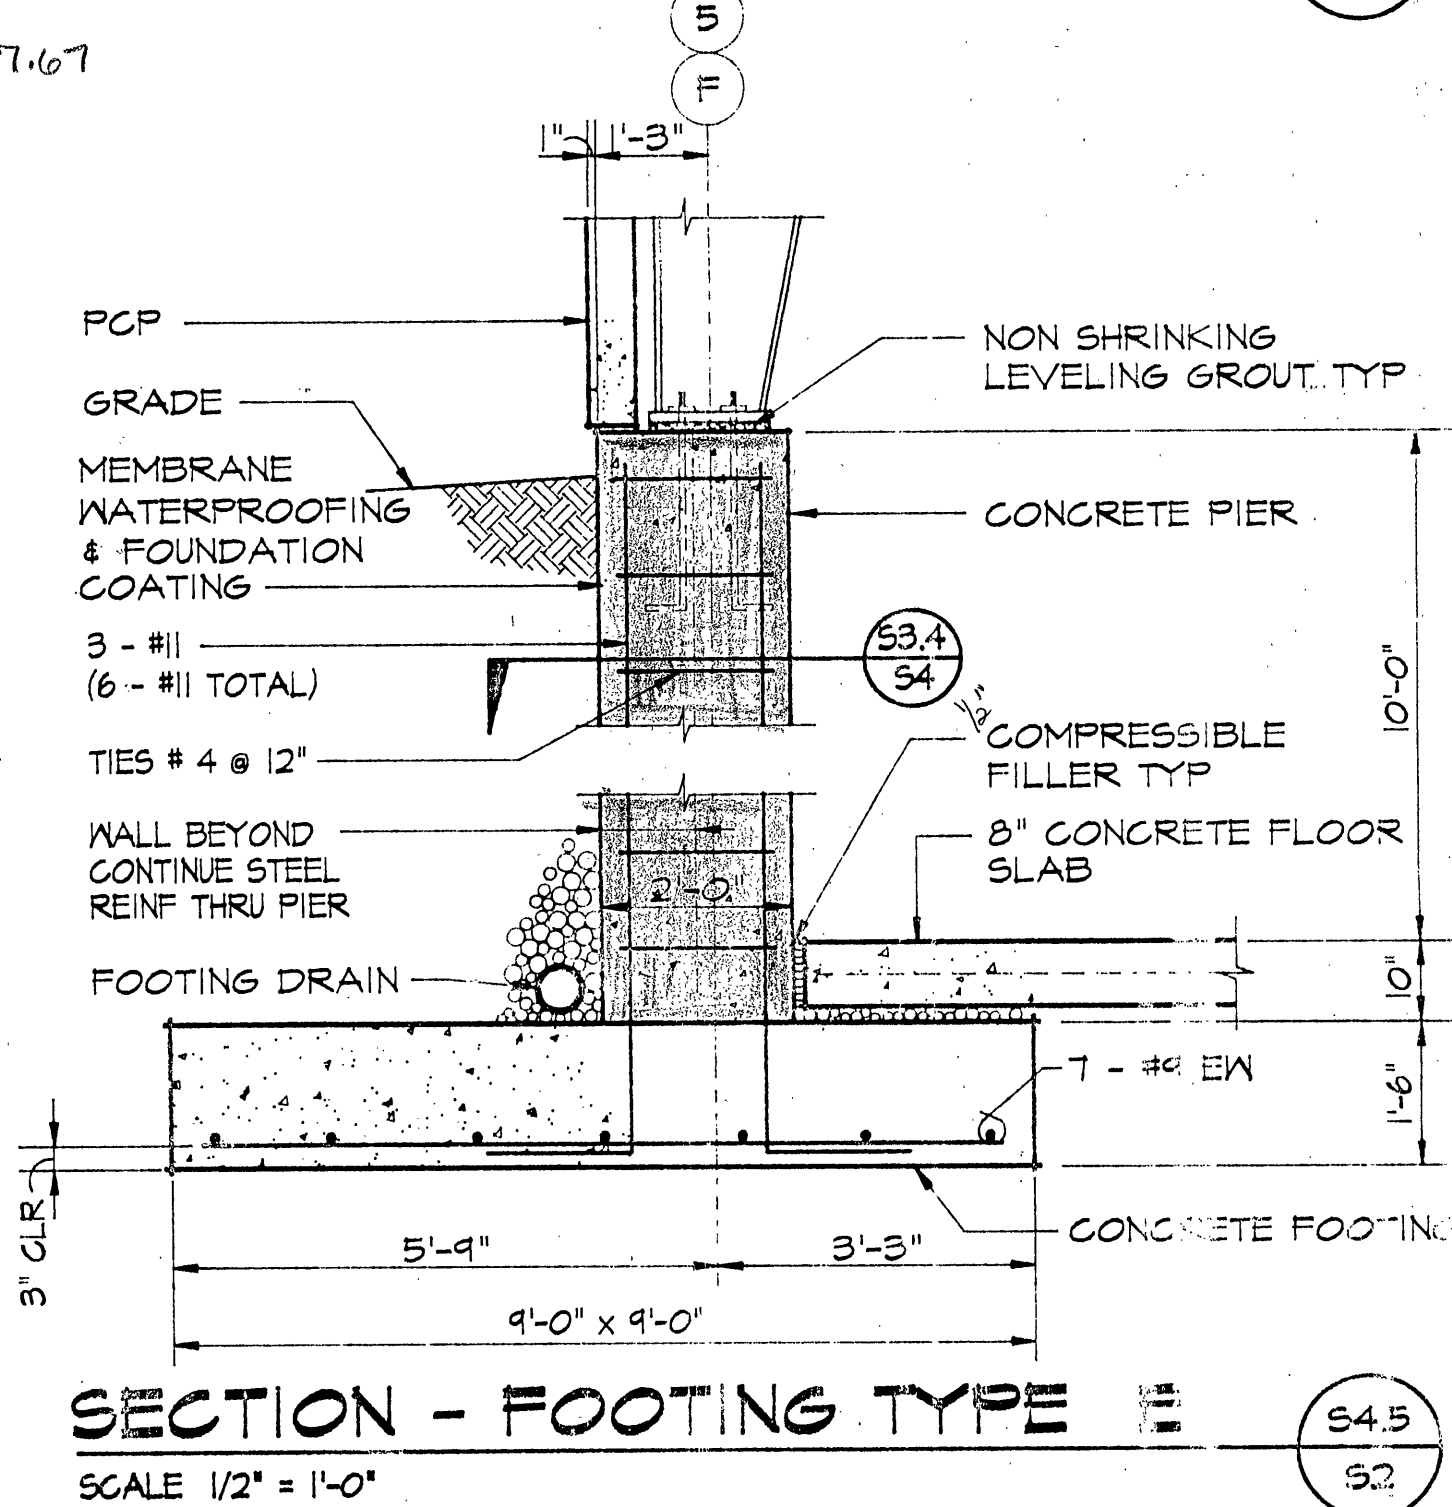
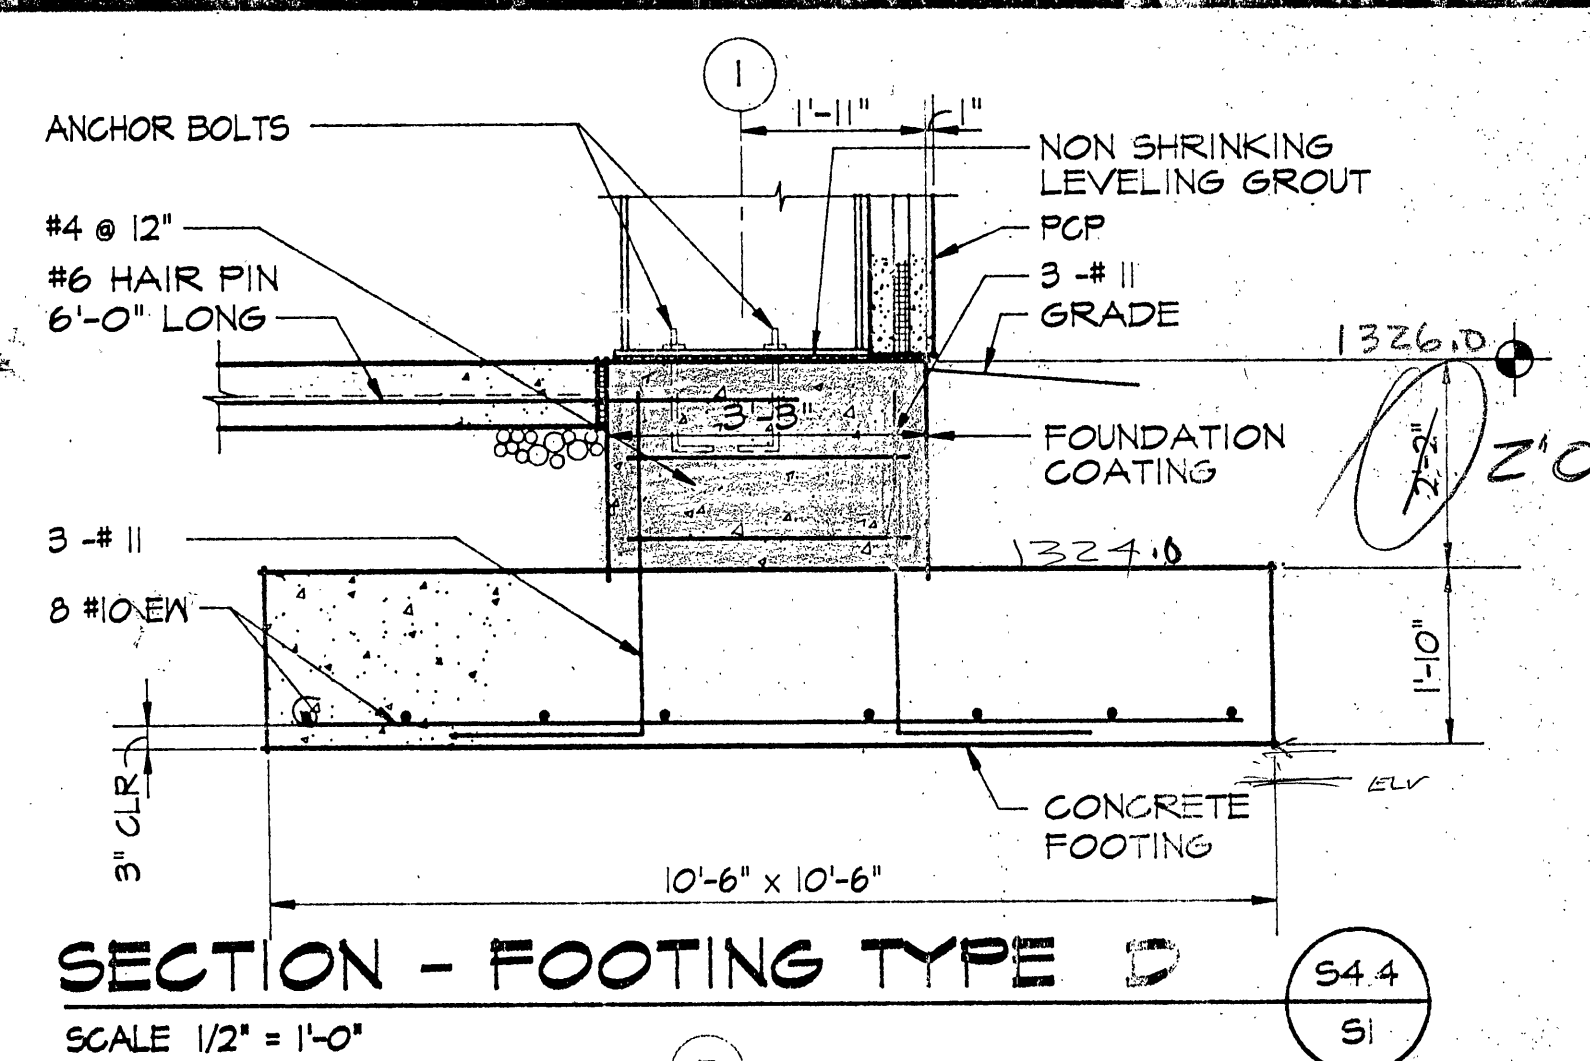
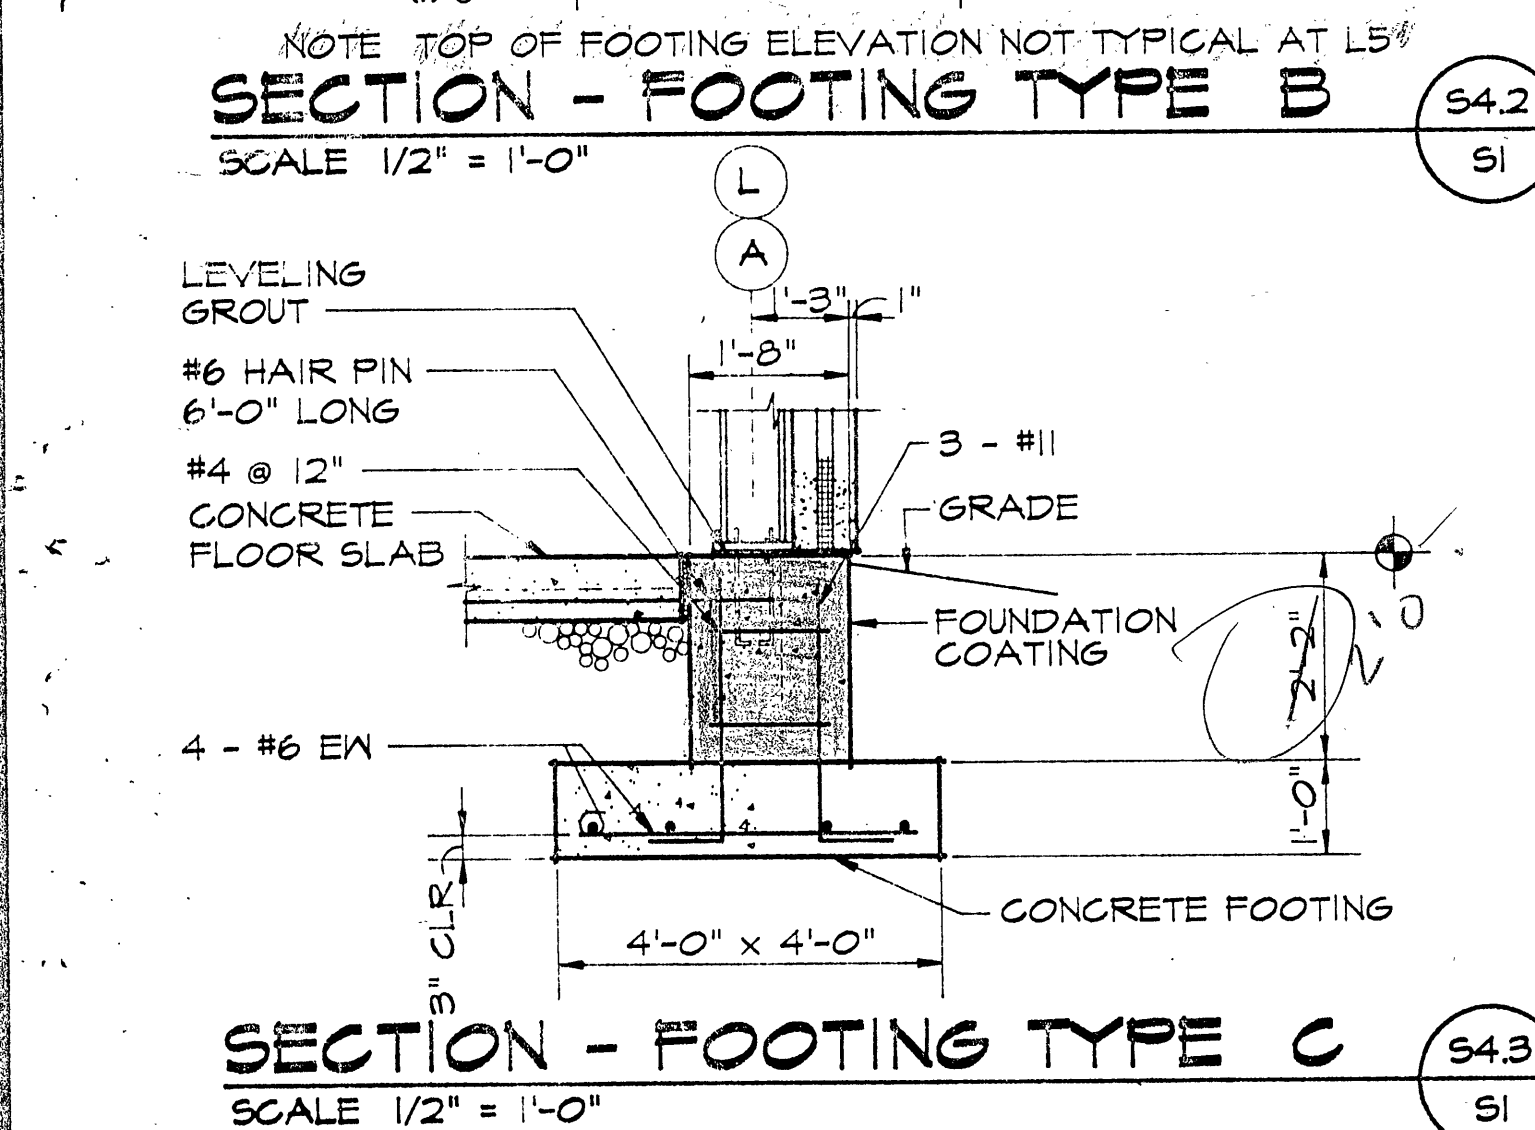
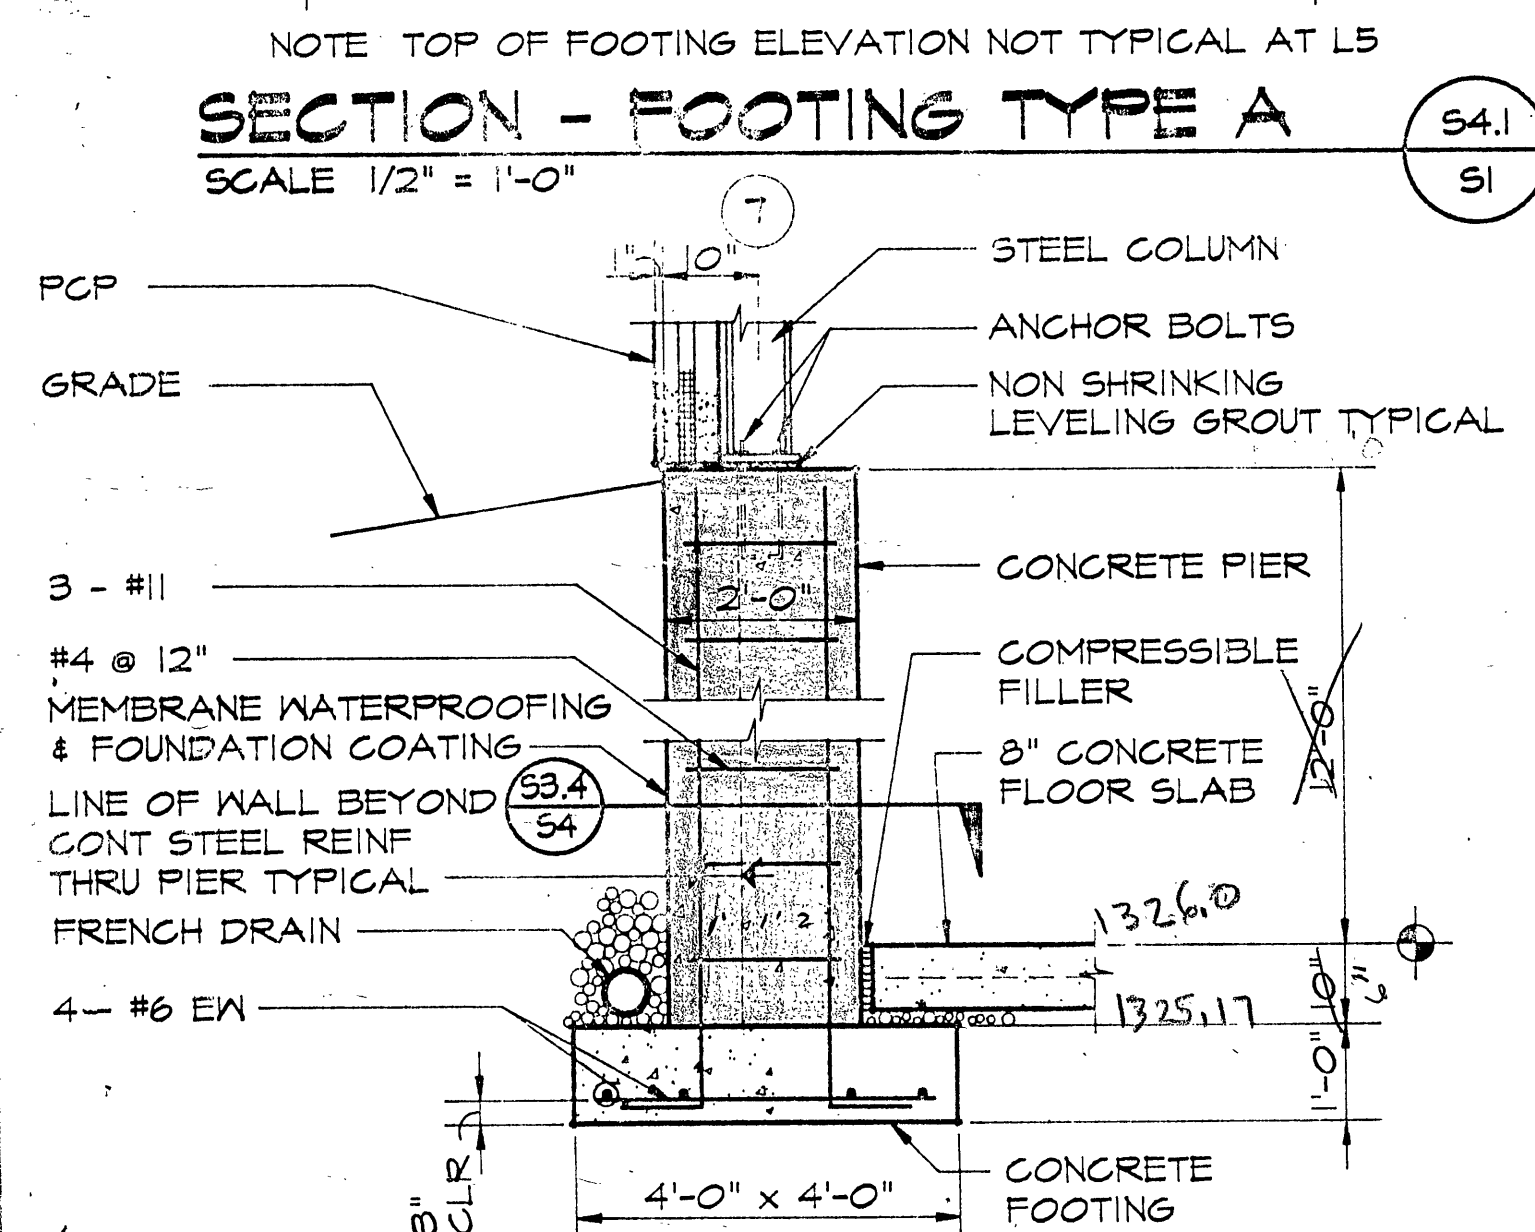


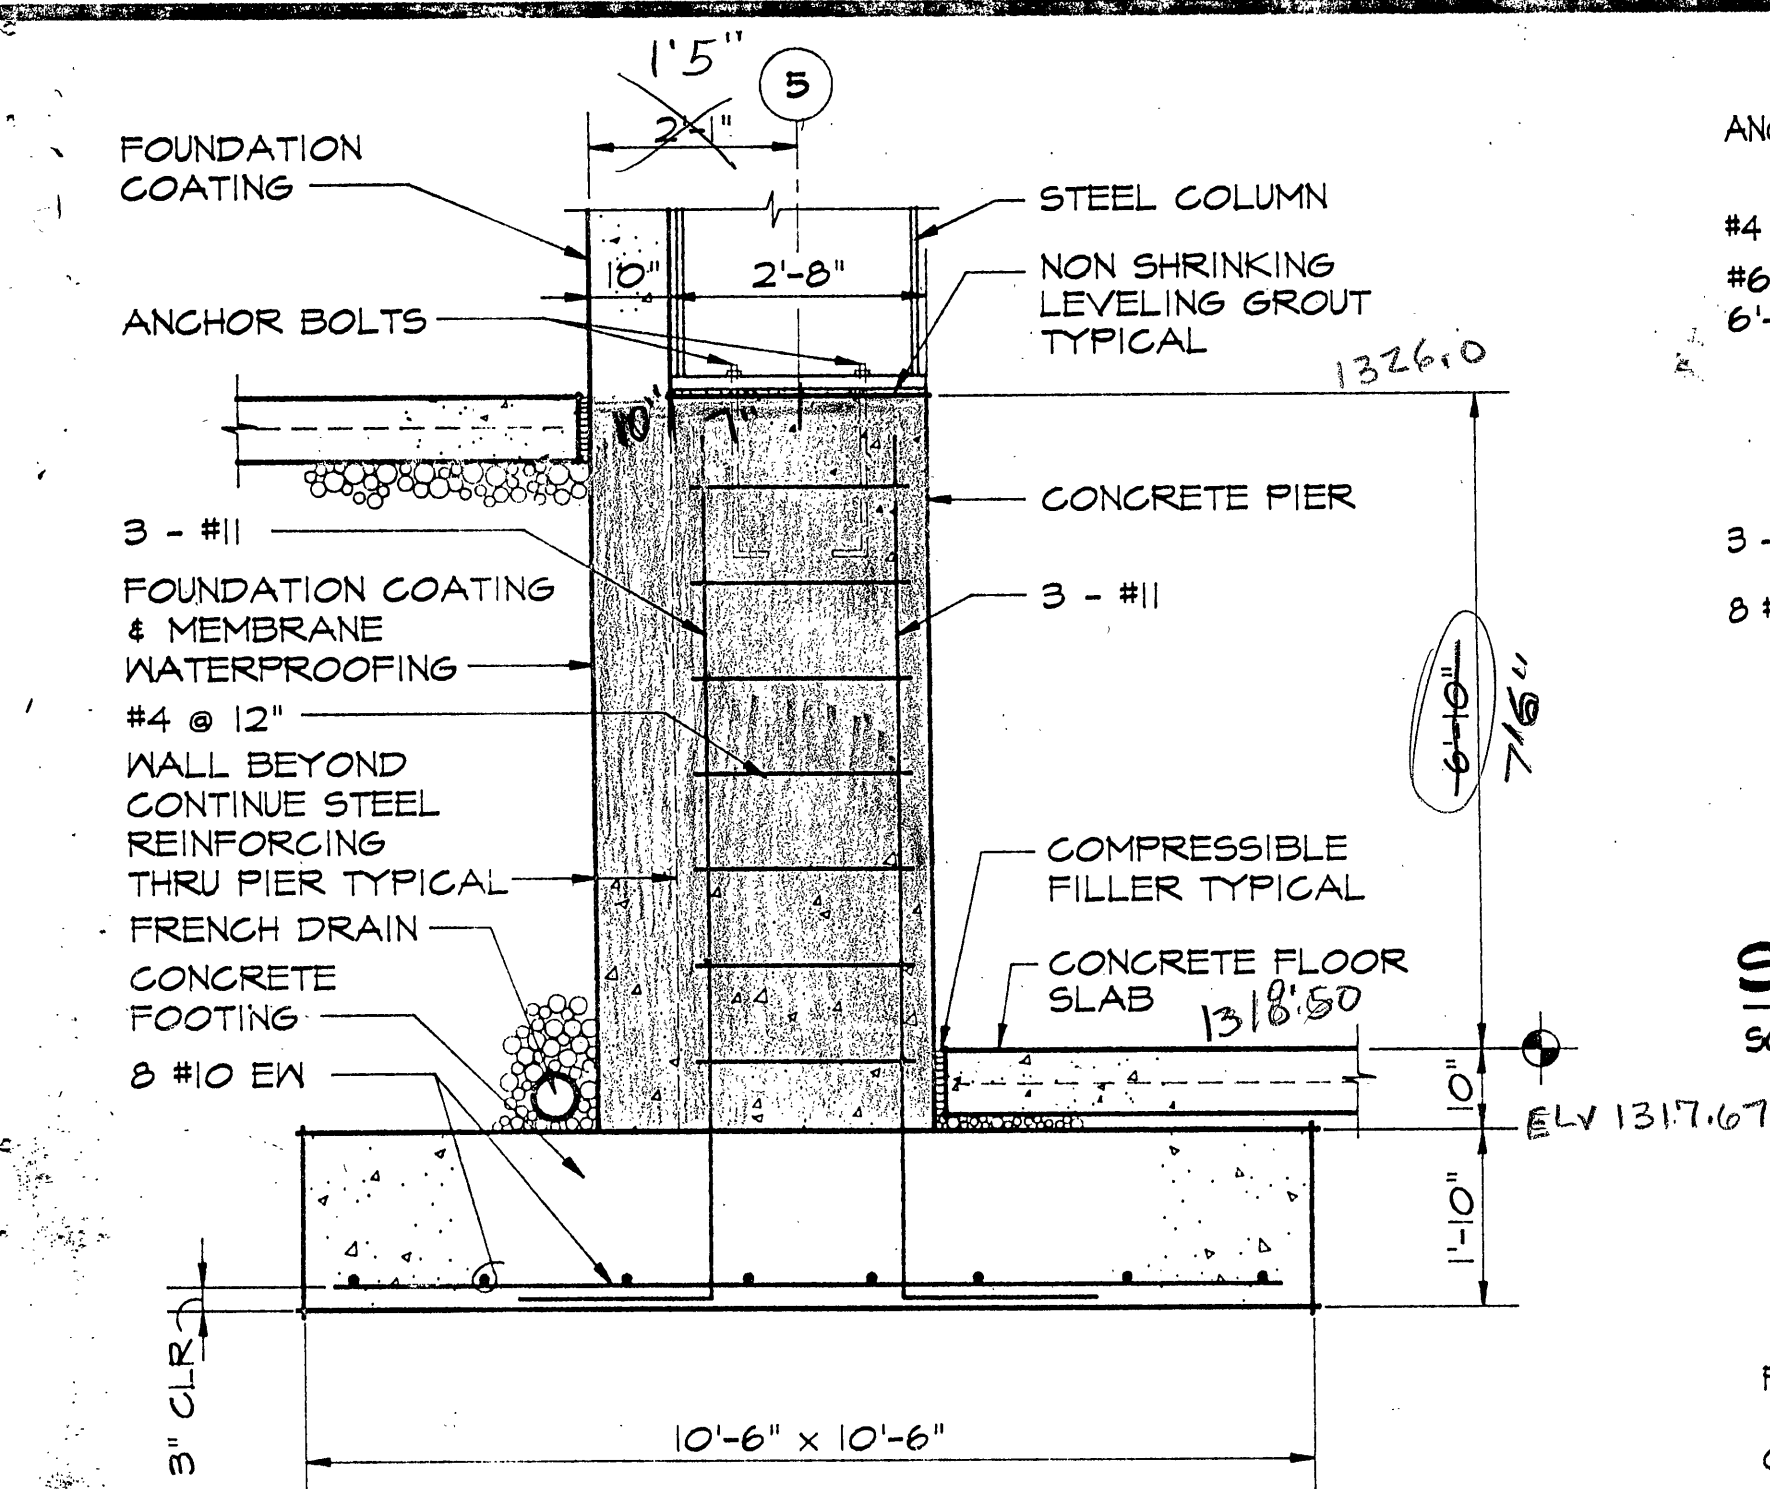


NOTE
CONTRACTOR SHALL COORDINATE
SIZES AND CONFIGURATION OF ANCHOR
BOLTS AND BASE PLATES WITH
PRE ENGINEERED BUILDING MANUFACTURER

INSPECTOR'S AS-BUILTS 1995

WVWA ID# 6LDLWZ

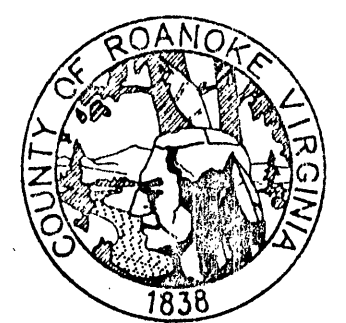

ROANOKE COUNTY WATER TREATMENT FACILITY

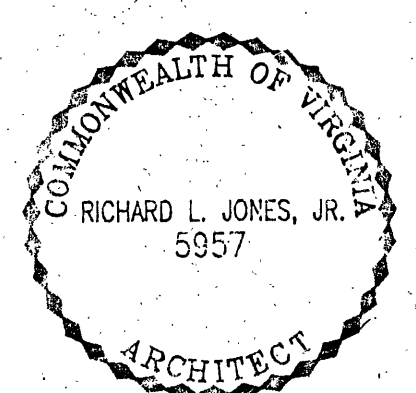

FOOTING SECTIONS		S4
PROJECT ARCHITECT RLJ JS	COMMISSION NUMBER 1913	
TECHNICIANS RAIT	DATE 22 SEPT 1994	