




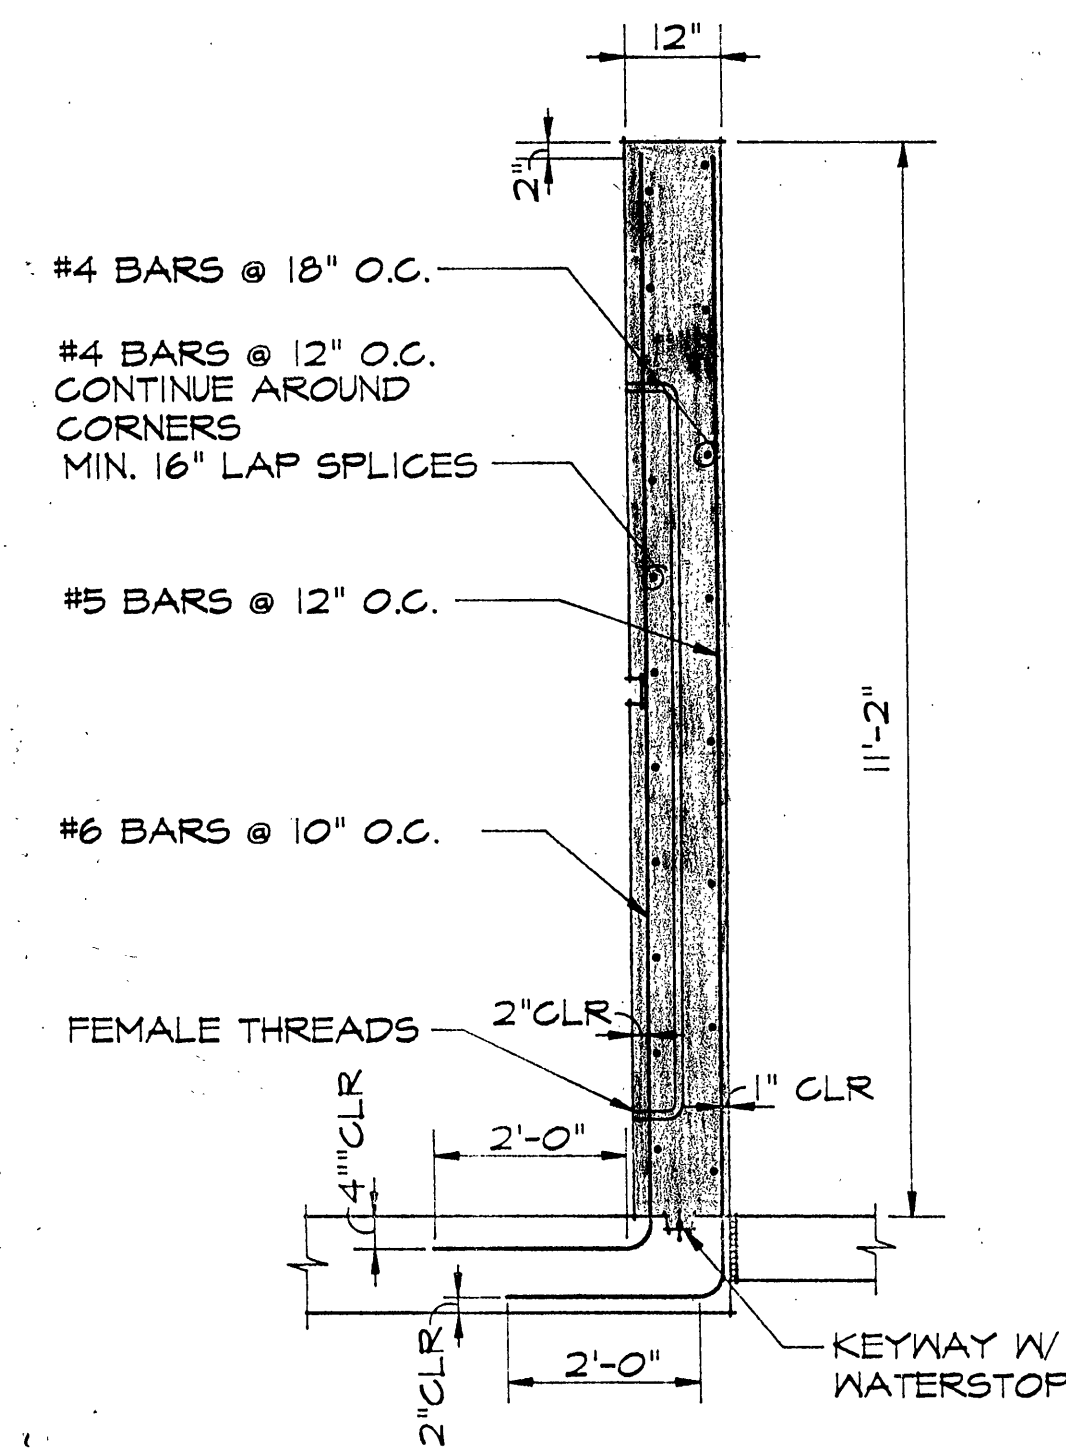


SECTION
SCALE 1/2" = 1'-0"
56.1
SI

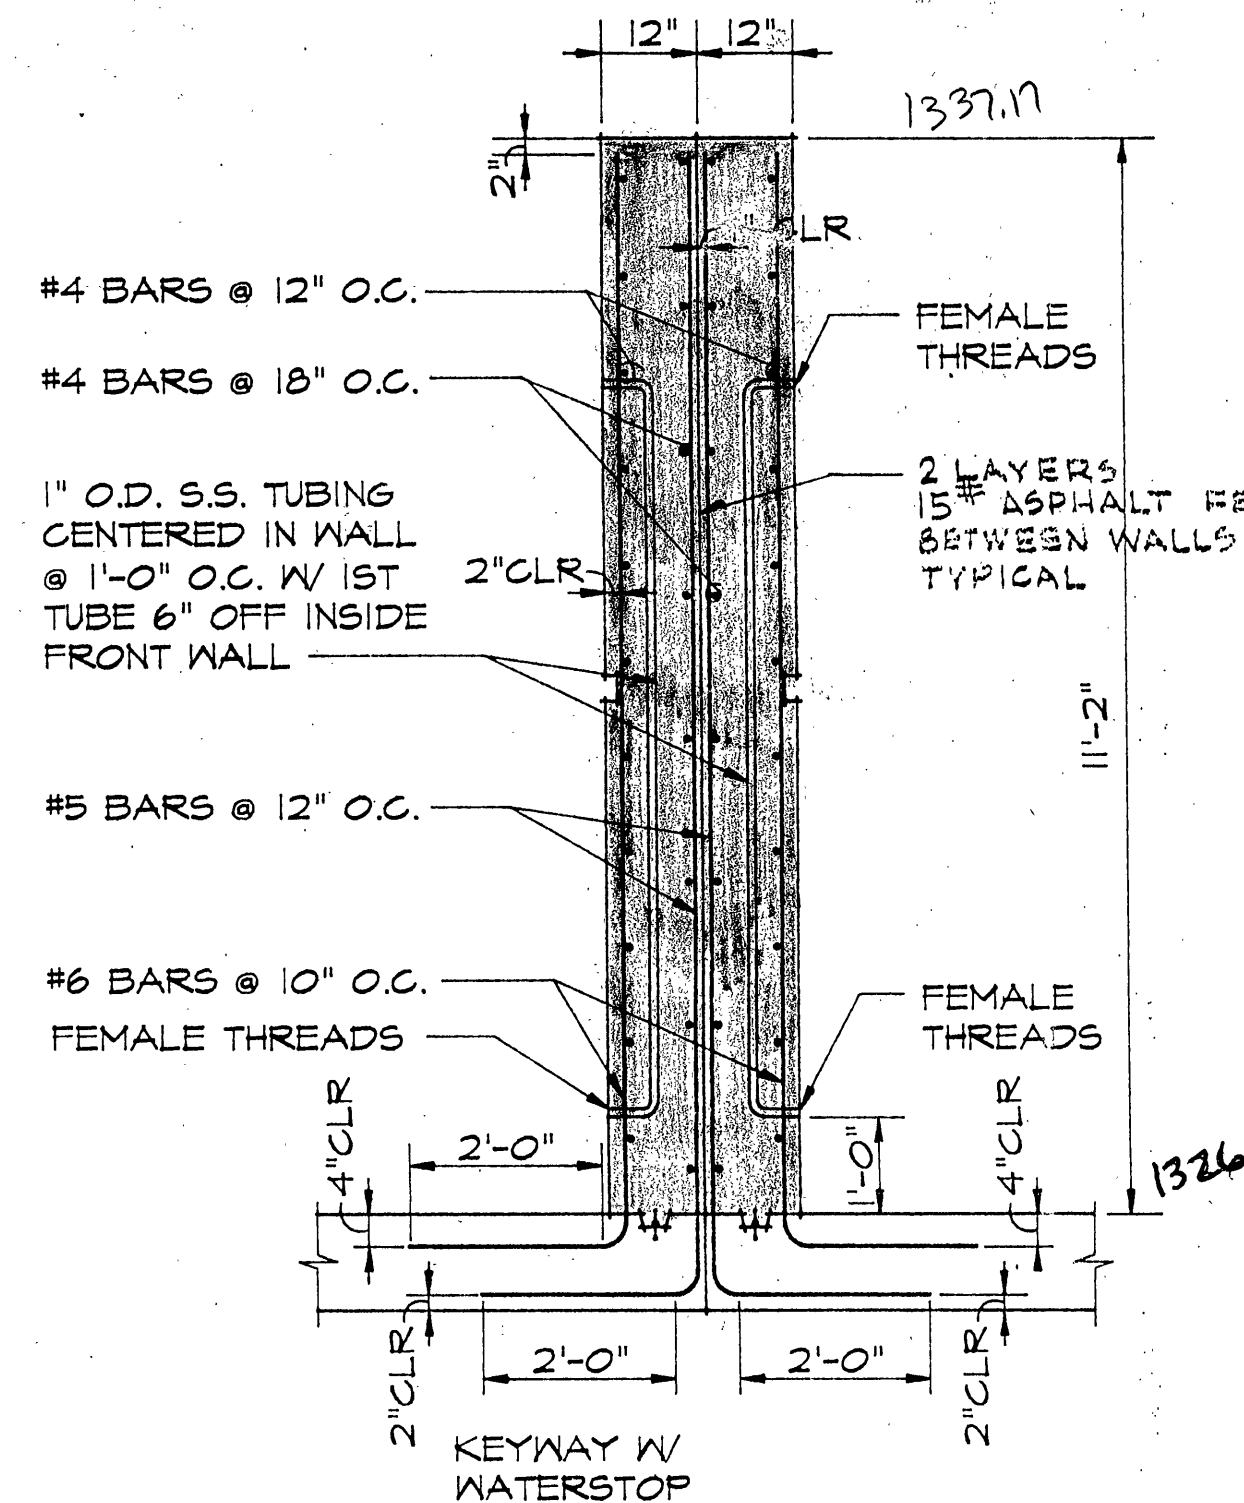


SECTION
SCALE 1/2" = 1'-0"
56.2
SI

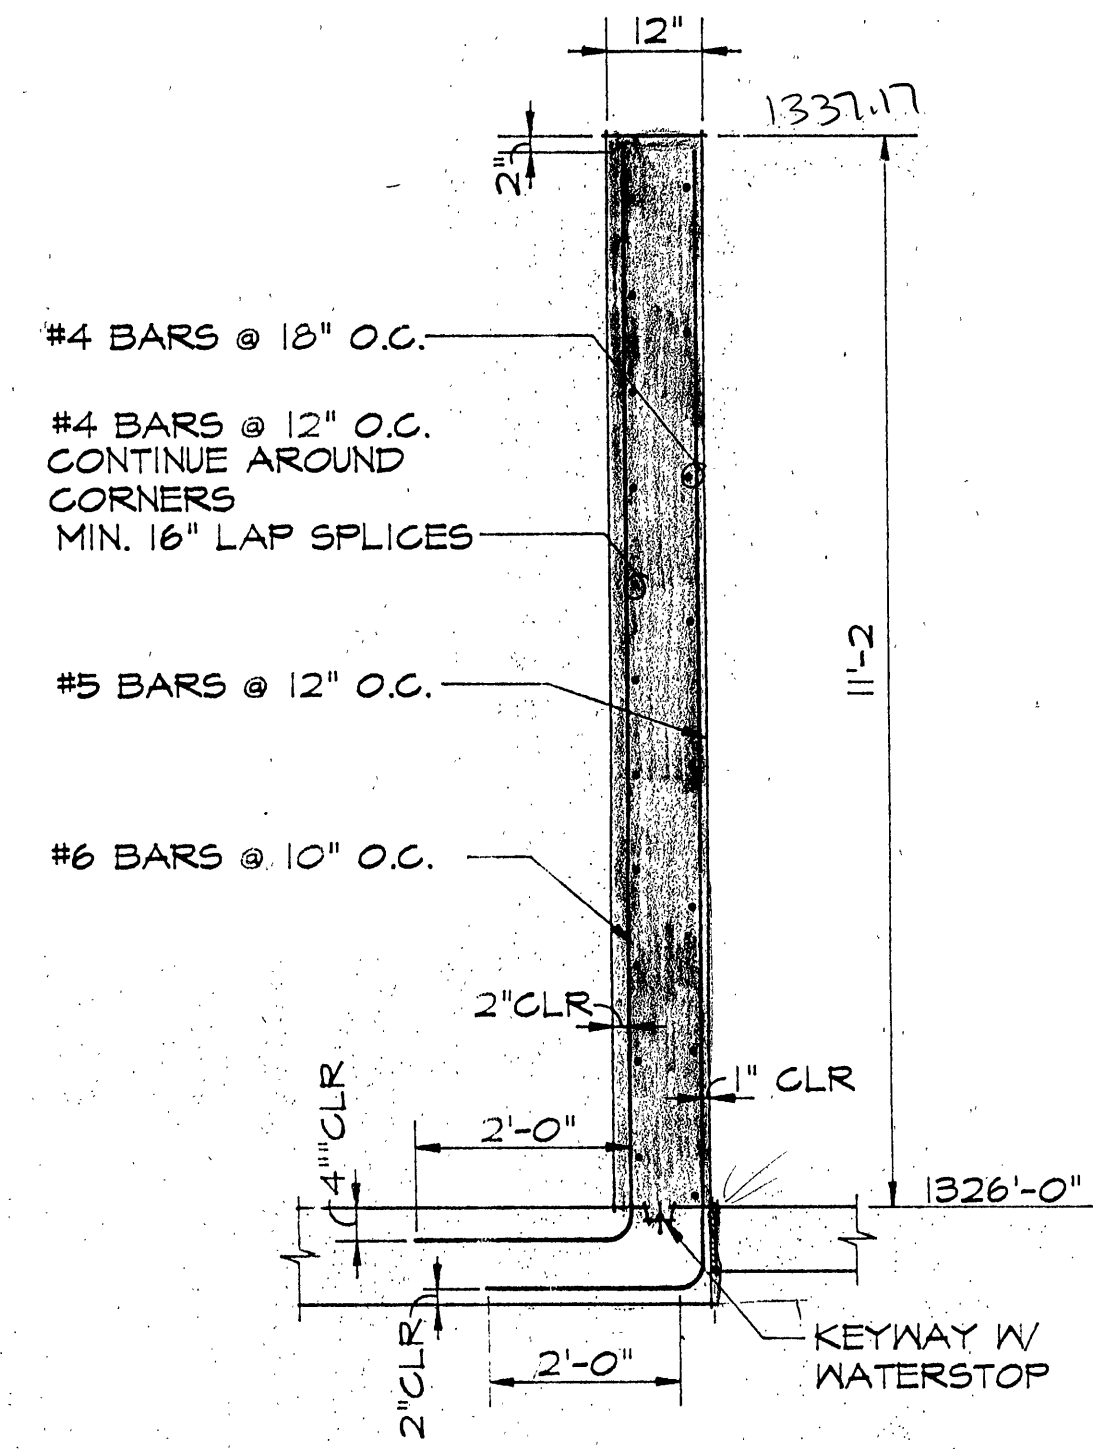


SECTION
SCALE 1/2" = 1'-0"
56.3
SI

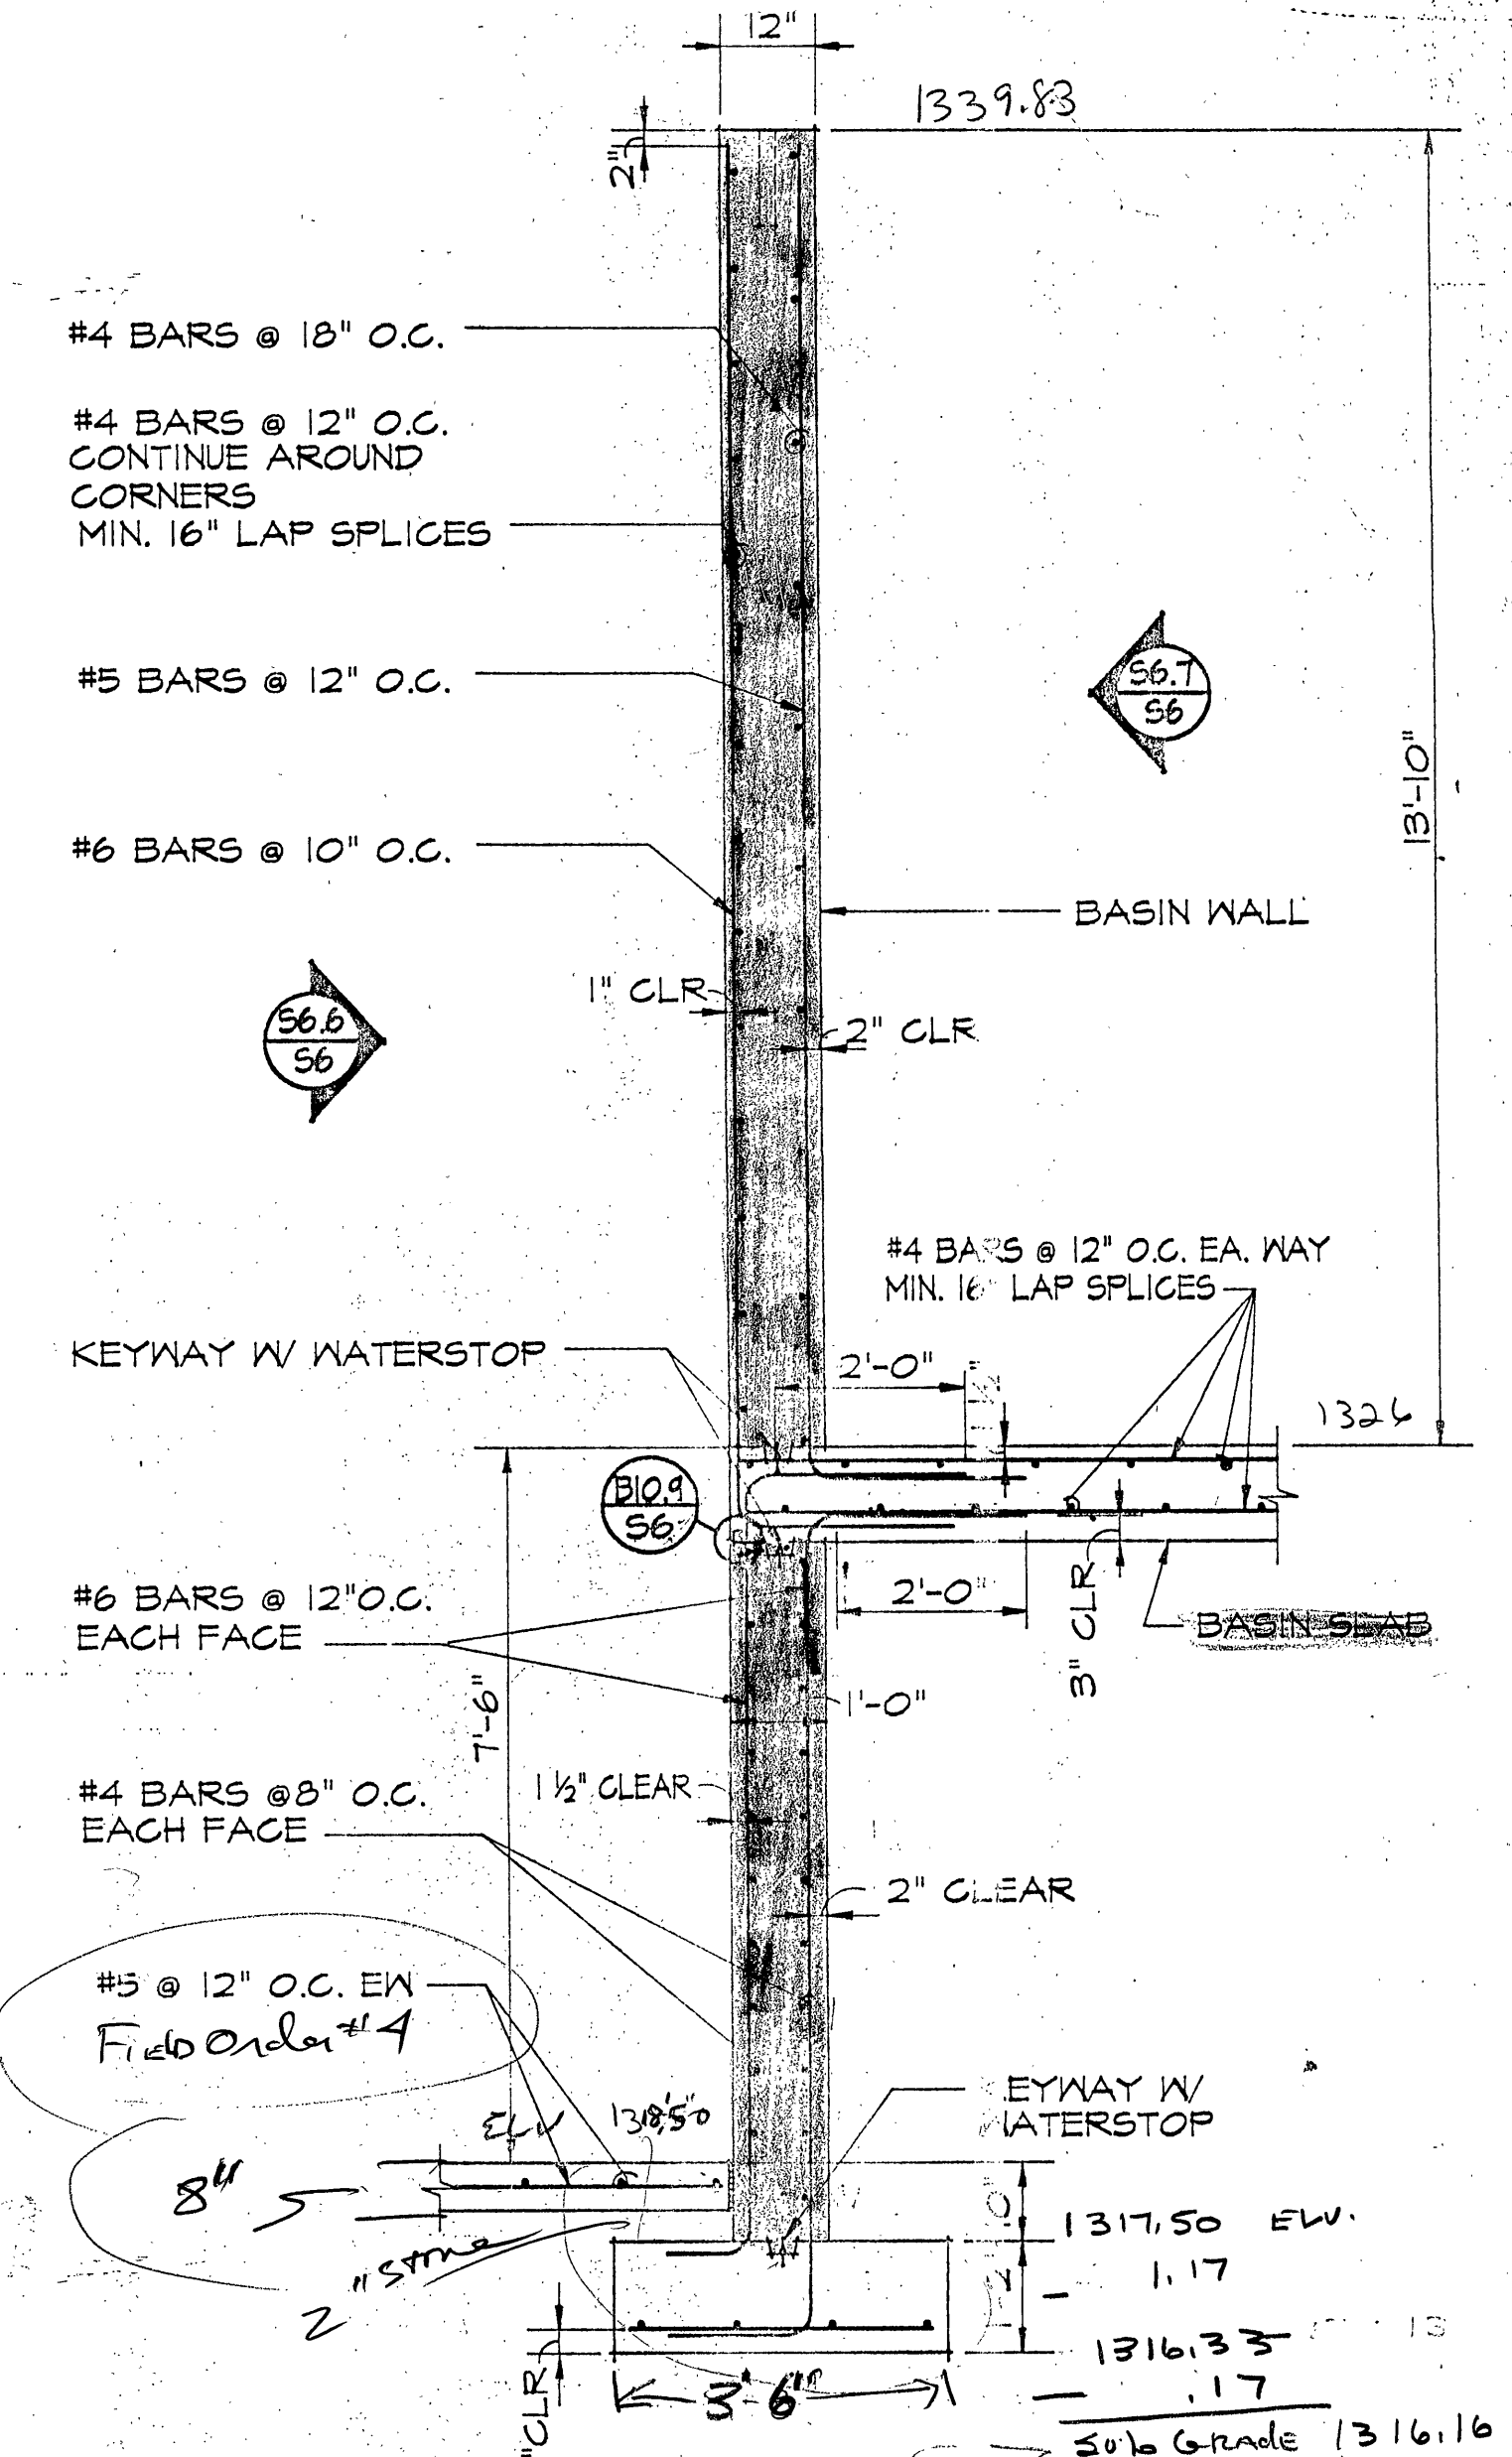


SECTION
SCALE 1/2" = 1'-0"
56.4
SI

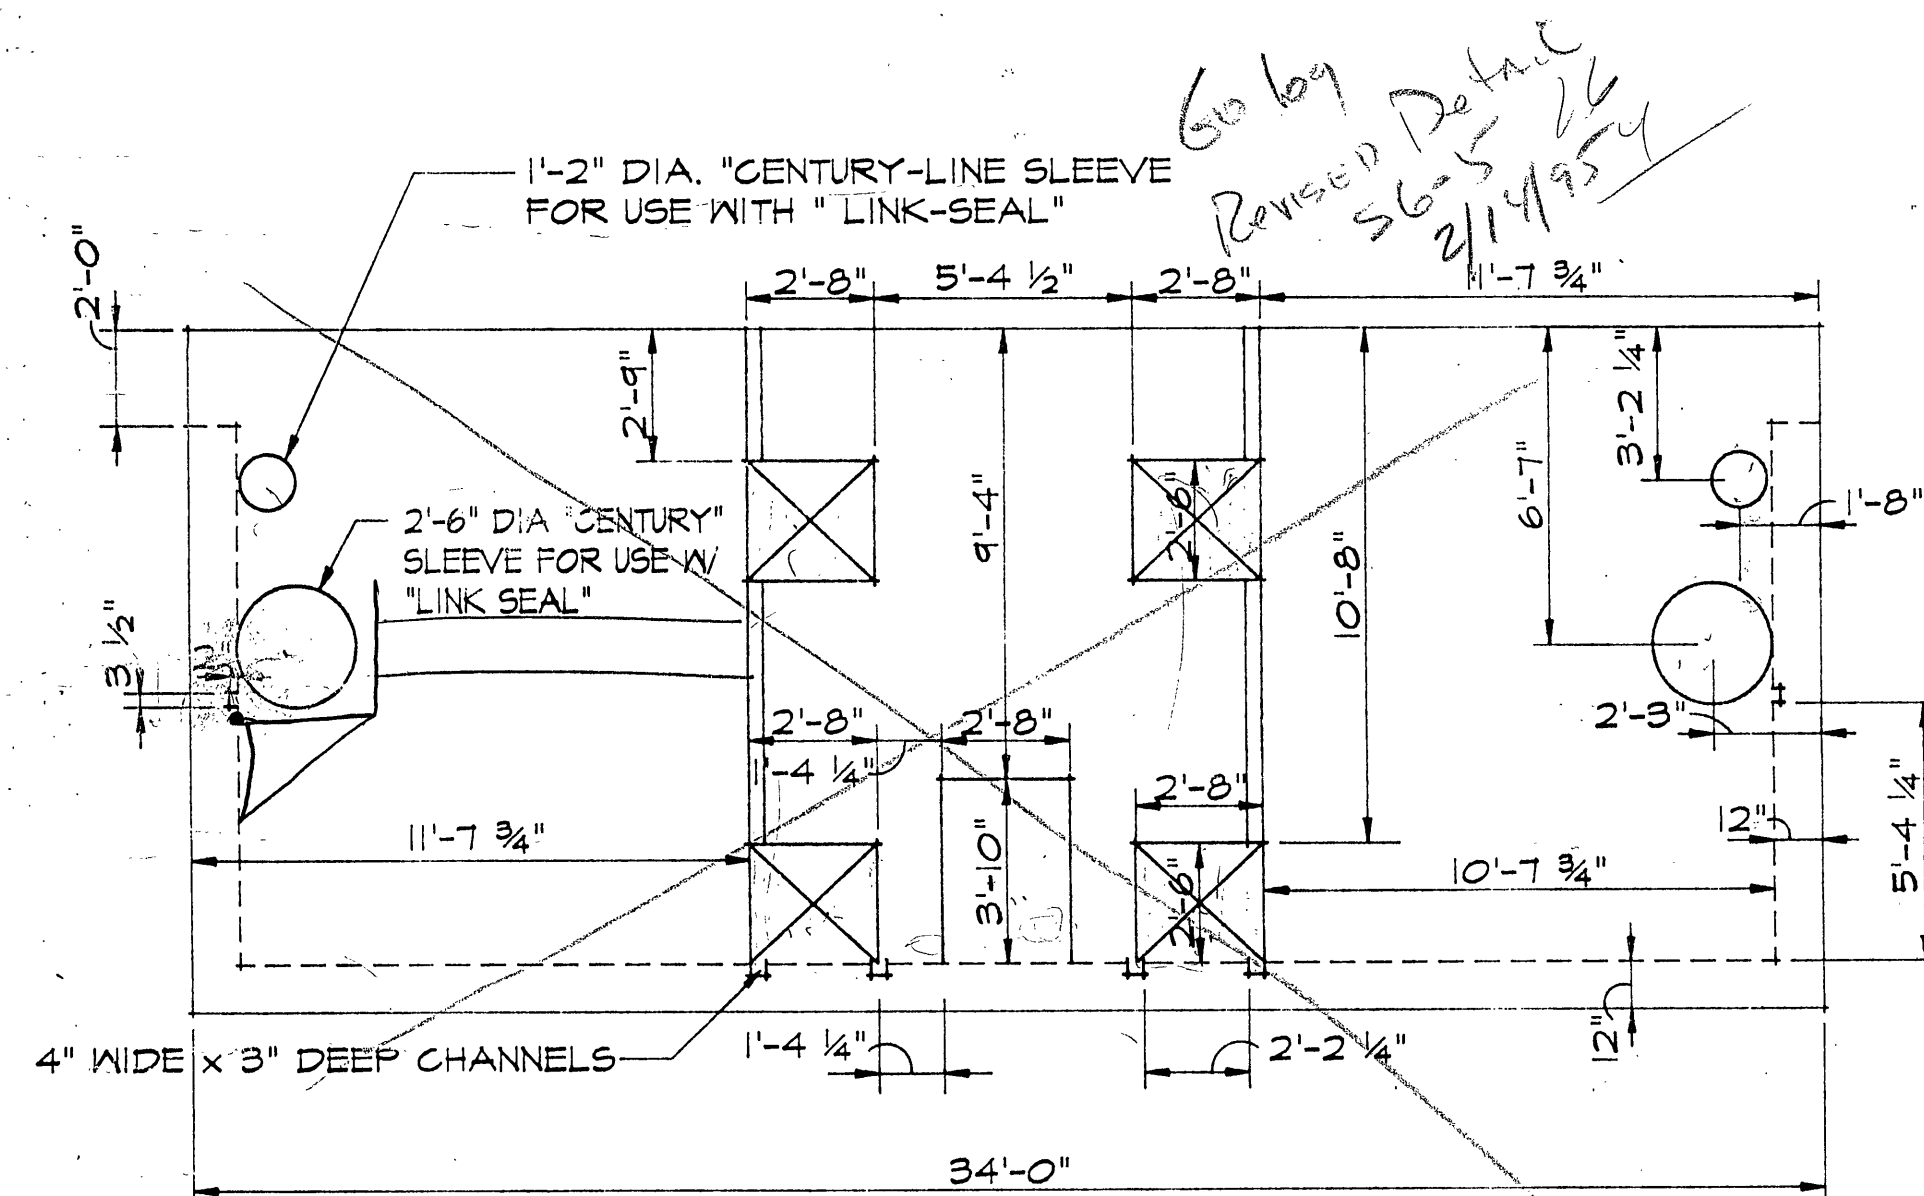

ELEVATION - TREATMENT BASIN OPENINGS
SCALE 1/4" = 1'-0"
56.5
SI

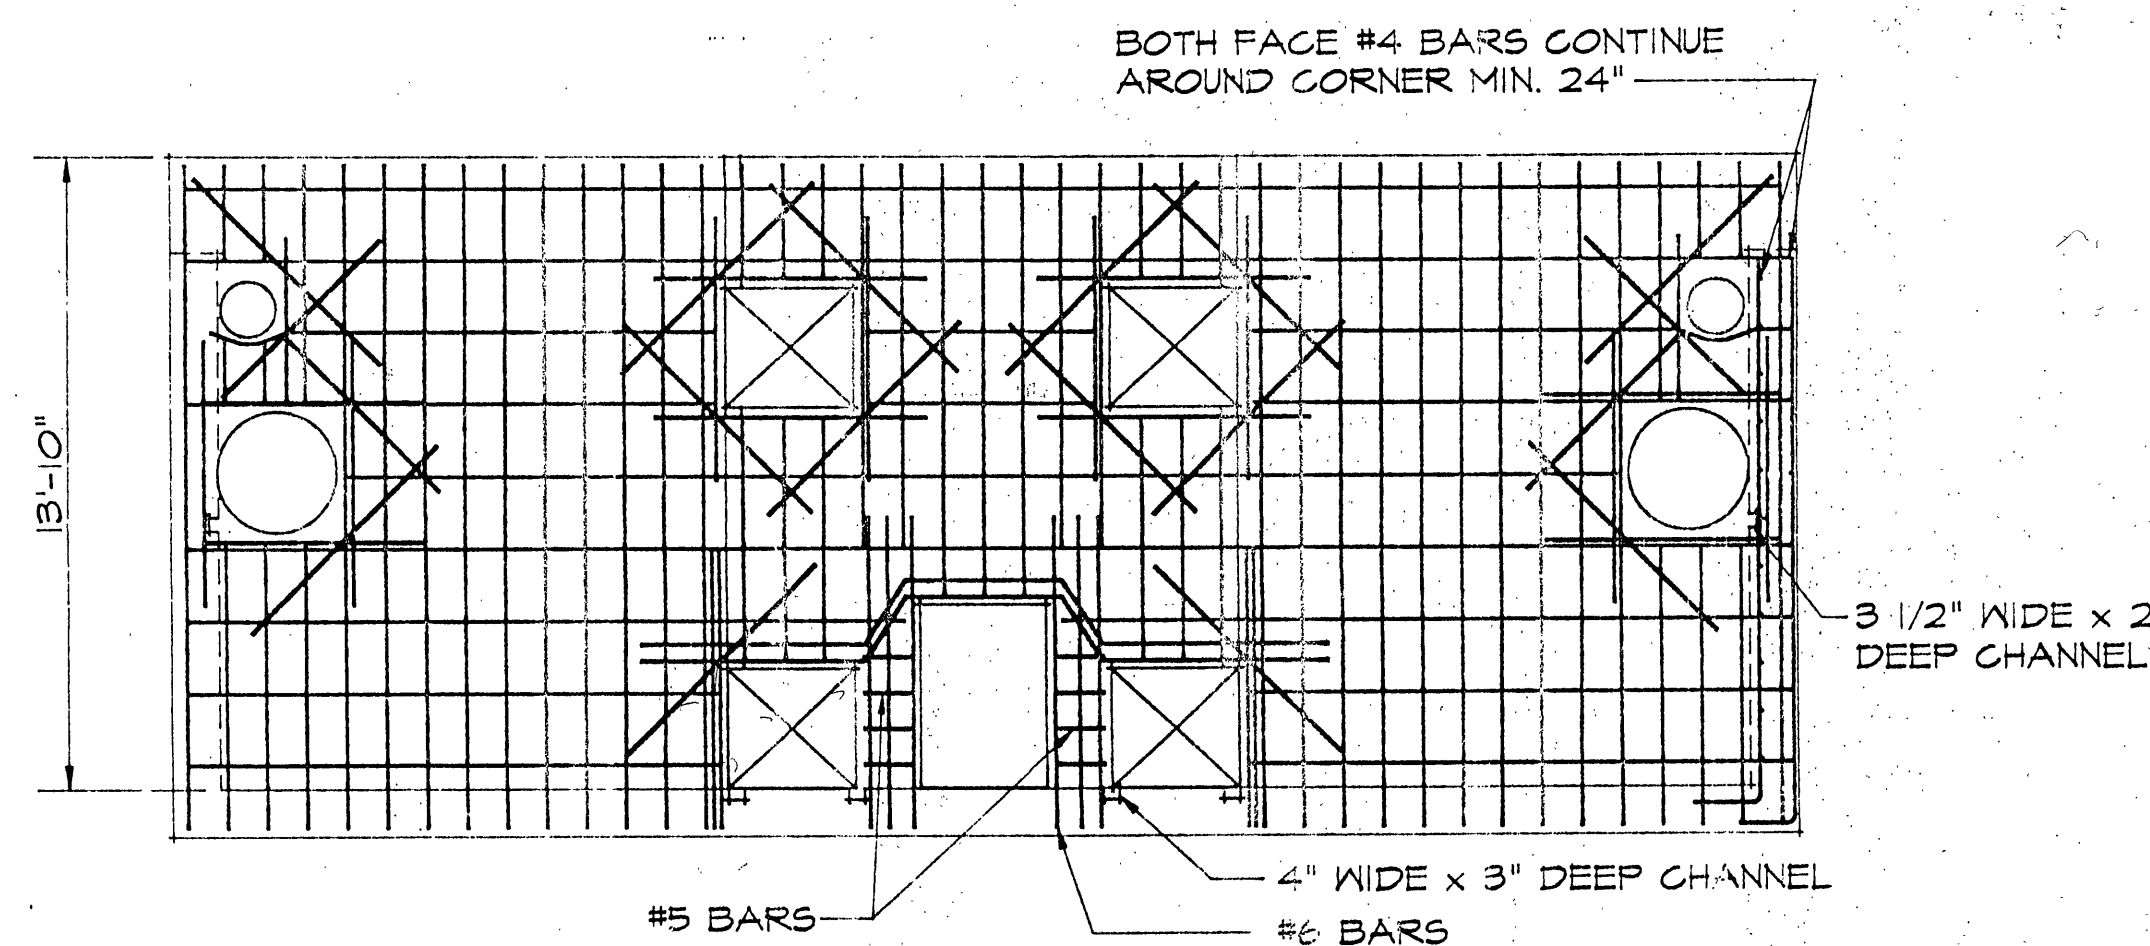

ELEVATION - TREATMENT BASIN REINFORCEMENT
SCALE 1/4" = 1'-0"
56.6
SI

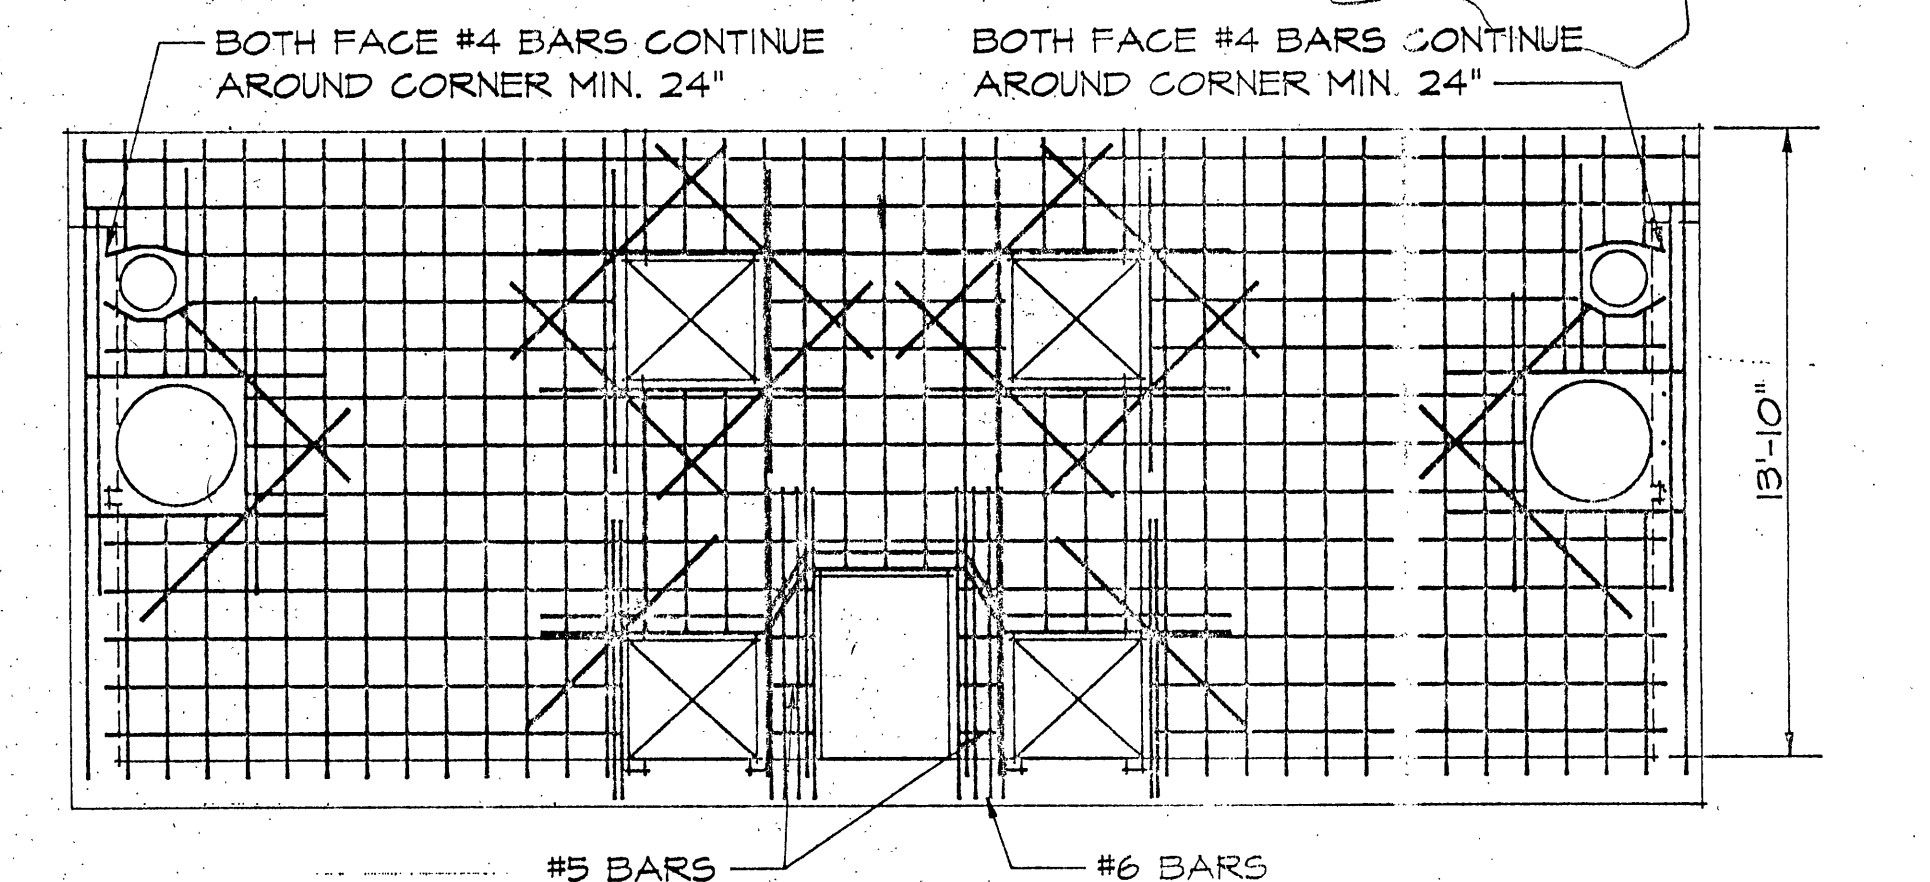


ELEVATION - TREATMENT BASIN REINFORCEMENT
SCALE 1/4" = 1'-0"
56.7
SI


- NOTES
1. CONCRETE STRENGTH TO BE MIN 4,000 PSI
 2. REINFORCING STEEL STRENGTH 60,000 PSI
 3. VAPOR BARRIER WILL BE USED FOR ALL CONCRETE PLACED AGAINST EARTH
 4. ALL BASIN SLABS SHALL HAVE A MIN OF 4" GRAVEL BASE

INSPECTOR'S AS-BUILTS 1995

WWW.ID# 6LDLIZ

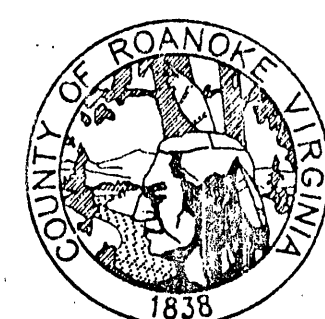

**ROANOKE COUNTY
WATER TREATMENT
FACILITY**

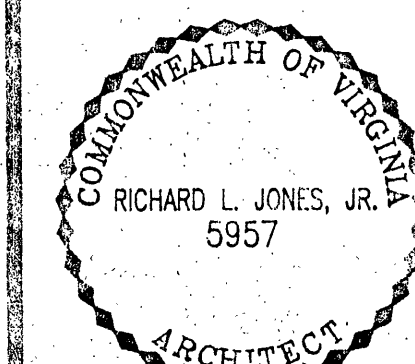

REINFORCING - TREATMENT UNIT 3	
PROJECT ARCHITECT RLJ JR	COMMISSION NUMBER 1413
TECHNICIAN RAT	DATE 22 SEPT 1994

S6