

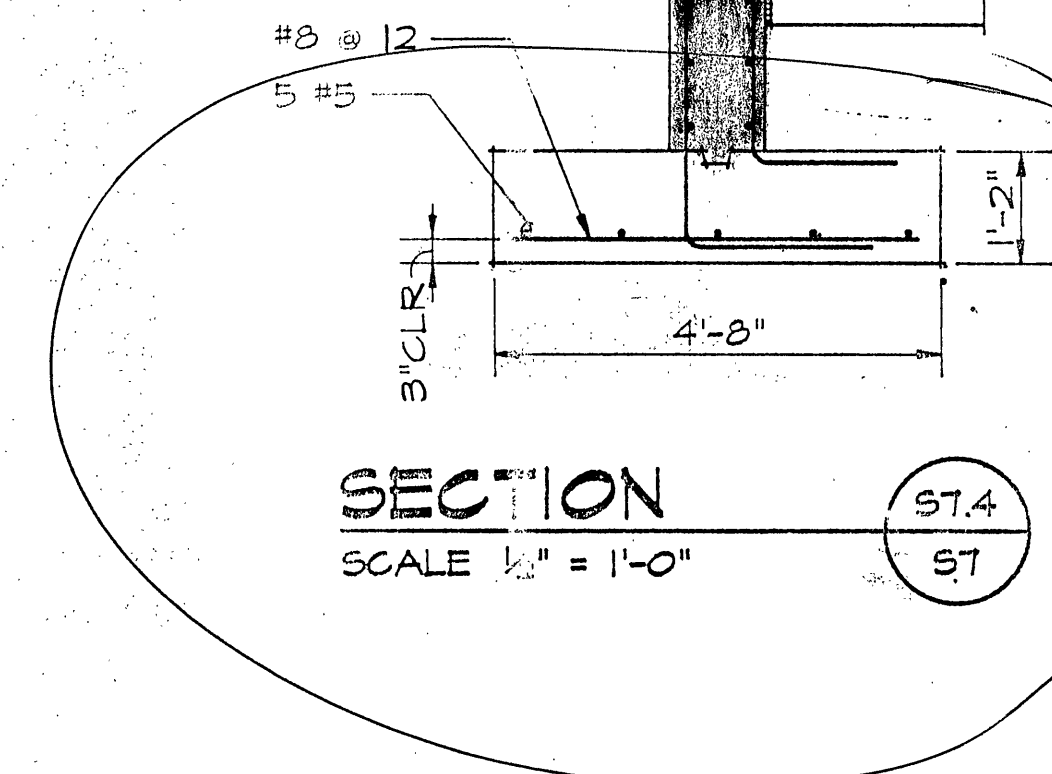
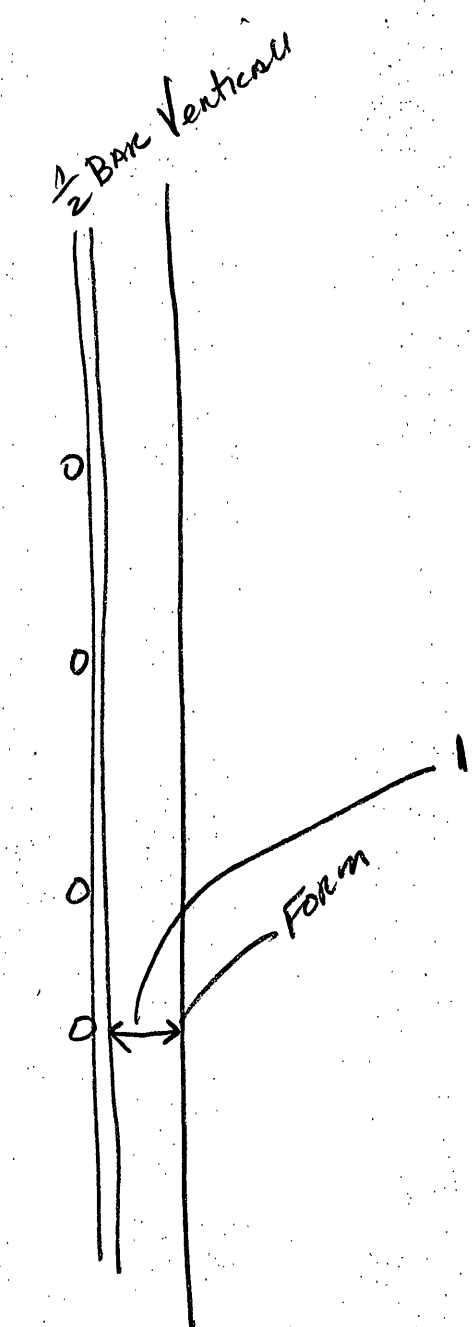
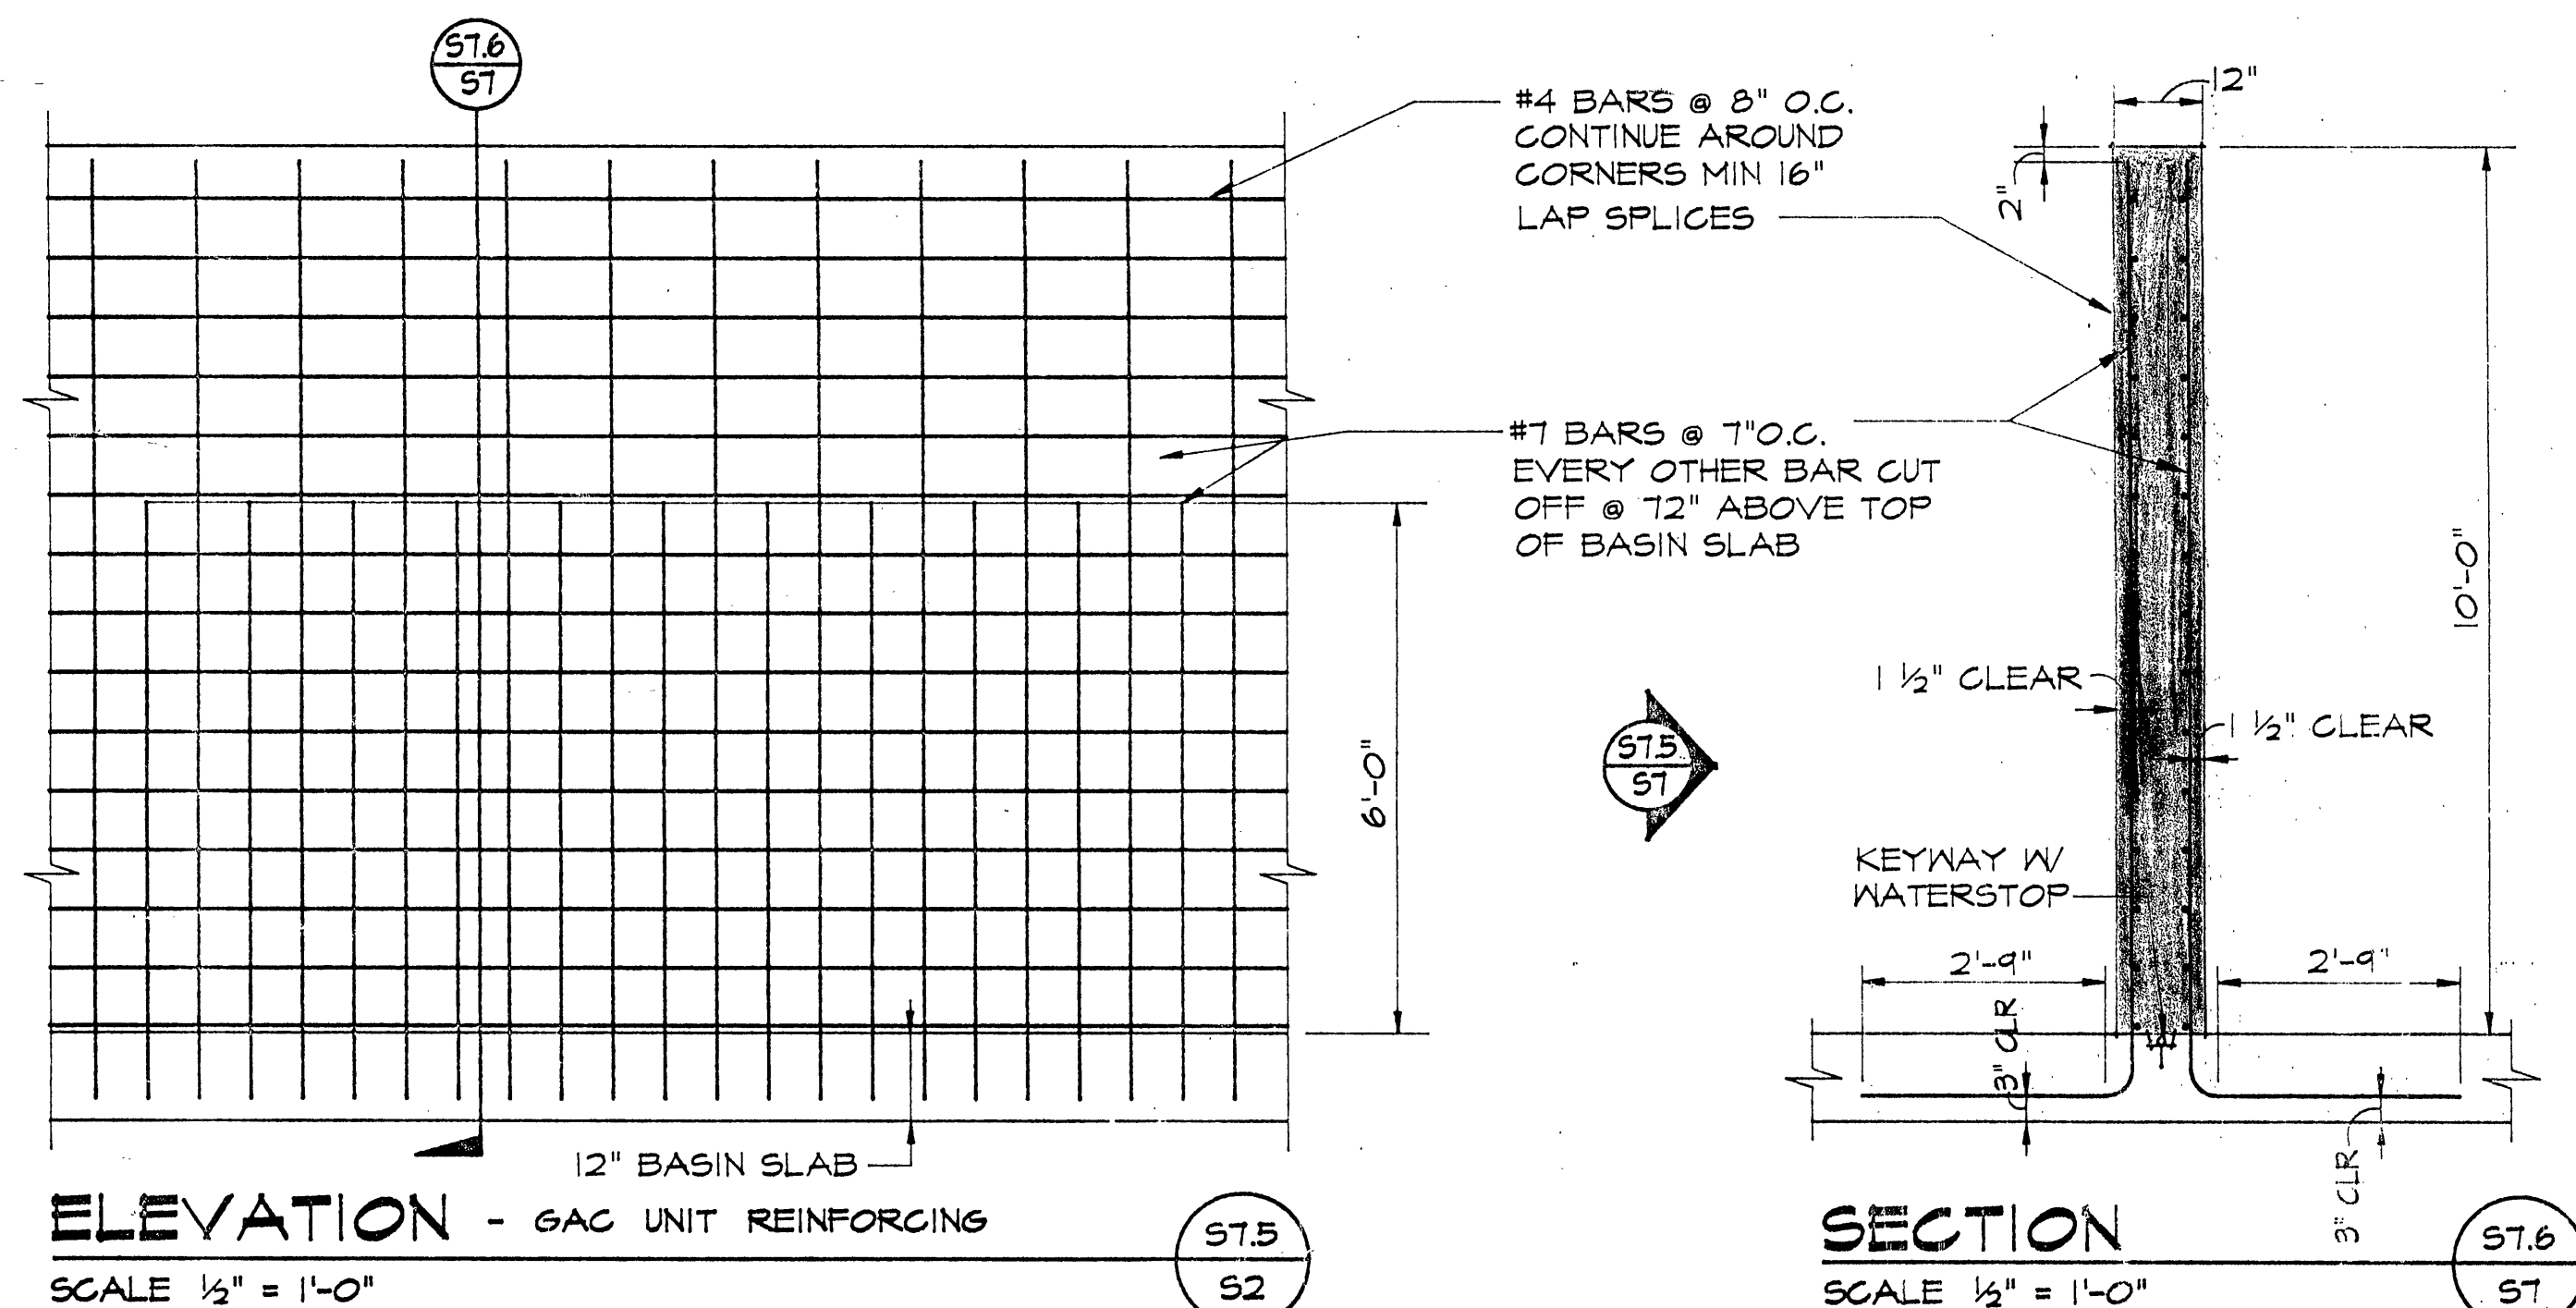
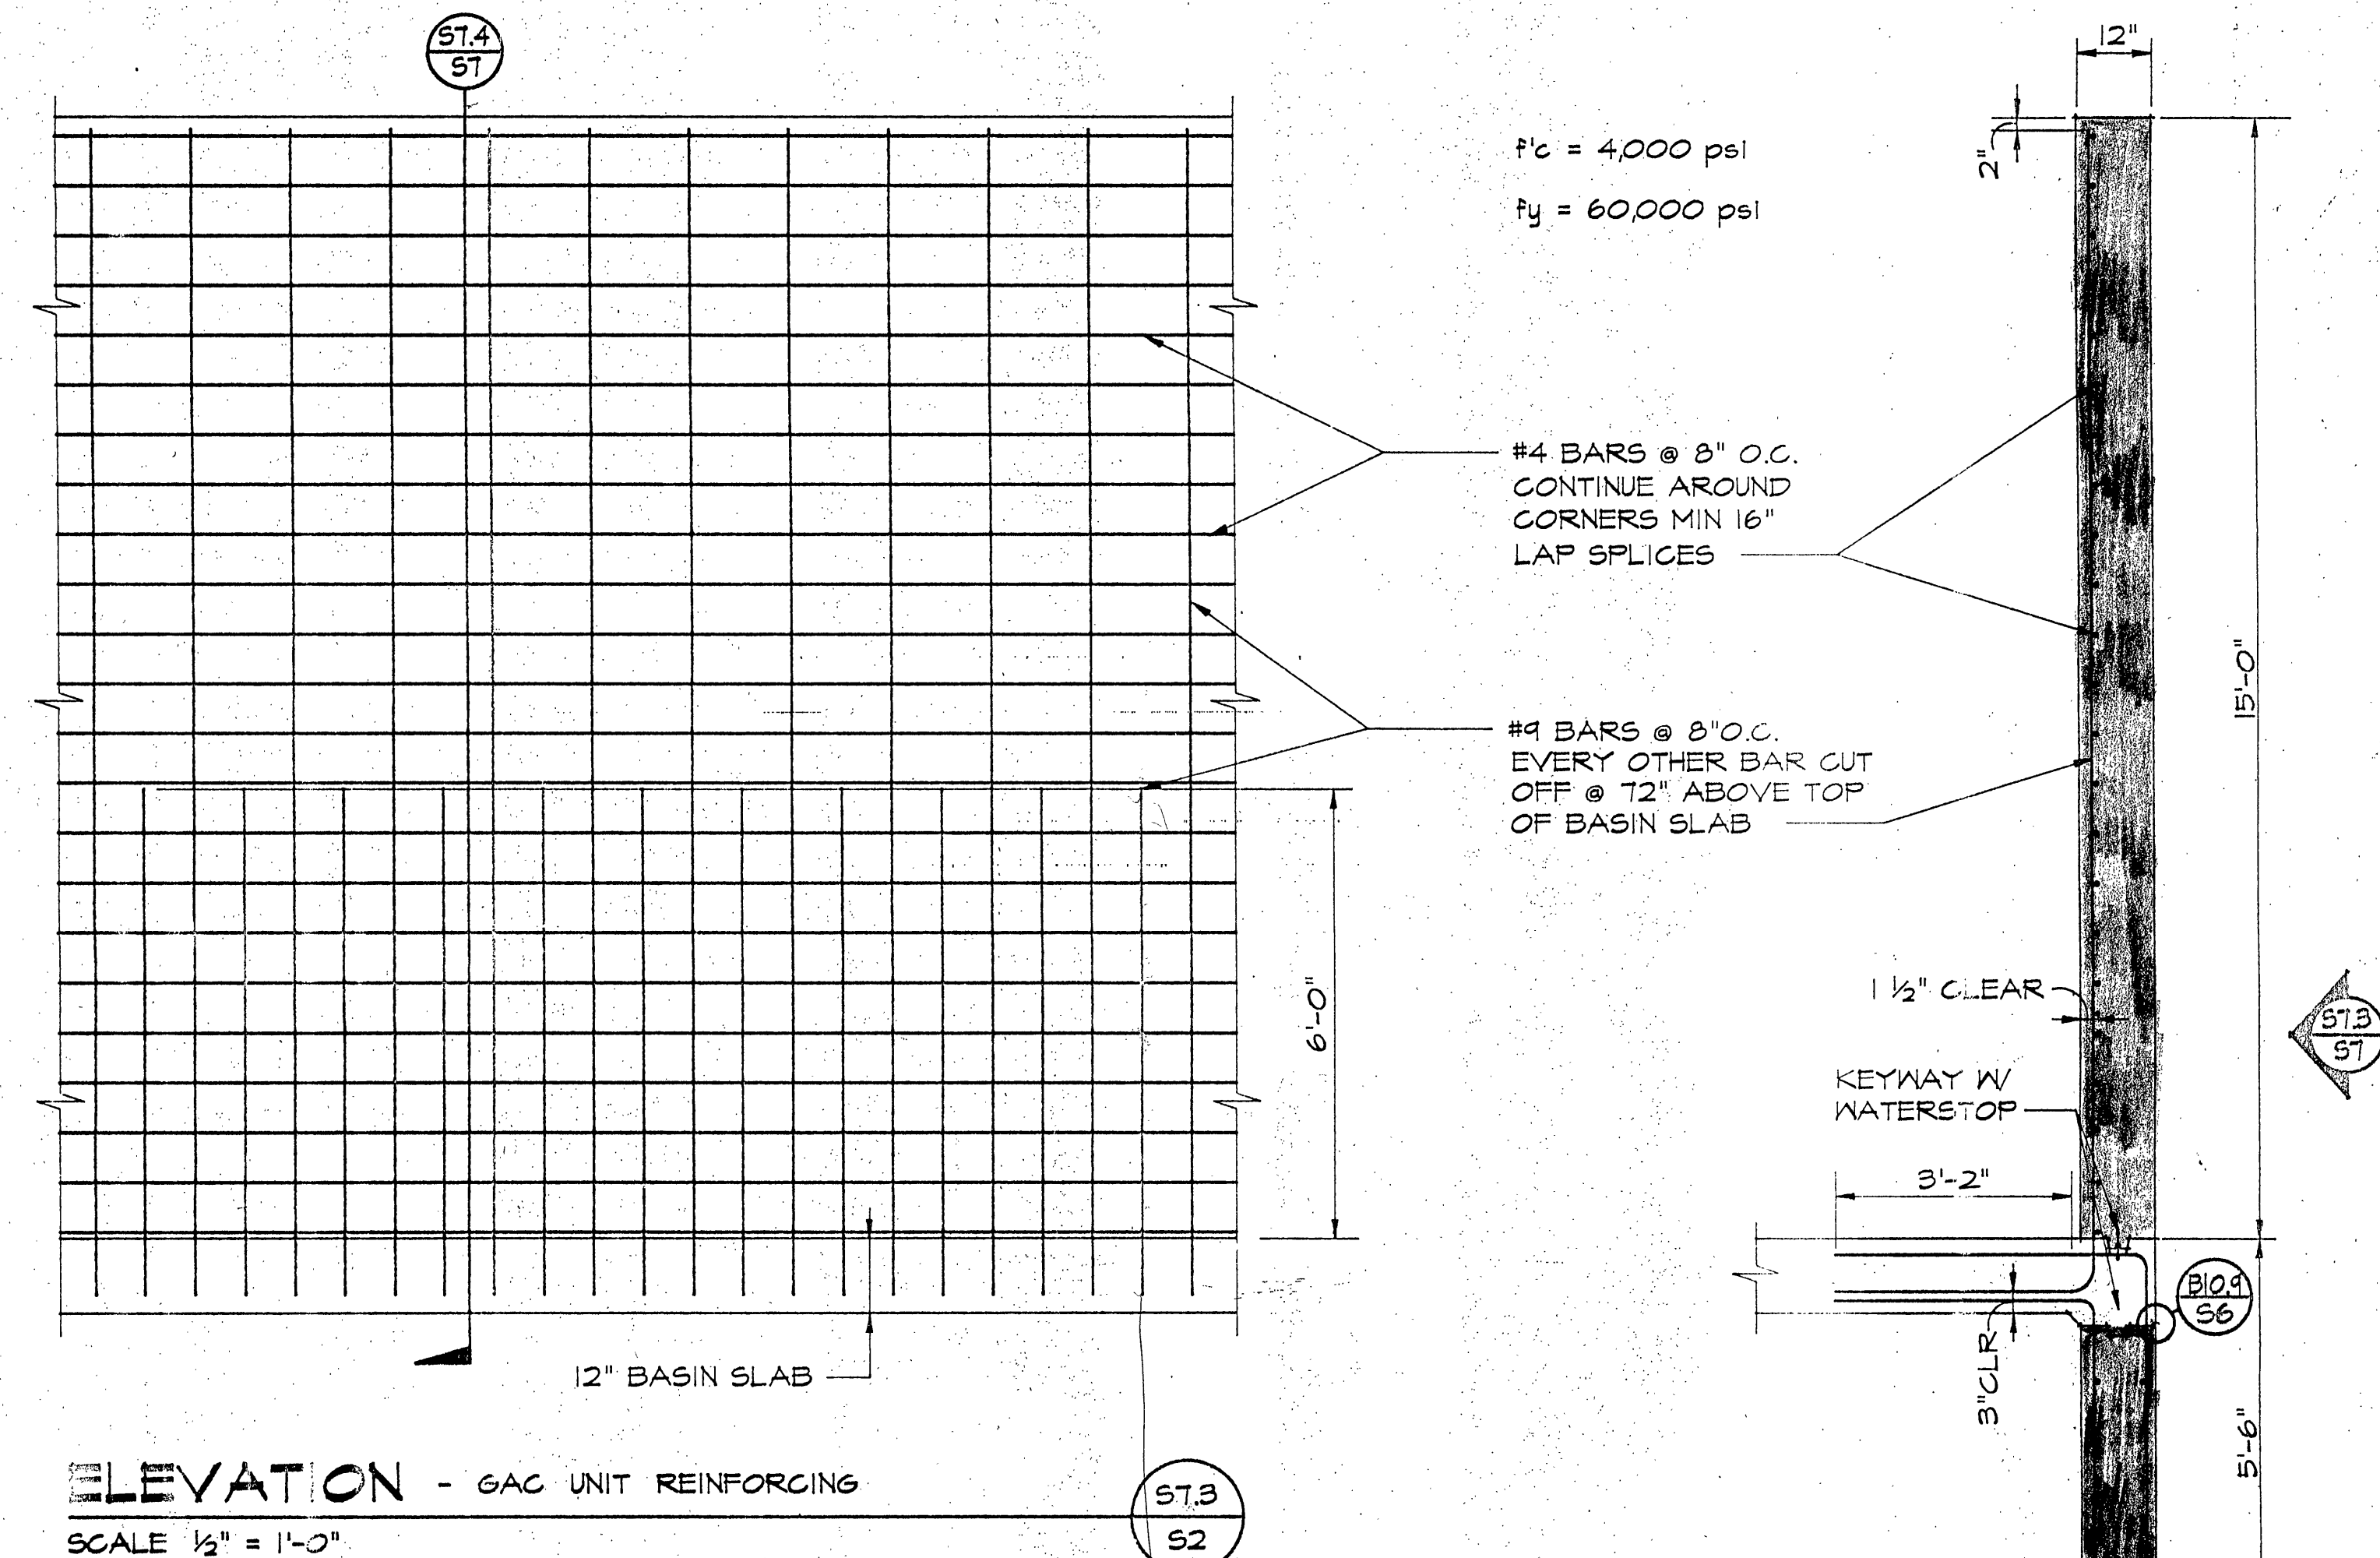


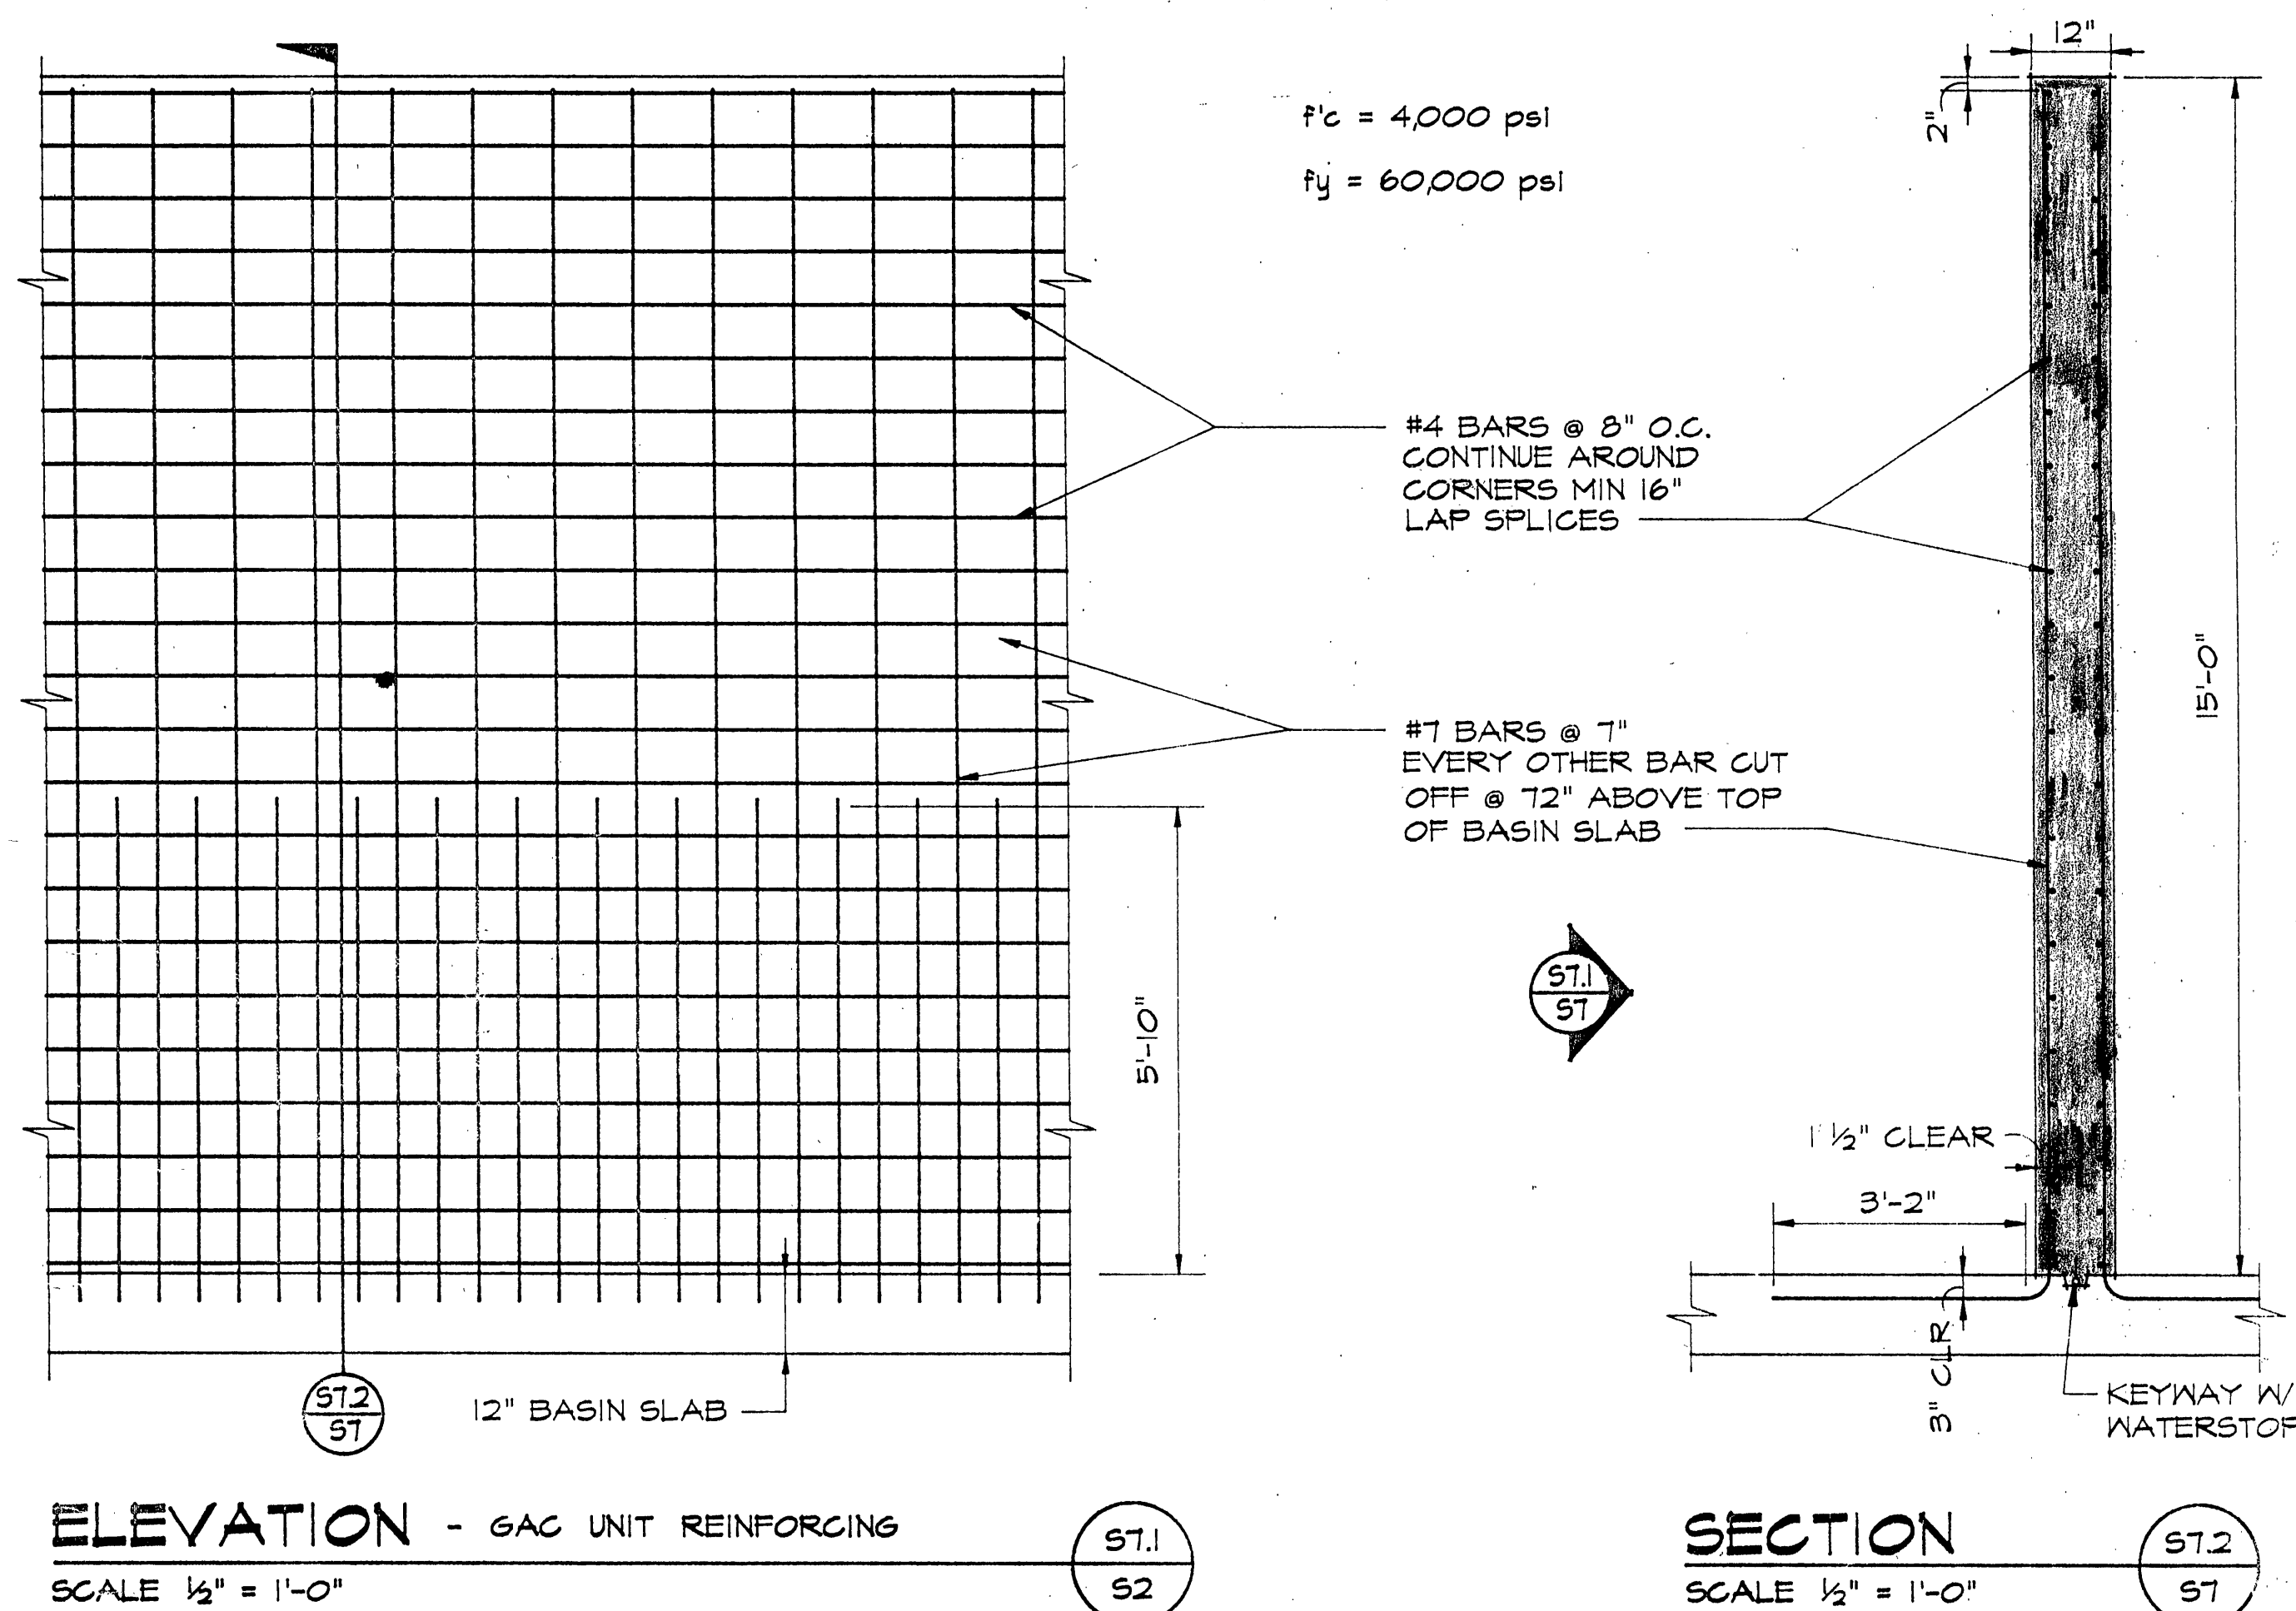


INSPECTOR'S AS-BUILTS 1995

NOTE
ELEVATIONS INDICATE REINFORCEMENT OF A PORTION OF THE BASIN WALLS. THE BARS SHALL CONTINUE THROUGH THE ENTIRE WALL PLANE

WWW.ID# 8LDLIZ

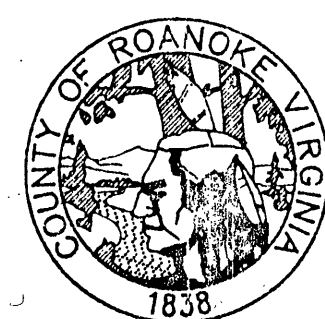

ROANOKE COUNTY WATER TREATMENT FACILITY

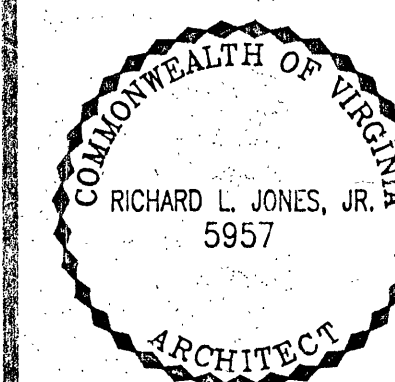

REINFORCING - TREATMENT UNIT'S

PROJECT ARCHITECT
RLJ JR

COMMISSION NUMBER
1913

TECHNICIANS
RNT

DATE
22 SEPT 1994

S7

JAMES S. JONES / ASSOCIATES / ARCHITECTS, P.C.