



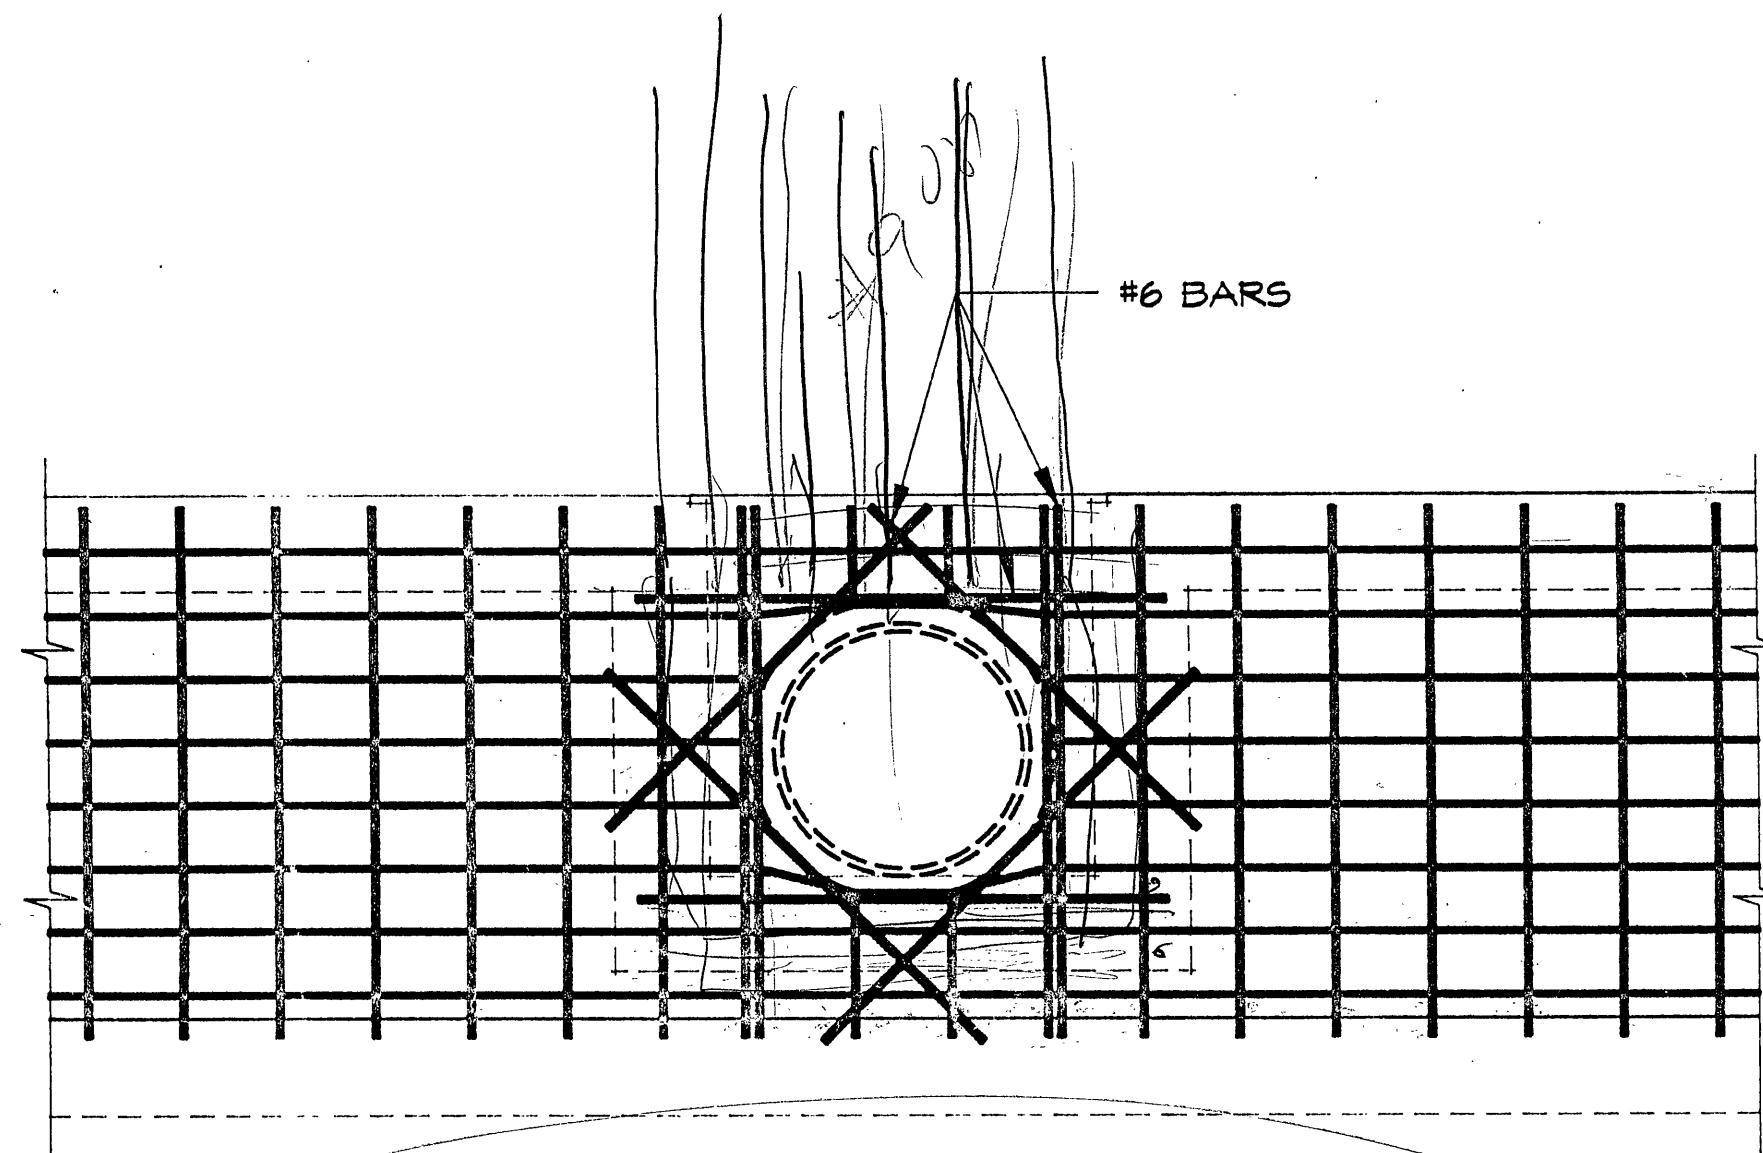

GAC PIPE GALLERY WALL

SCALE 1/2" = 1'-0"


S8.1
S2

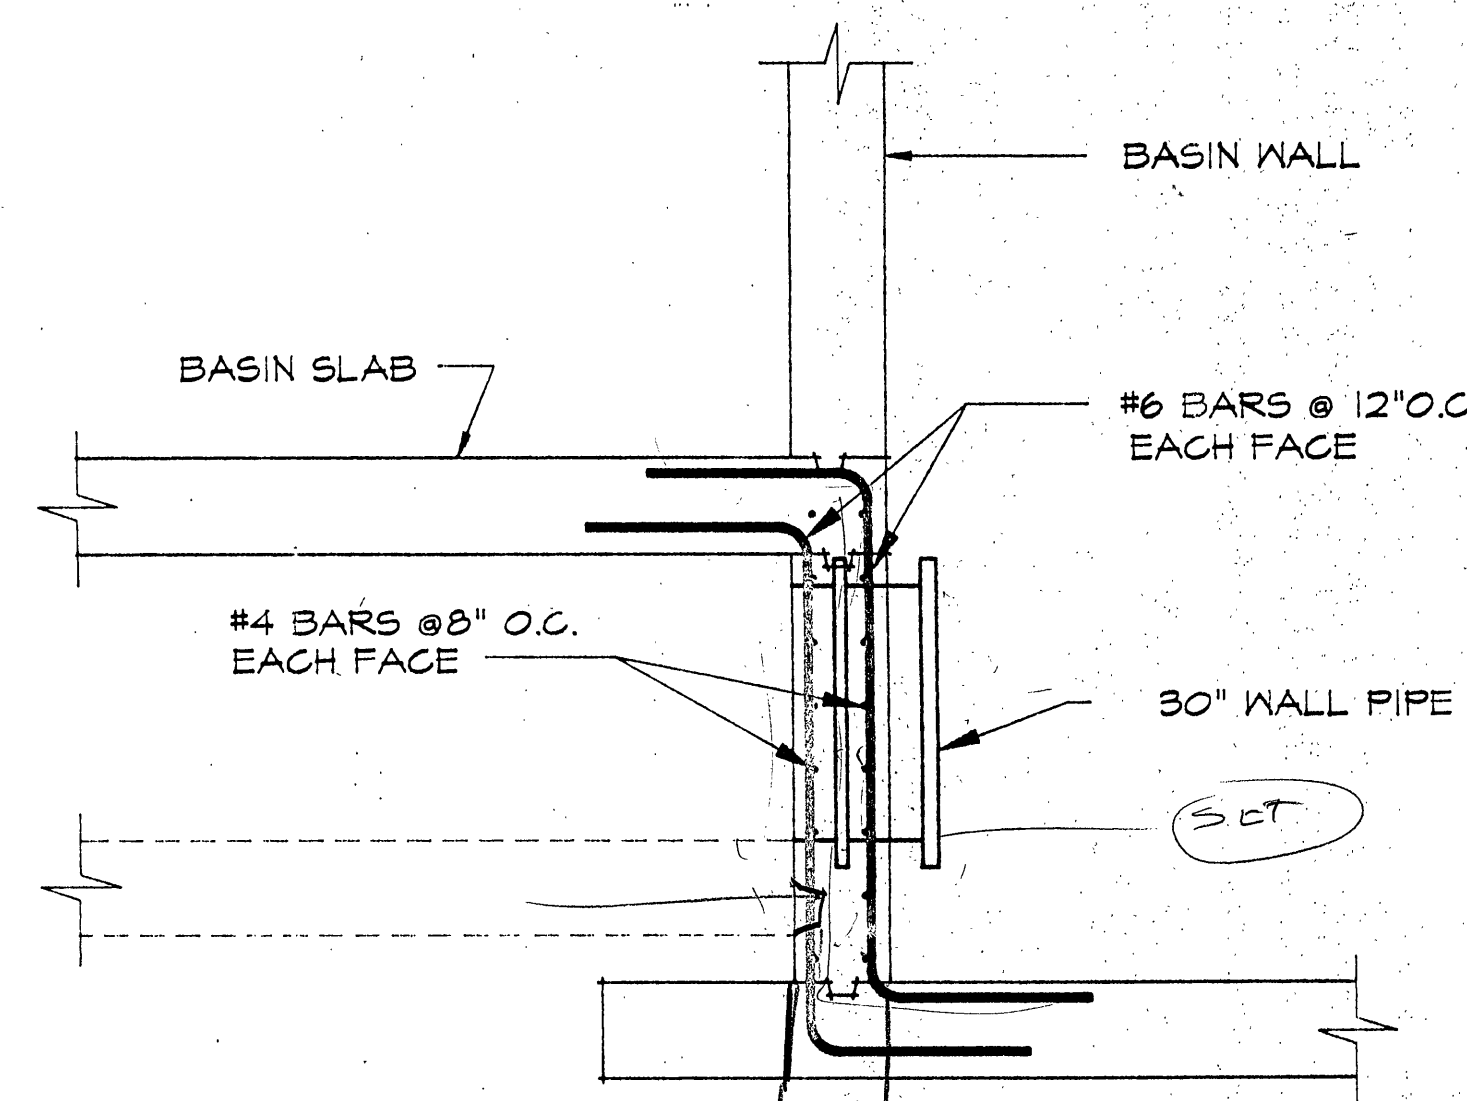

GAC PIPE GALLERY WALL

SCALE 1/2" = 1'-0"


S8.2
S2

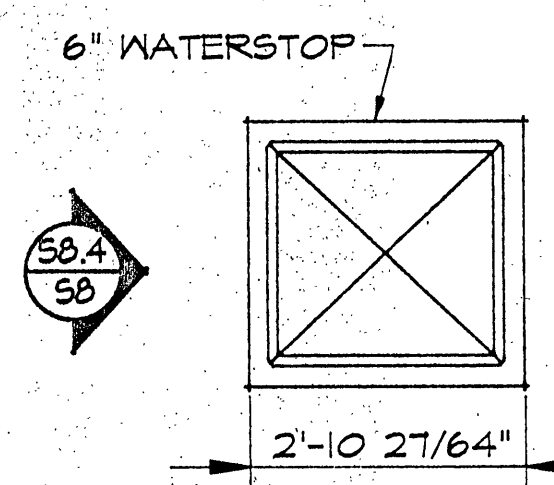

ELEVATION

NO SCALE


S8.3
S

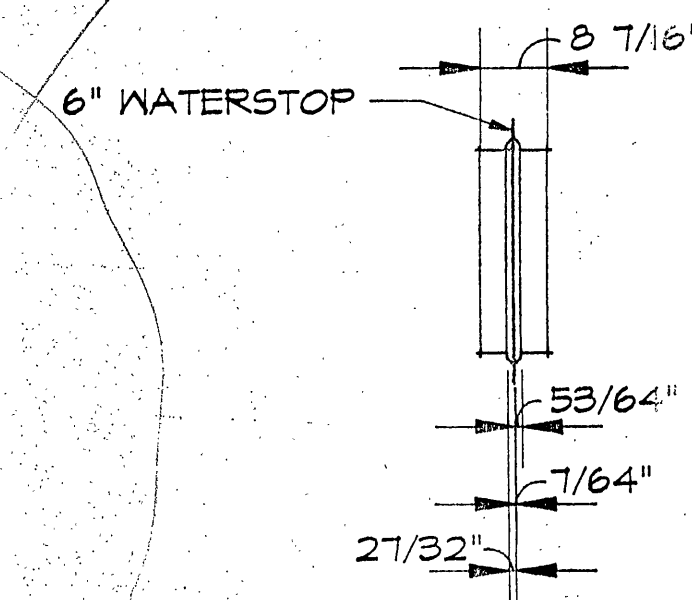

ELEVATION

NO SCALE


S8.4
S

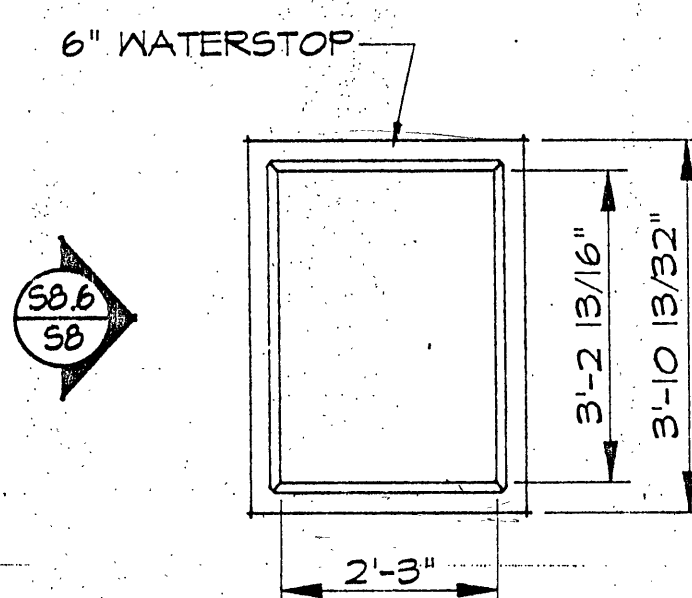

ELEVATION

NO SCALE




S8.5
S

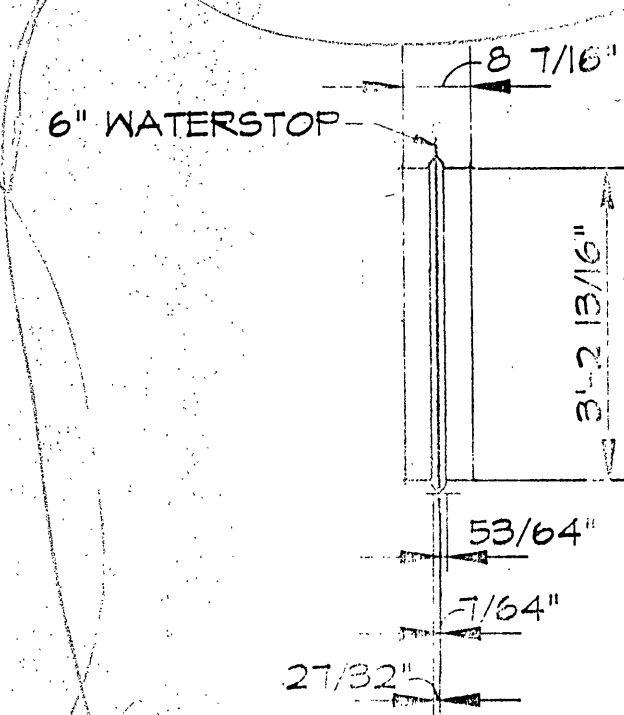

ELEVATION


NO SCALE

S8.6
S

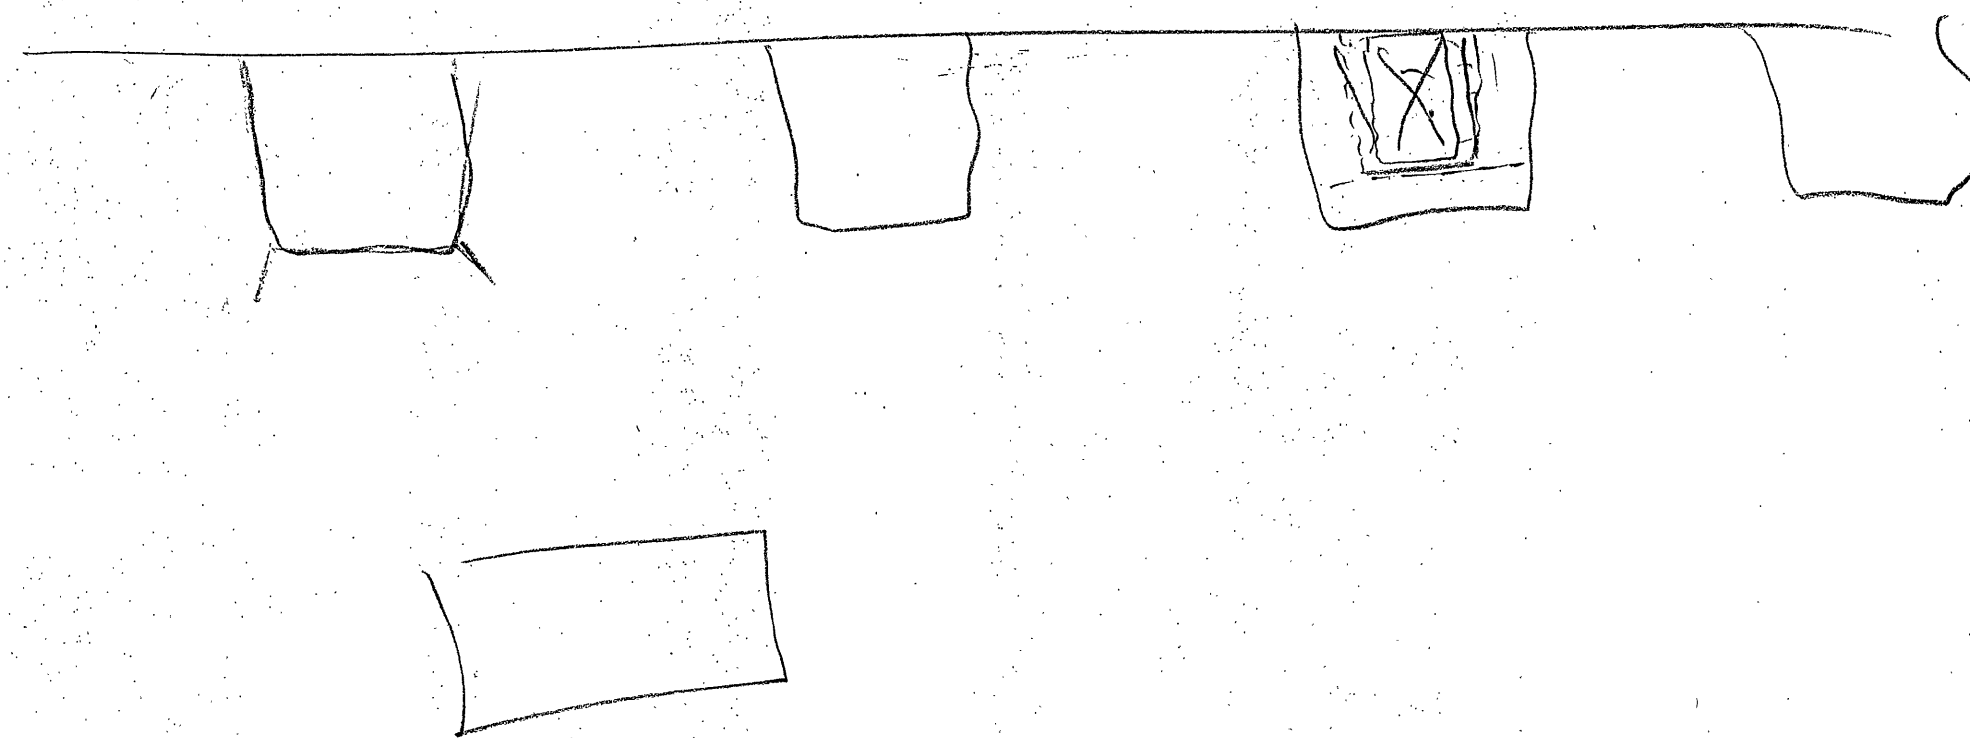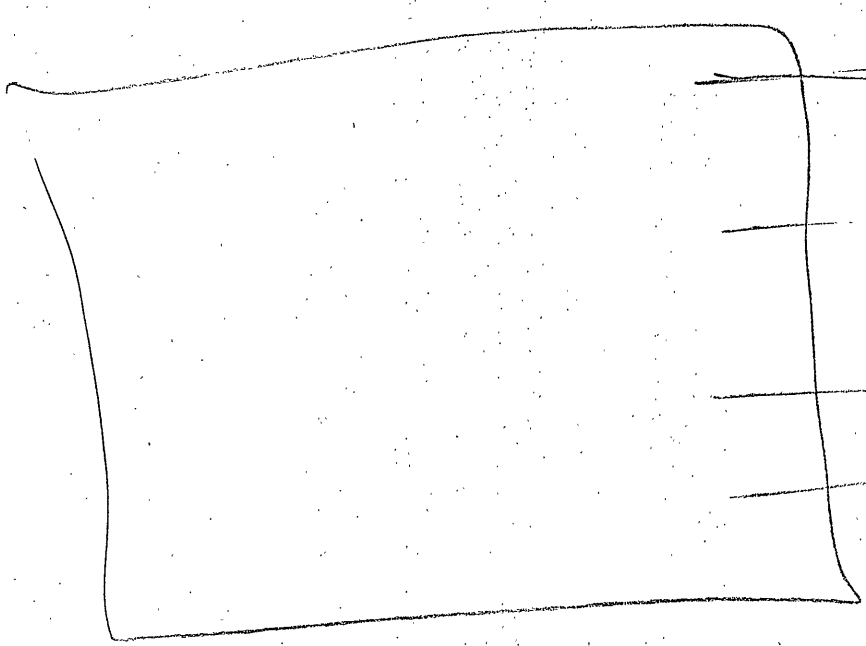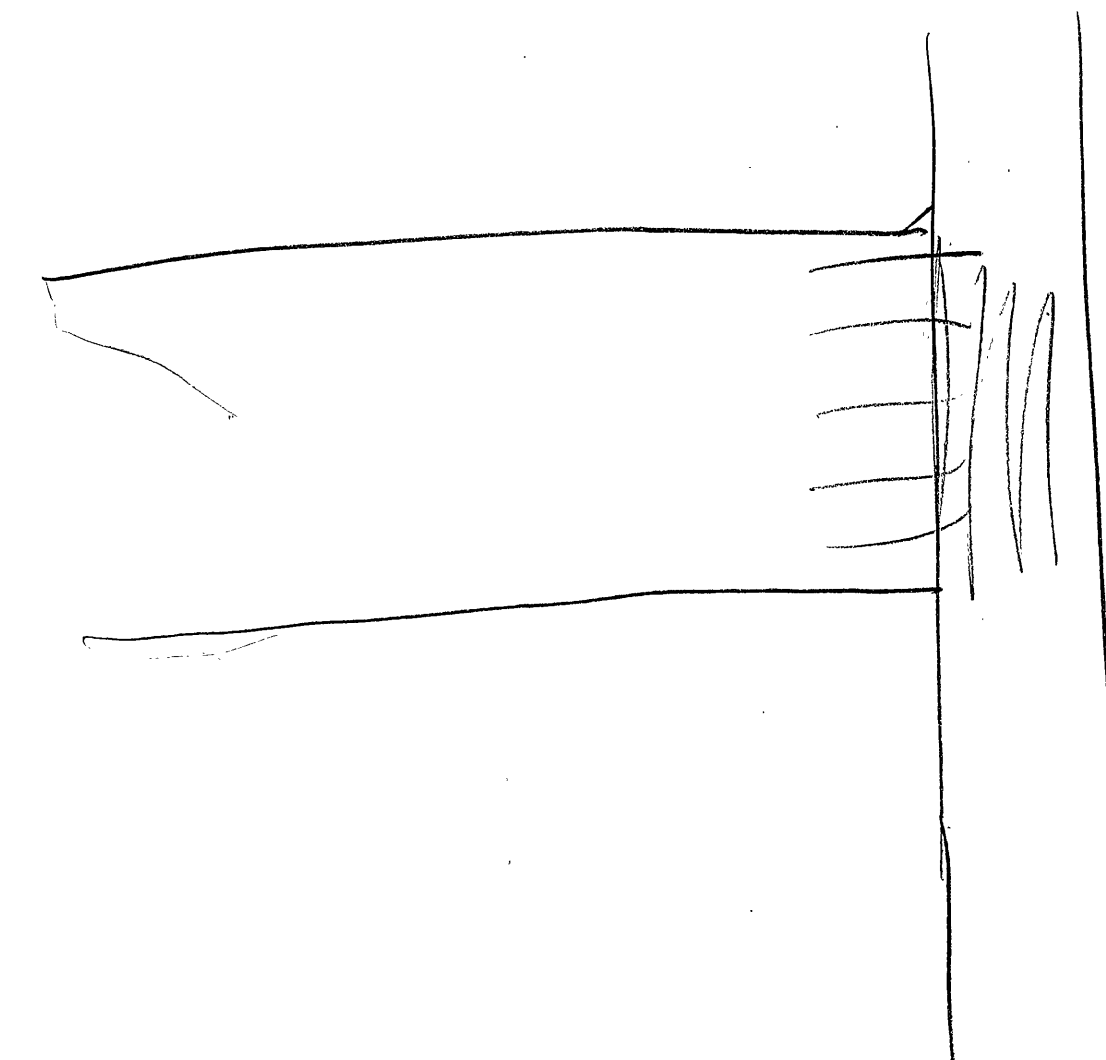


INSPECTOR'S AS-BUILTS 1995

WWW ID# 6DLJUZ

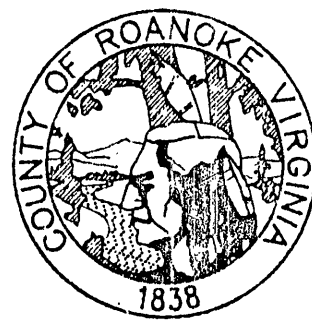

ROANOKE COUNTY
WATER TREATMENT
FACILITY

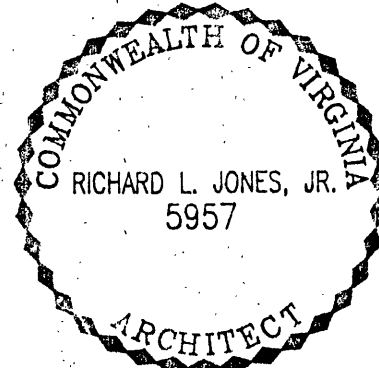

REINFORCING DETAILS

PROJECT ARCHITECT
RLJ JR

COMMISSION NUMBER
1913

TECHNICIANS
RAT

DATE
22 SEPT 1994

S8

JONES & JONES ASSOCIATES / ARCHITECTS PC