


ACO DRAIN 02725/ACP
BuyLine 4490

Location: Post Treatment - Sludge Area
Pipe Gallery
Treatment Bldg - Chemical Room

**ACO S-100
Technical Data**

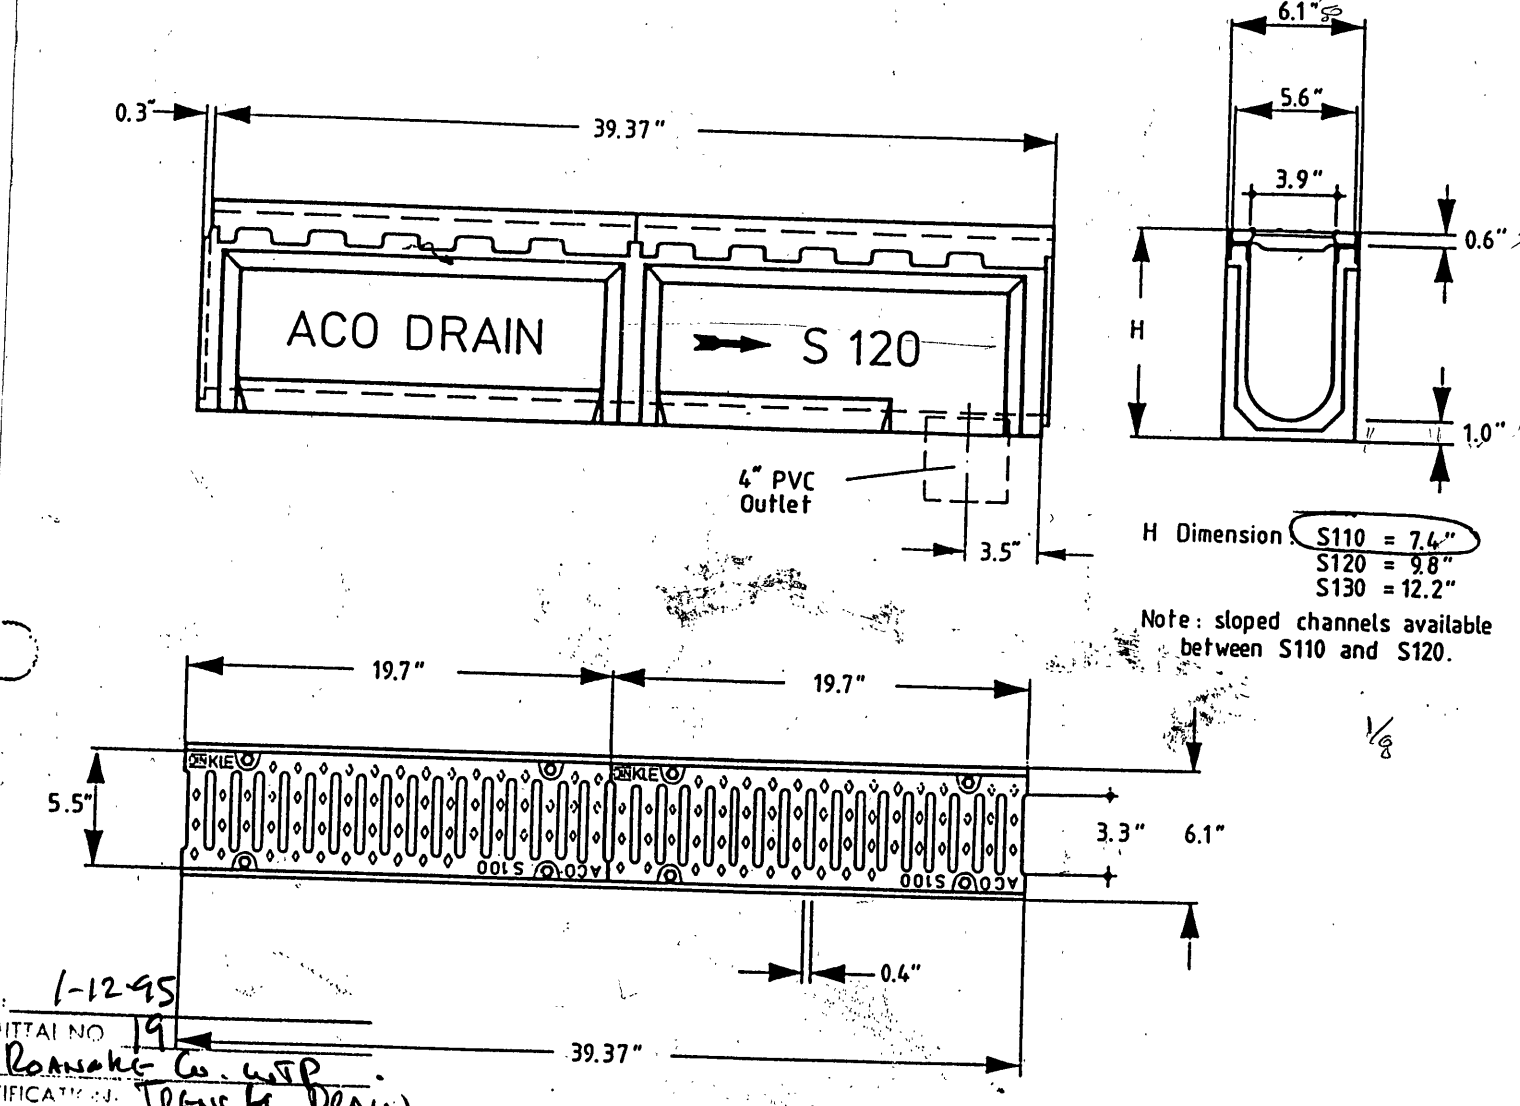

1-1245
MATERIAL NO. 19
Roanoke Co. WSP
Trunk Drain
15-14-19-4


ACO S-100 Channel Brute Weights

Part No.	Product and Size	Wt. Lbs.
1251	Channel Brute S110, complete with grates & locks	78
1252	Channel Brute S120, complete with grates & locks	89
1253	Channel Brute S130, complete with grates & locks	99
1447	Channel Brute S110, channel only	34
1448	Channel Brute S120, channel only	65
1449	Channel Brute S130, channel only	75
5581-5590	S10 through S19, complete with grates & locks	64-74
0858	S100 spacer No. 123	1
1450	S100 Channel Brute grate, 1/2 meter	12
1727	S100 Channel Brute rails	3
2323	S100 Verbus Ripp bolt M10x22	.05

SIGNED: Dave Clark

THE ASAP SERIES

Channel Brute line is available

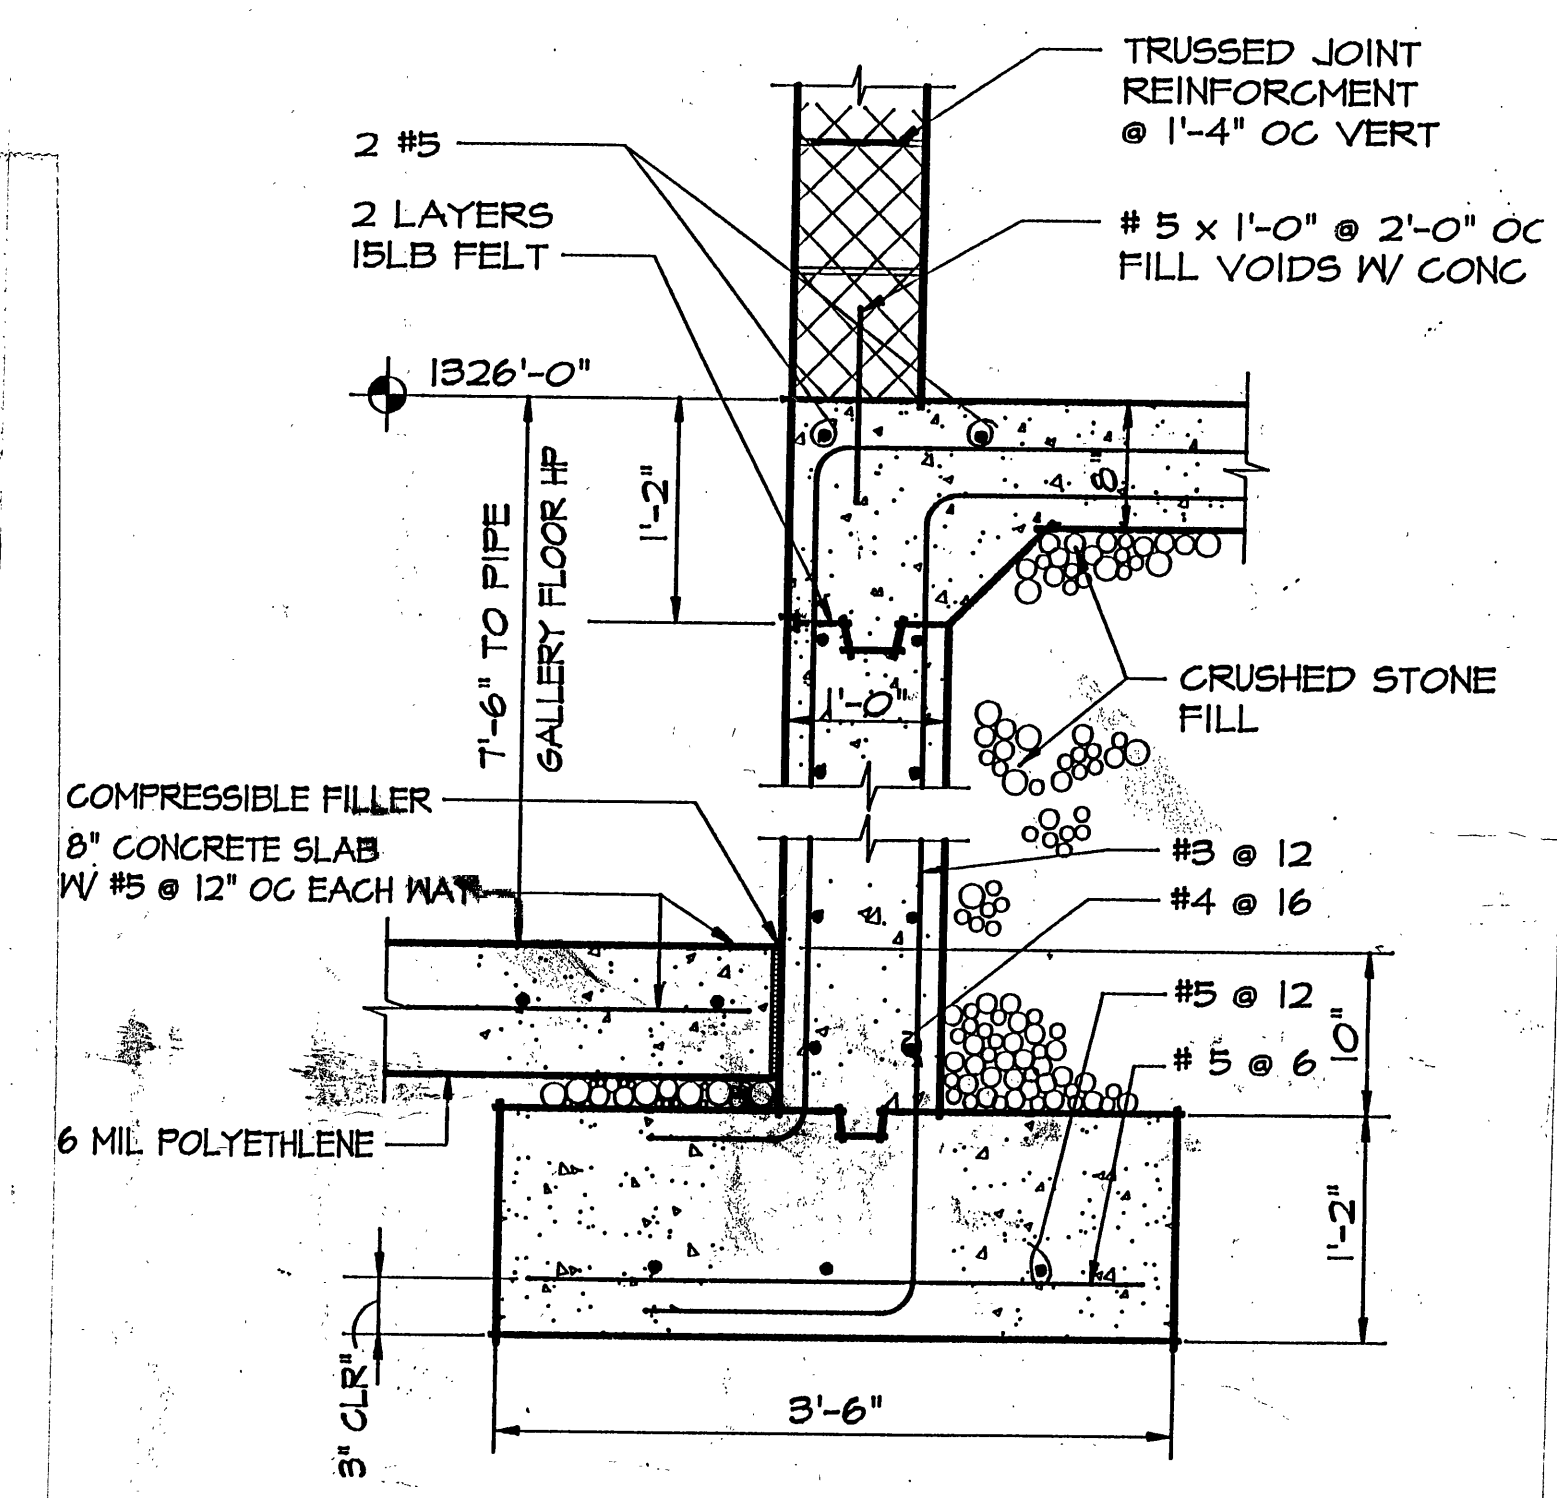

DETAIL LD - 1
SCALE 1" = 1'-0"
DATE 5 JAN 1995

**ROANOKE COUNTY
WATER TREATMENT
FACILITY**

**JONES & JONES
ASSOCIATES
ARCHITECTS**

INSPECTOR'S AS-BUILTS 1995

WWW ID# 8LDLIZ