



NORTHWEST ELEVATION - TREATMENT BUILDING
SCALE 1/8" = 1'-0"

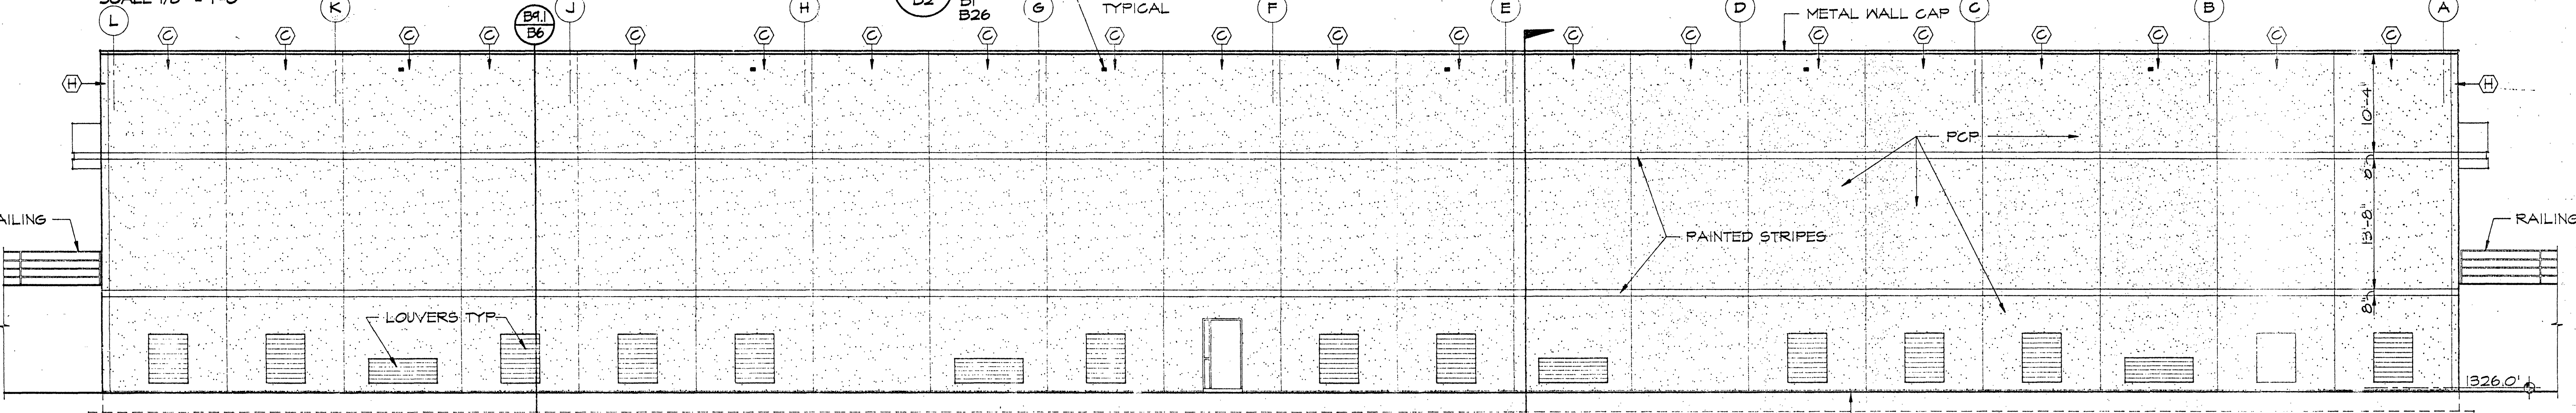

SOUTHEAST ELEVATION - TREATMENT BUILDING
SCALE 1/8" = 1'-0"

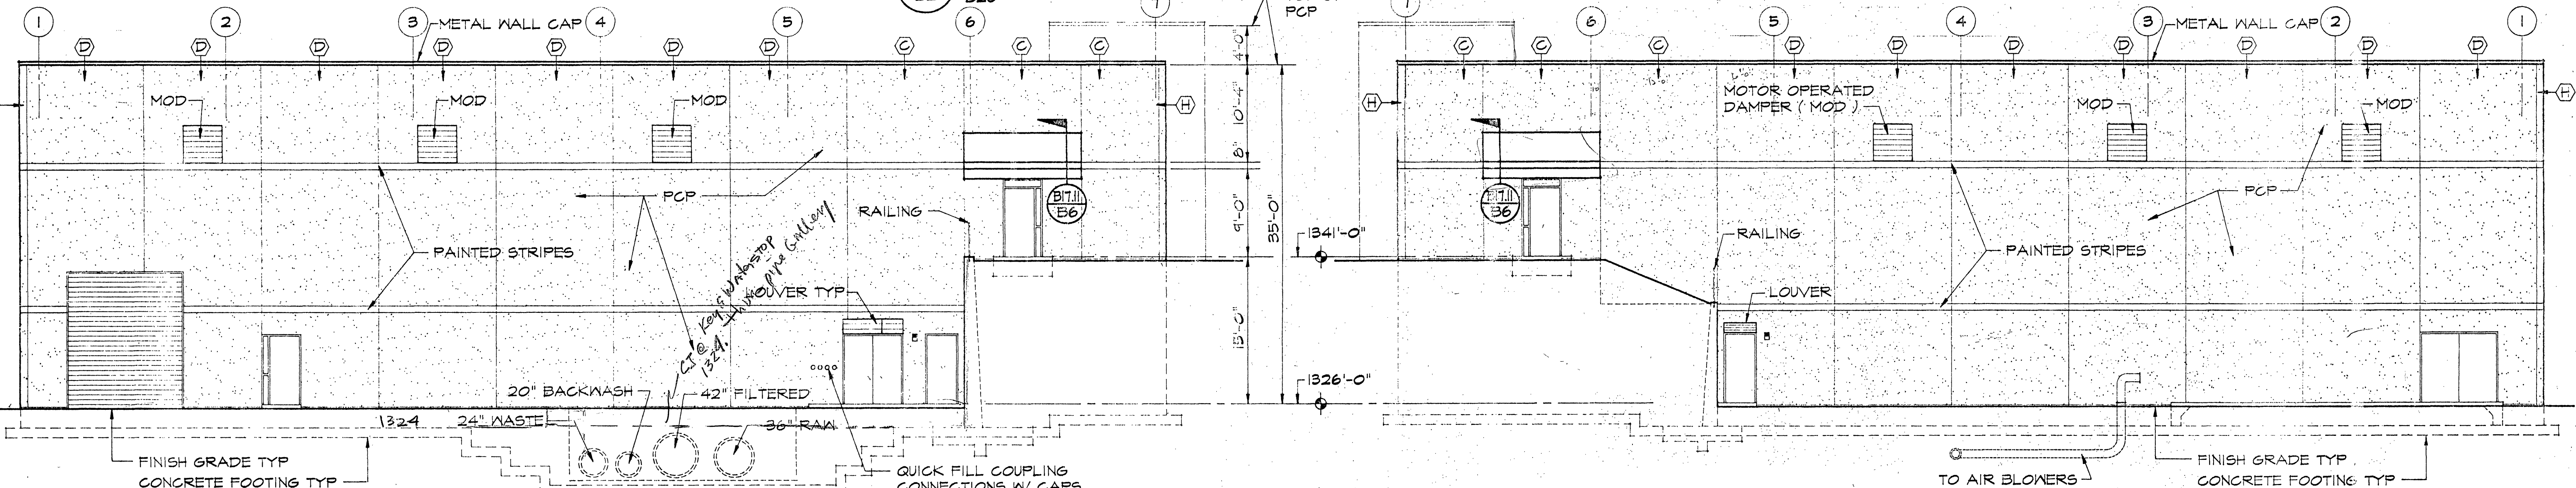


NORTHEAST ELEVATION - TREATMENT BUILDING
SCALE 1/8" = 1'-0"


SOUTHWEST ELEVATION - TREATMENT BUILDING
SCALE 1/8" = 1'-0"

INSPECTOR'S AS-BUILTS 1995

NOTE
PAINT INSIDE AND OUTSIDE
OF SCUPPERS

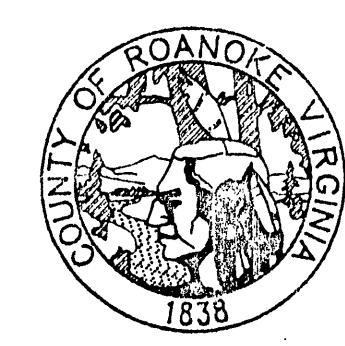

**ROANOKE COUNTY
WATER TREATMENT
FACILITY**

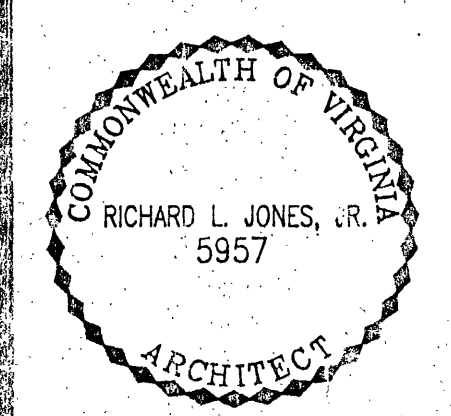

ELEVATIONS - TREATMENT BUILDING	
PROJECT ARCHITECT RLJ/JR	COMMISSION NUMBER 1913
TECHNICIAN'S RWT	DATE 22 SEPT 1994

B6

JONES & JONES ASSOCIATES / ARCHITECTS, P.C.