

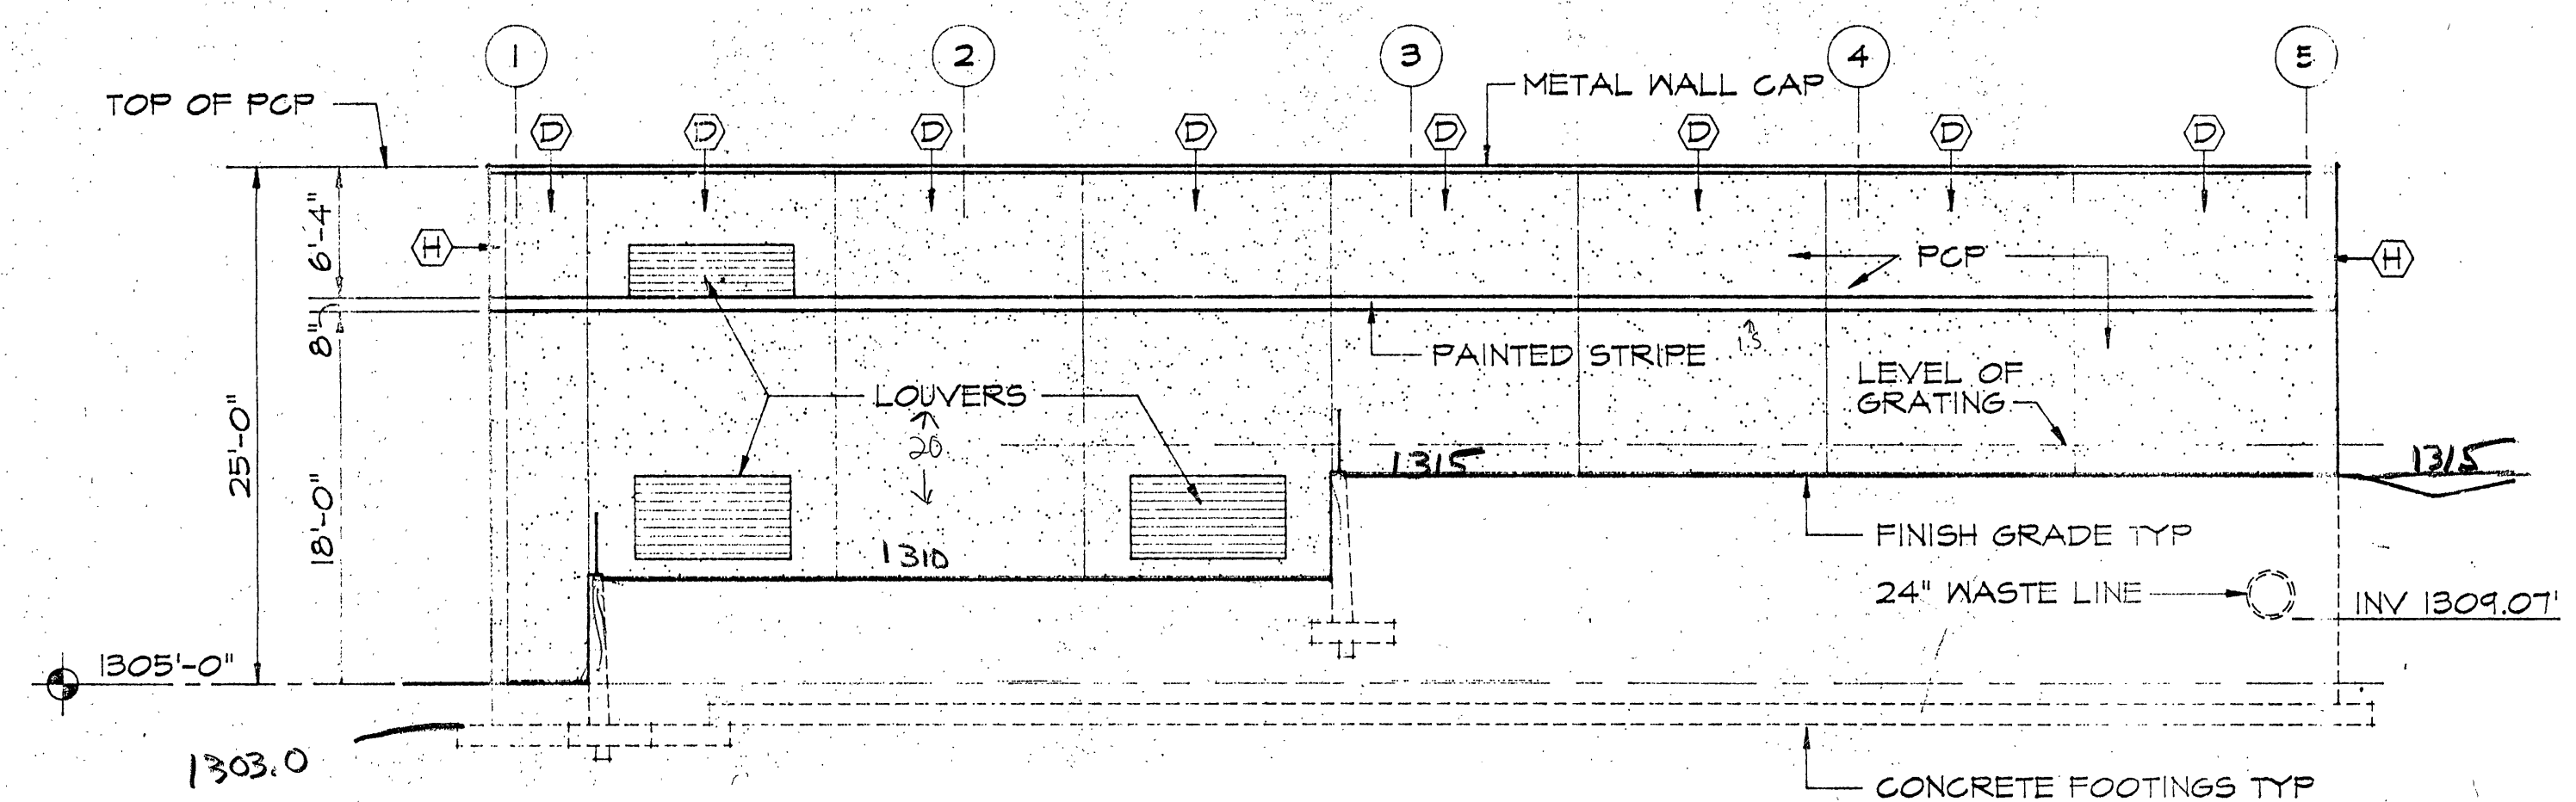
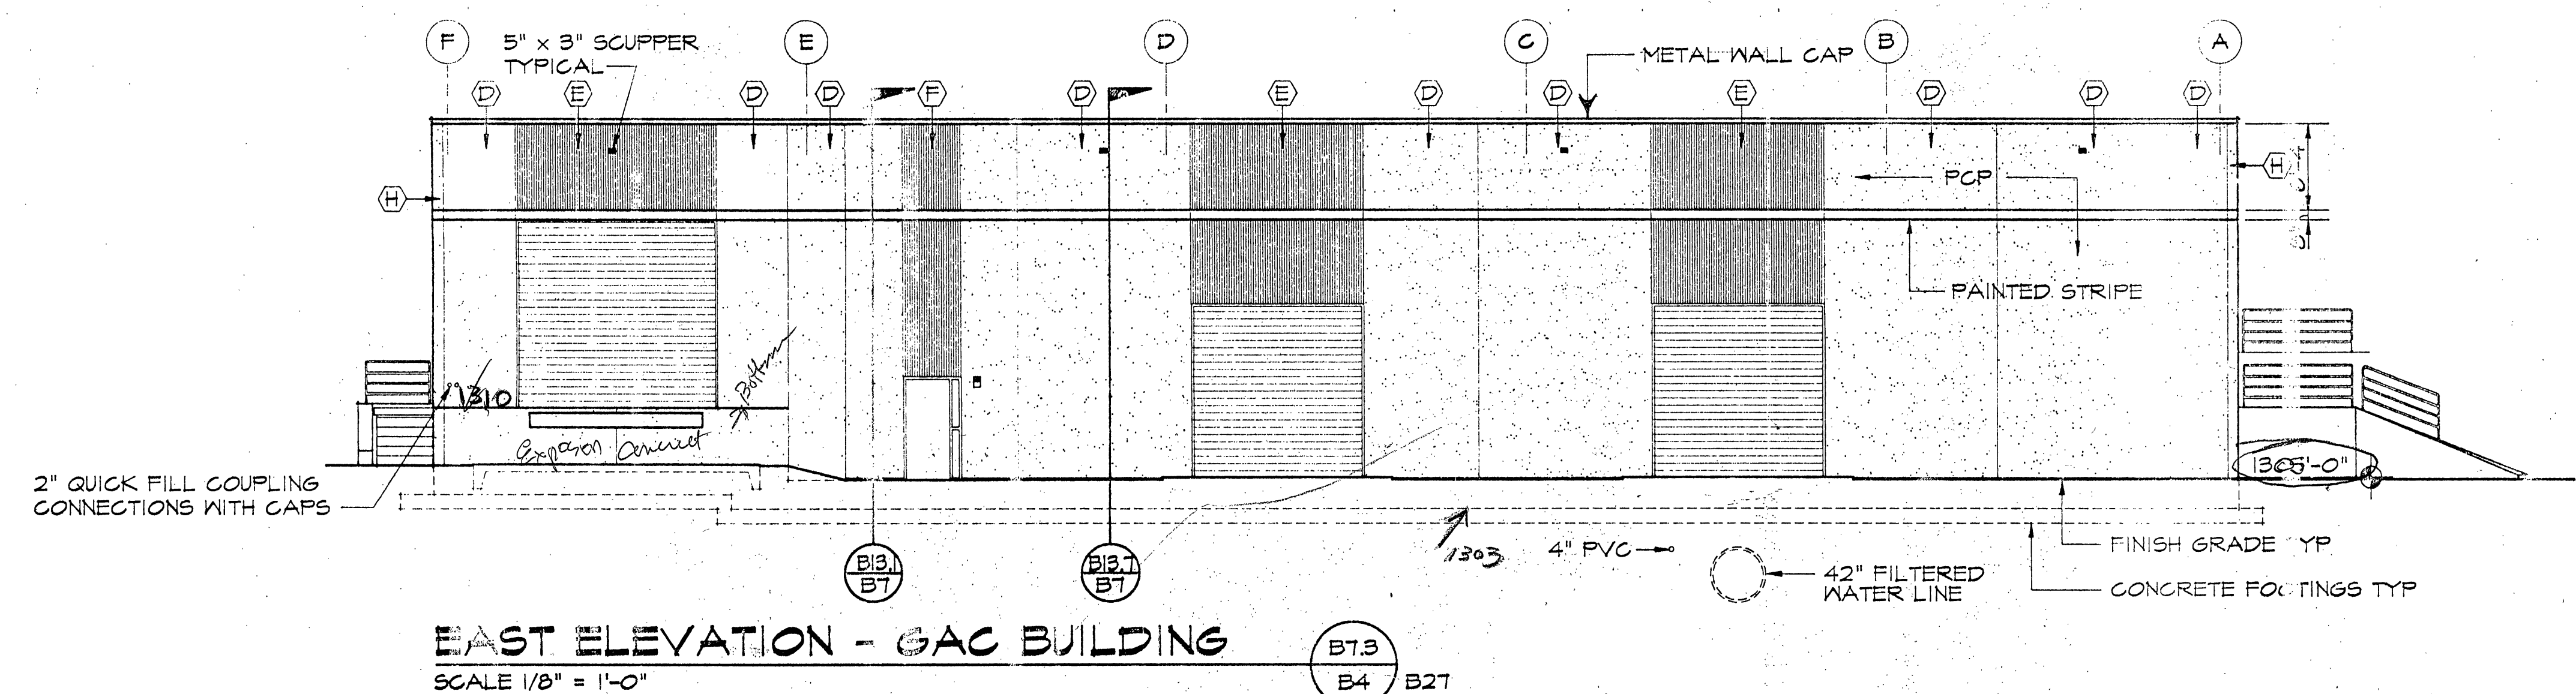
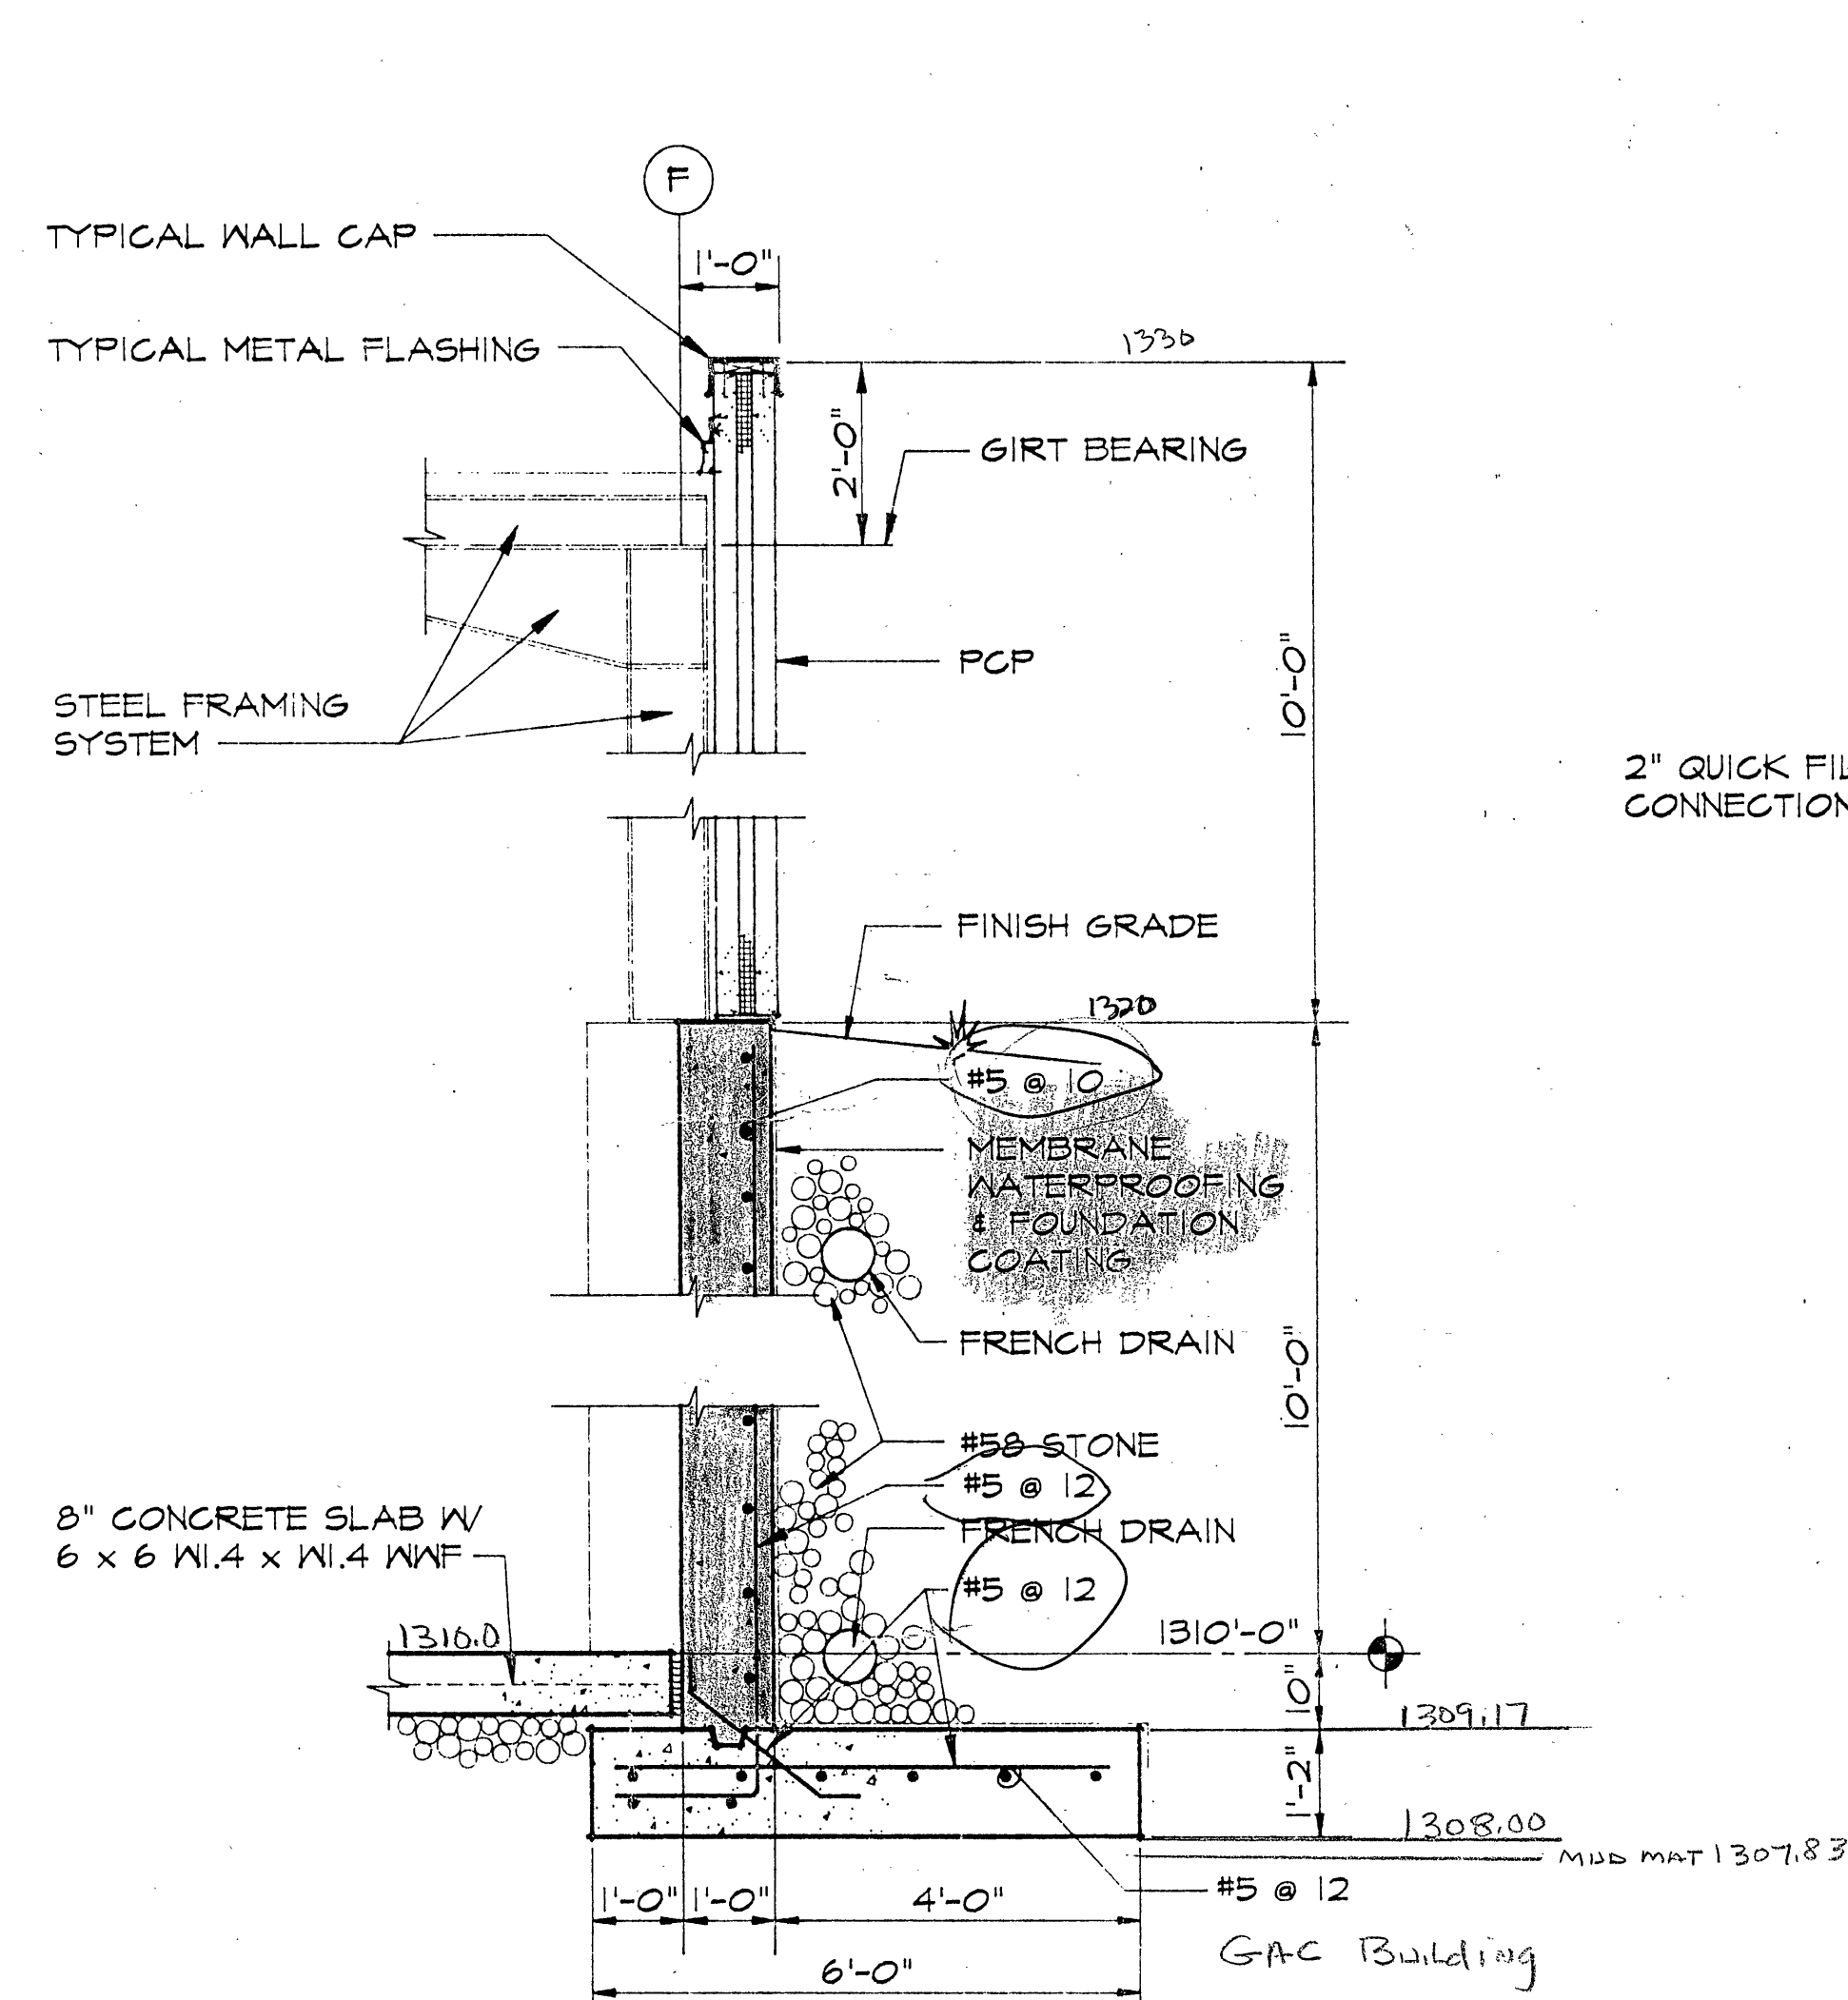
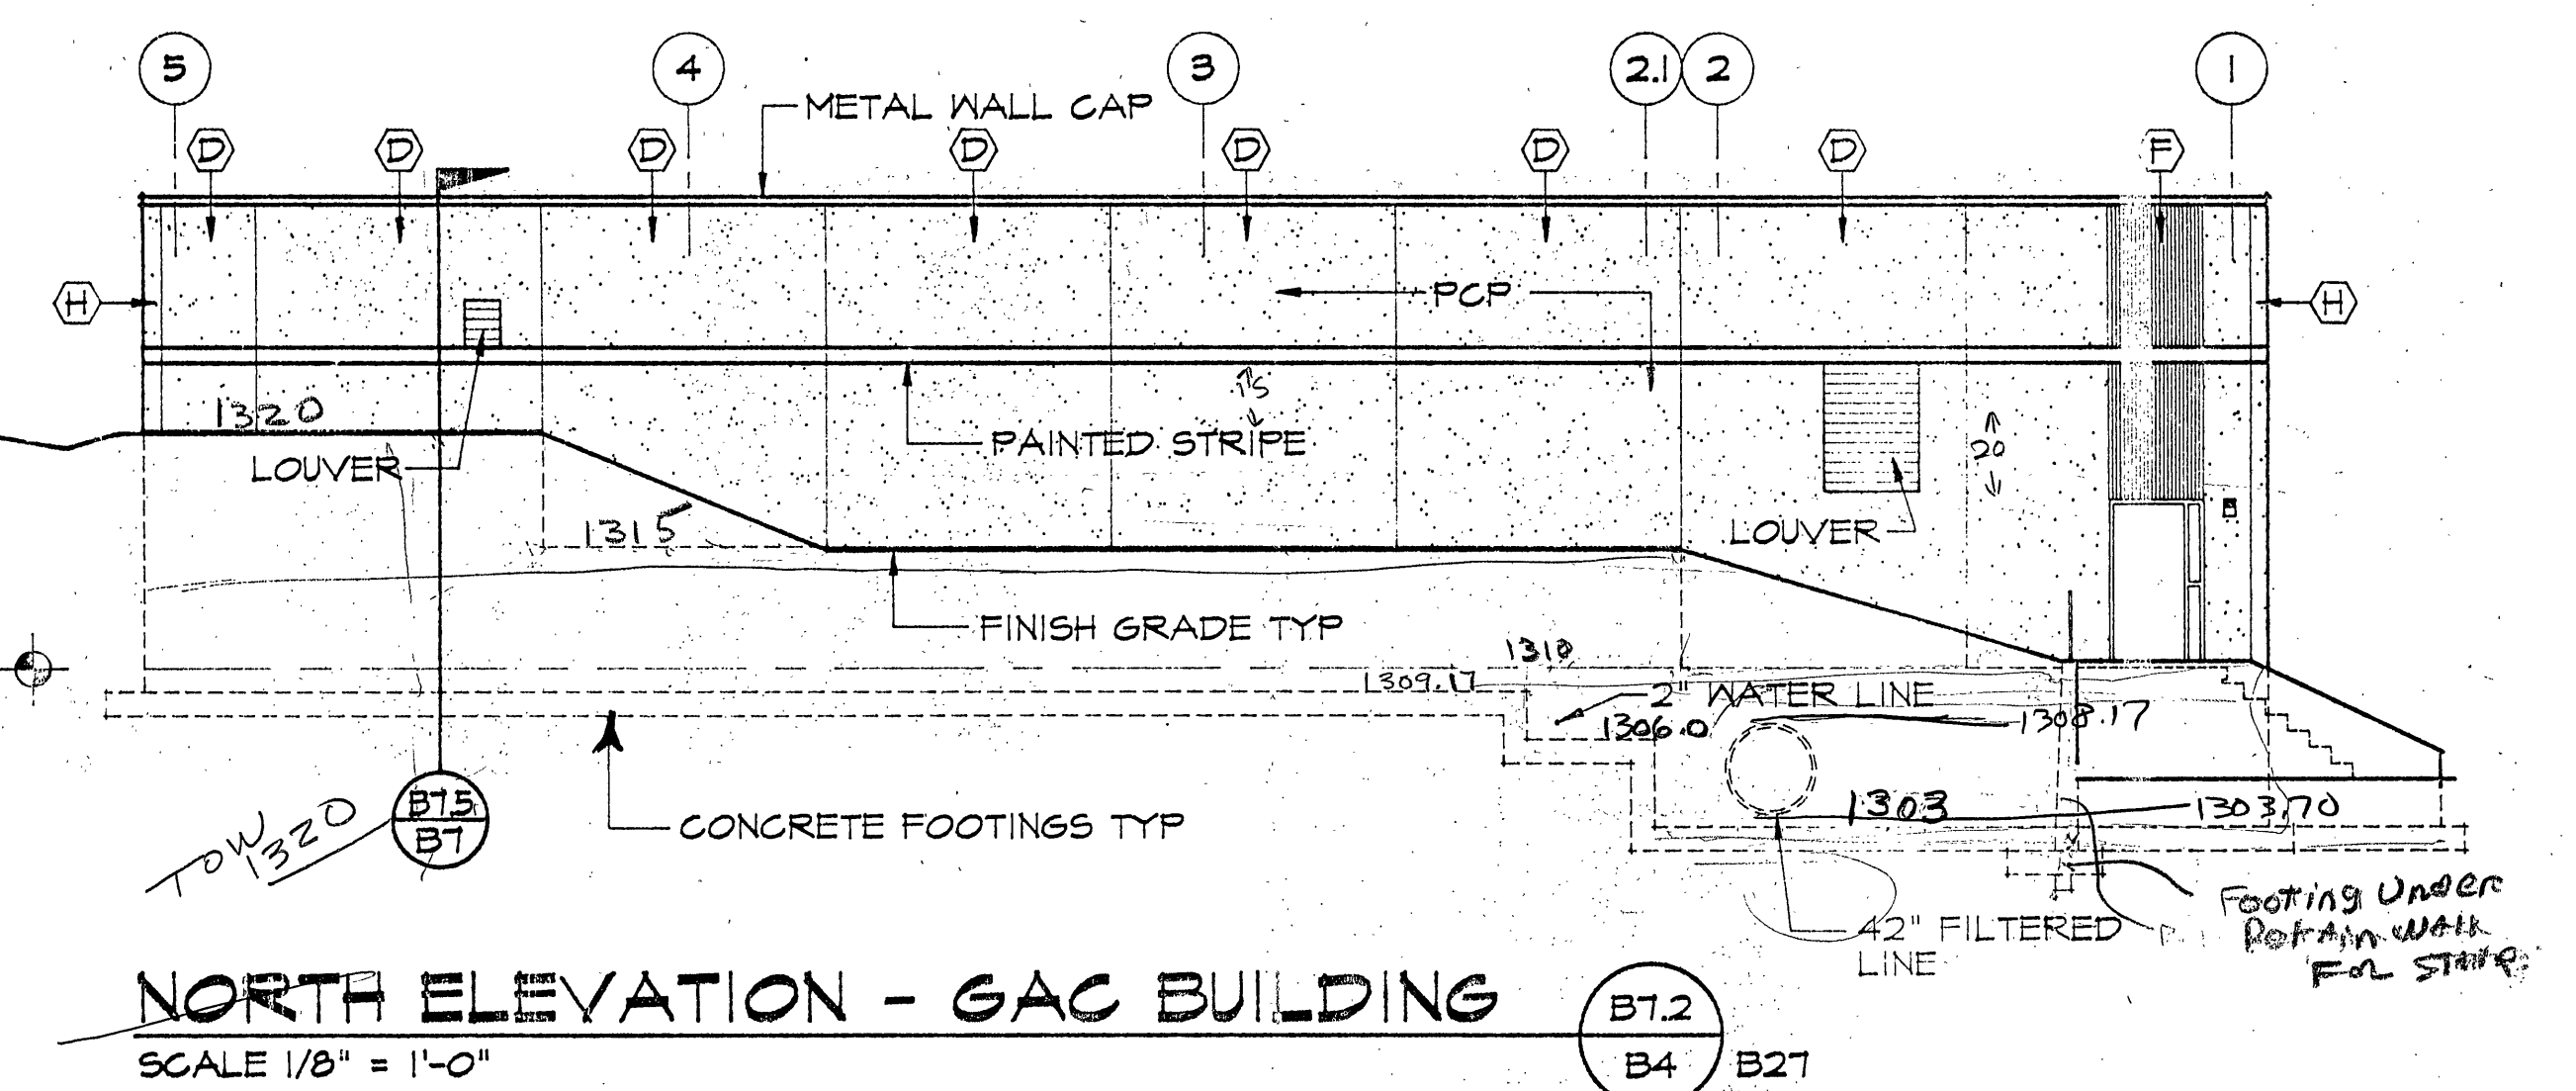


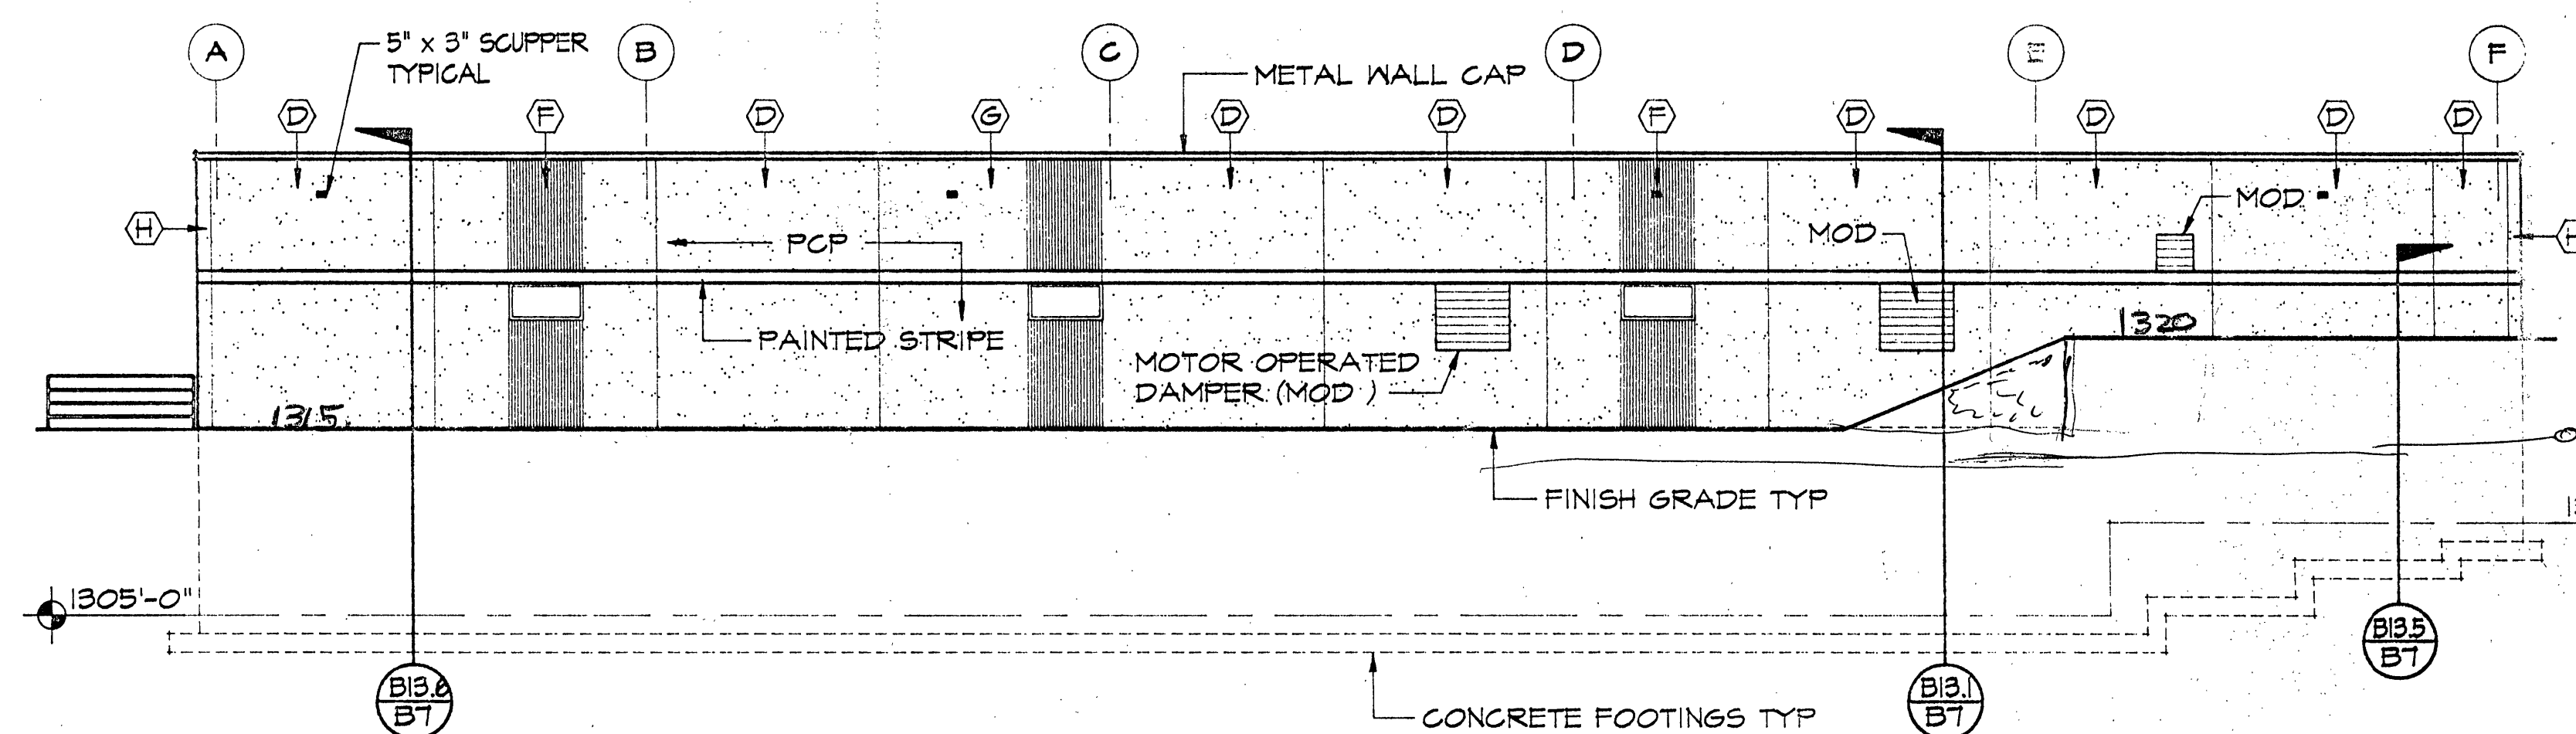


INSPECTOR'S AS-BUILTS 1995

WVWA ID# 6LDLIZ

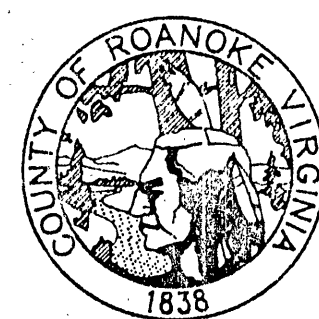

ROANOKE COUNTY WATER TREATMENT FACILITY

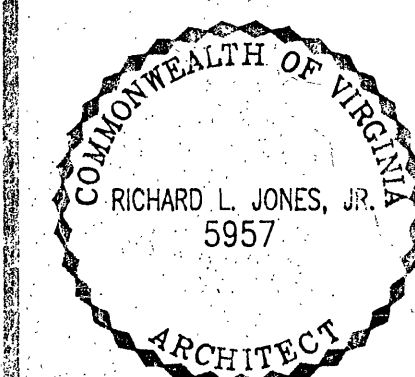

ELEVATIONS - GAC BUILDING

PROJECT ARCHITECT
R L J R

COMMISSION NUMBER
1417

TECHNICIANS
RWT

DATE
22 SEPT 1994

B7