



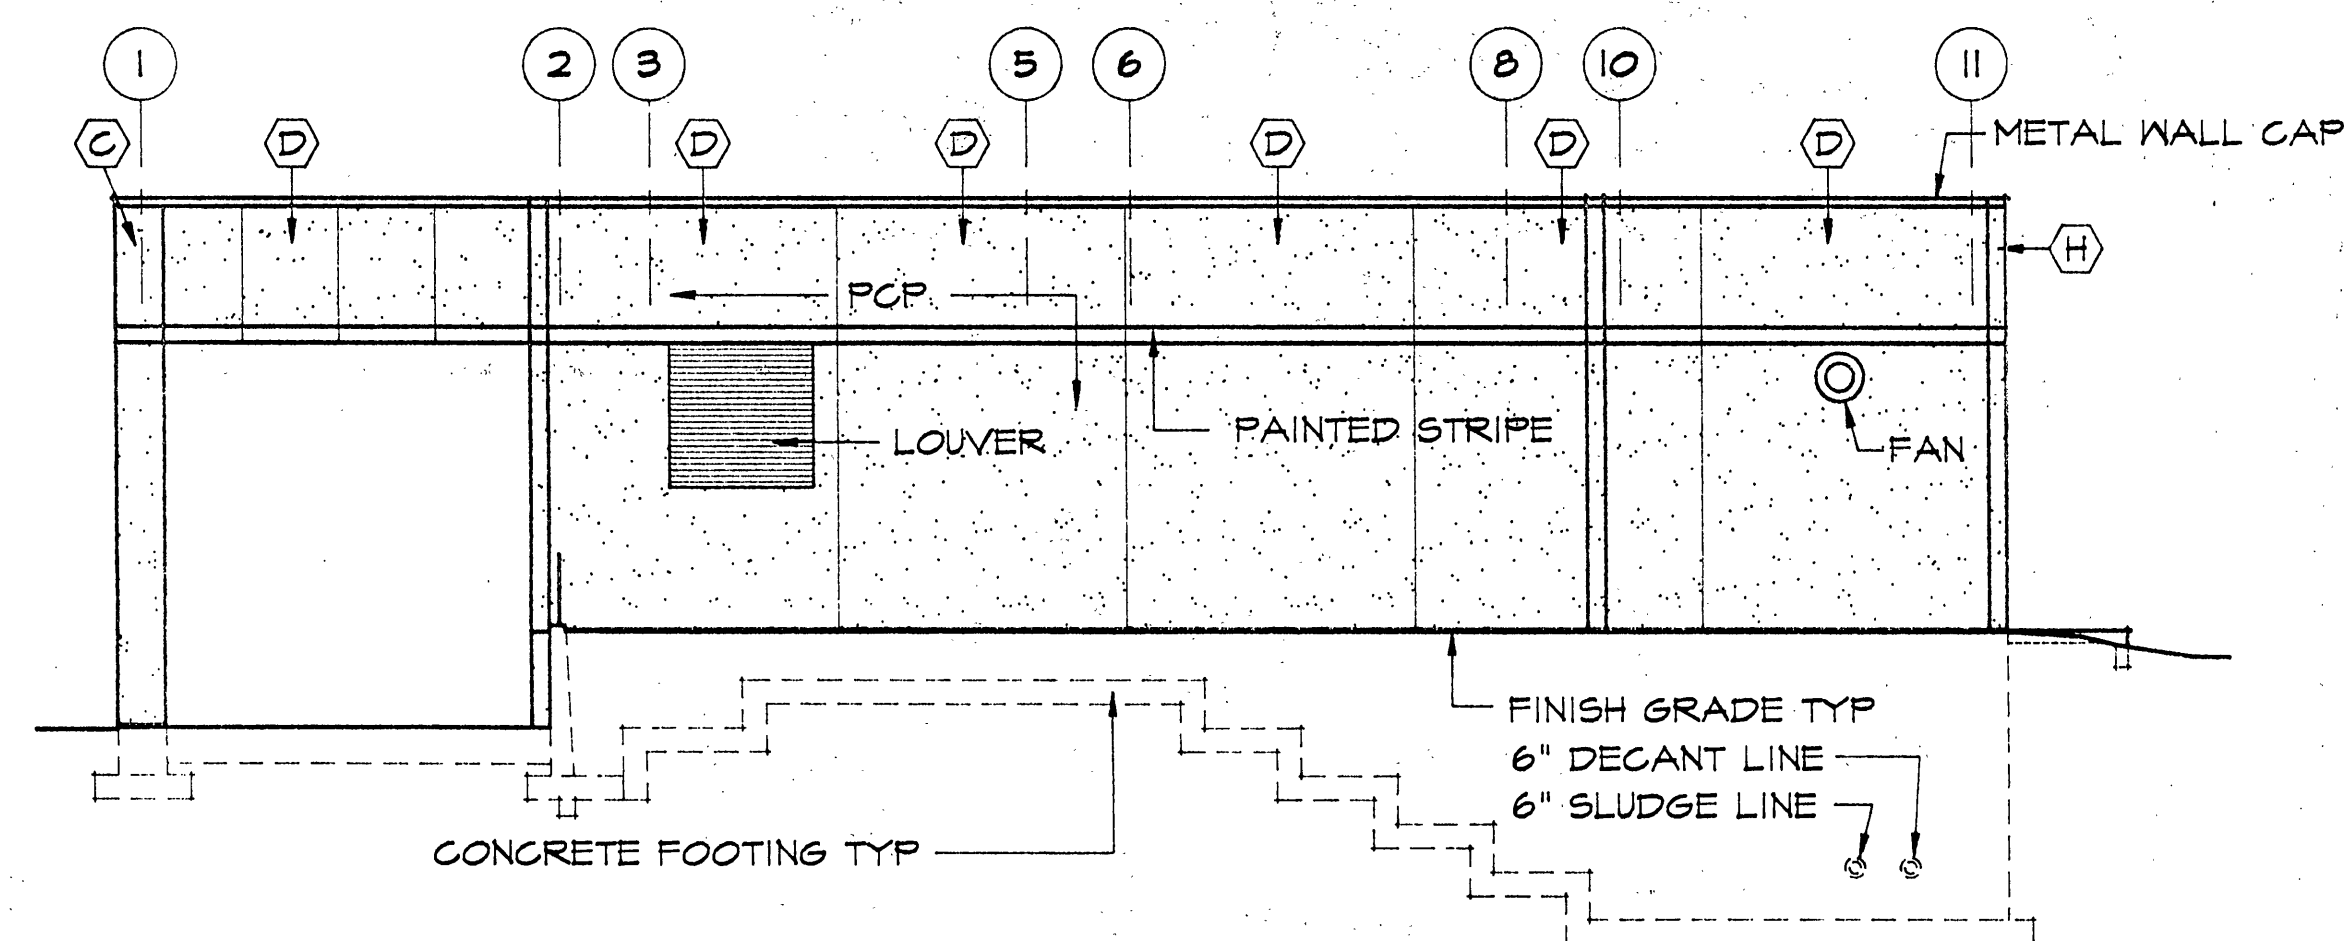


NORTH ELEVATION - POST TREATMENT BUILDING
SCALE 1/8" = 1'-0"

B8.1
B5 B27

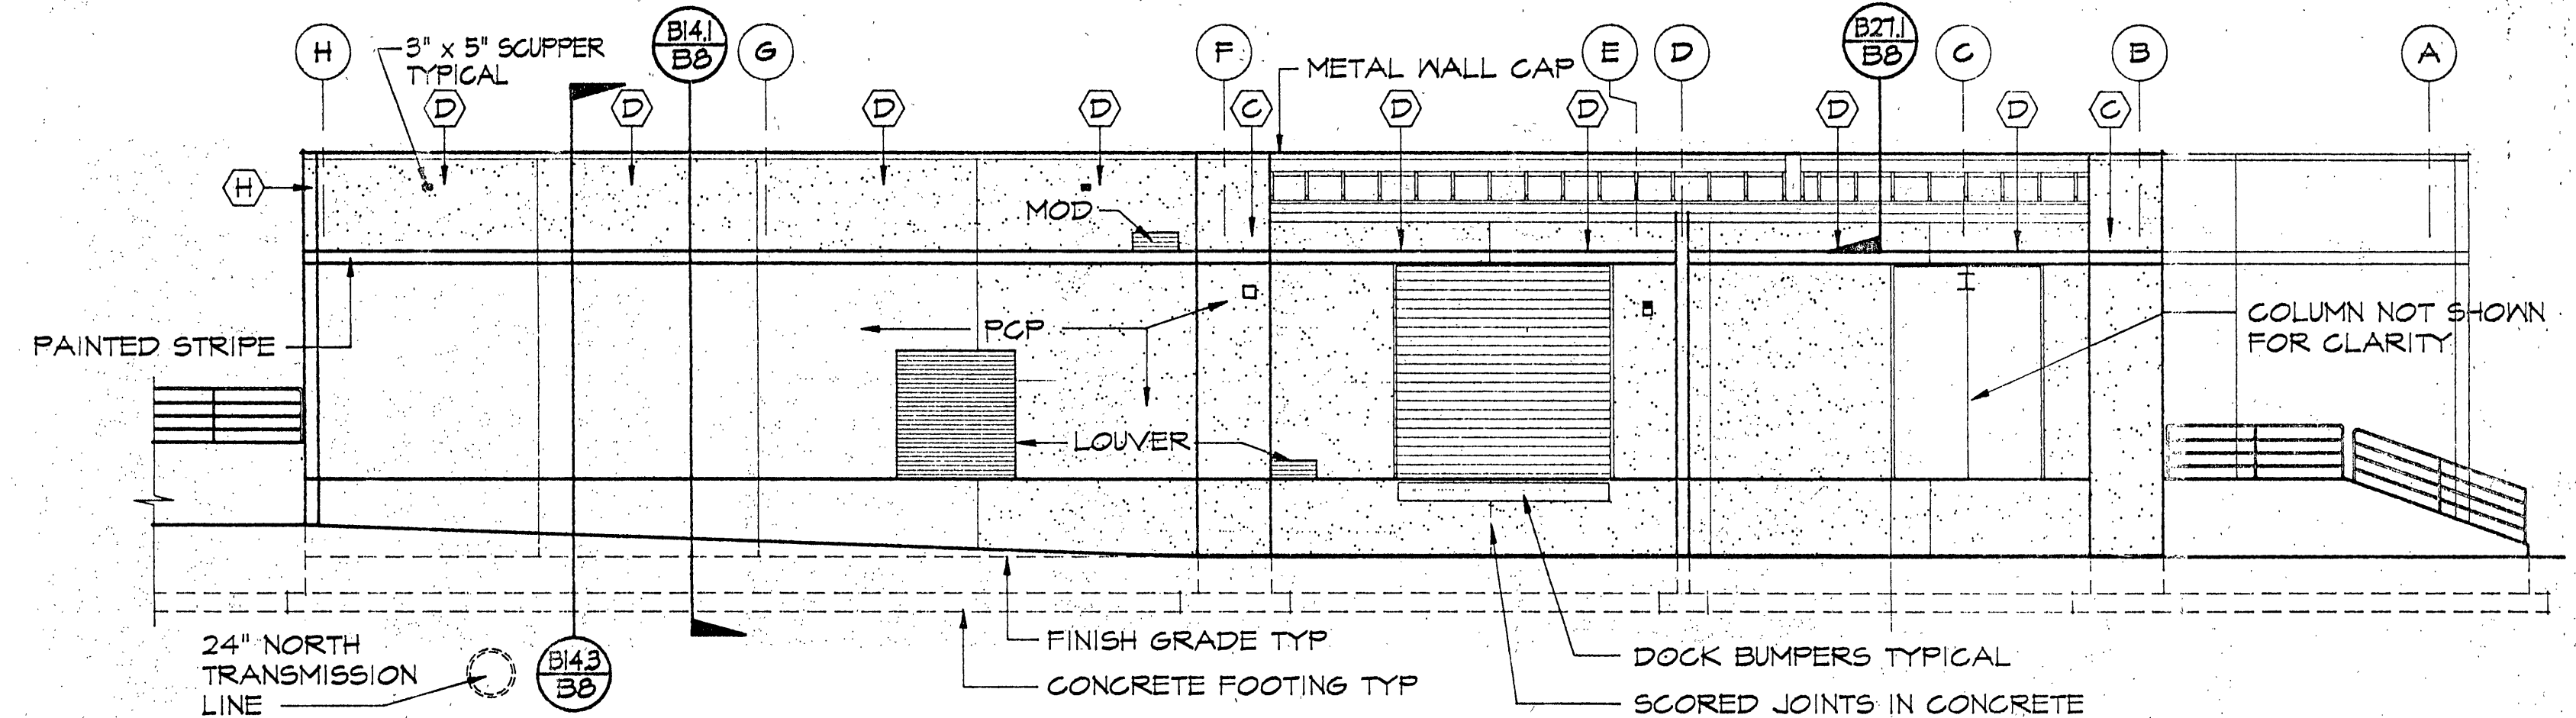

EAST ELEVATION - POST TREATMENT BUILDING
SCALE 1/8" = 1'-0"

B8.2
B5 B27

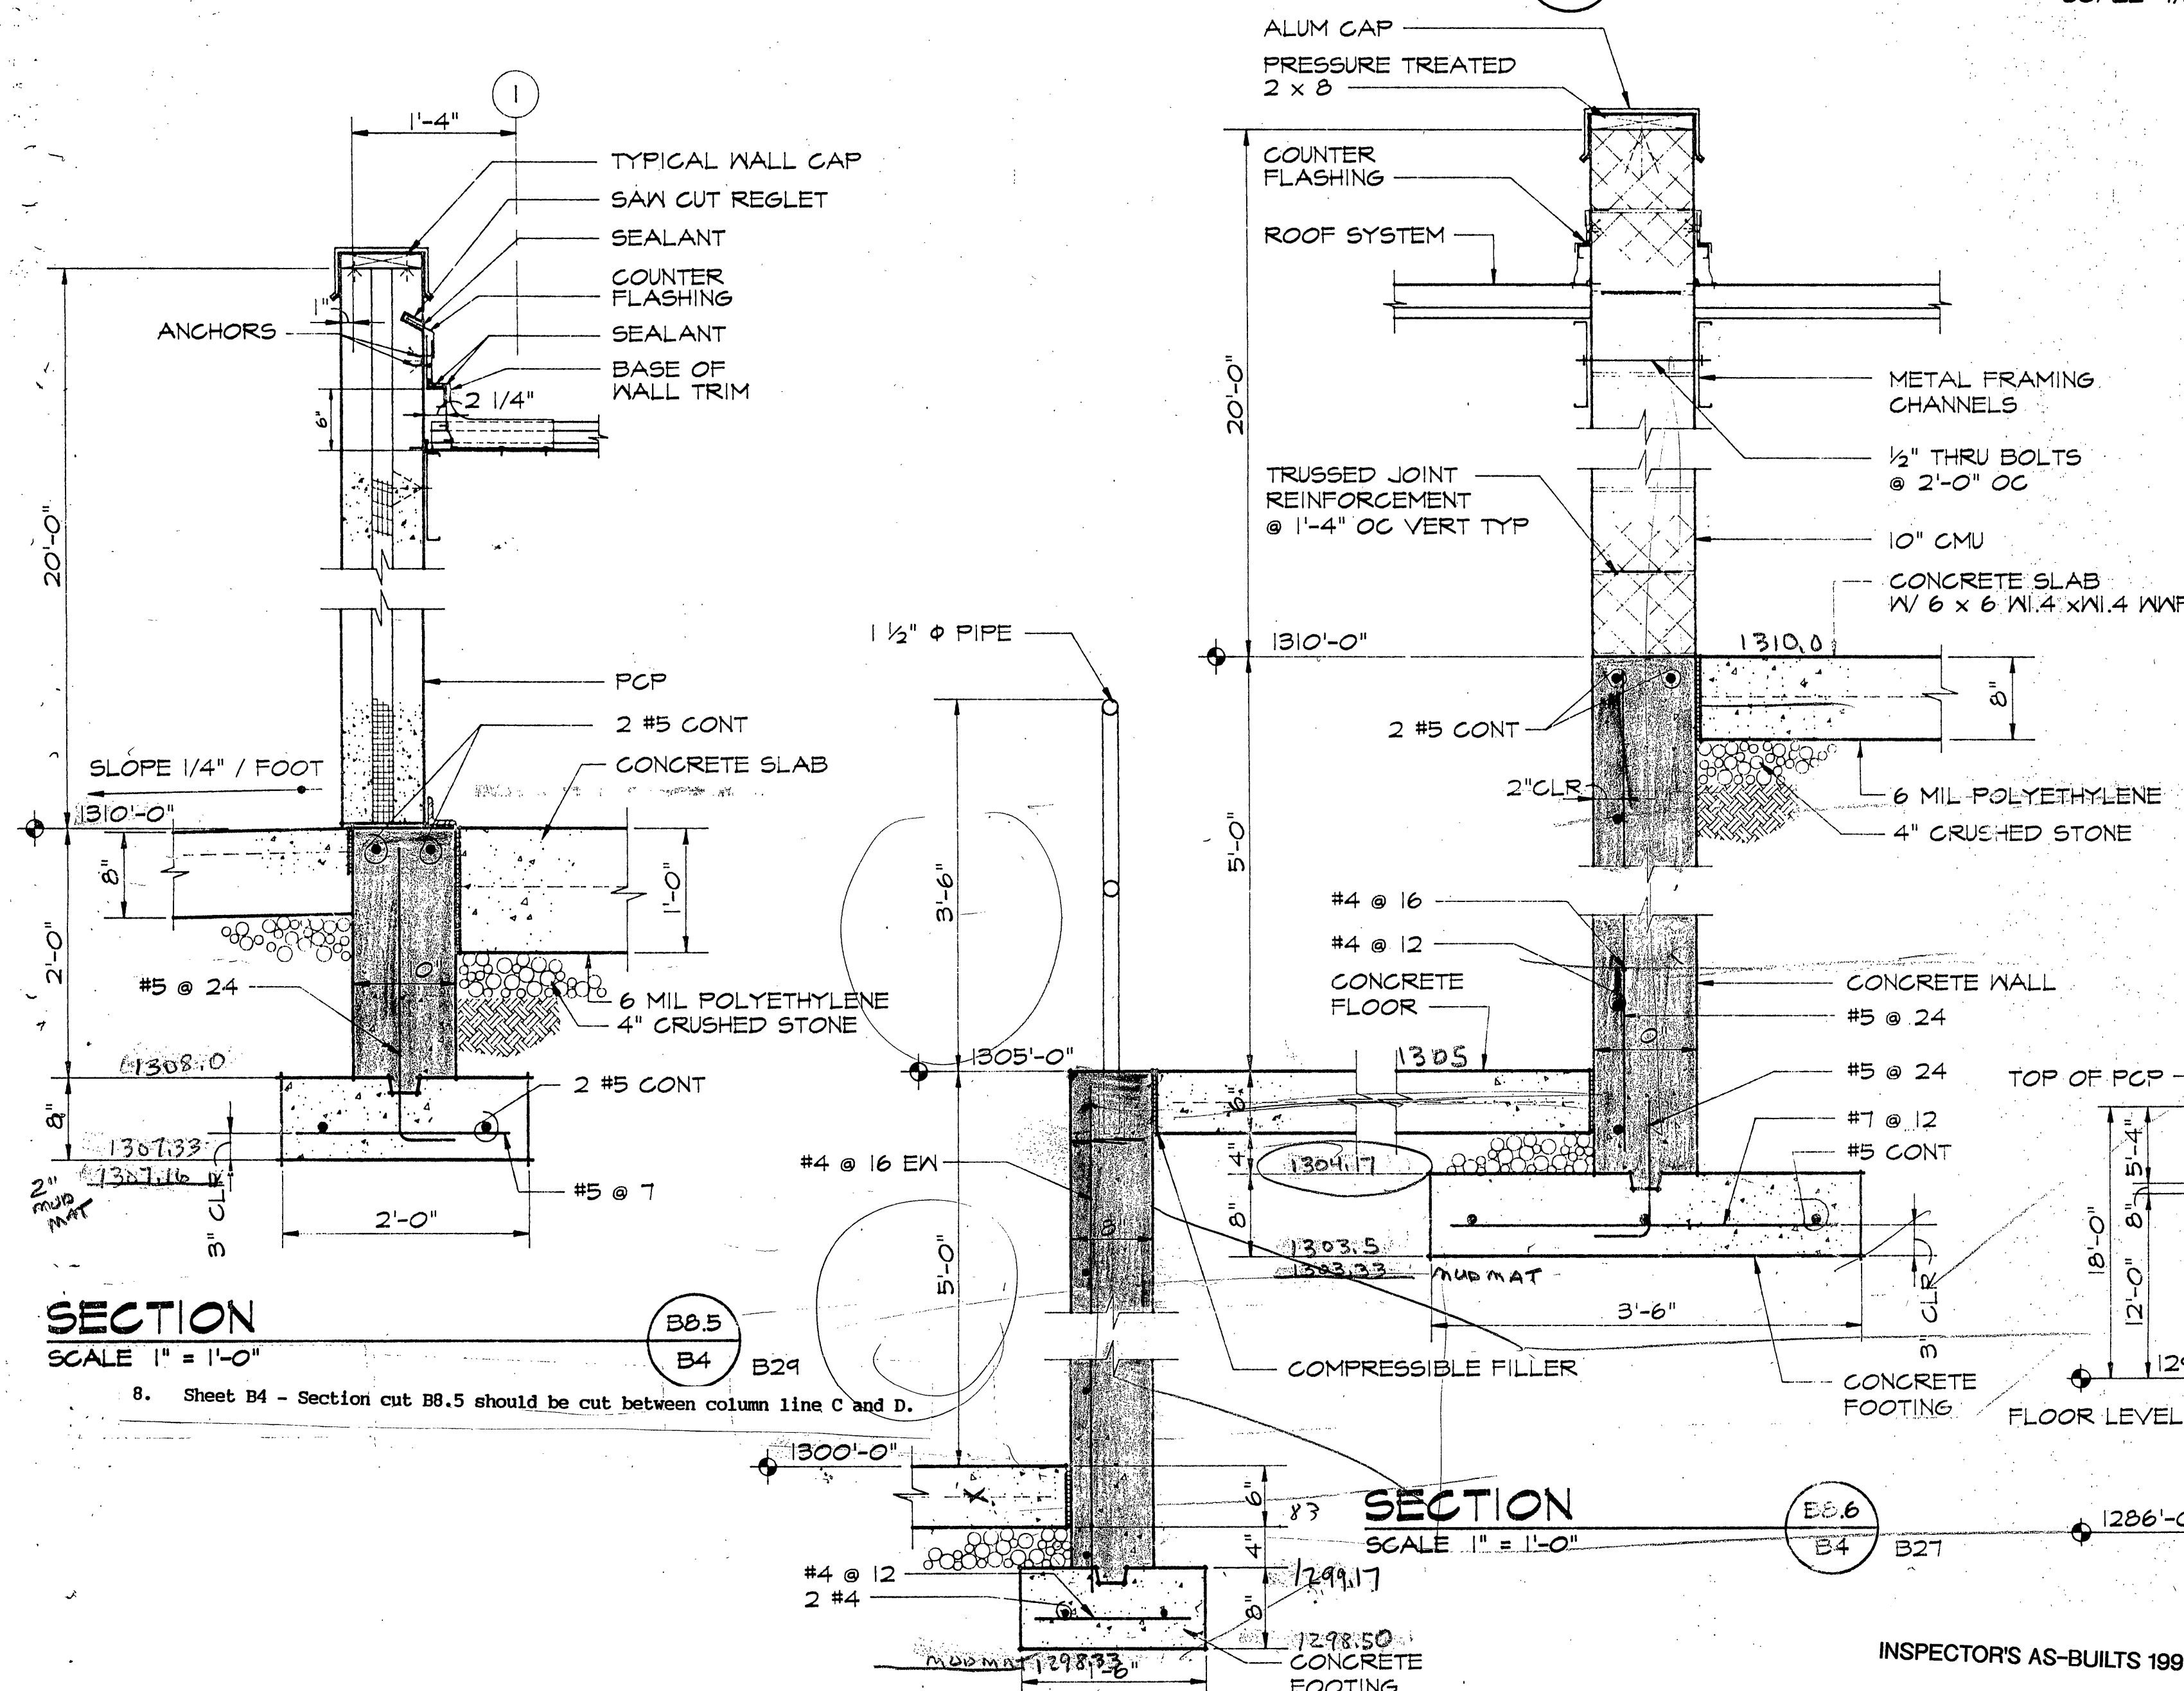


SECTION
SCALE 1" = 1'-0"

8. Sheet B4 - Section cut B8.5 should be cut between column line C and D.

SECTION
SCALE 1" = 1'-0"

INSPECTOR'S AS-BUILTS 1995

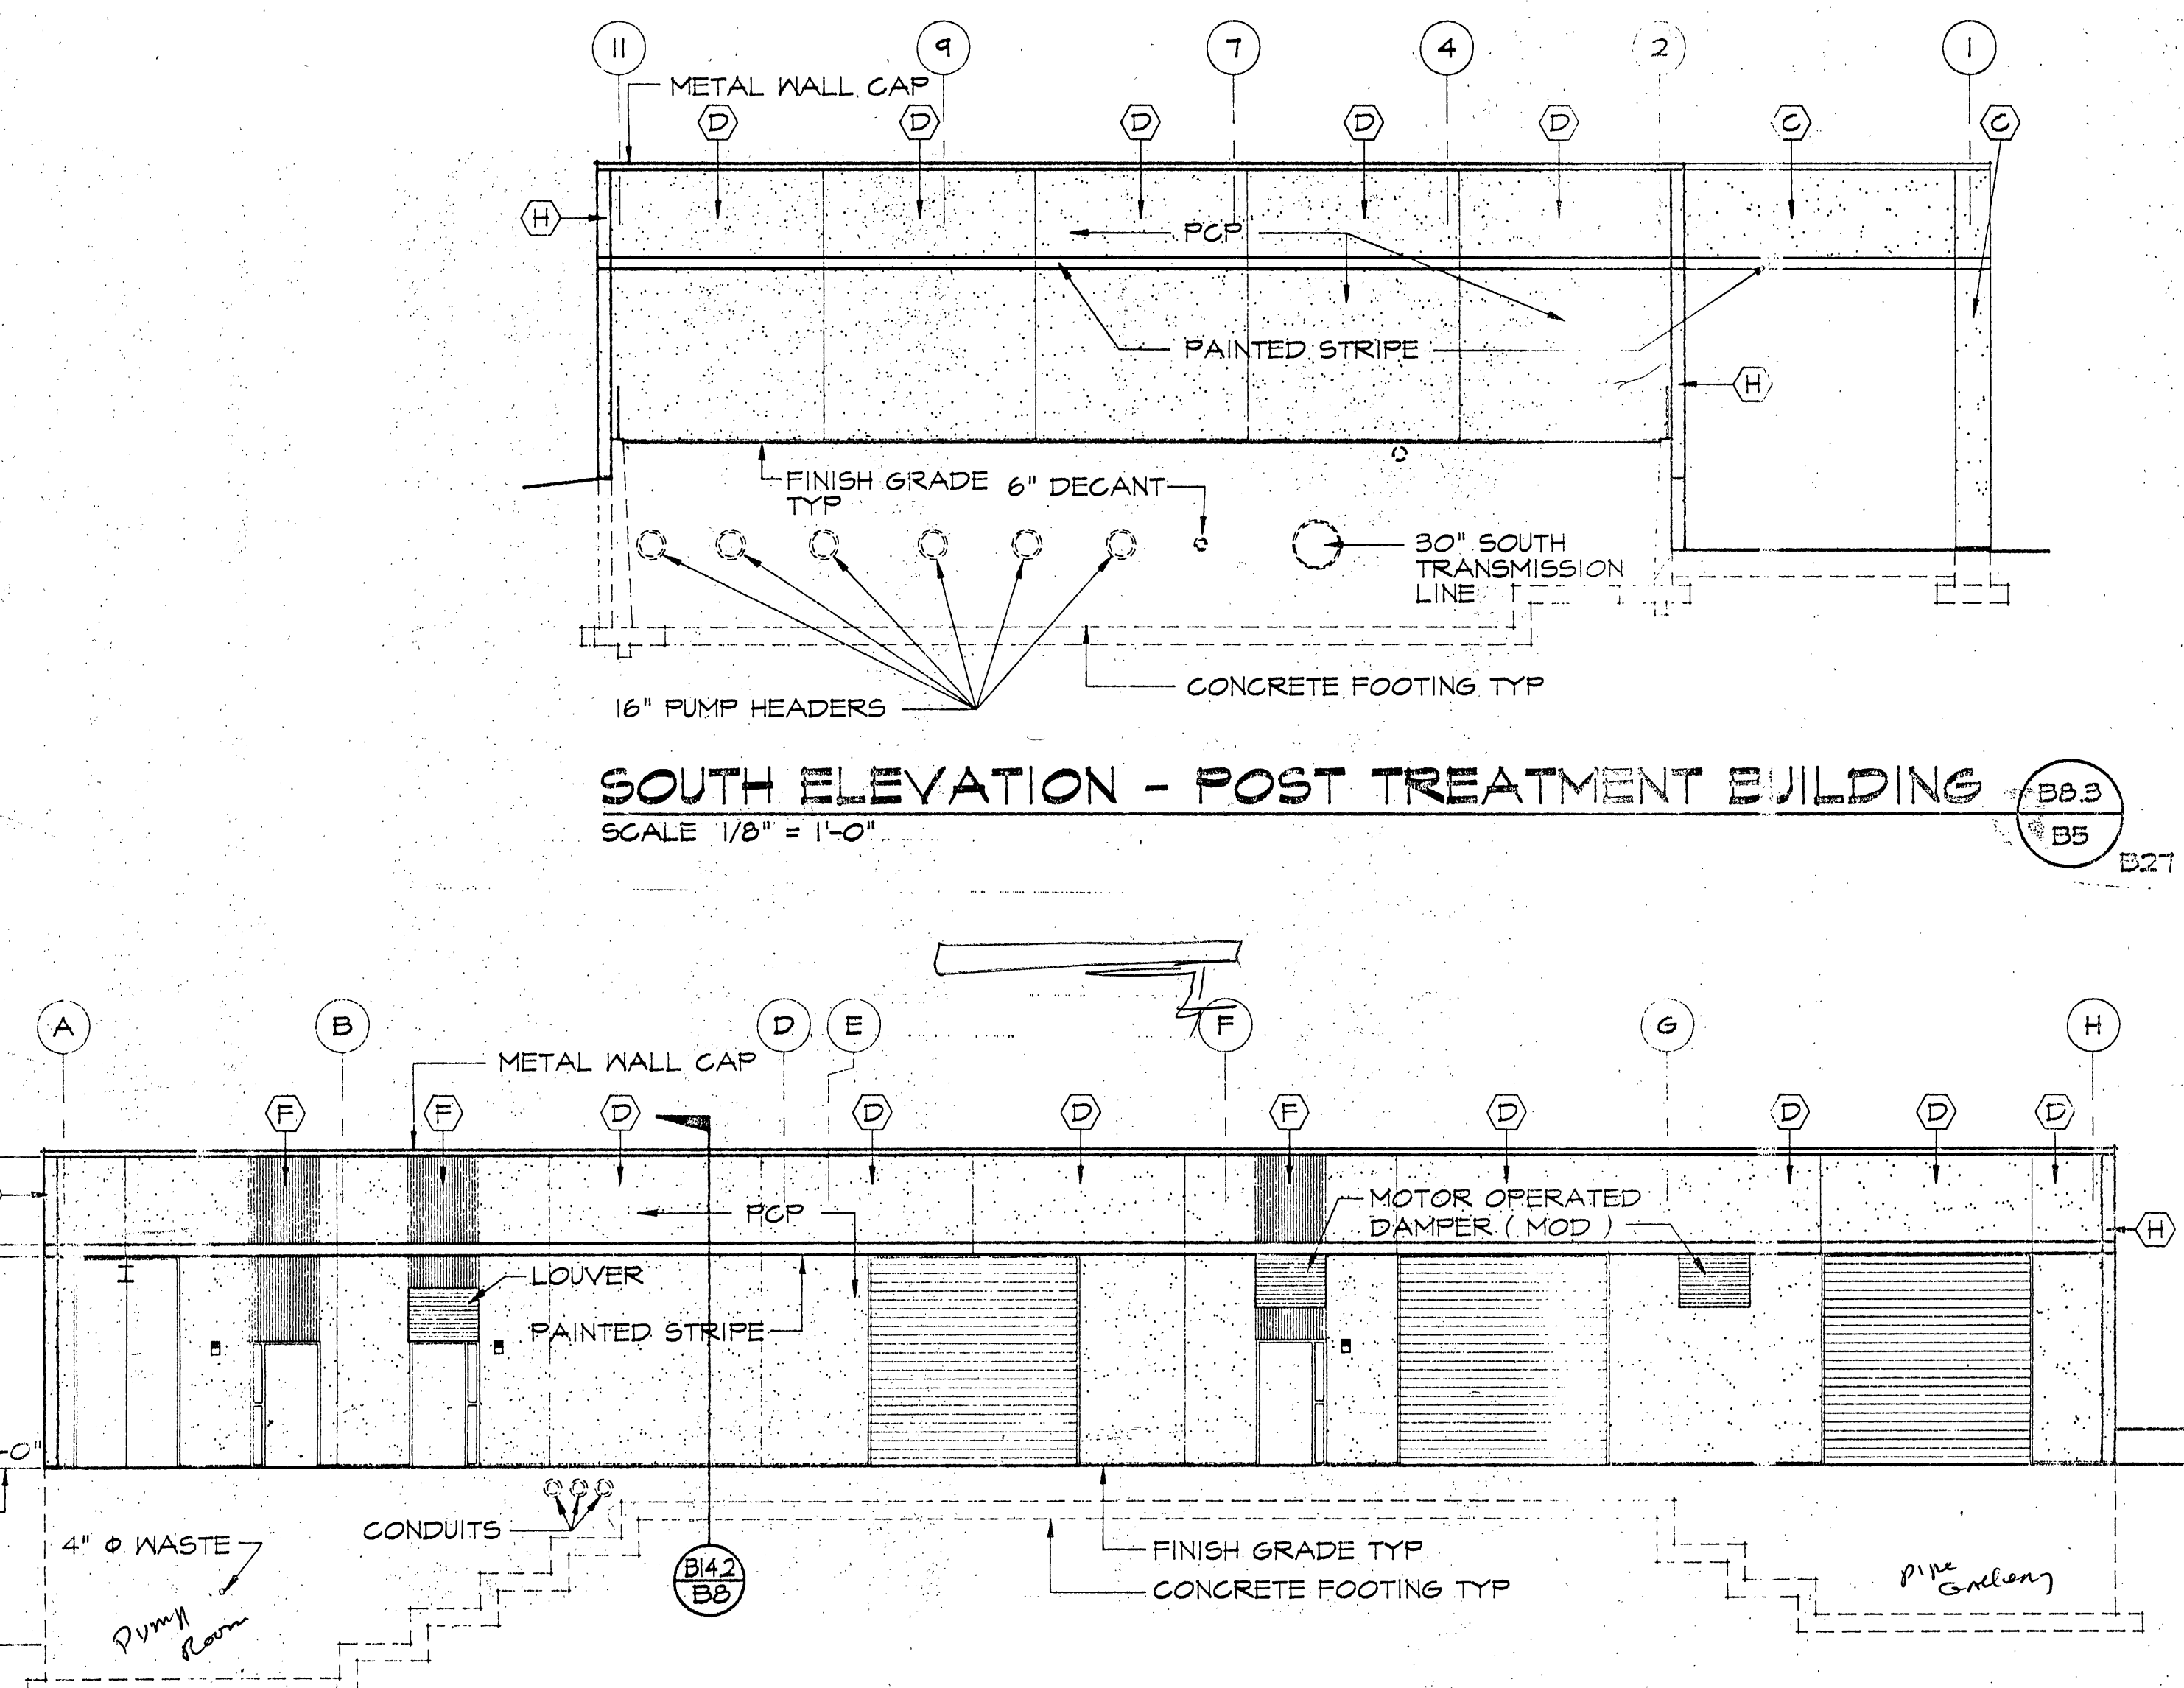


SOUTH ELEVATION - POST TREATMENT BUILDING
SCALE 1/8" = 1'-0"


B8.3
B5 B27

WEST ELEVATION - POST TREATMENT BUILDING
SCALE 1/8" = 1'-0"

B8.4
B5 B27

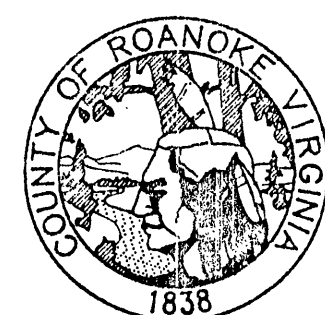

**ROANOKE COUNTY
WATER TREATMENT
FACILITY**

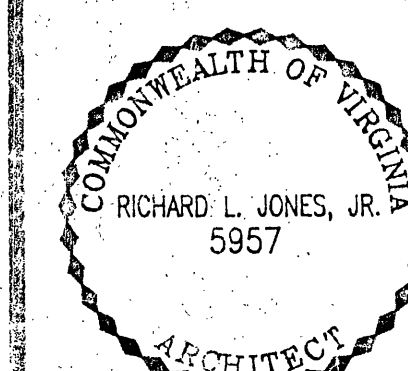

ELEVATIONS - POST TREATMENT

PROJECT ARCHITECT
RLJ JR

COMMISSION NUMBER
1913

TECHNICIAN
RAT

DATE
22 SEPT 1994

B8