



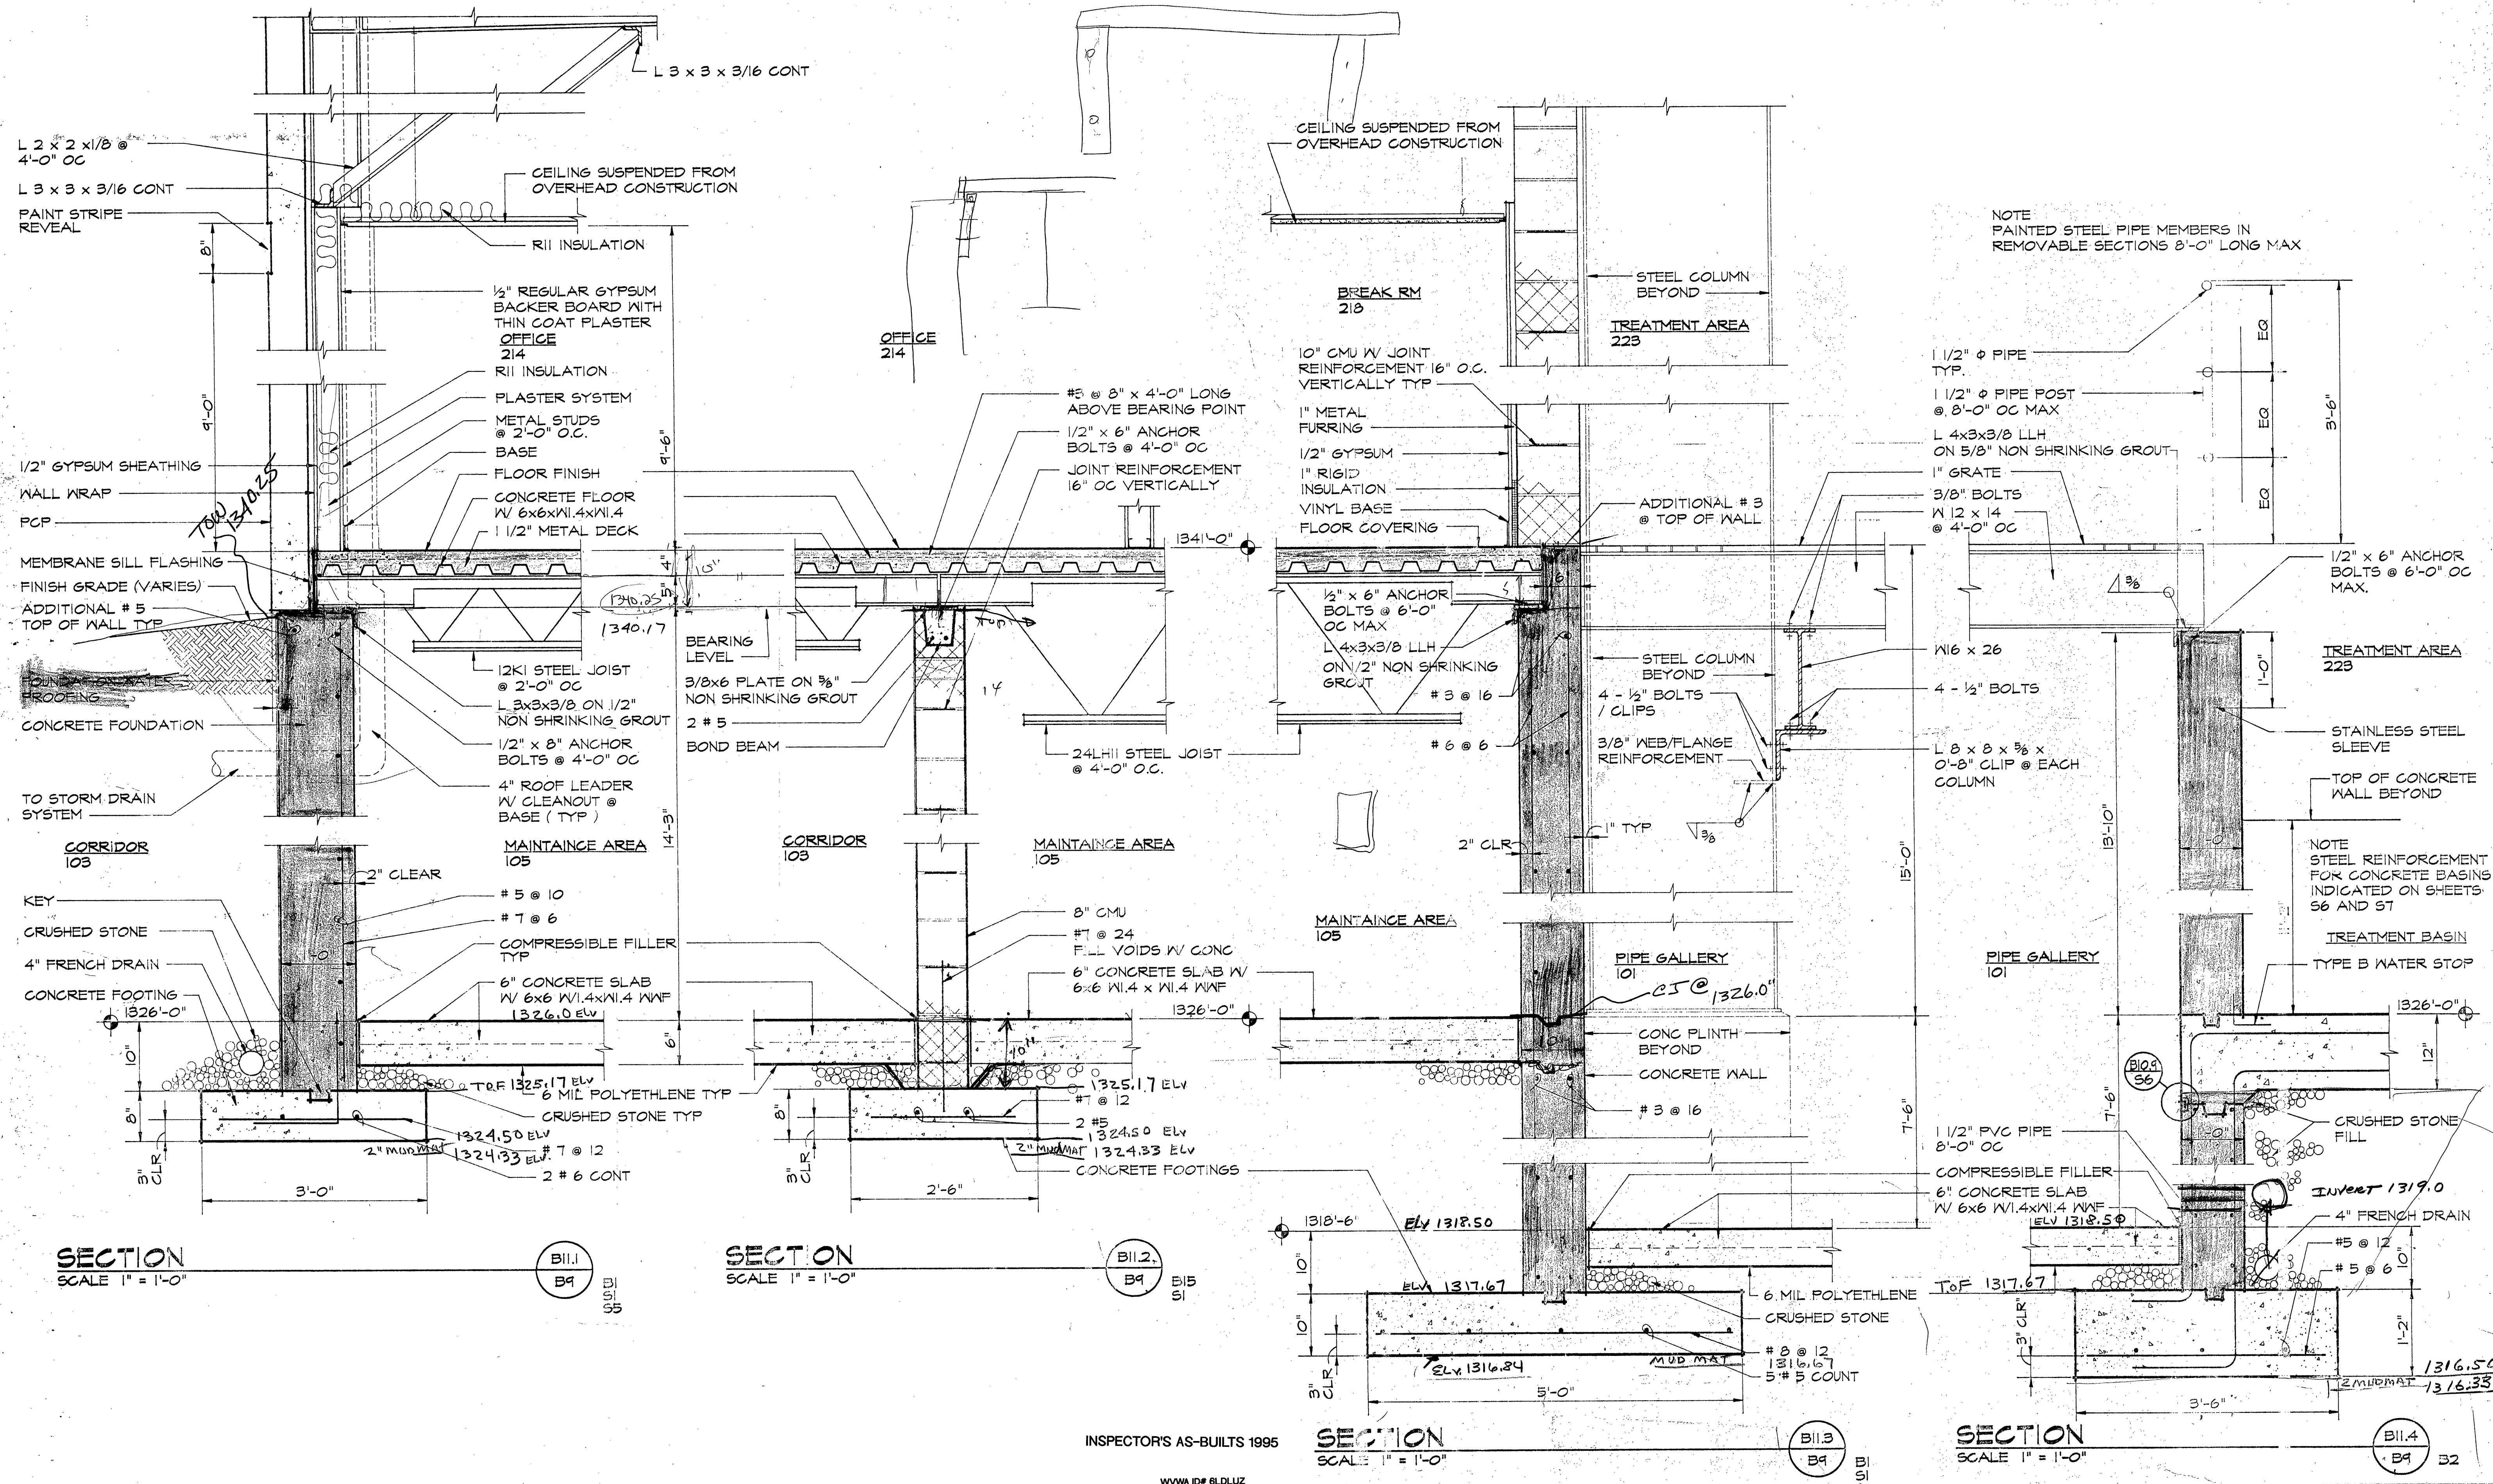


INSPECTOR'S AS-BUILTS 1995

WWW.ID# 8LDLZ

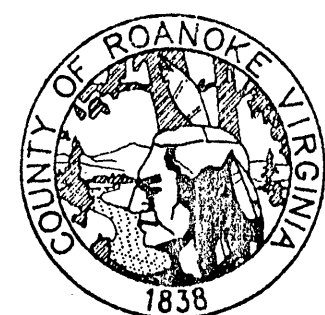

ROANOKE COUNTY WATER TREATMENT FACILITY

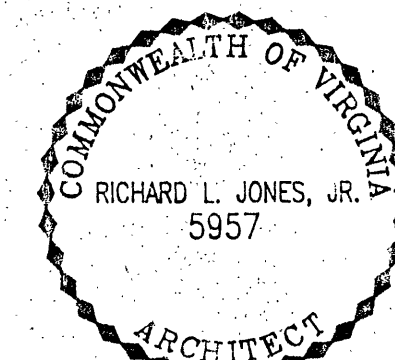

SECTIONS

PROJECT ARCHITECT

RLJR

COMMISSION NUMBER

1913

TECHNICIAN

RAT

DATE

22 SEPT 1994

B11