

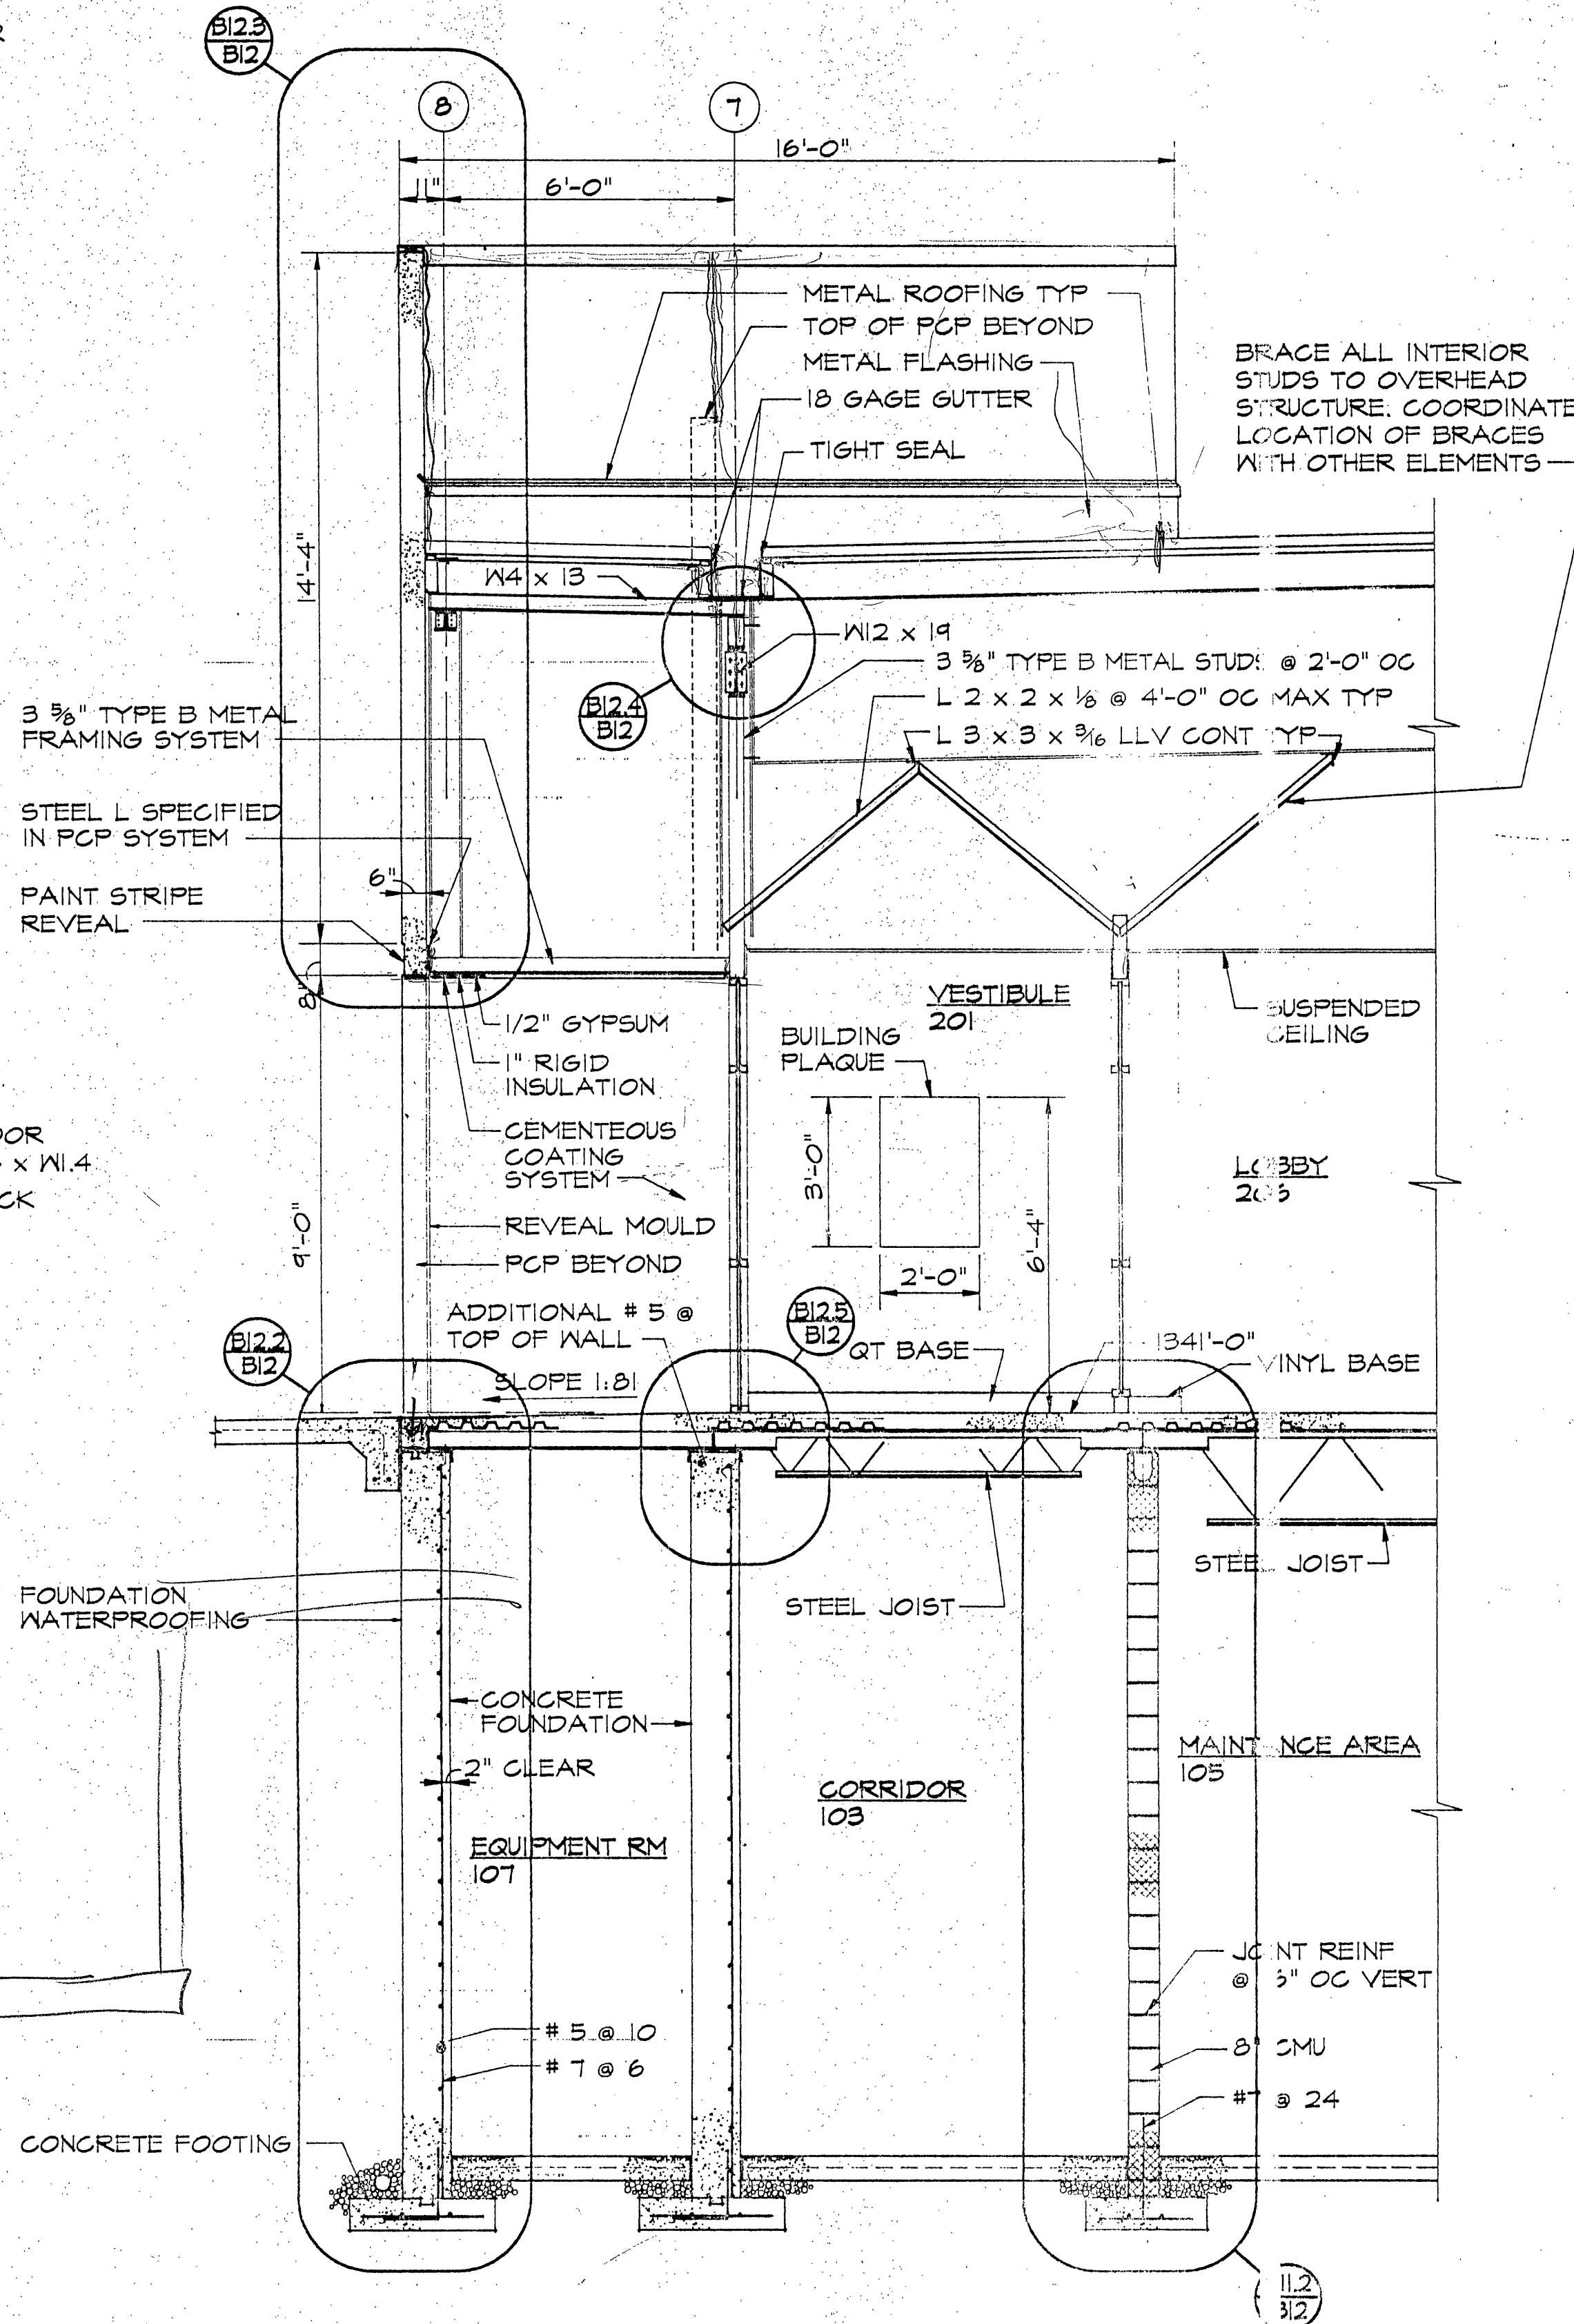
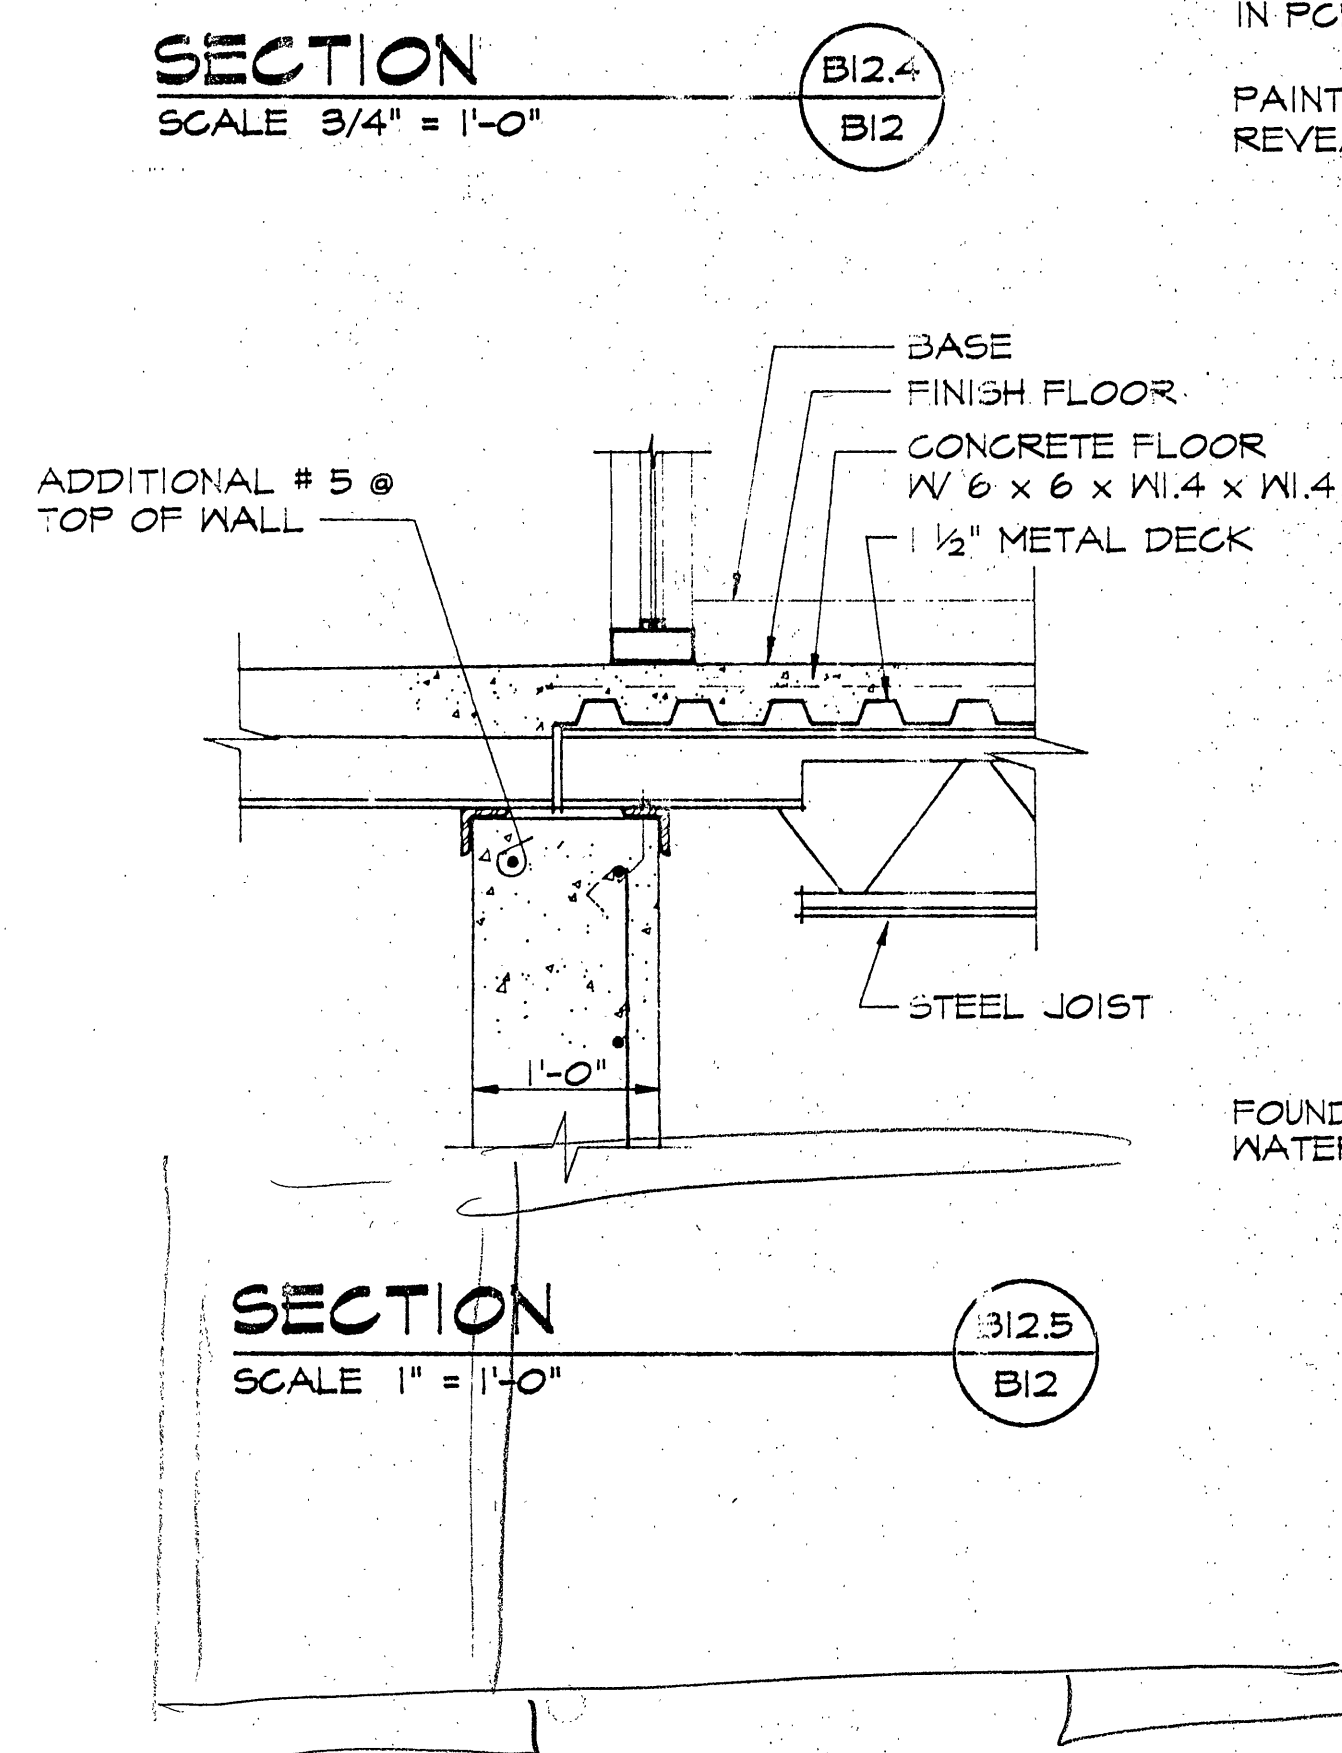
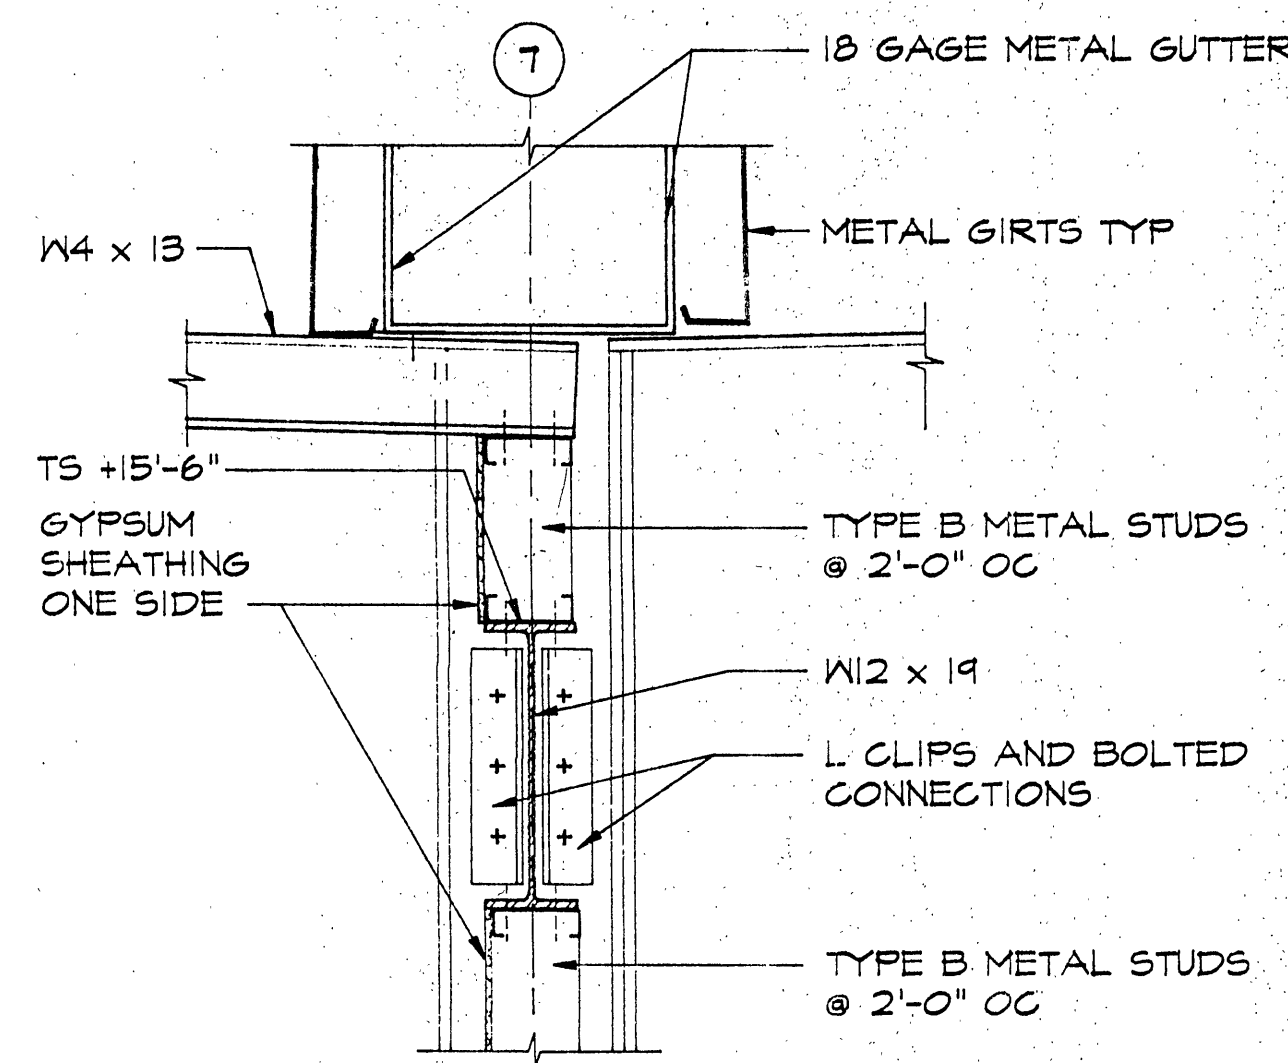
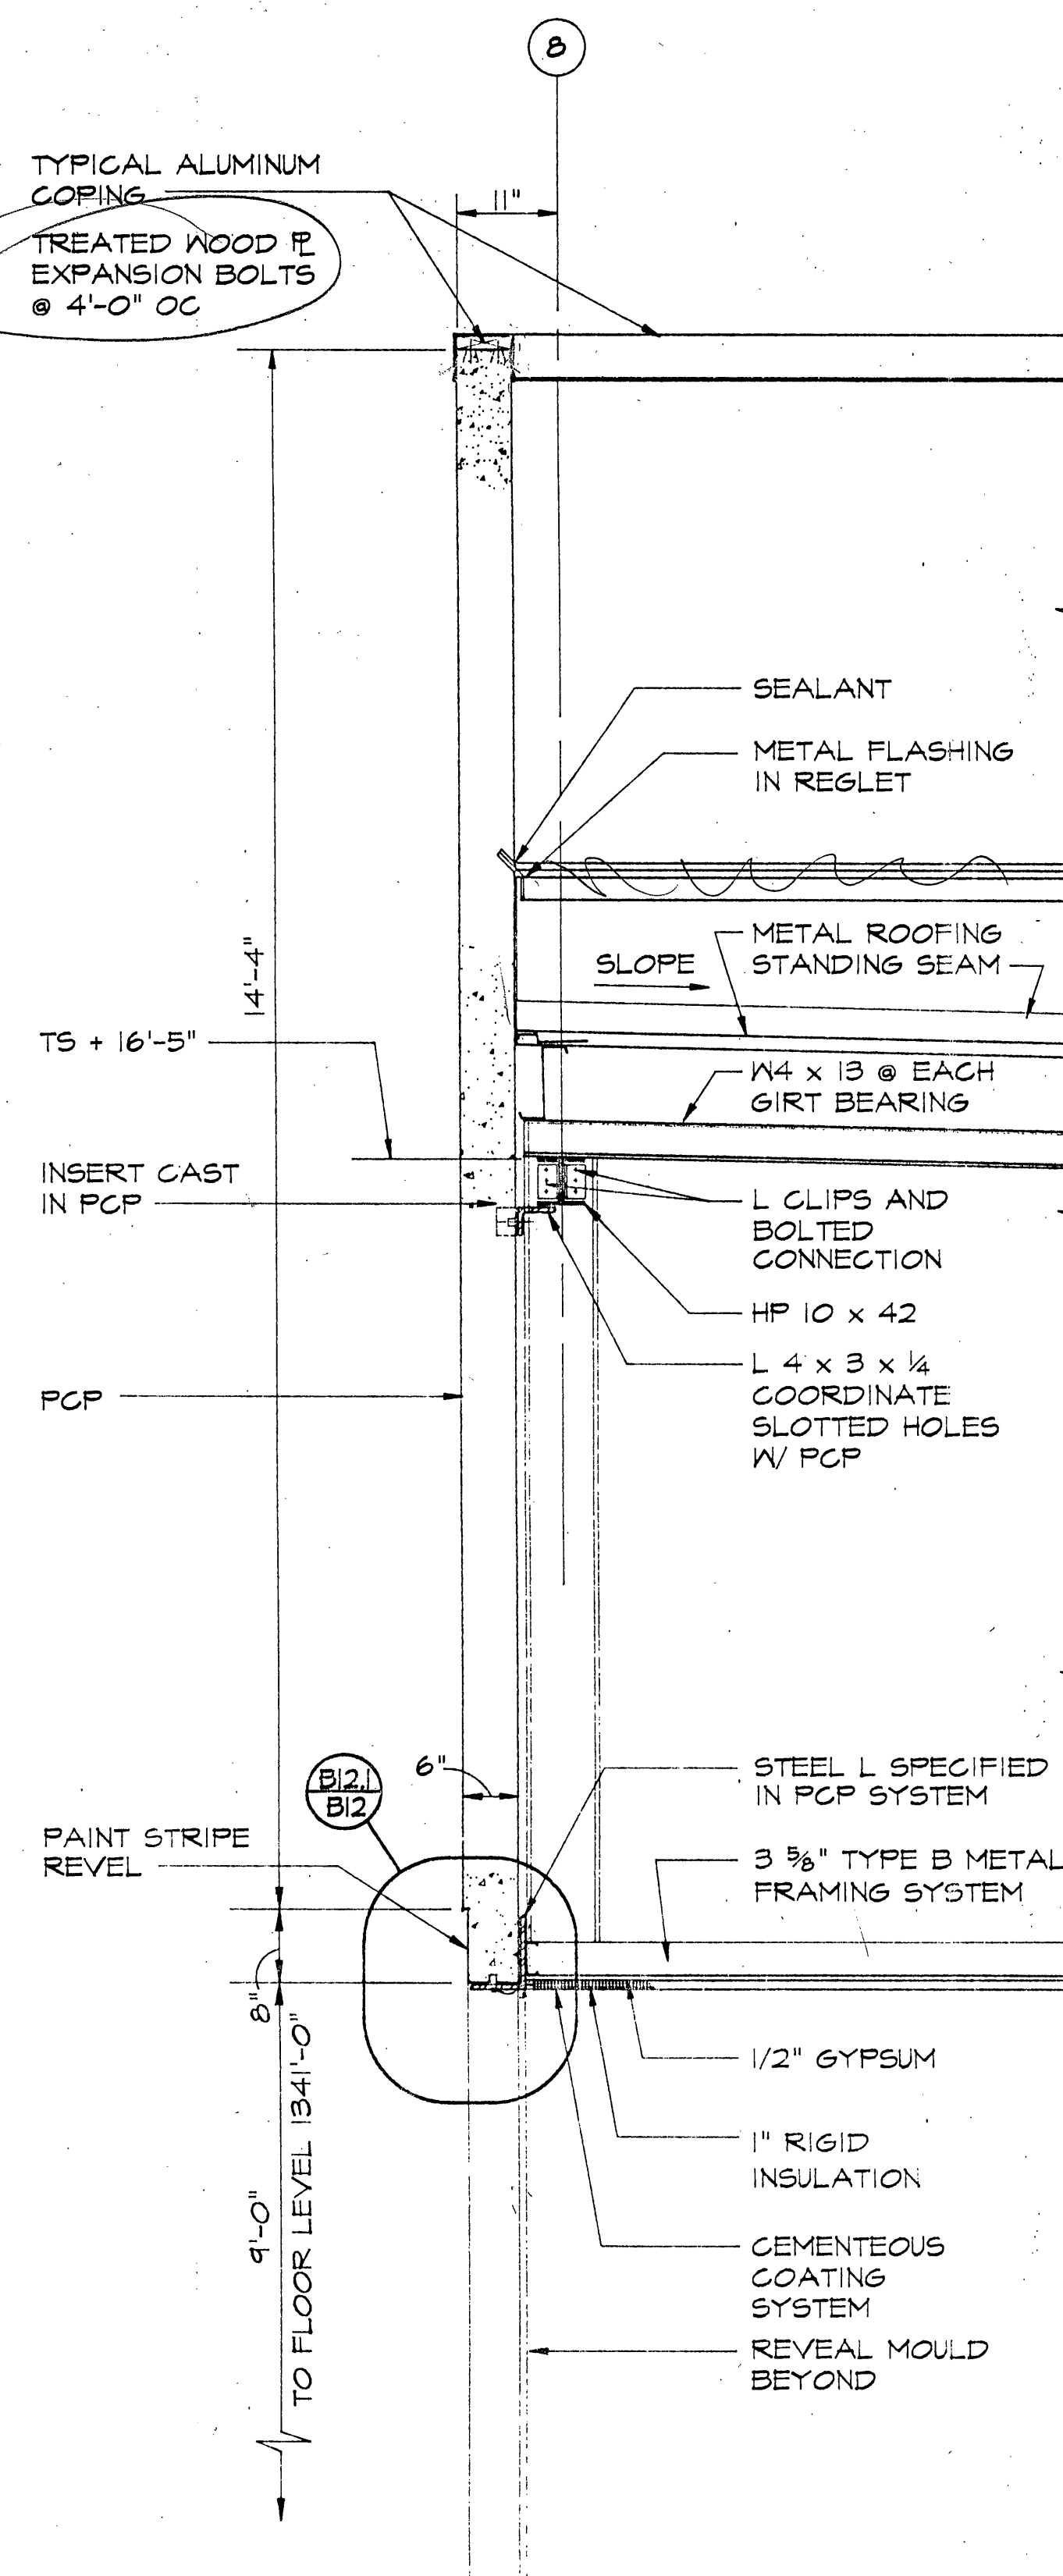
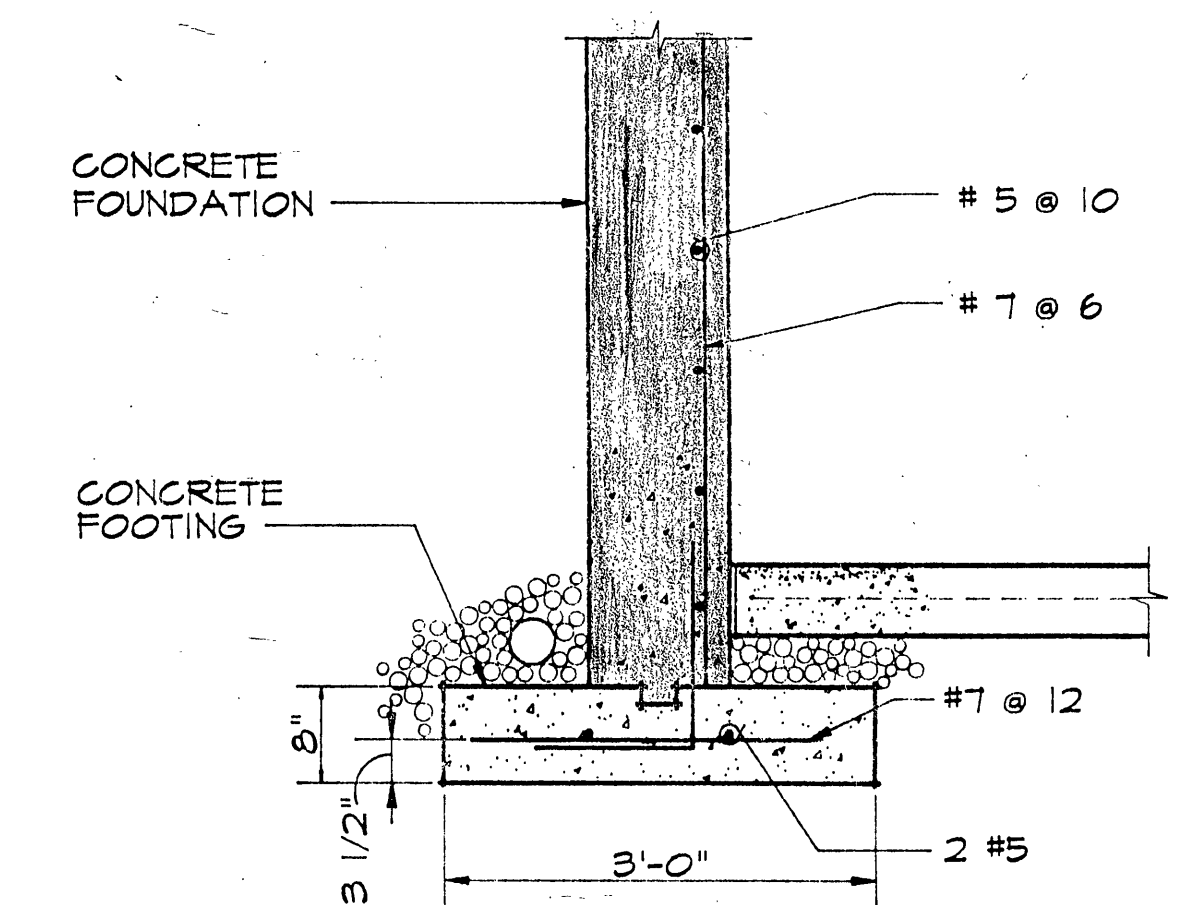
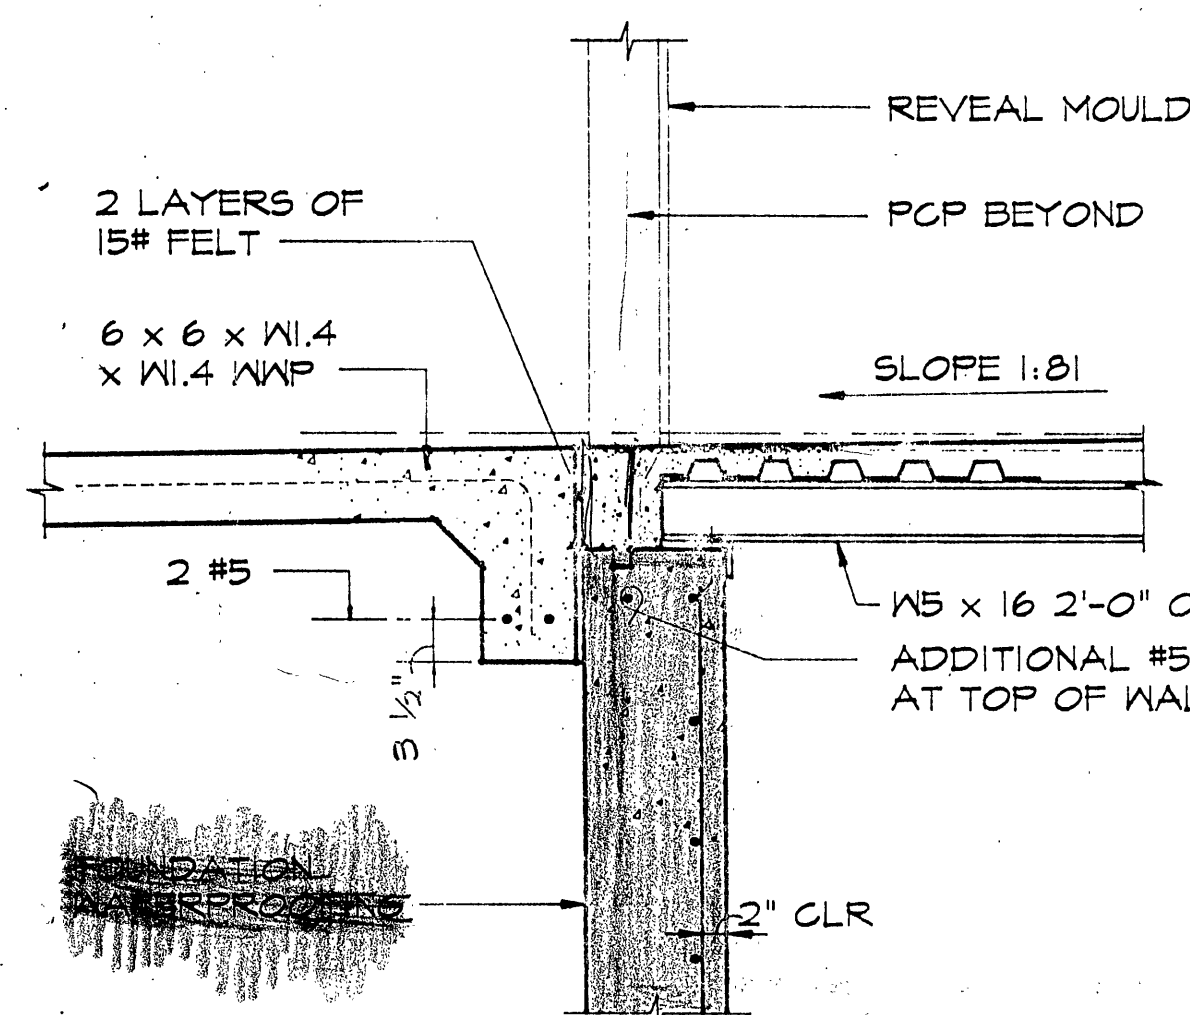


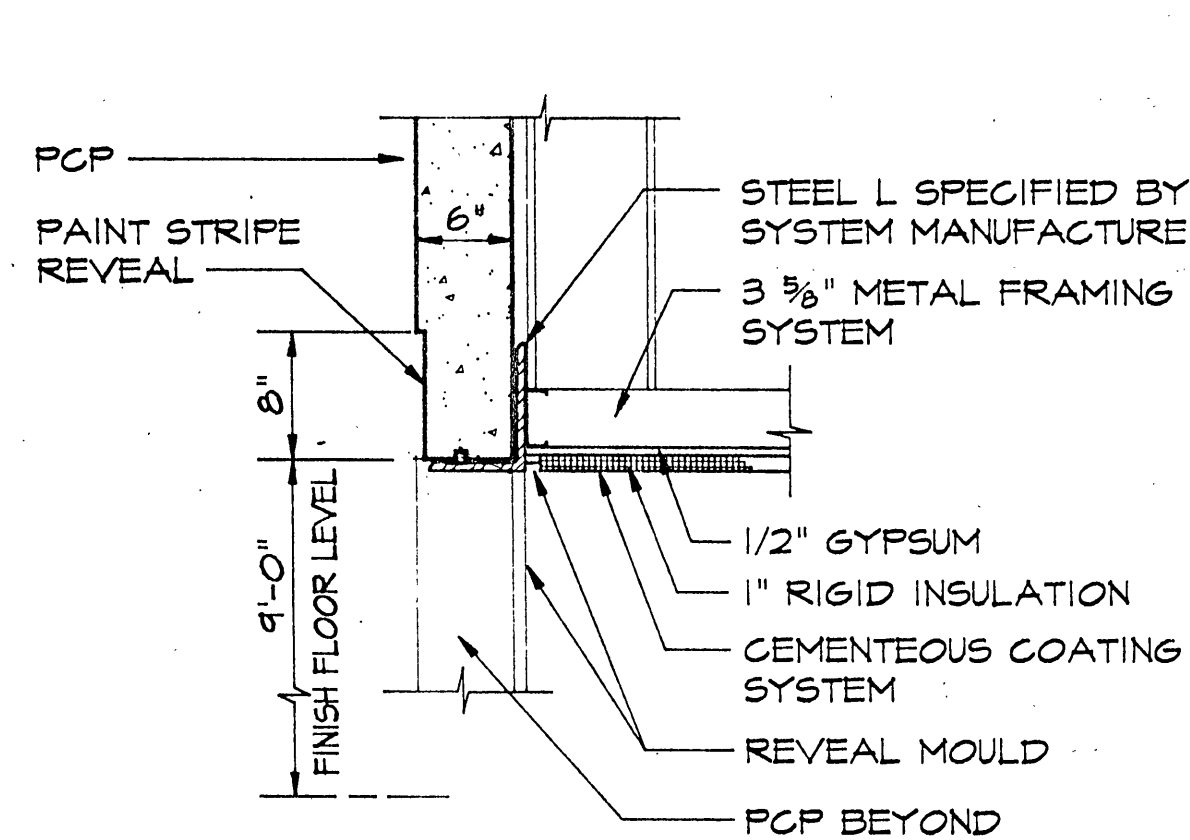


INSPECTOR'S AS-BUILTS 1995

WWW.ID# 6LDL2

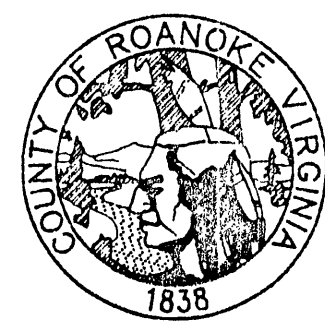

ROANOKE COUNTY WATER TREATMENT FACILITY

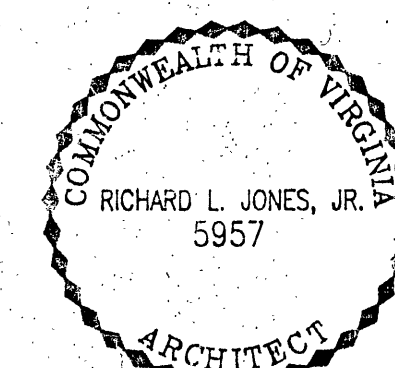

SECTIONS	
PROJECT ARCHITECT RLJ JR	COMMISSION NUMBER 1913
TECHNICIANS RWT	DATE 22 SEPT 1994

B12

JONES & JONES ASSOCIATES ARCHITECTS, P.C.