




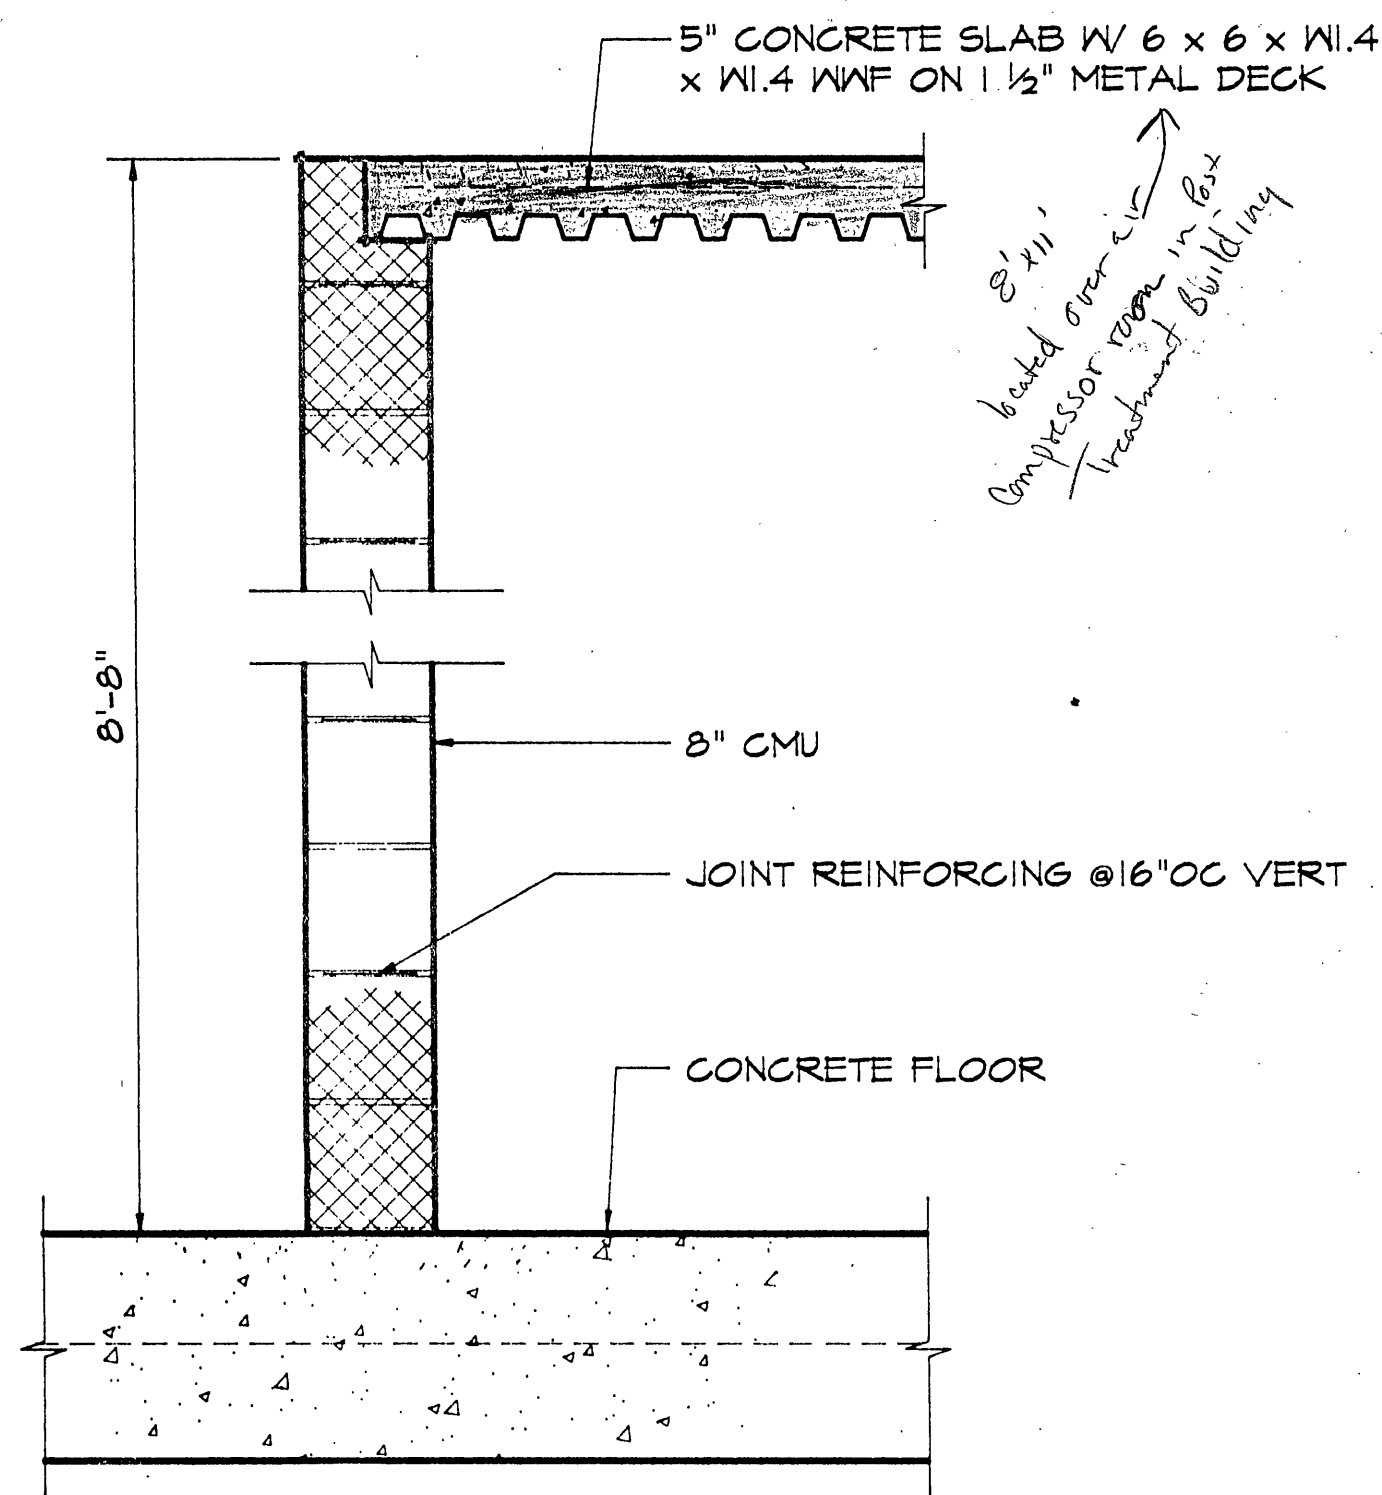


SECTION
SCALE 1" = 1'-0"
B14.4
B14

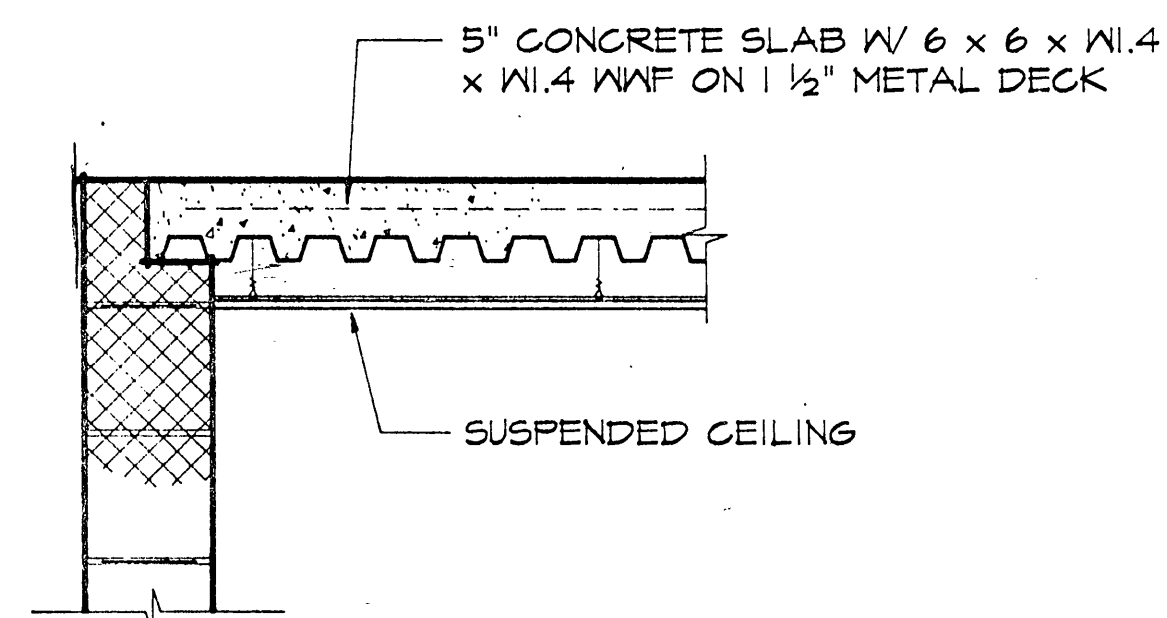


SECTION
SCALE 1" = 1'-0"
B14.5
B14

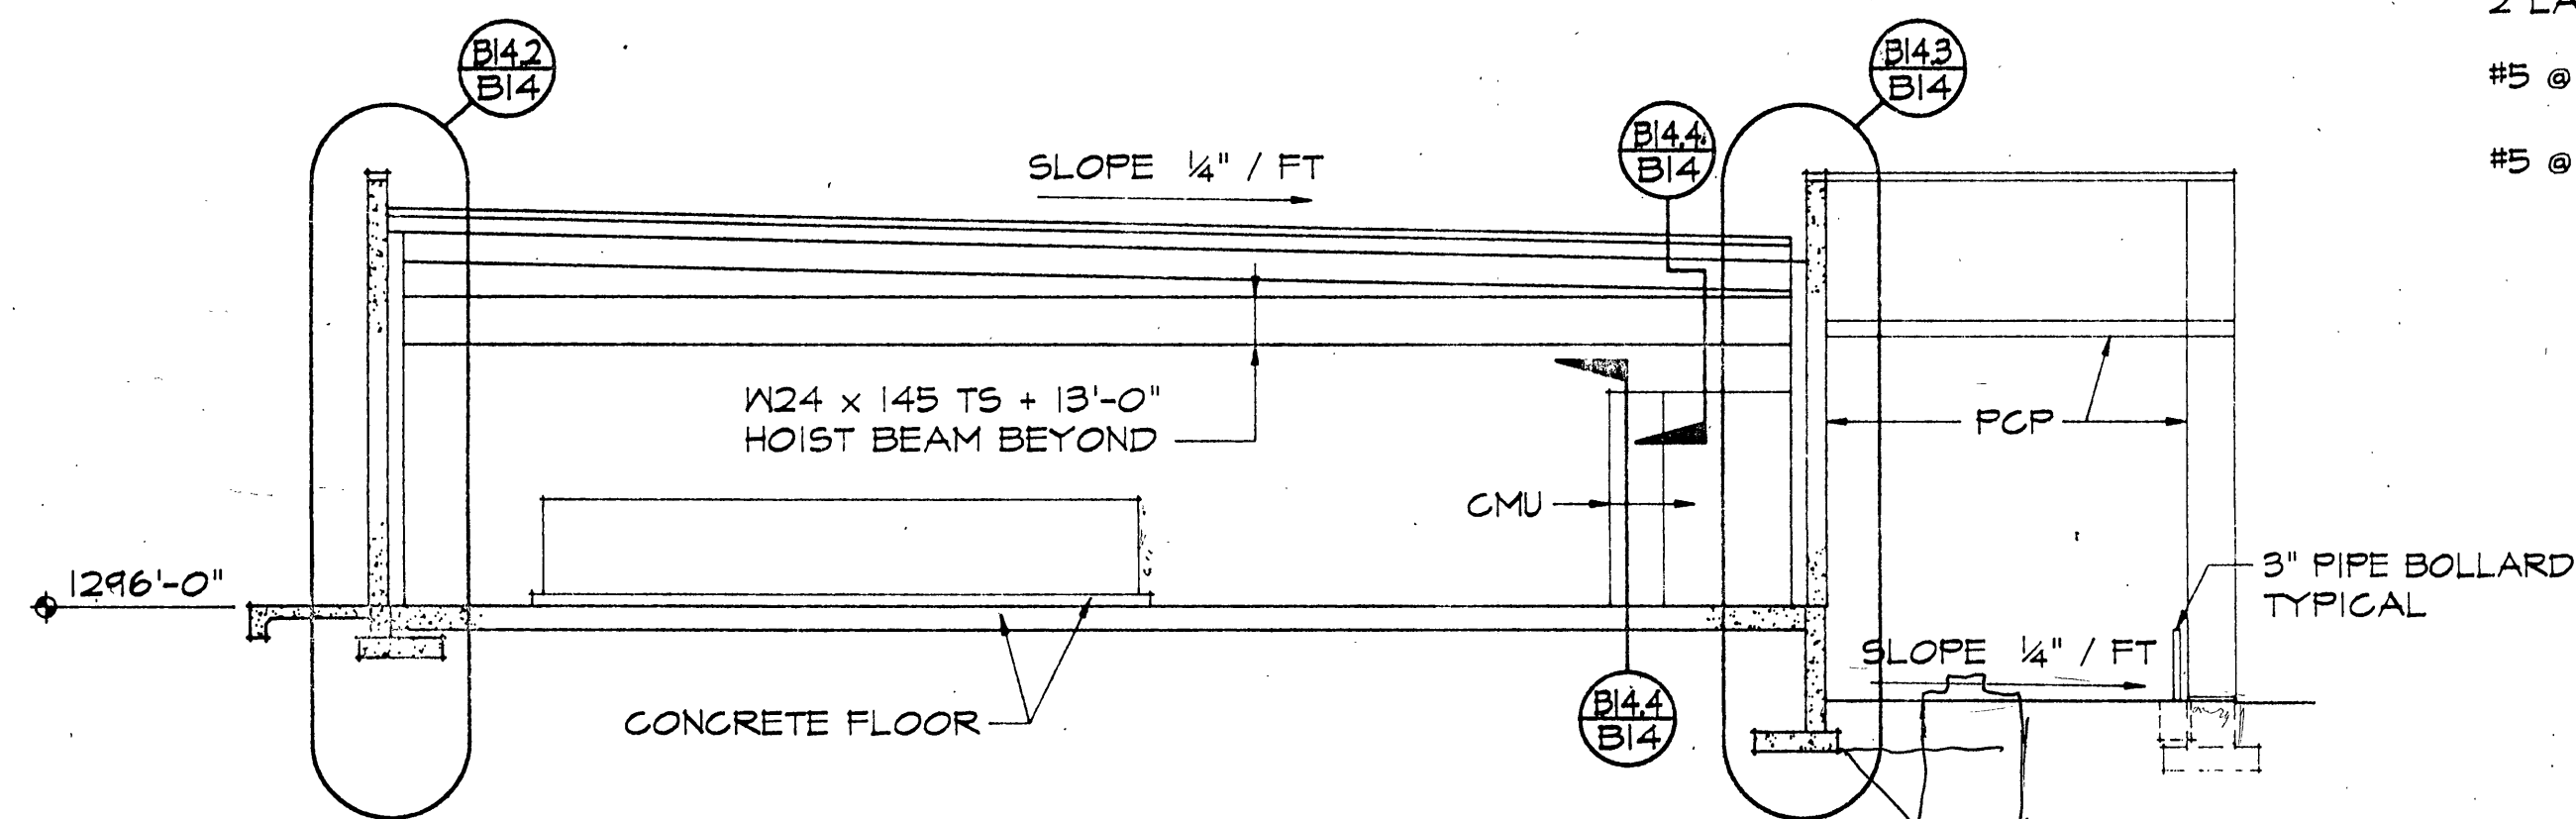

SECTION
SCALE 1/8" = 1'-0"
B14.1
B5 B8

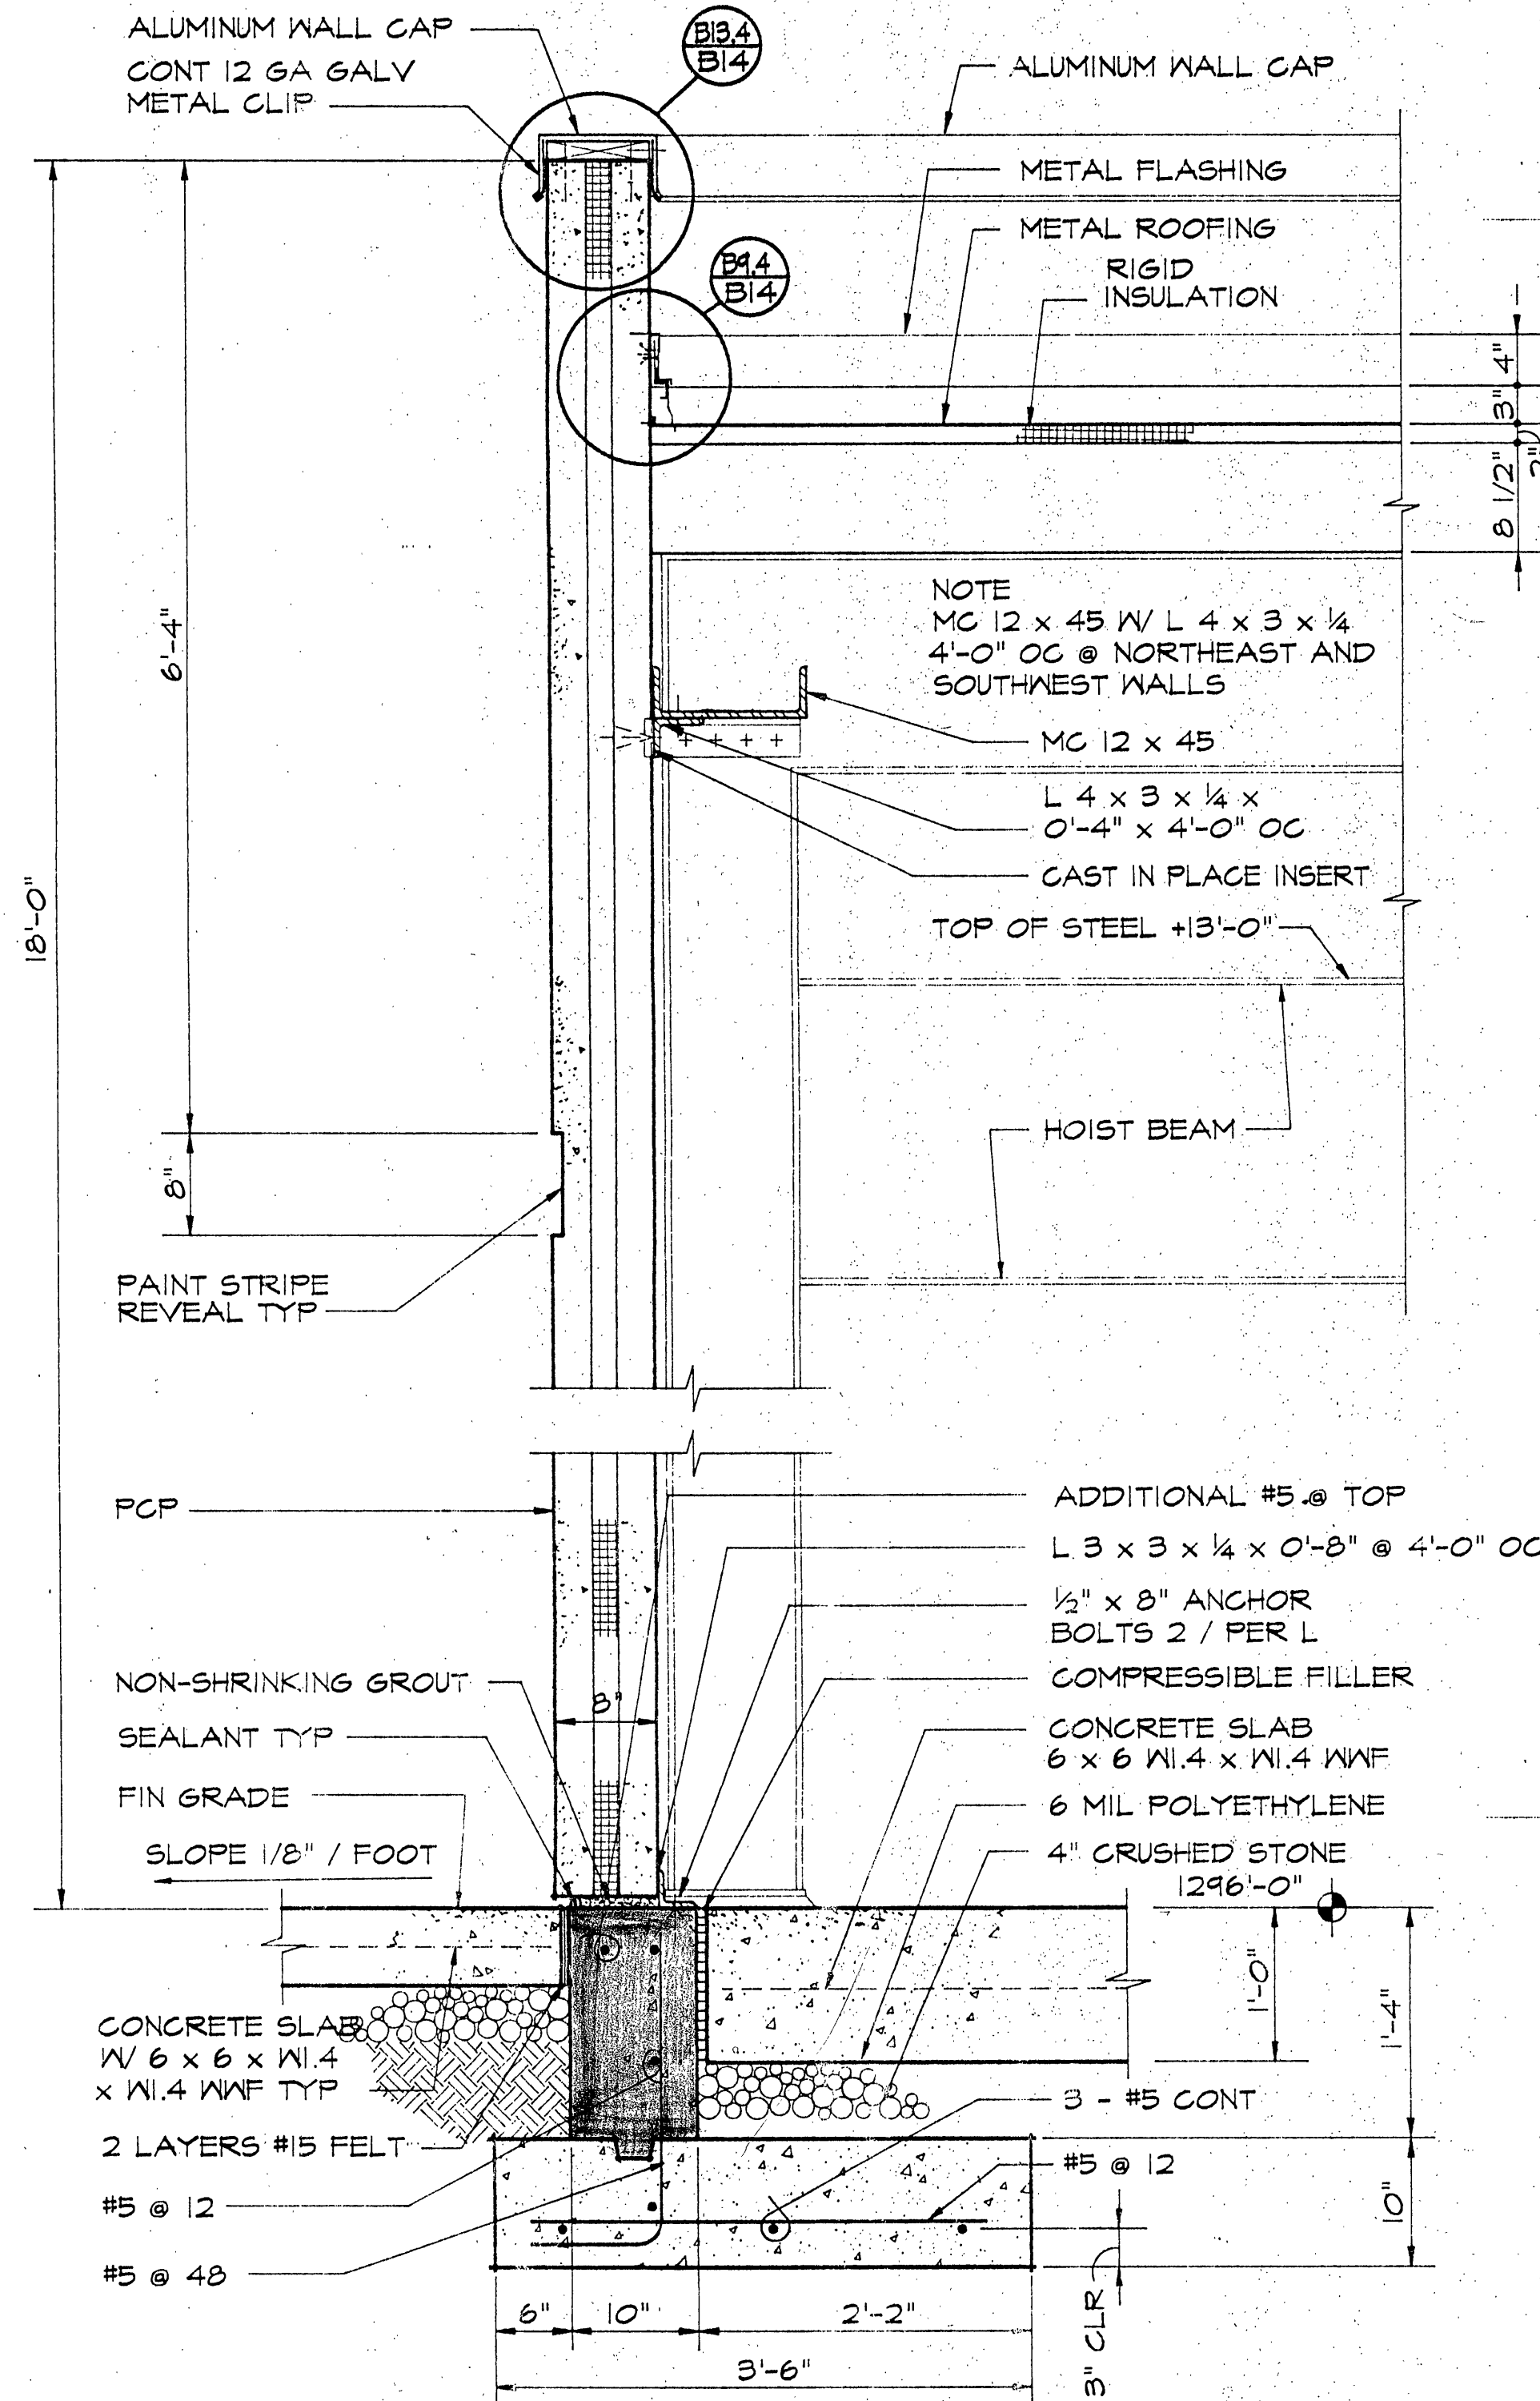


SECTION
SCALE 1" = 1'-0"
B14.2
B14 B8 B5

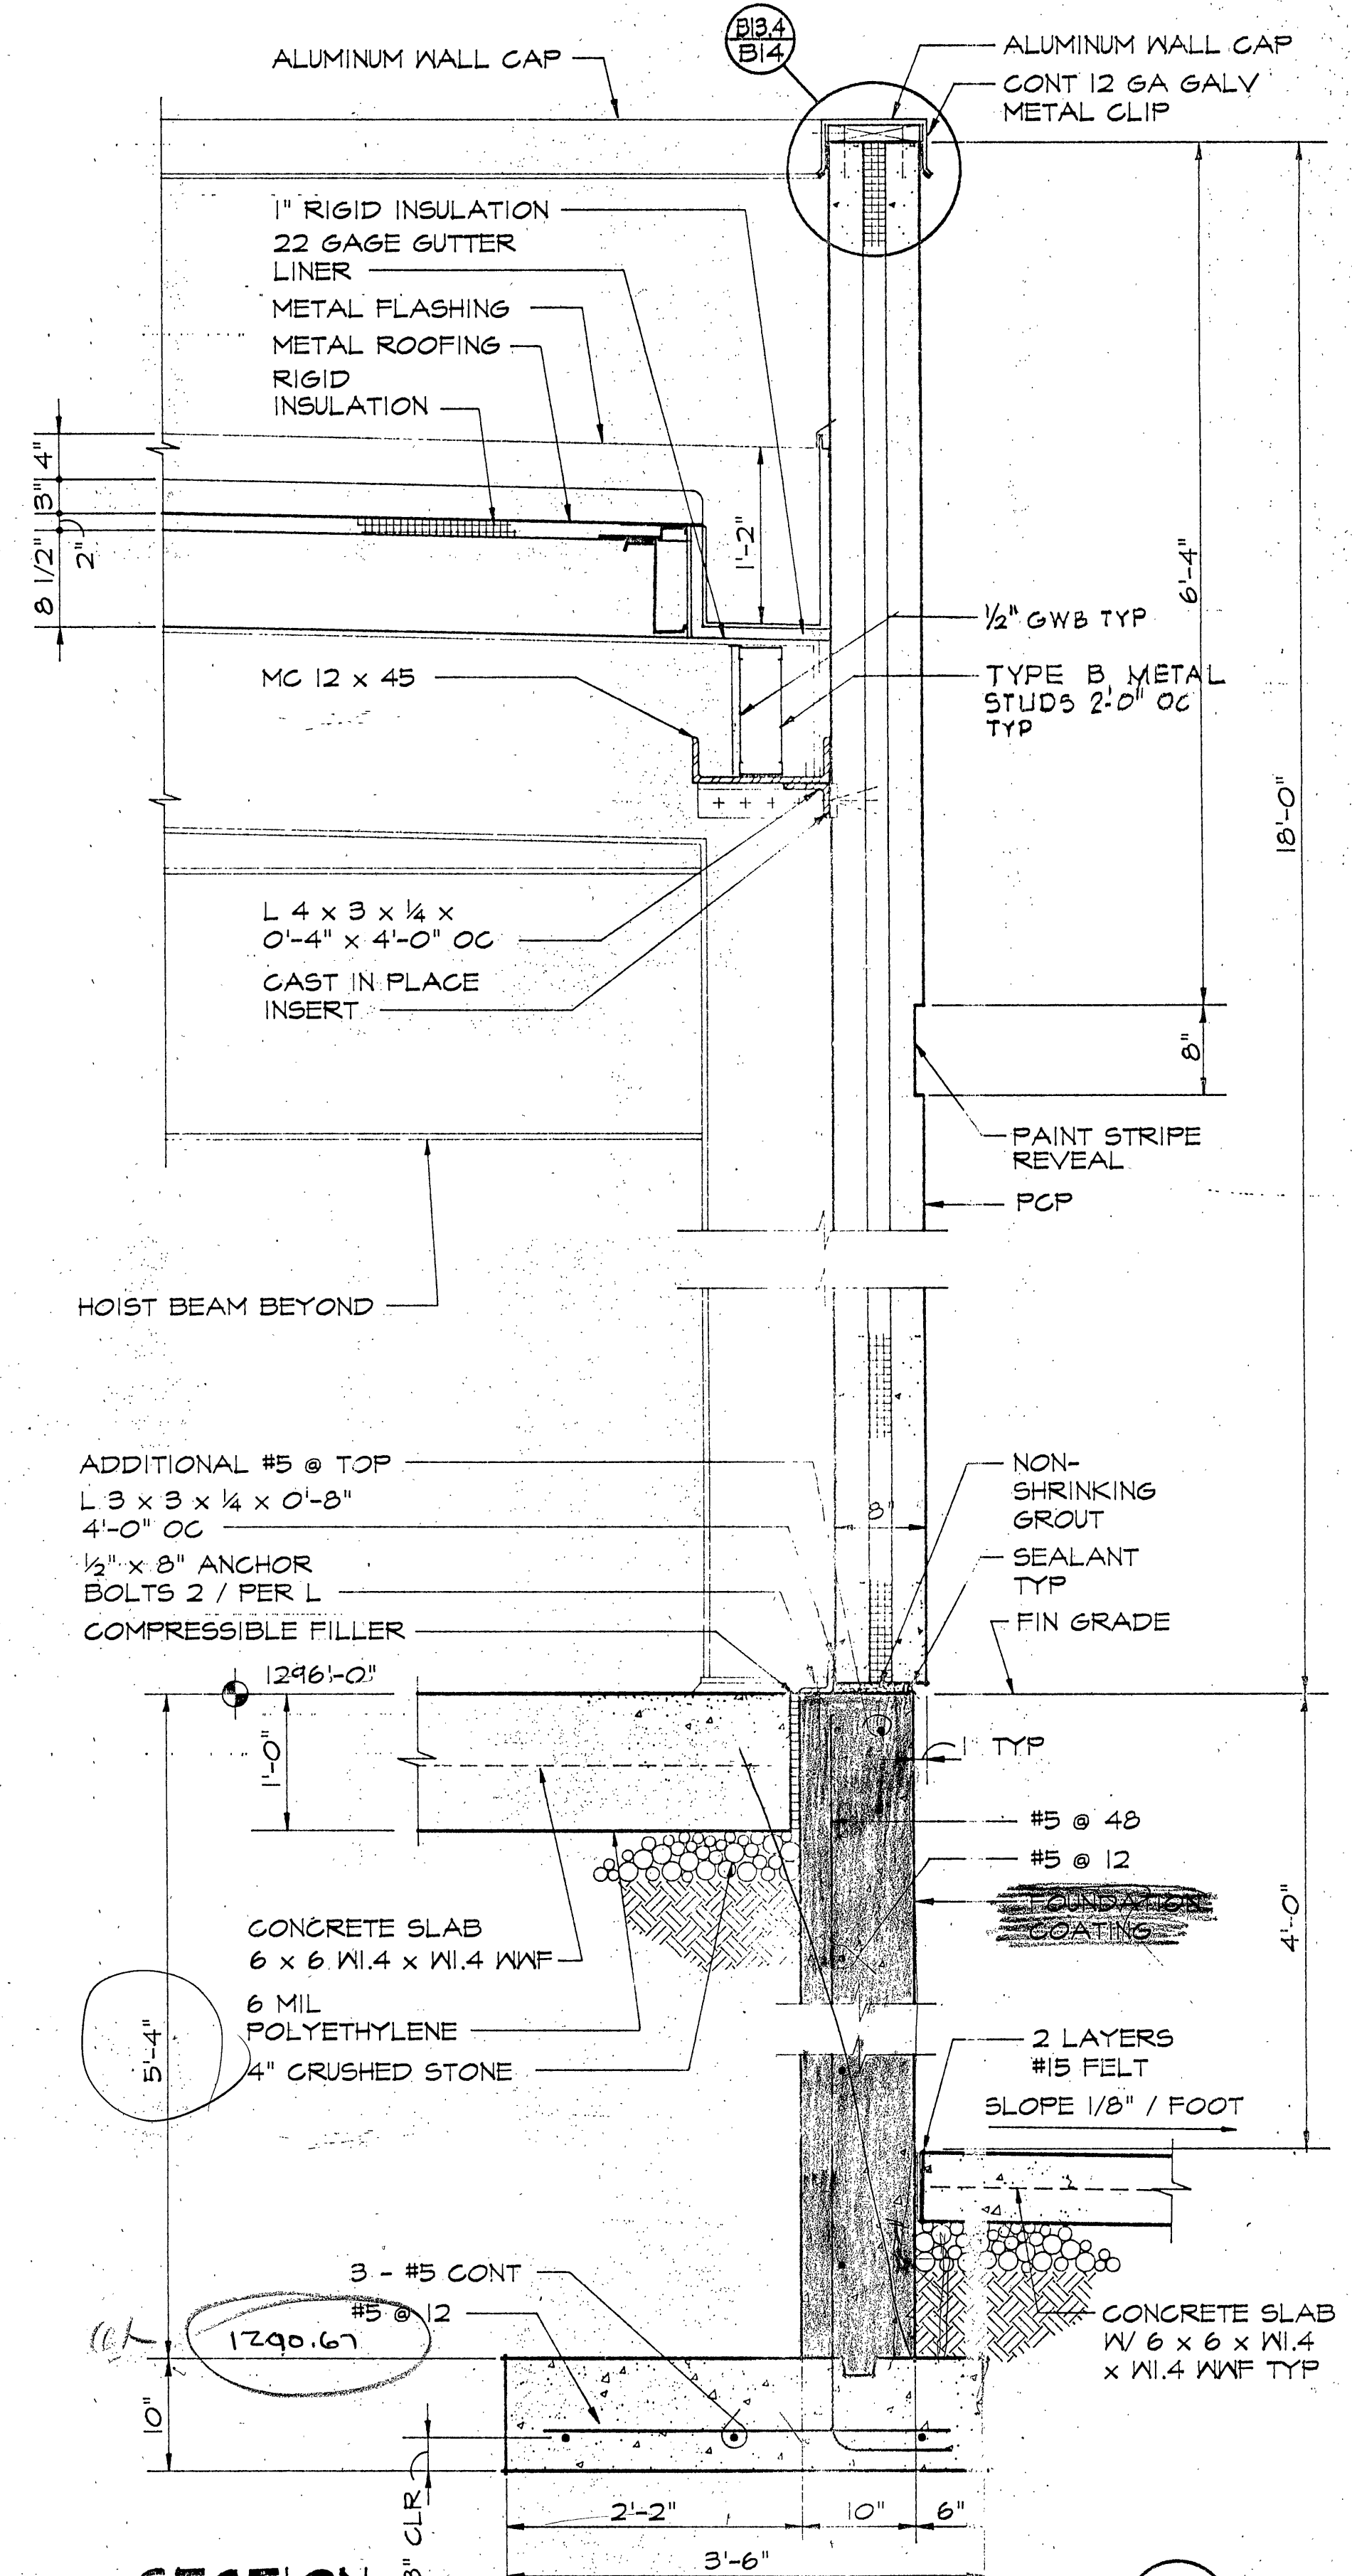


SECTION
SCALE 1" = 1'-0"
B14.3
B14 B8

INSPECTOR'S AS-BUILTS 1995

WWW.ID# 8LDLIZ

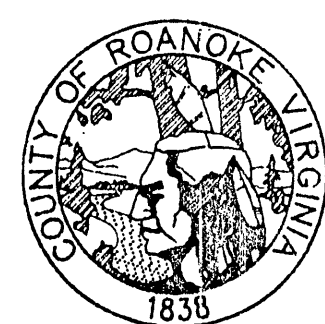

ROANOKE COUNTY WATER TREATMENT FACILITY

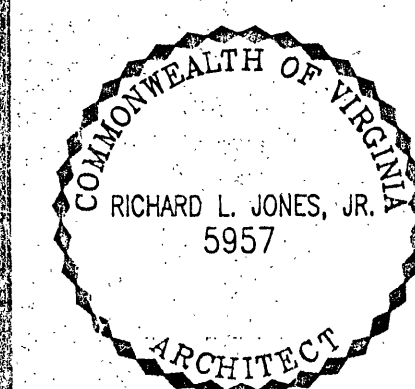

SECTIONS

PROJECT ARCHITECT
RLJ JR

COMMISSION NUMBER
1913

TECHNICIANS
RAT

DATE
22 SEPT 1994

B14