



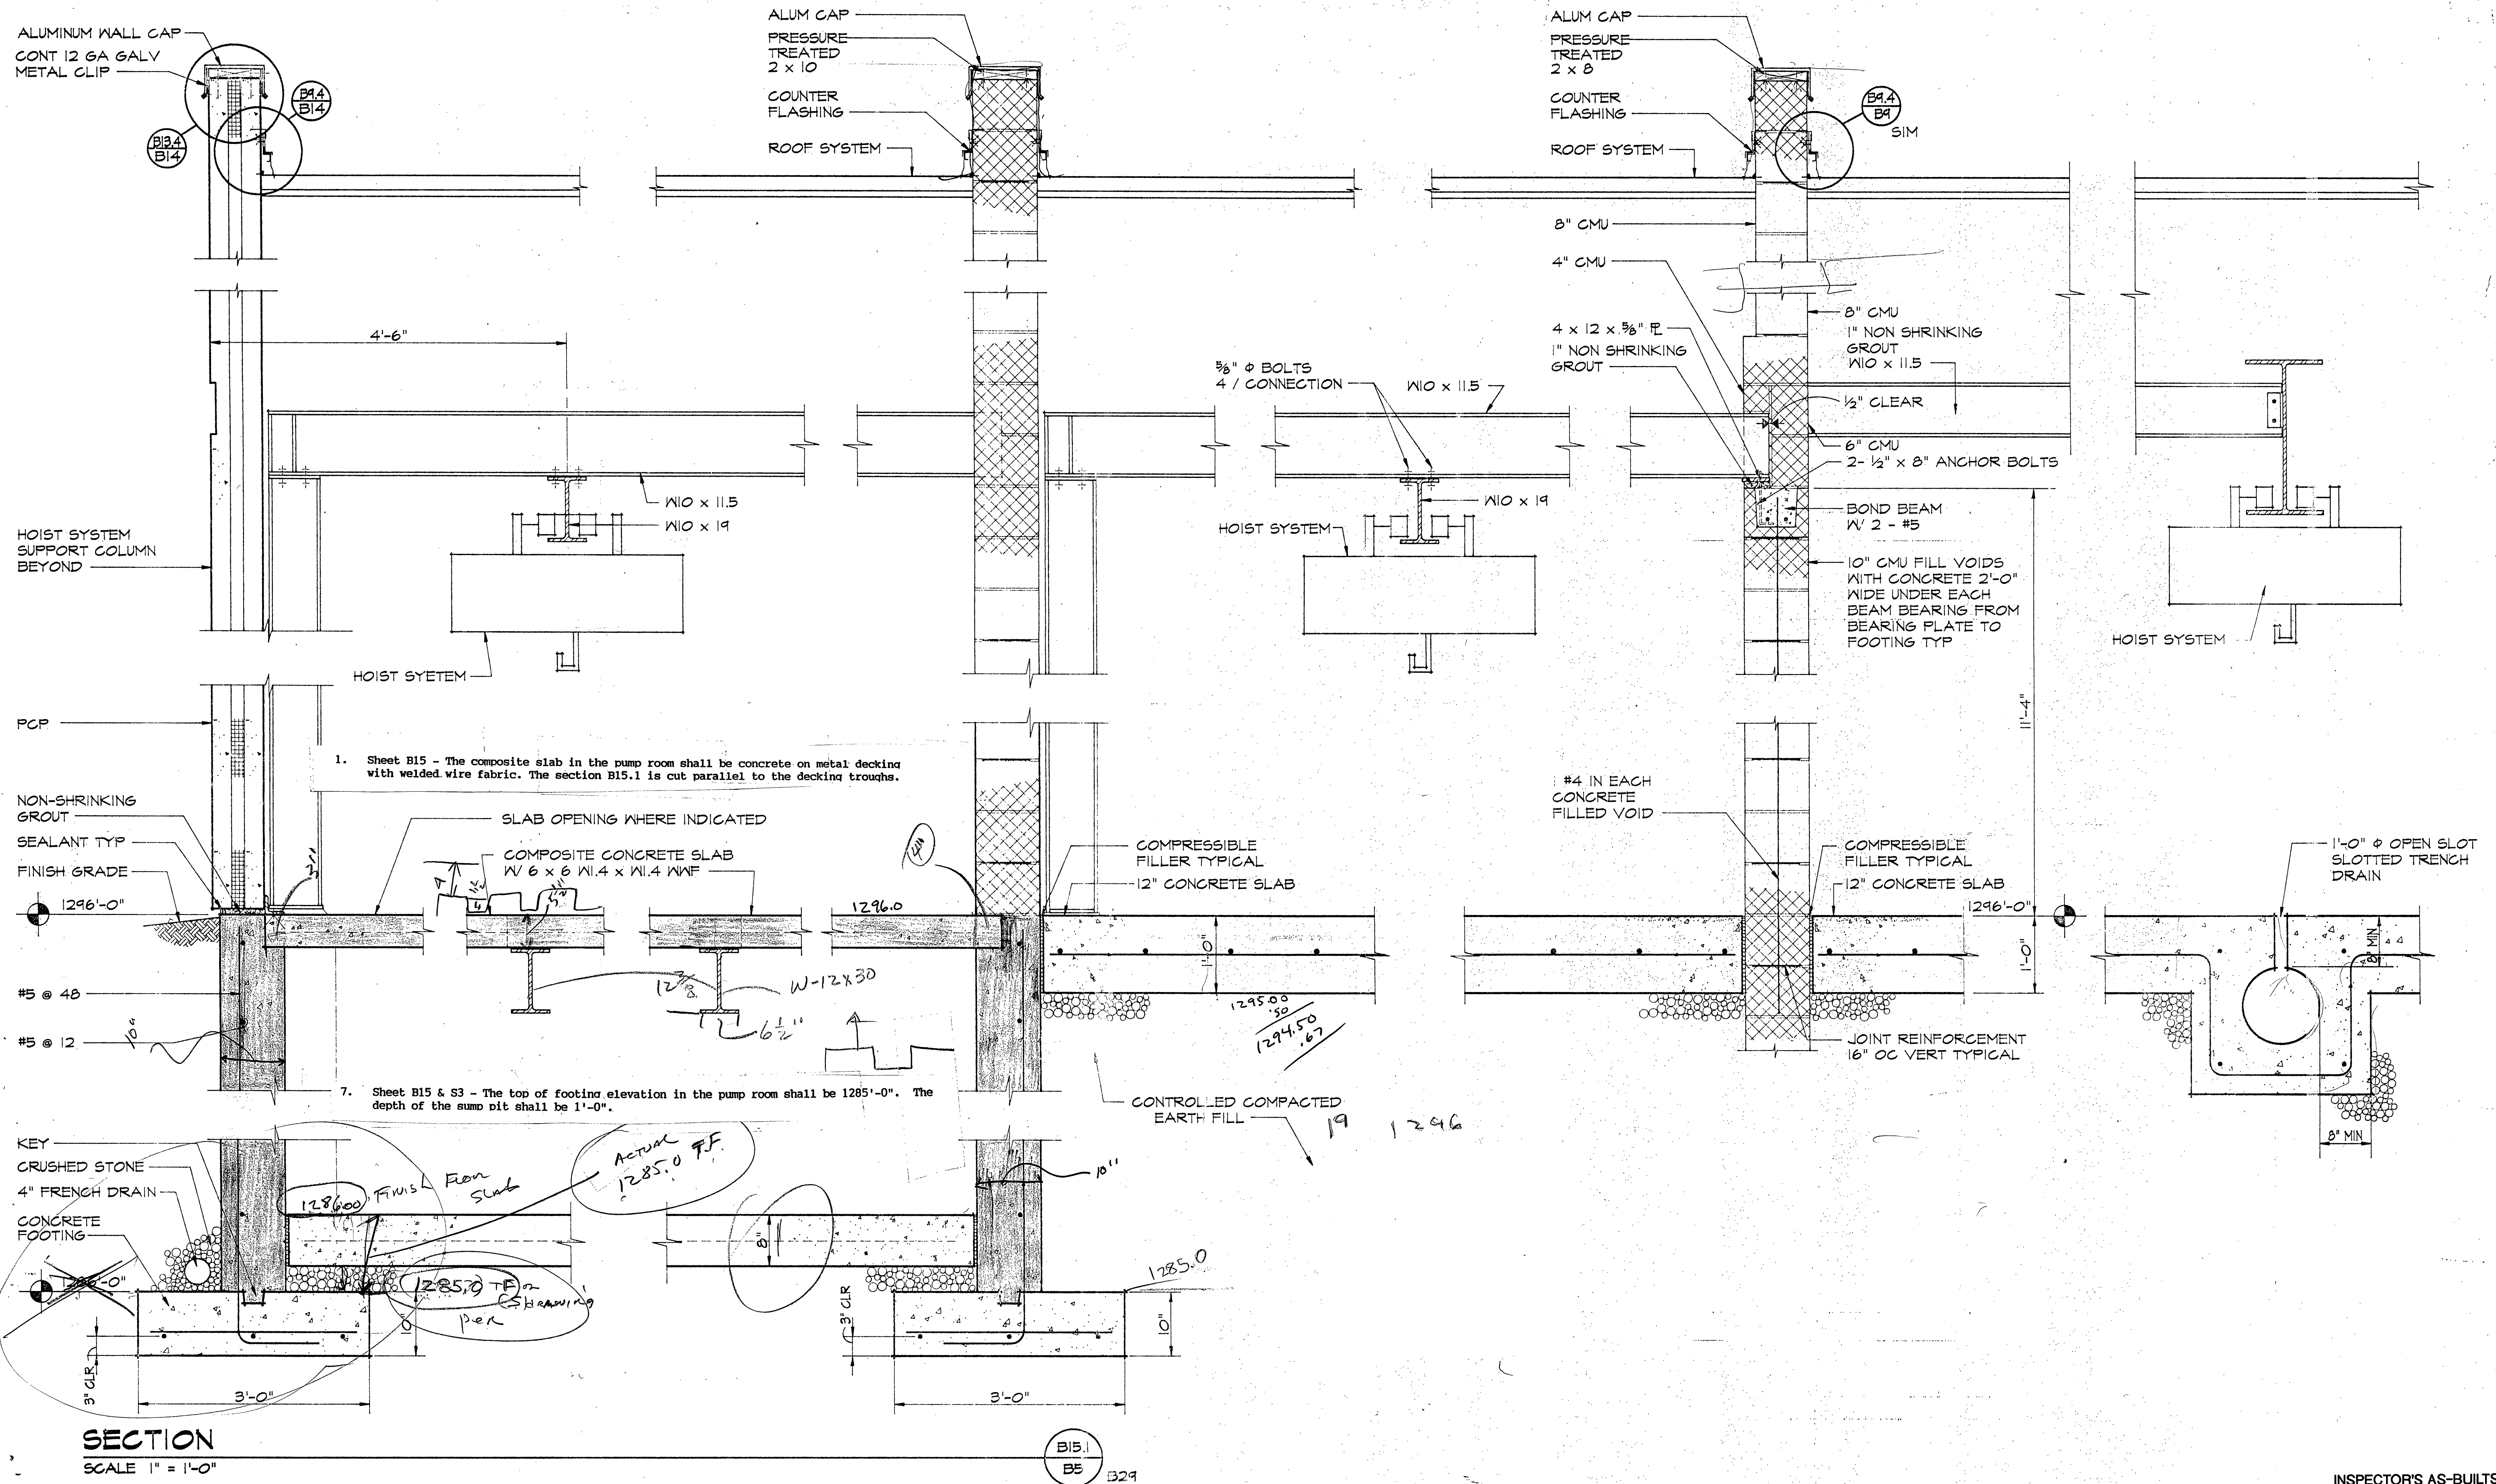


INSPECTOR'S AS-BUILTS 1995

WWW.ID# 8LDLIZ

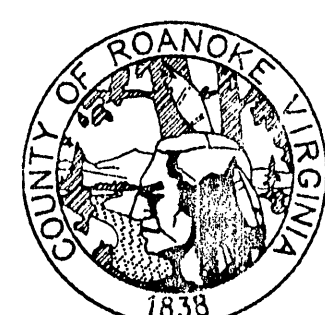

ROANOKE COUNTY WATER TREATMENT FACILITY

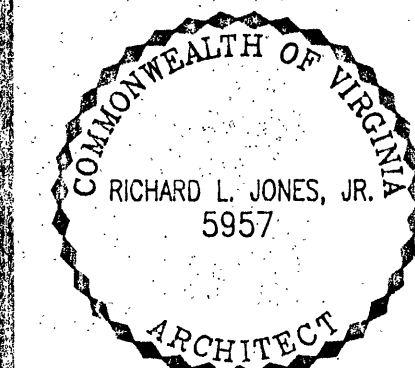

SECTIONS

PROJECT ARCHITECT RLJ JR	COMMISSION NUMBER 1913
TECHNICIAN RAT	DATE 22 SEPT 1994

B15

JONES & JONES ASSOCIATES / ARCHITECTS PC