
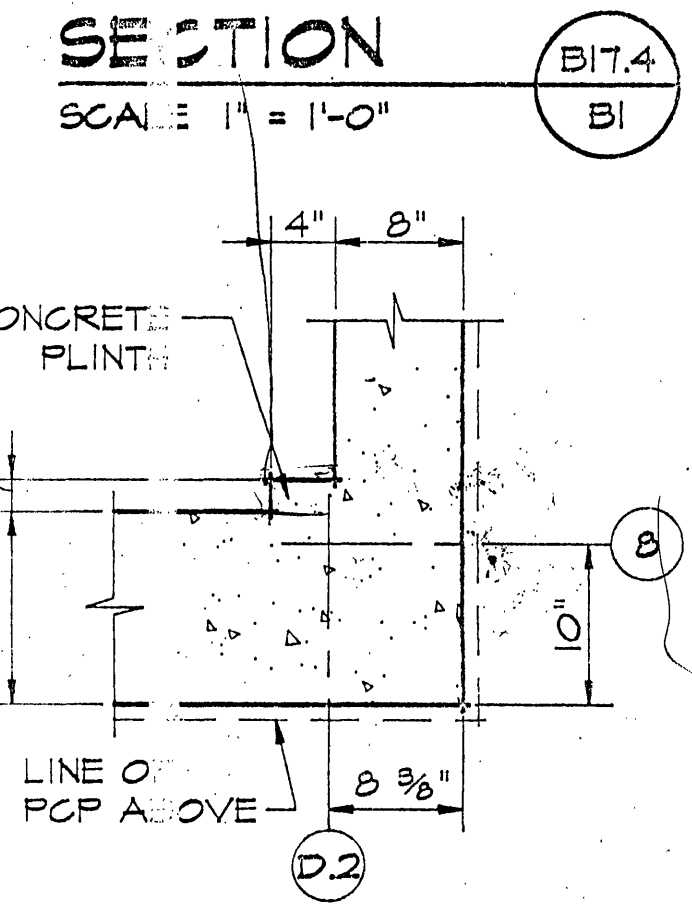
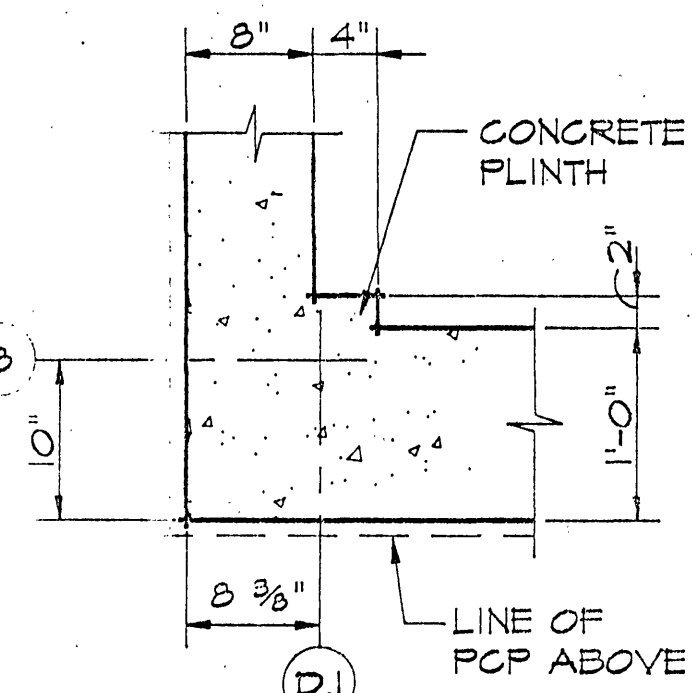
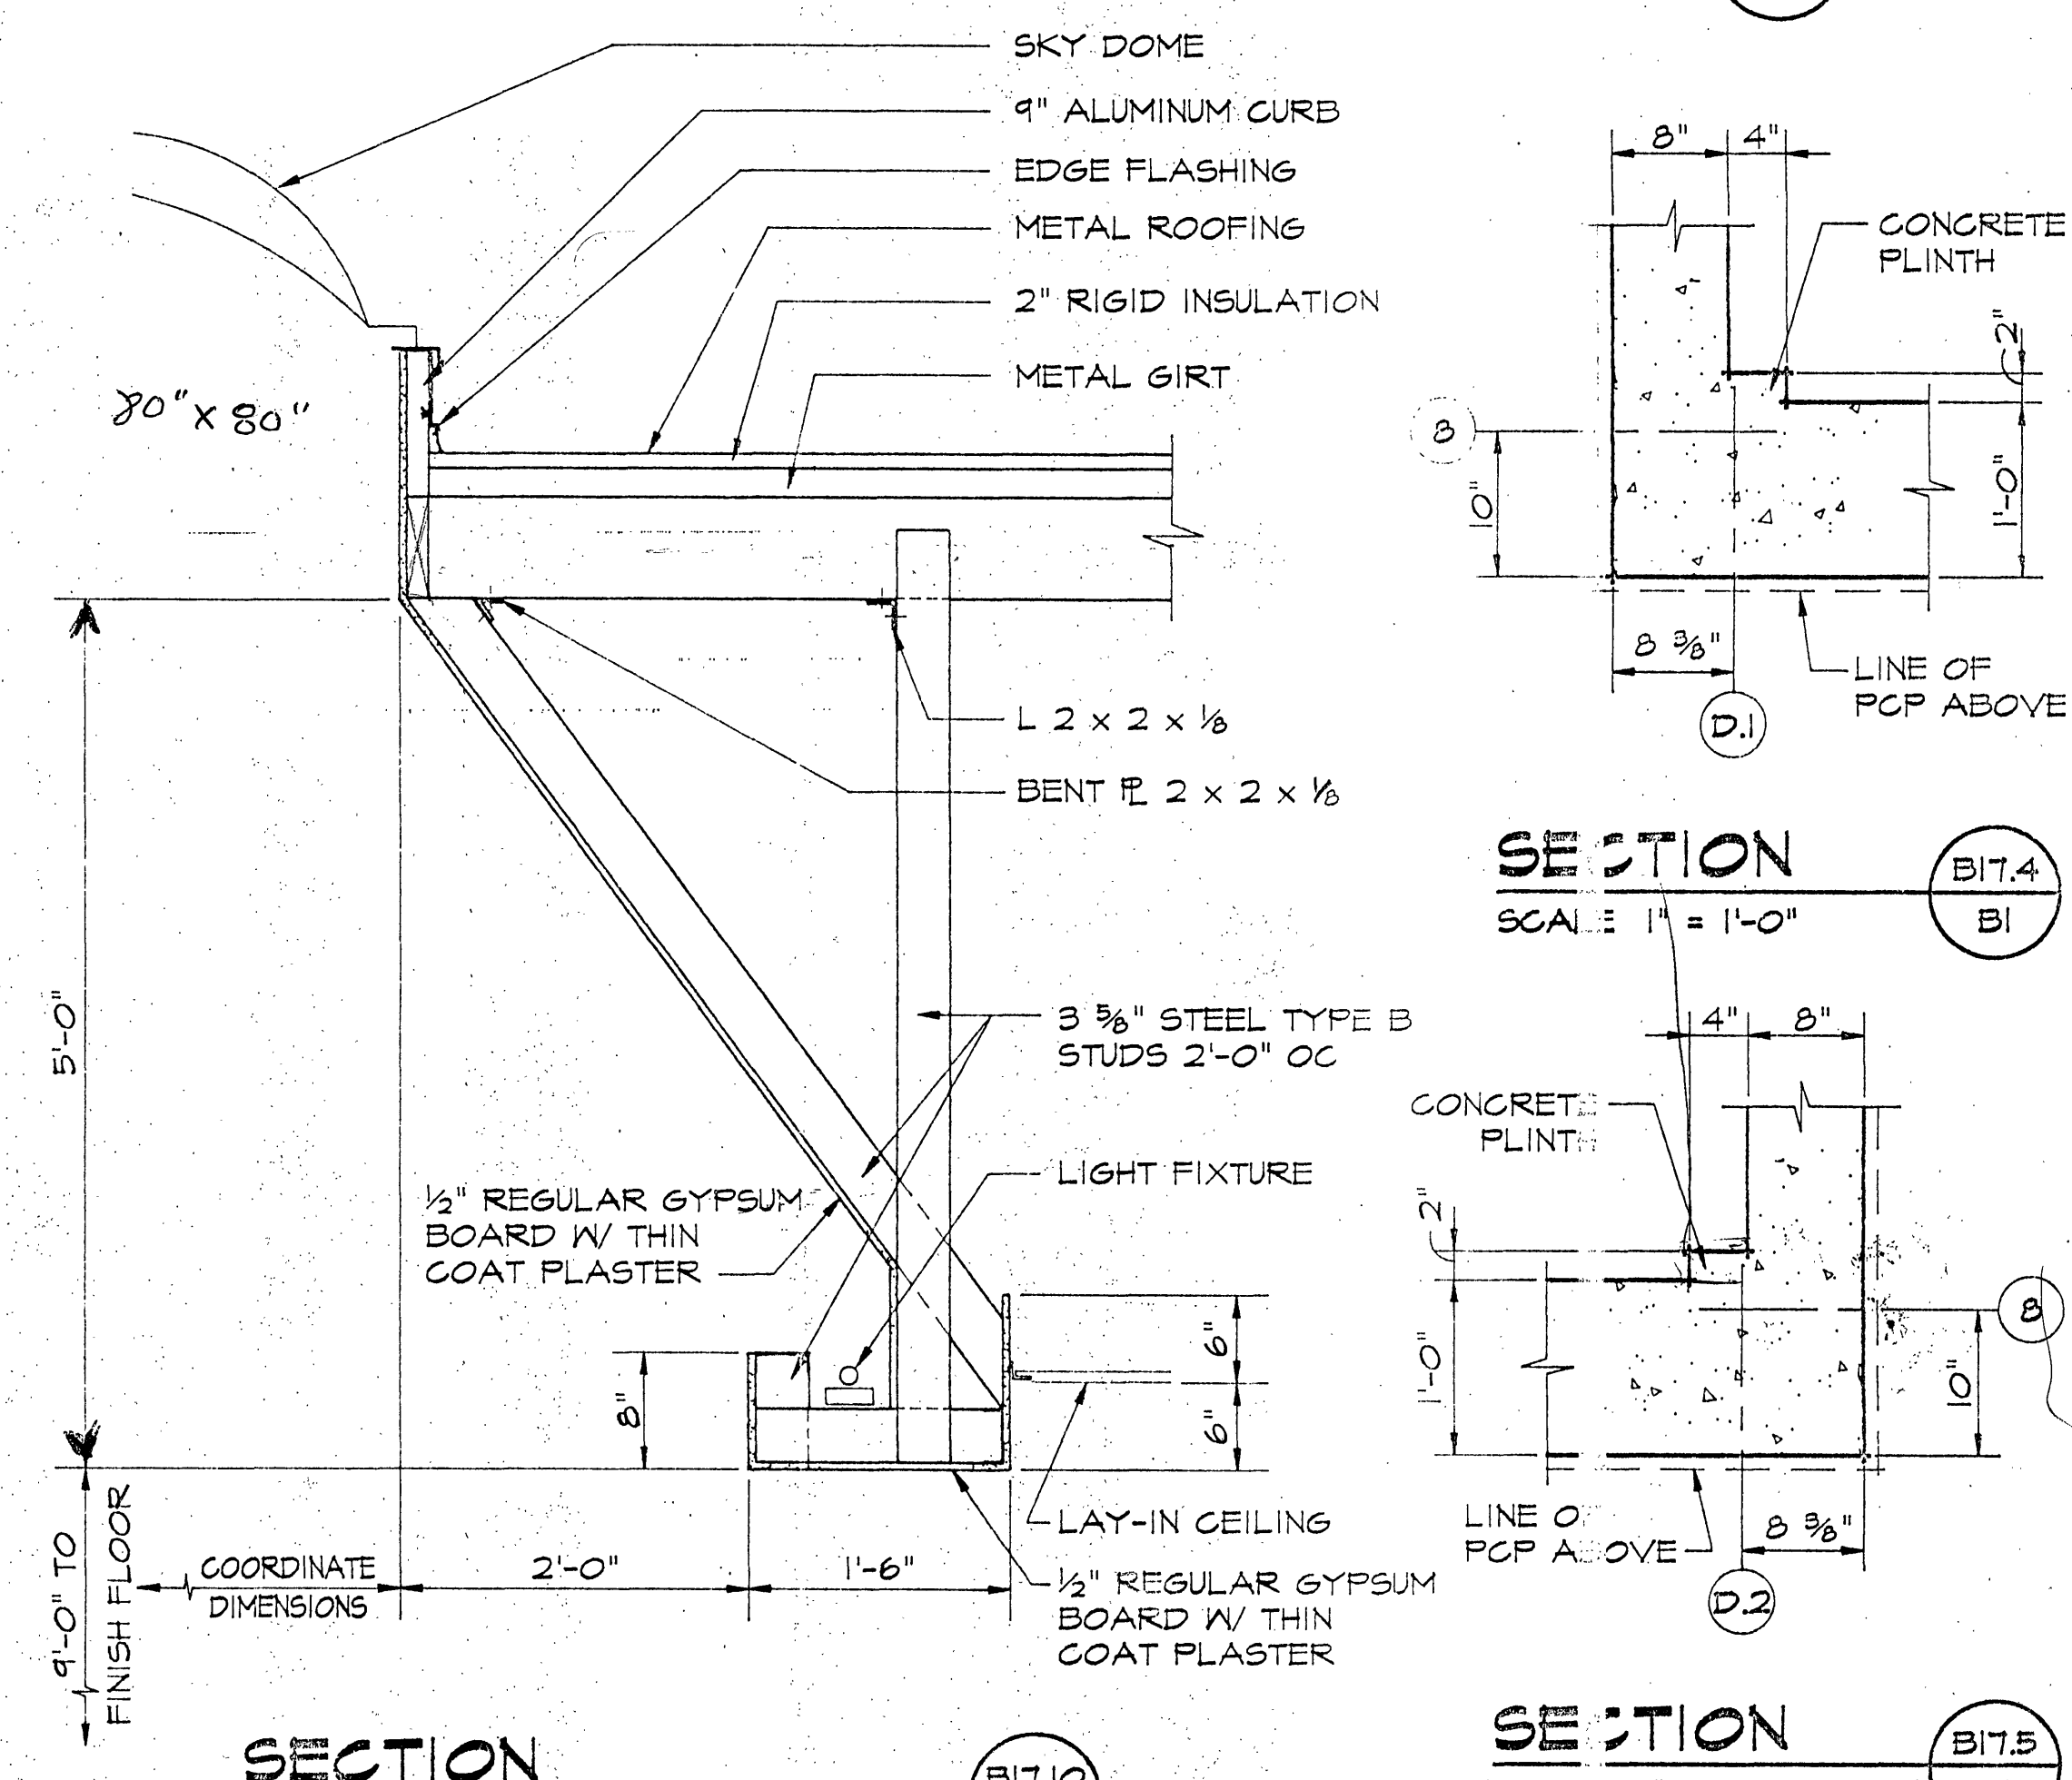
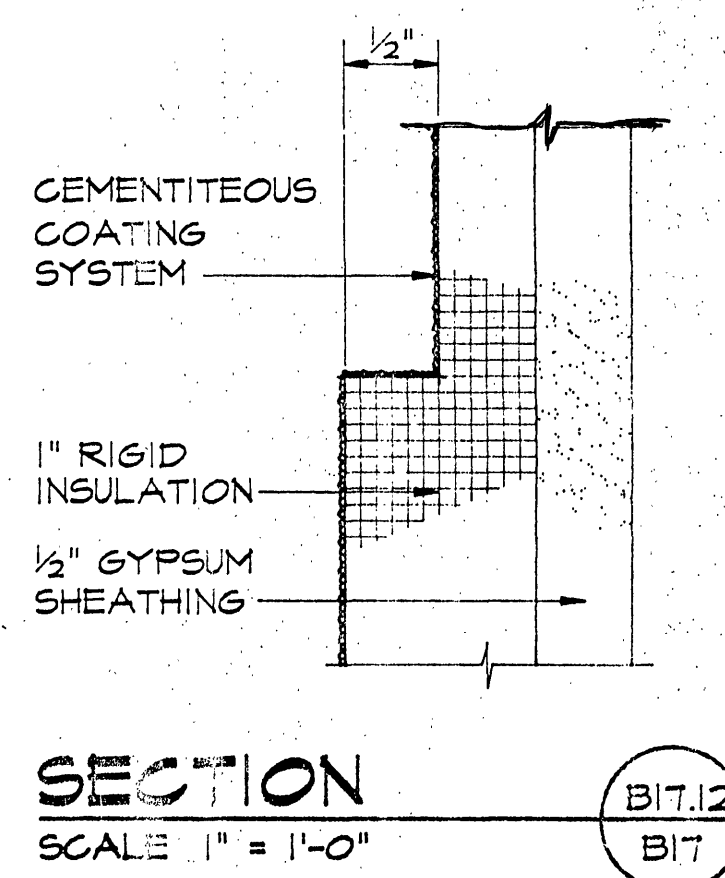
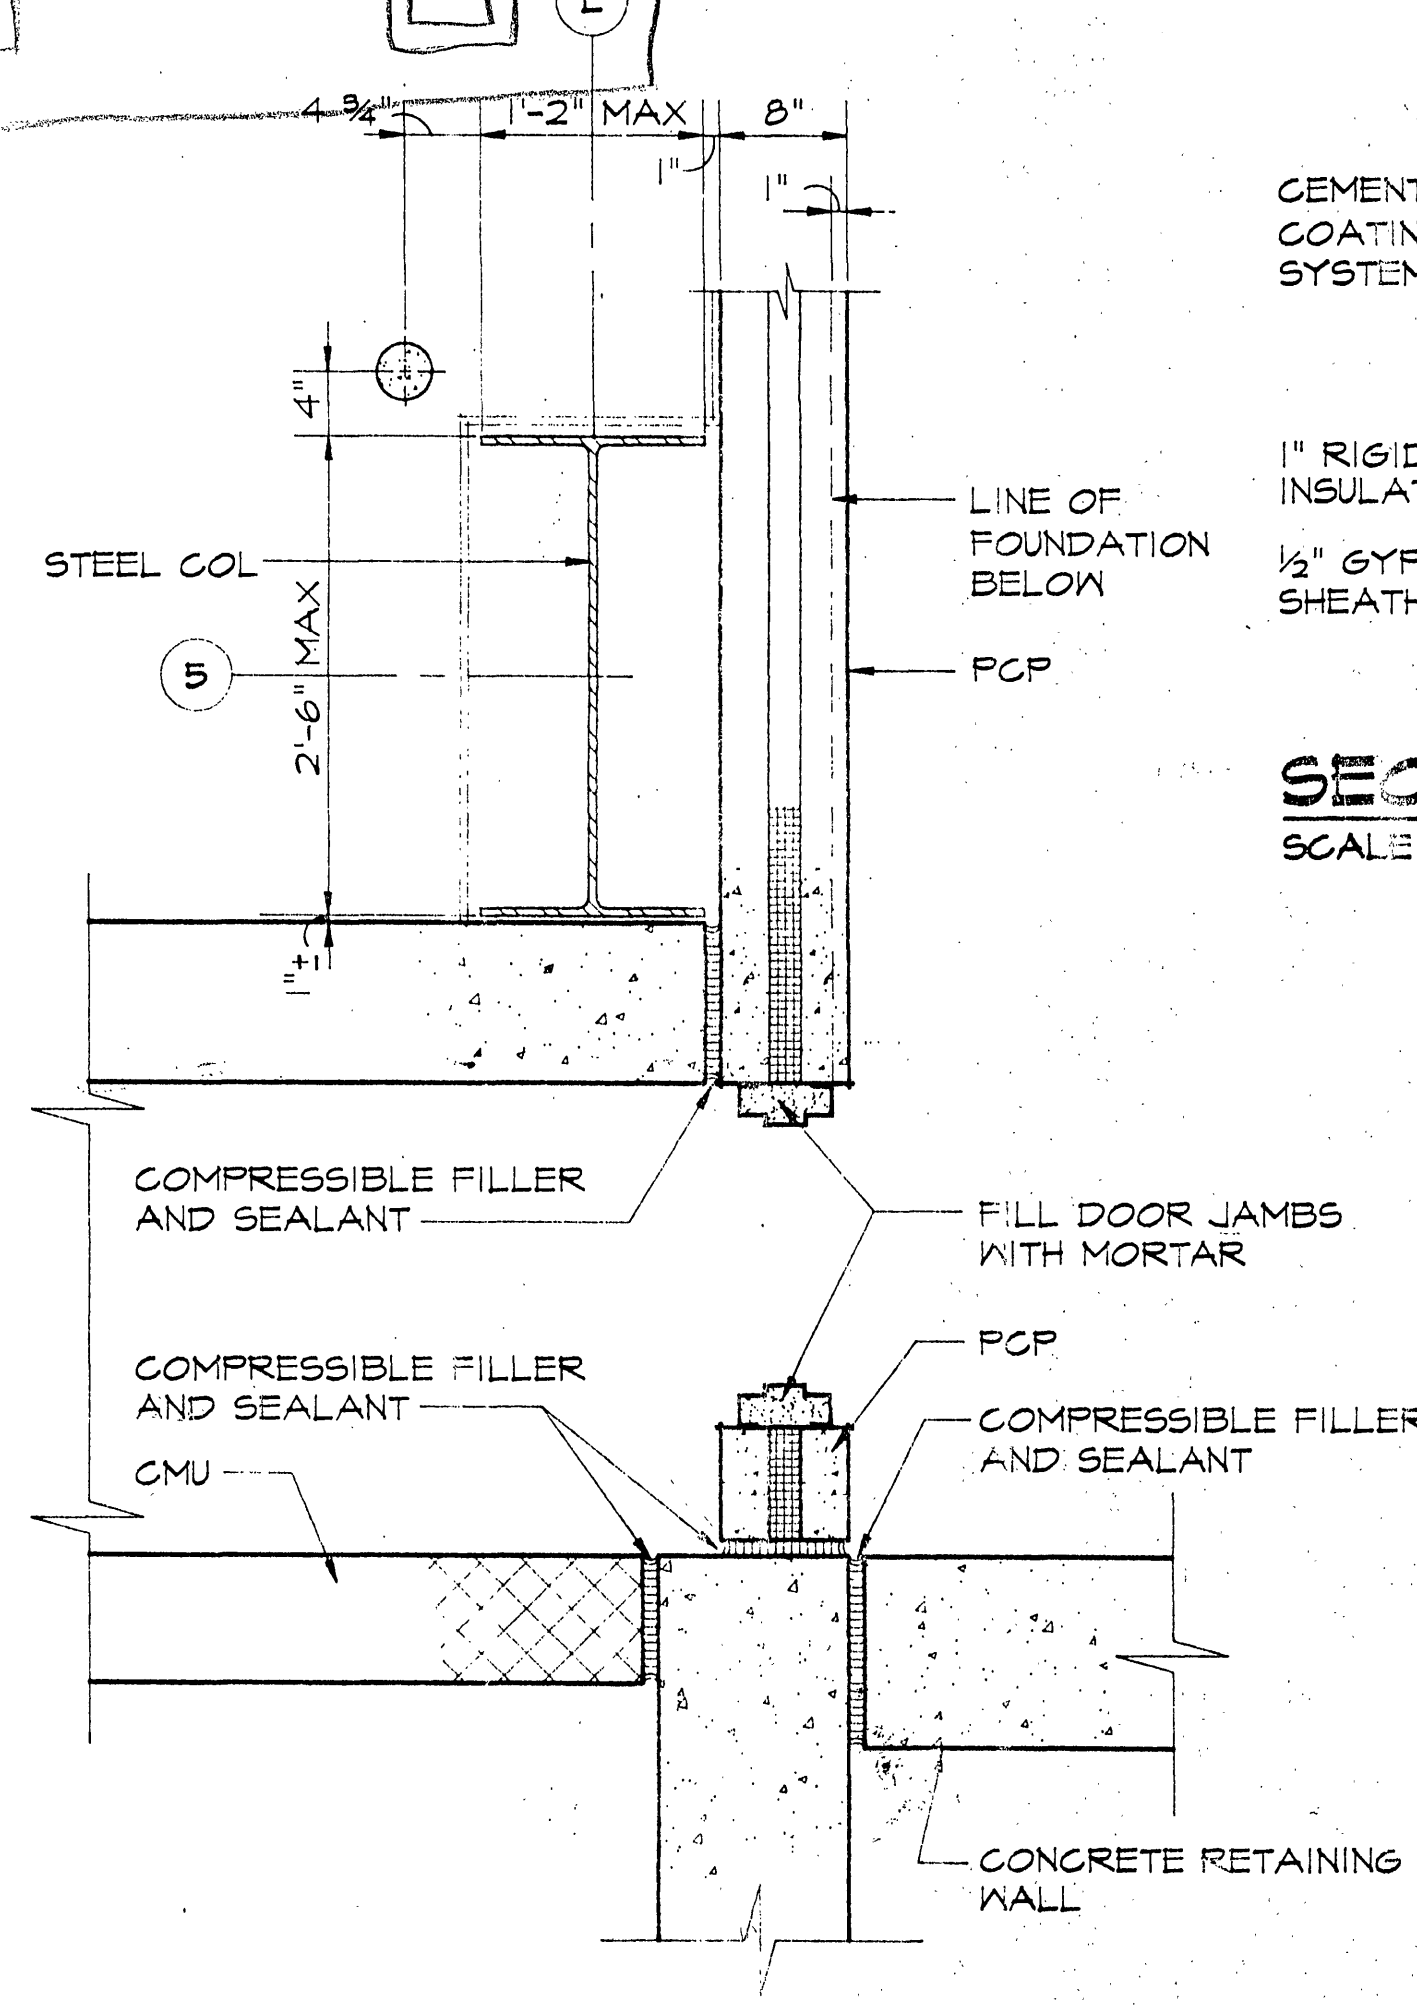
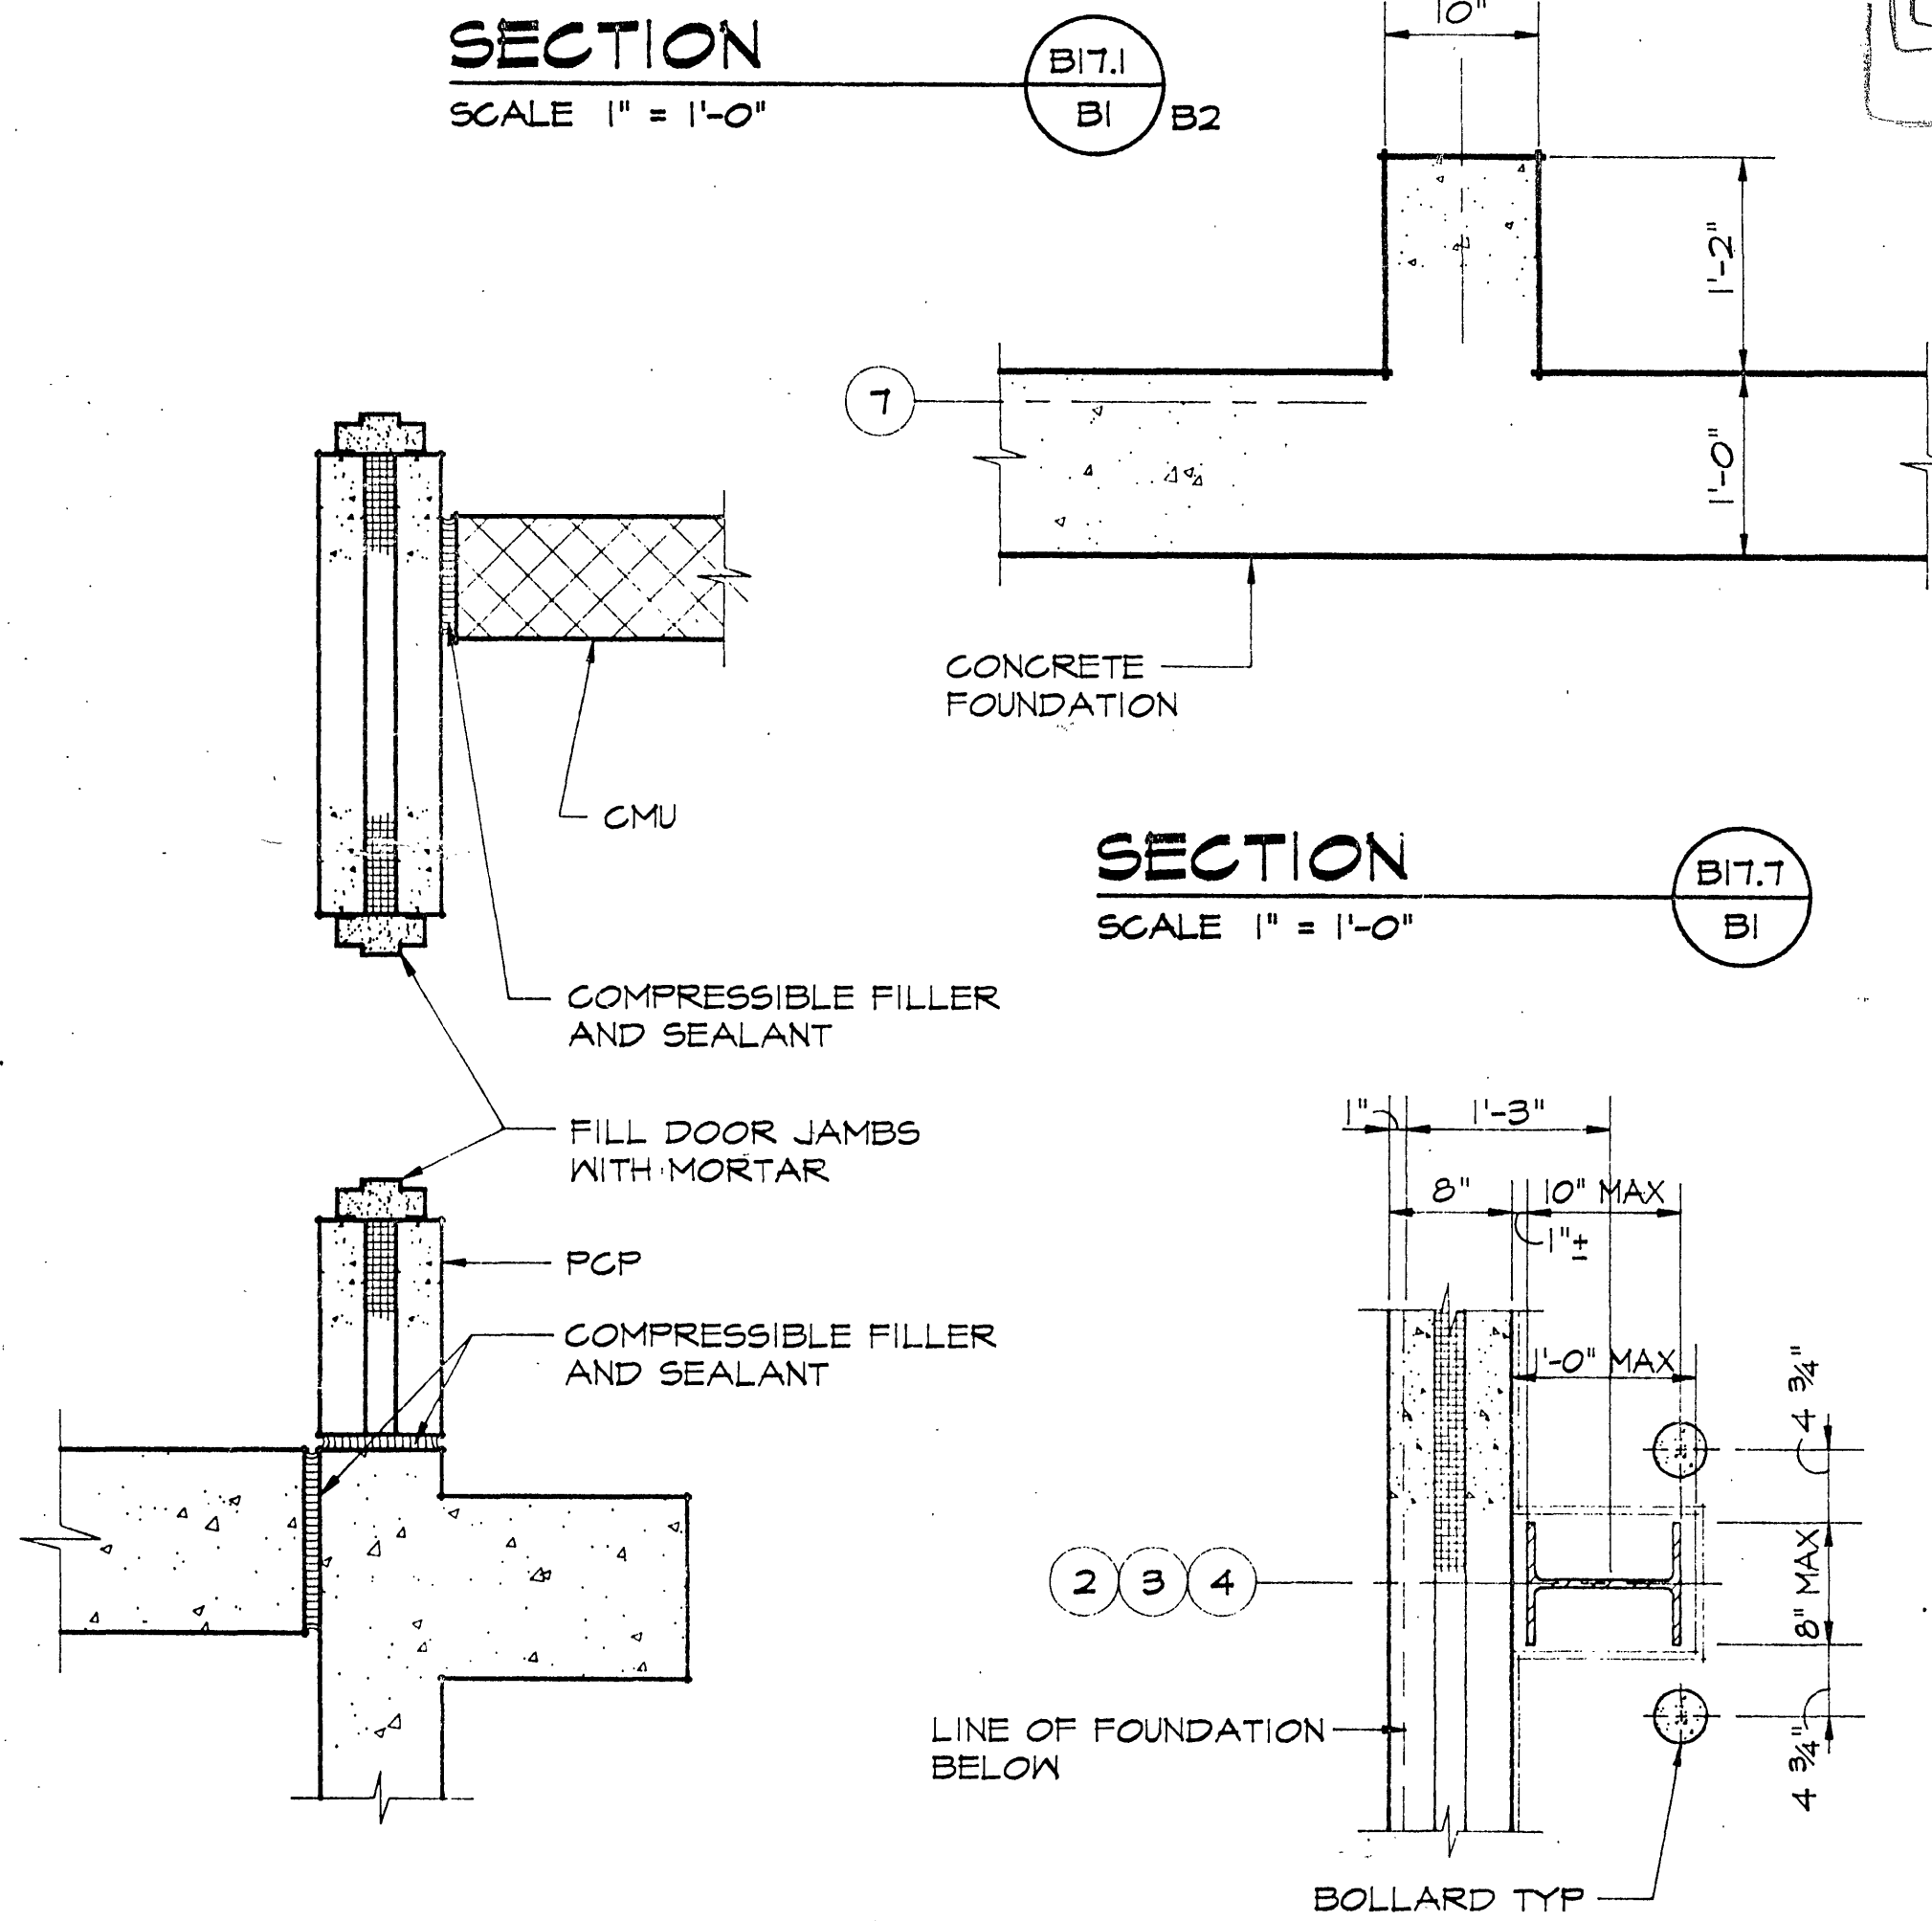
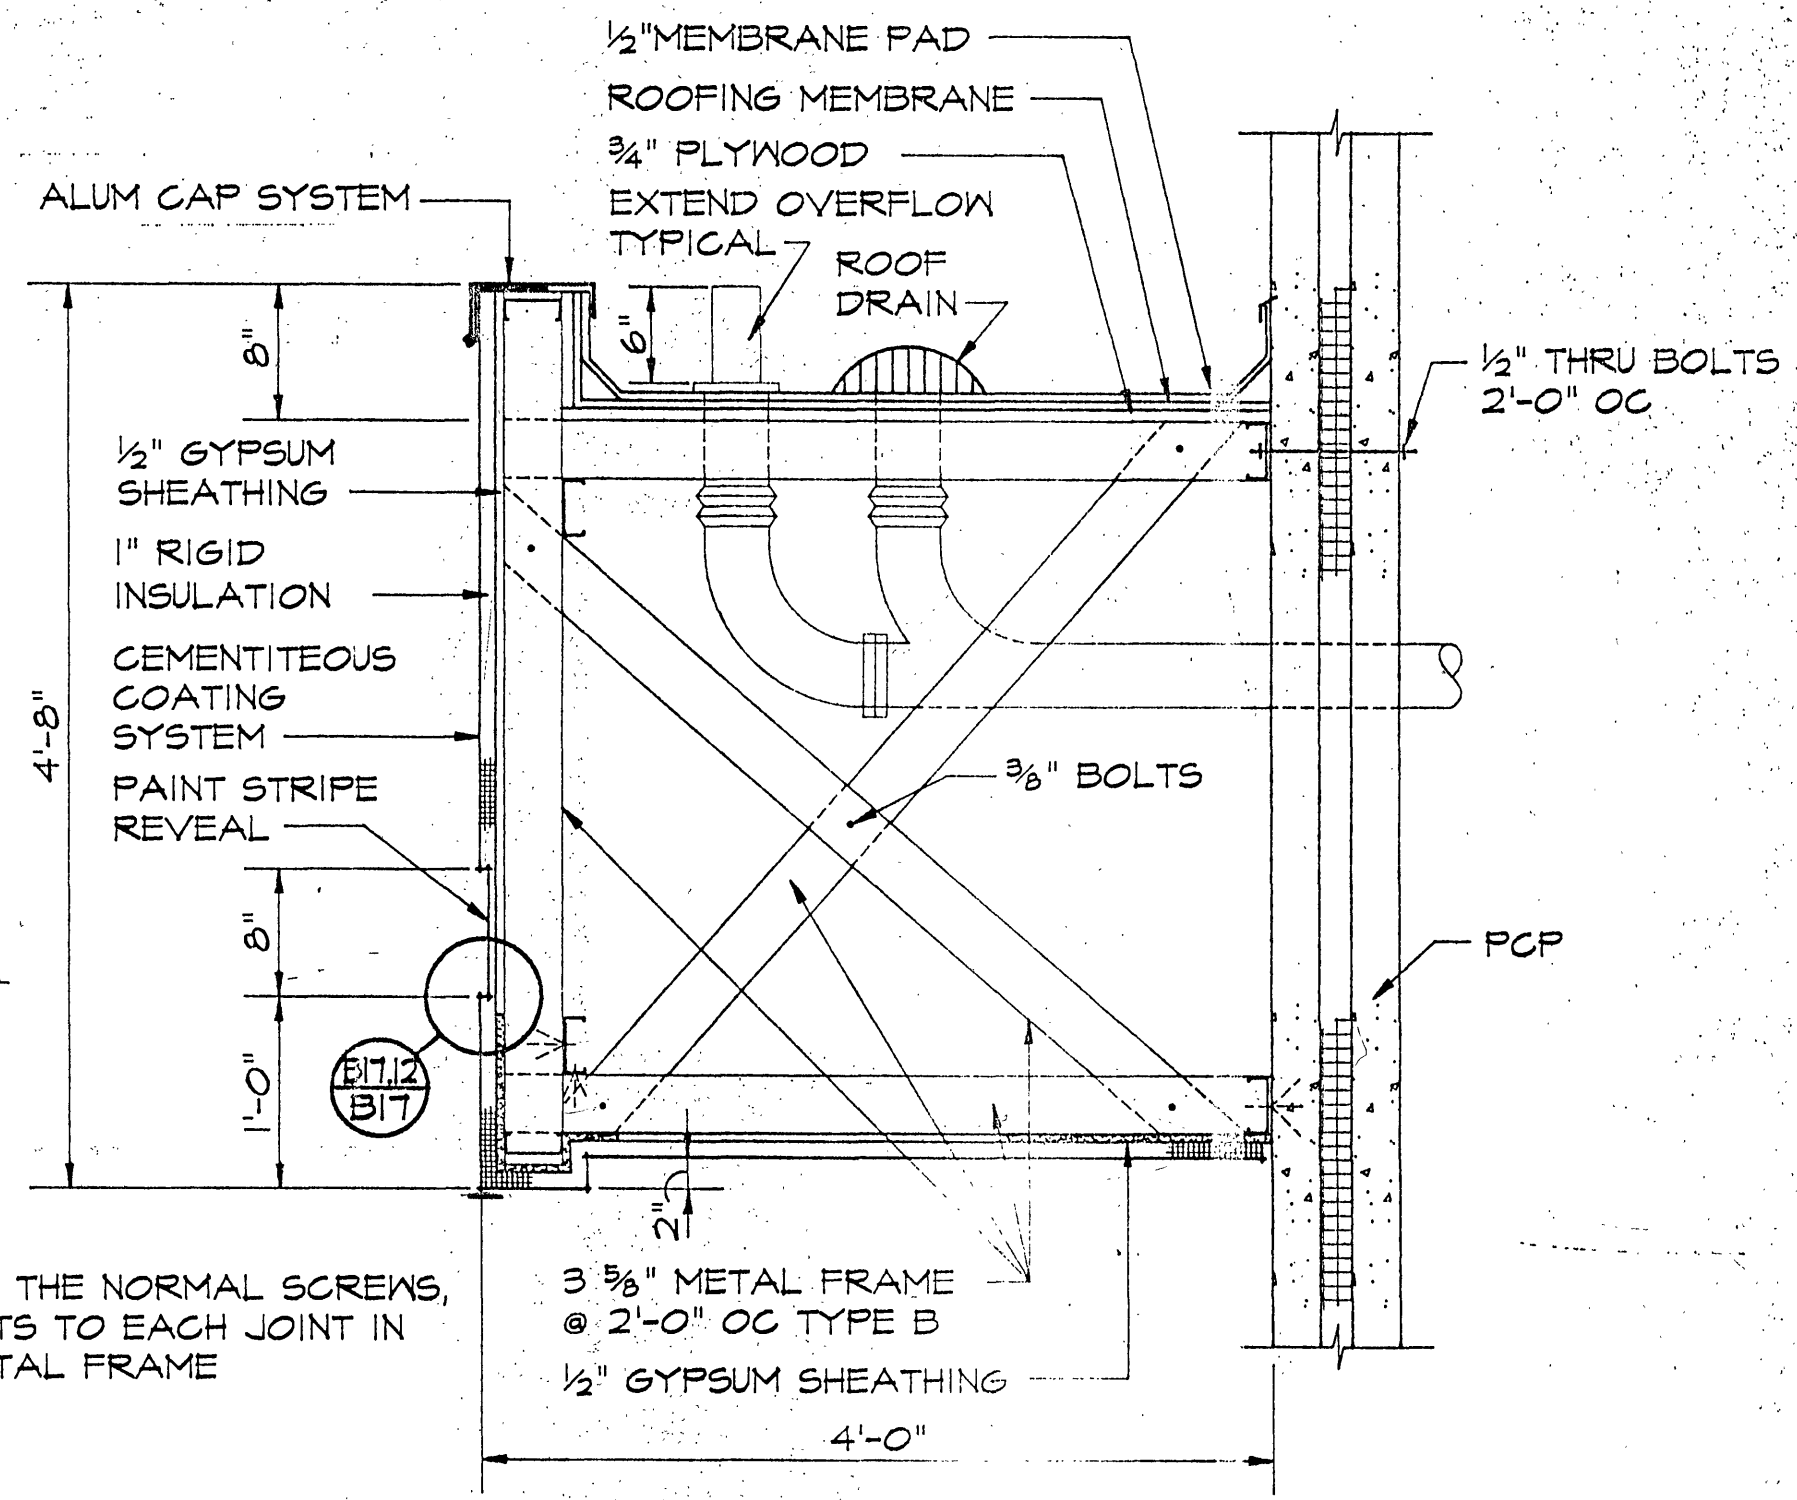
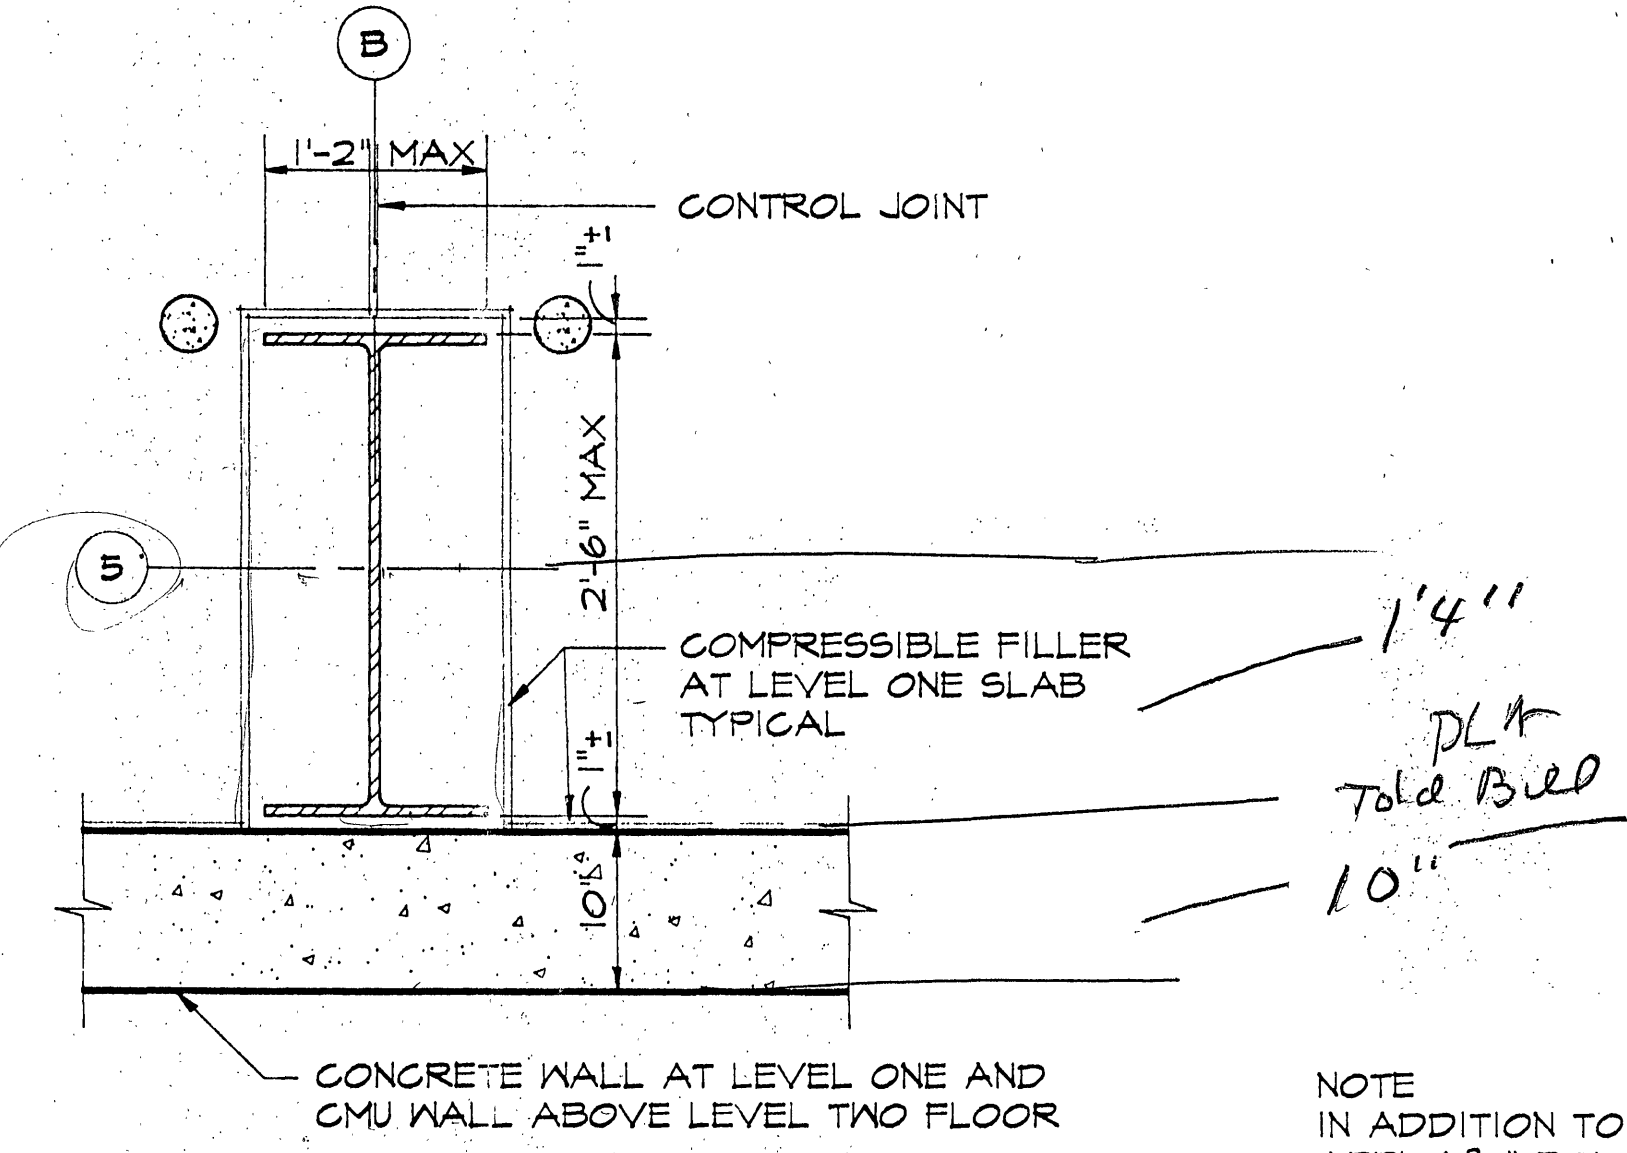
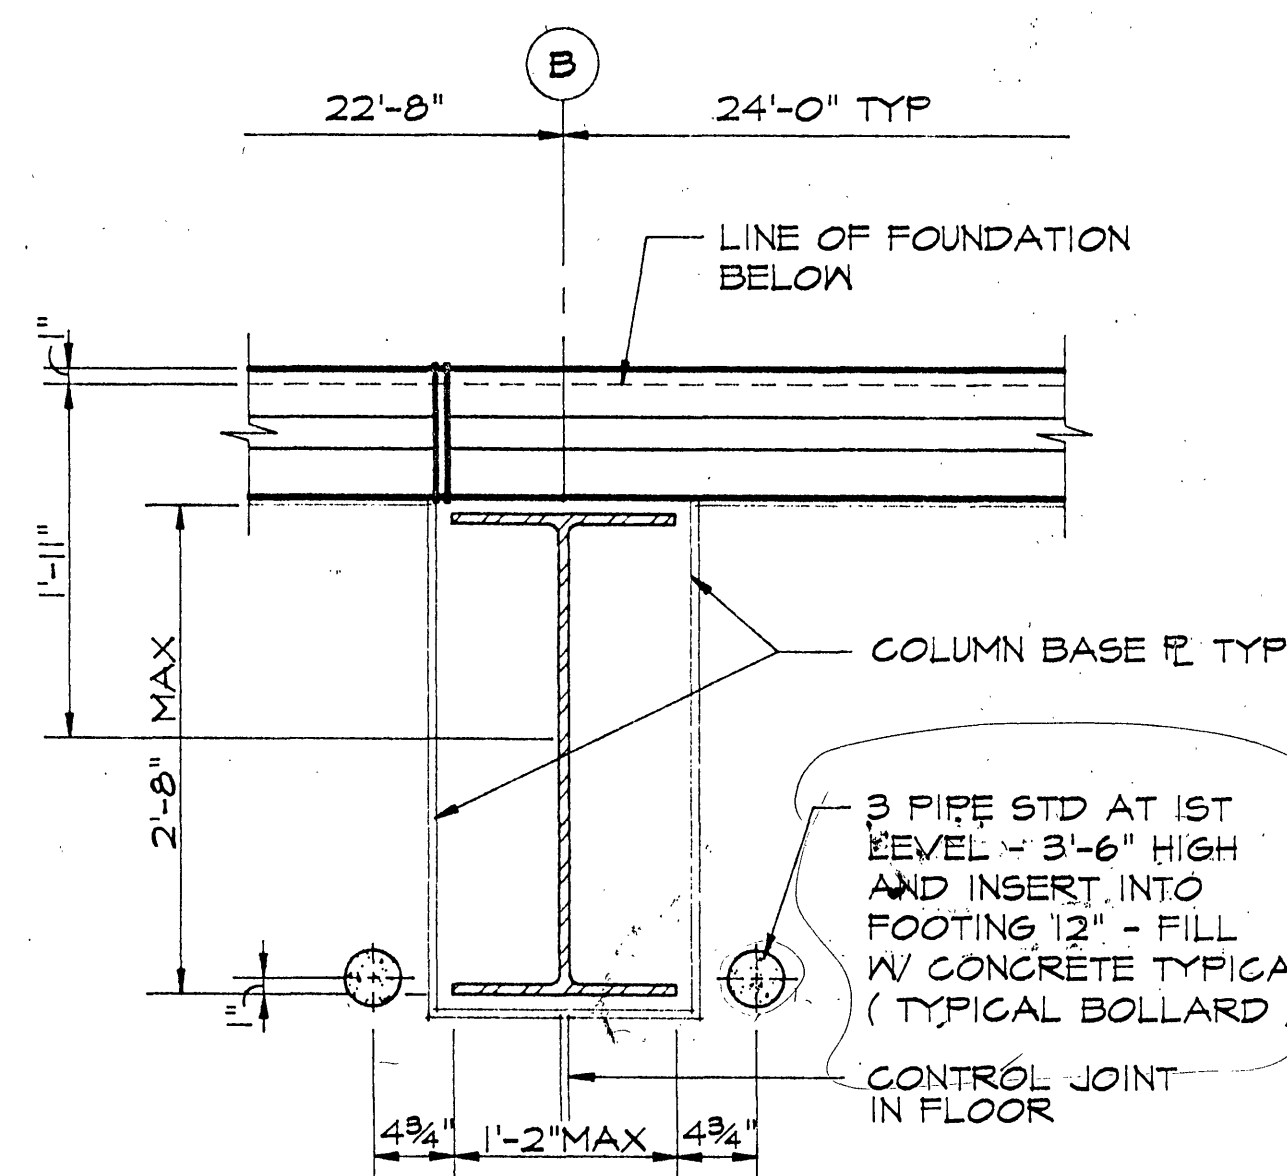


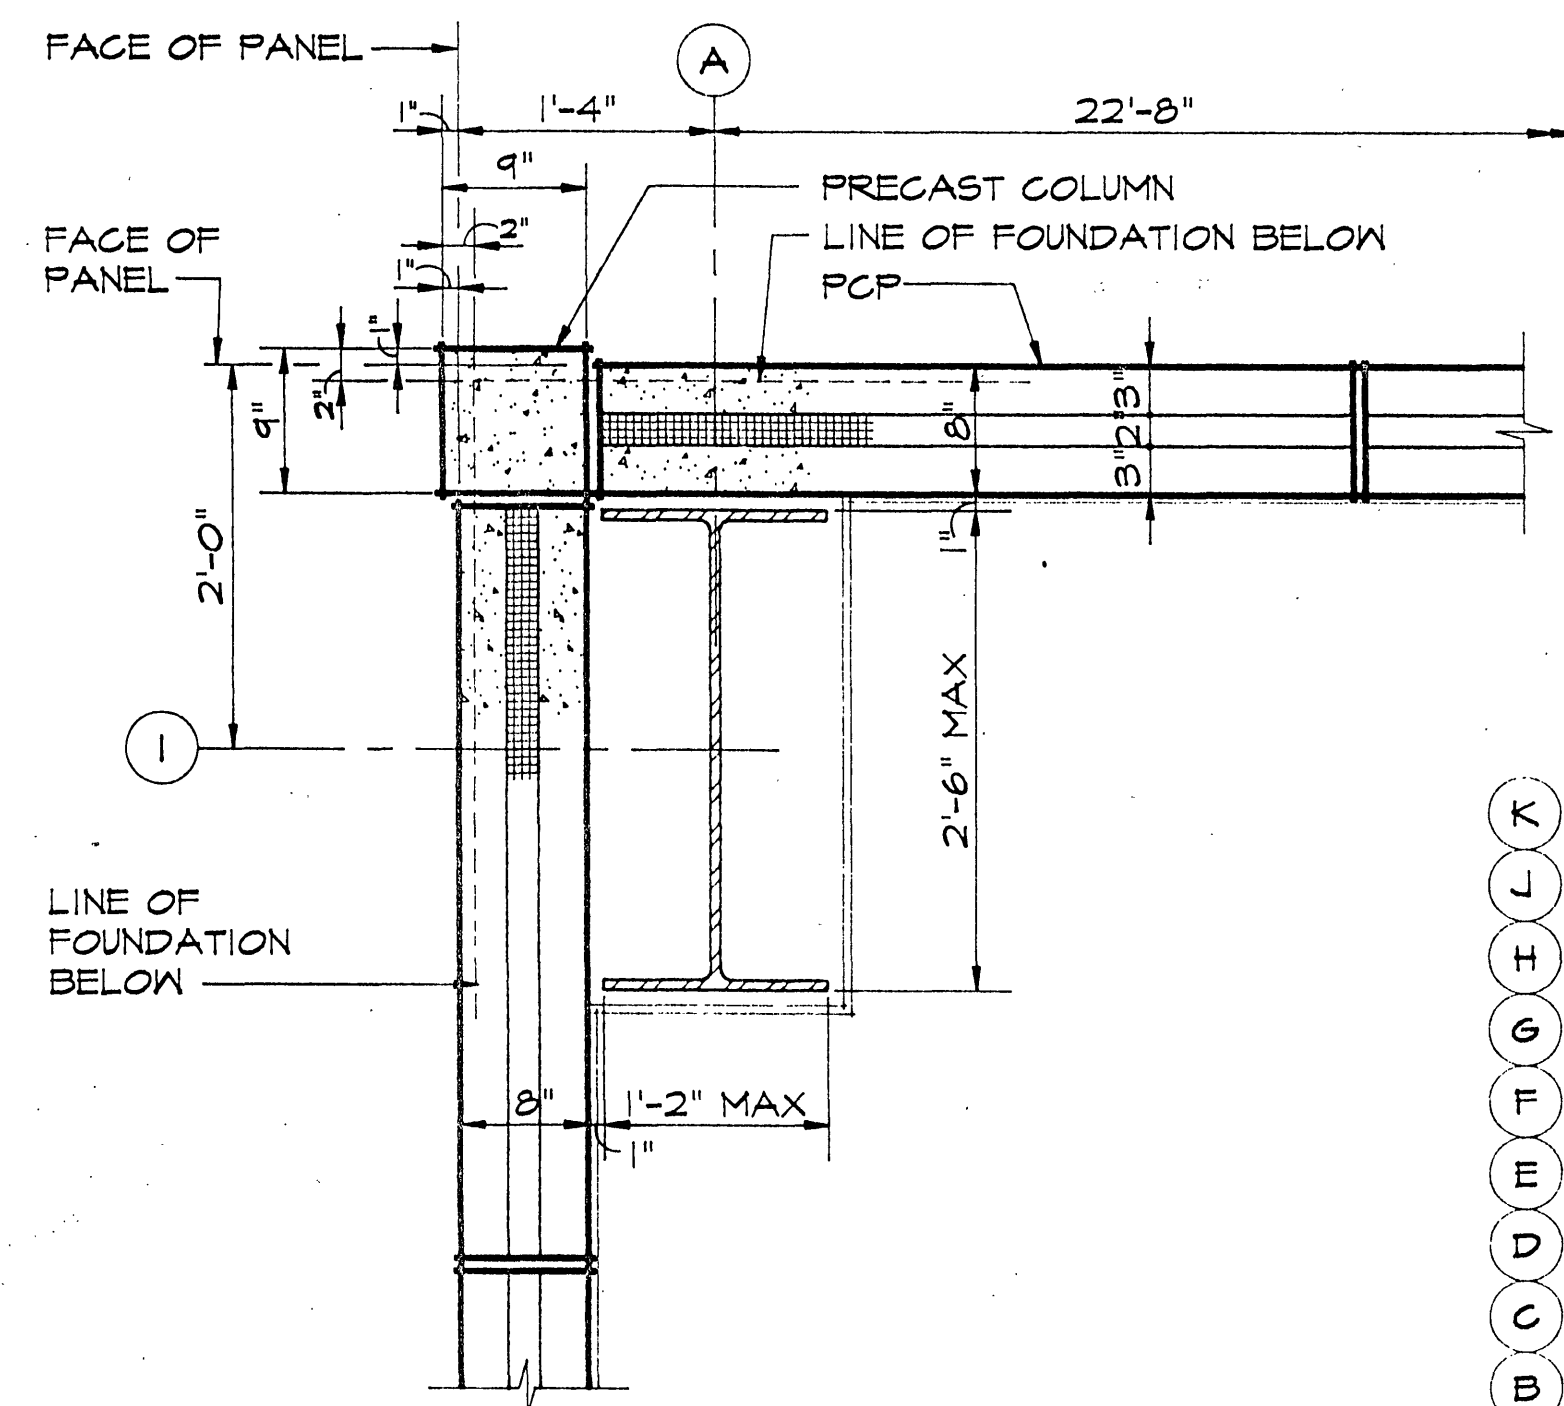

SECTION B17.6
SCALE 1" = 1'-0"


SECTION B17.8
SCALE 1" = 1'-0"

SECTION B17.9
SCALE 1" = 1'-0"


INSPECTOR'S AS-BUILTS 1995

WWW.ID# 6LDL2

NOTE: DIMENSIONS INDICATED FOR STEEL FRAMING MEMBERS ARE FOR MAXIMUM OVERALL SIZES

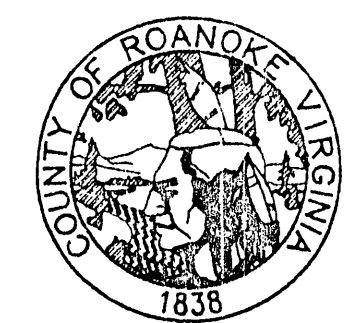

ROANOKE COUNTY WATER TREATMENT FACILITY

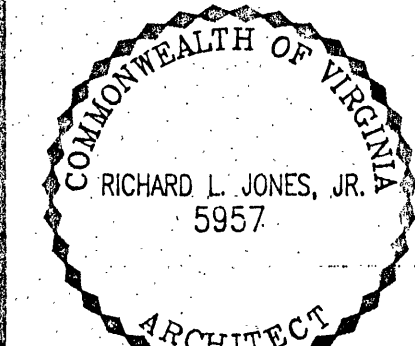

SECTIONS

PROJECT ARCHITECT	COMMISSION NUMBER
RLJ	1913
TECHNICIAN	DATE
RAY	22 SEPT 1994

B17

JONES & JONES ASSOCIATES / ARCHITECTS P.A.