



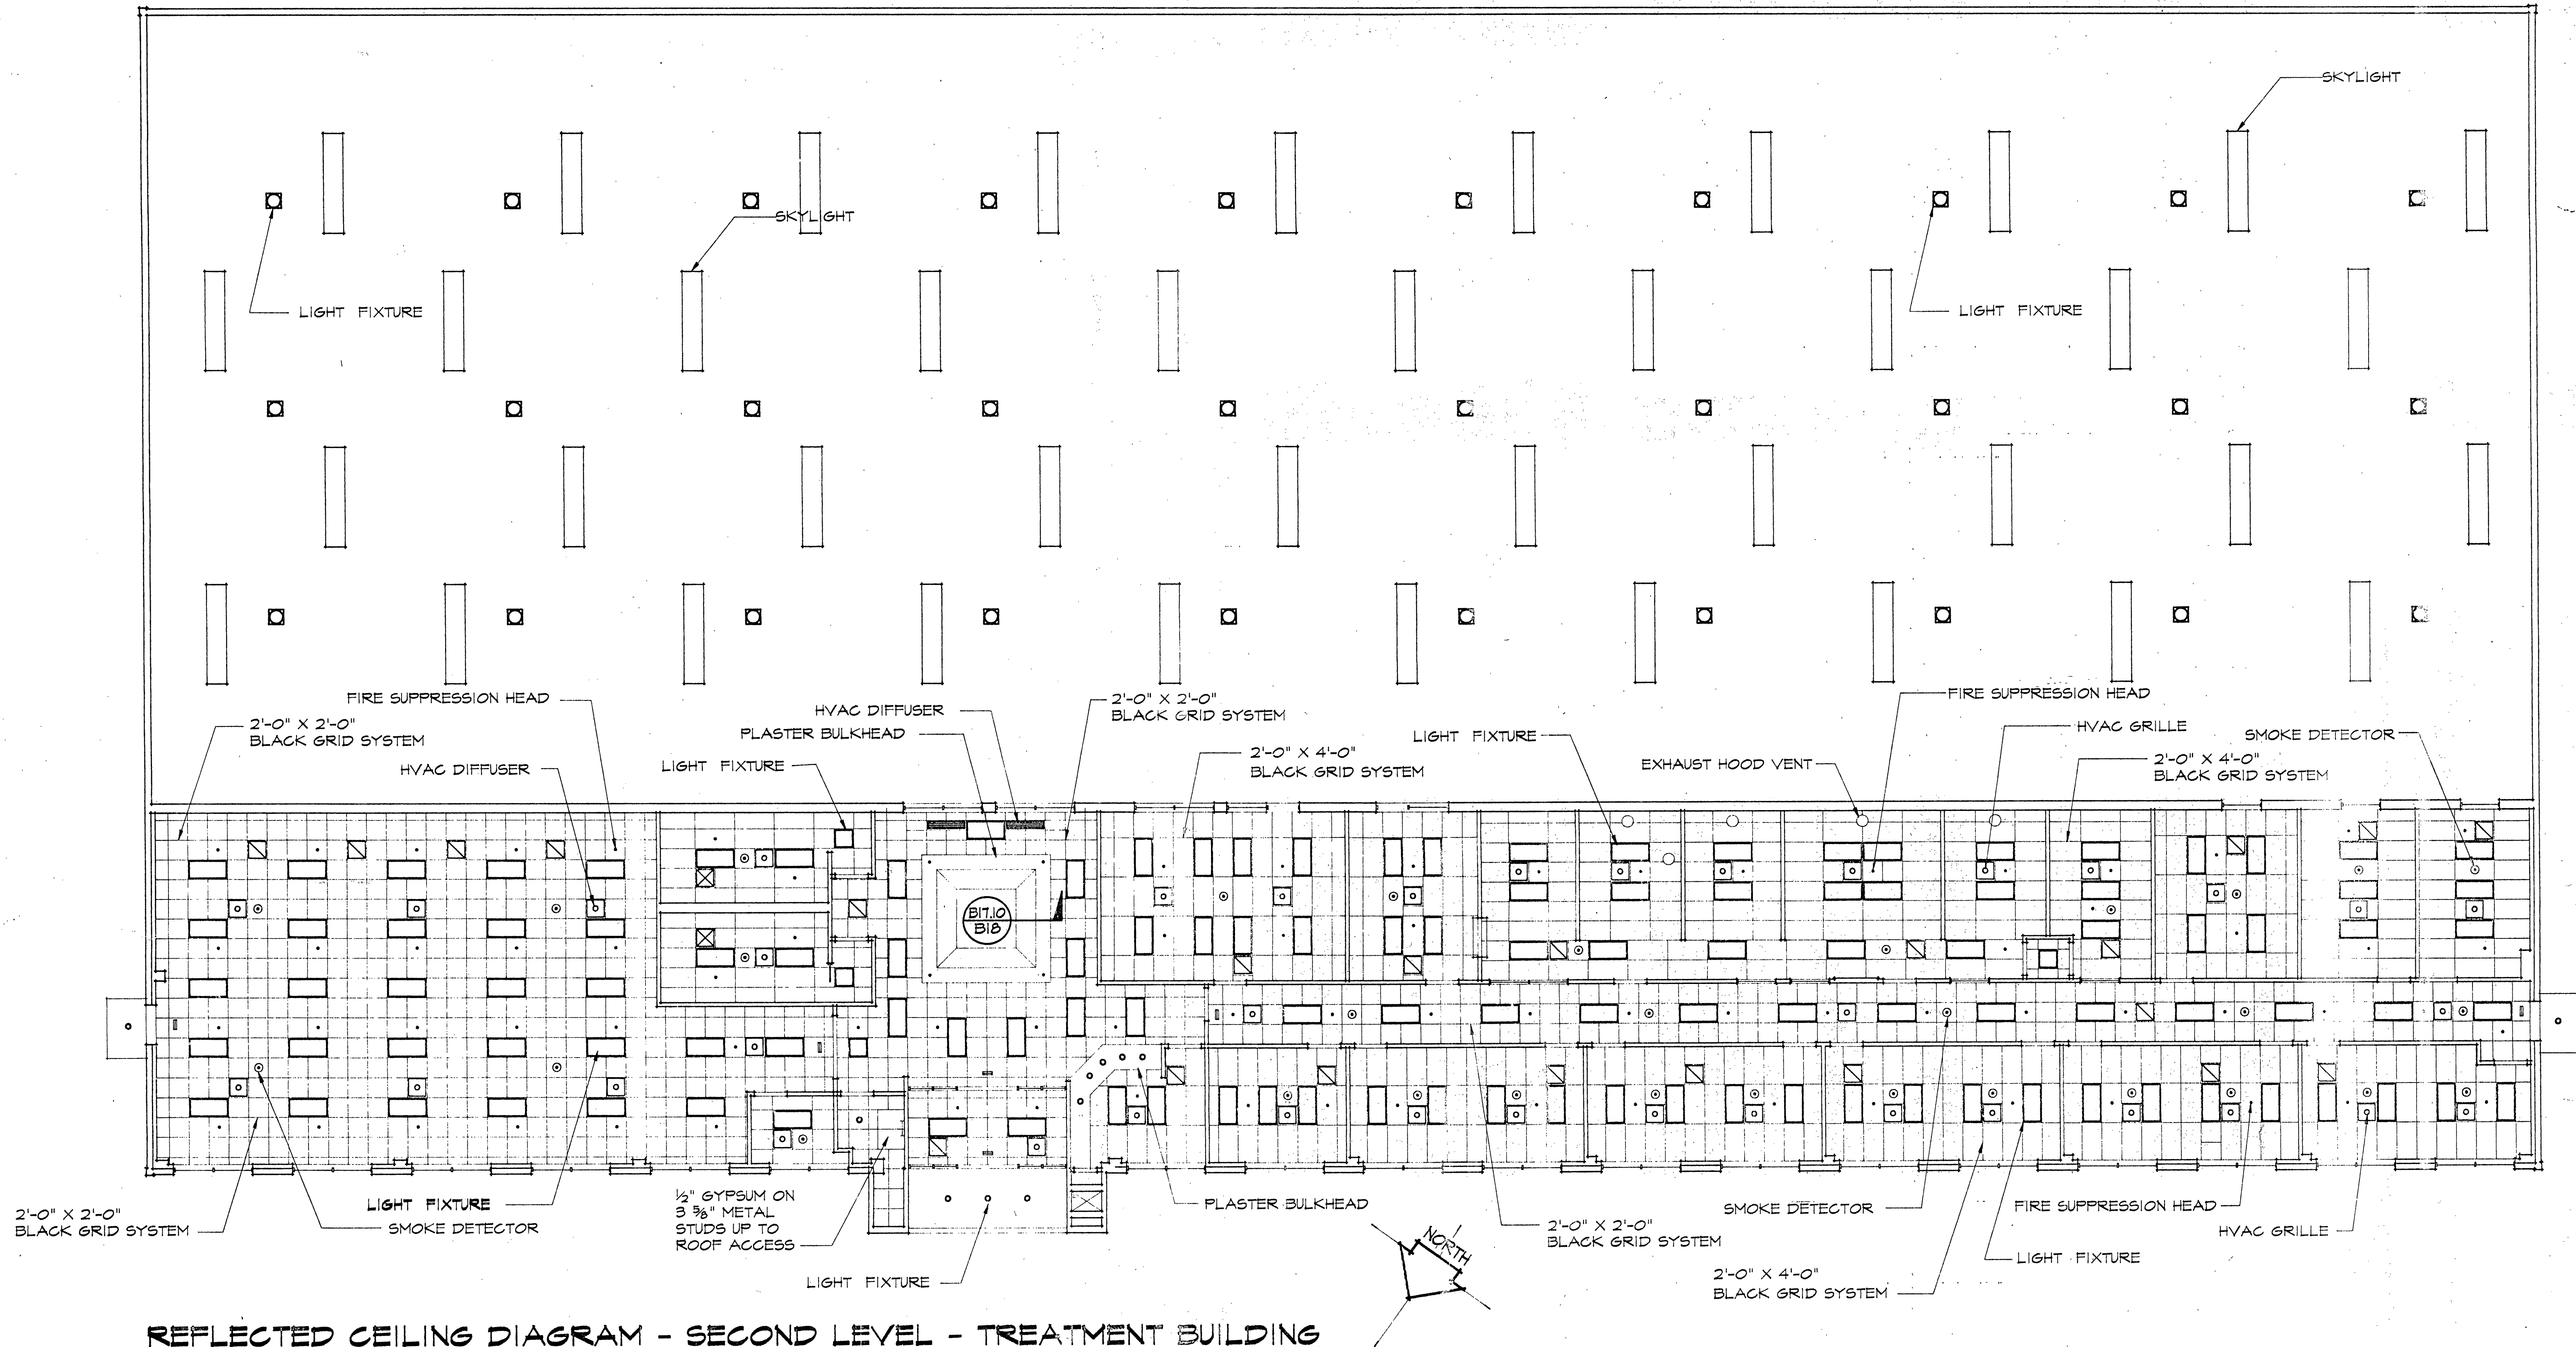


REFLECTED CEILING DIAGRAM - SECOND LEVEL - TREATMENT BUILDING
 SCALE 1/8" = 1'-0"

INSPECTOR'S AS-BUILTS 1995

WWW.ID# 8DLUZ

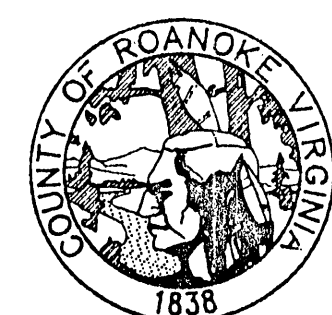

ROANOKE COUNTY WATER TREATMENT FACILITY

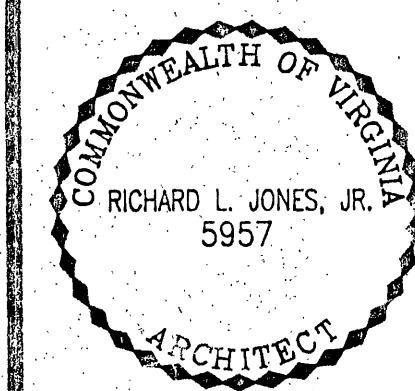

REFLECTED CEILING DIAGRAM	
PROJECT ARCHITECT RLJ JR	COMMISSION NUMBER 1913
TECHNICIANS RWI	DATE 22 SEPT 1994

B18

JONES & JONES ASSOCIATES / ARCHITECTS PC