



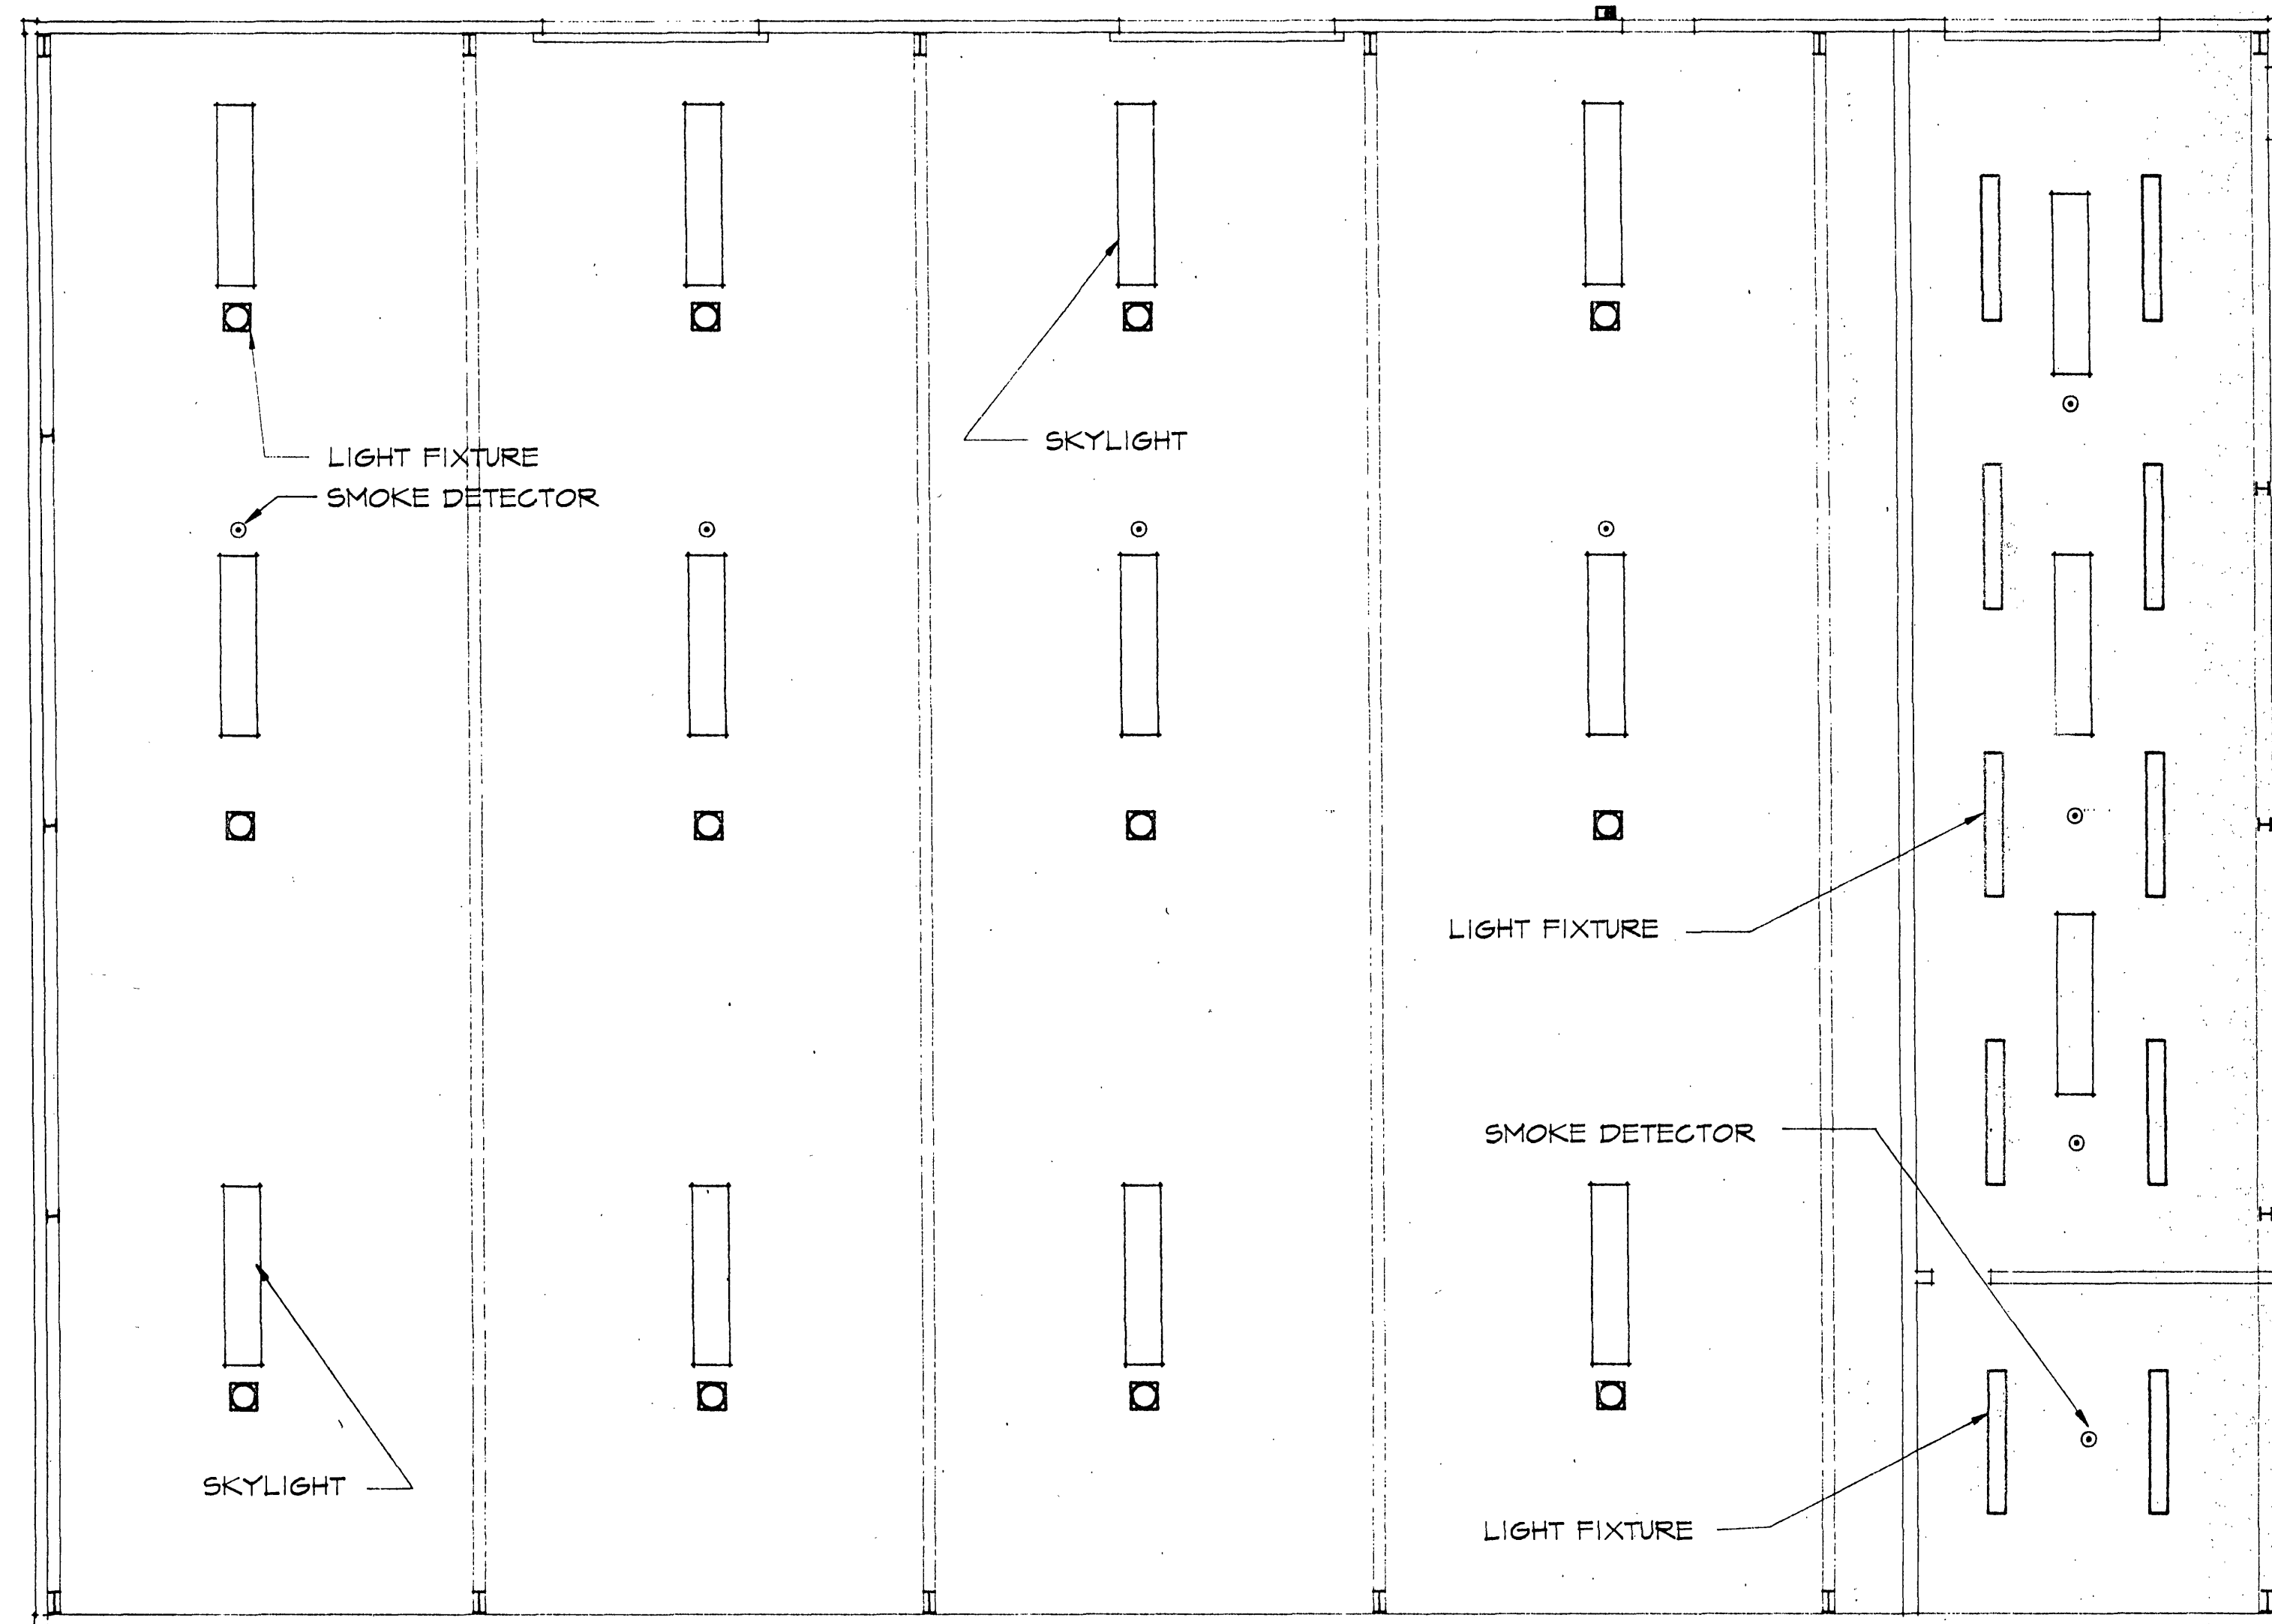

**REFLECTED CEILING DIAGRAM - GAC BUILDING**  
SCALE 1/8" = 1'-0"

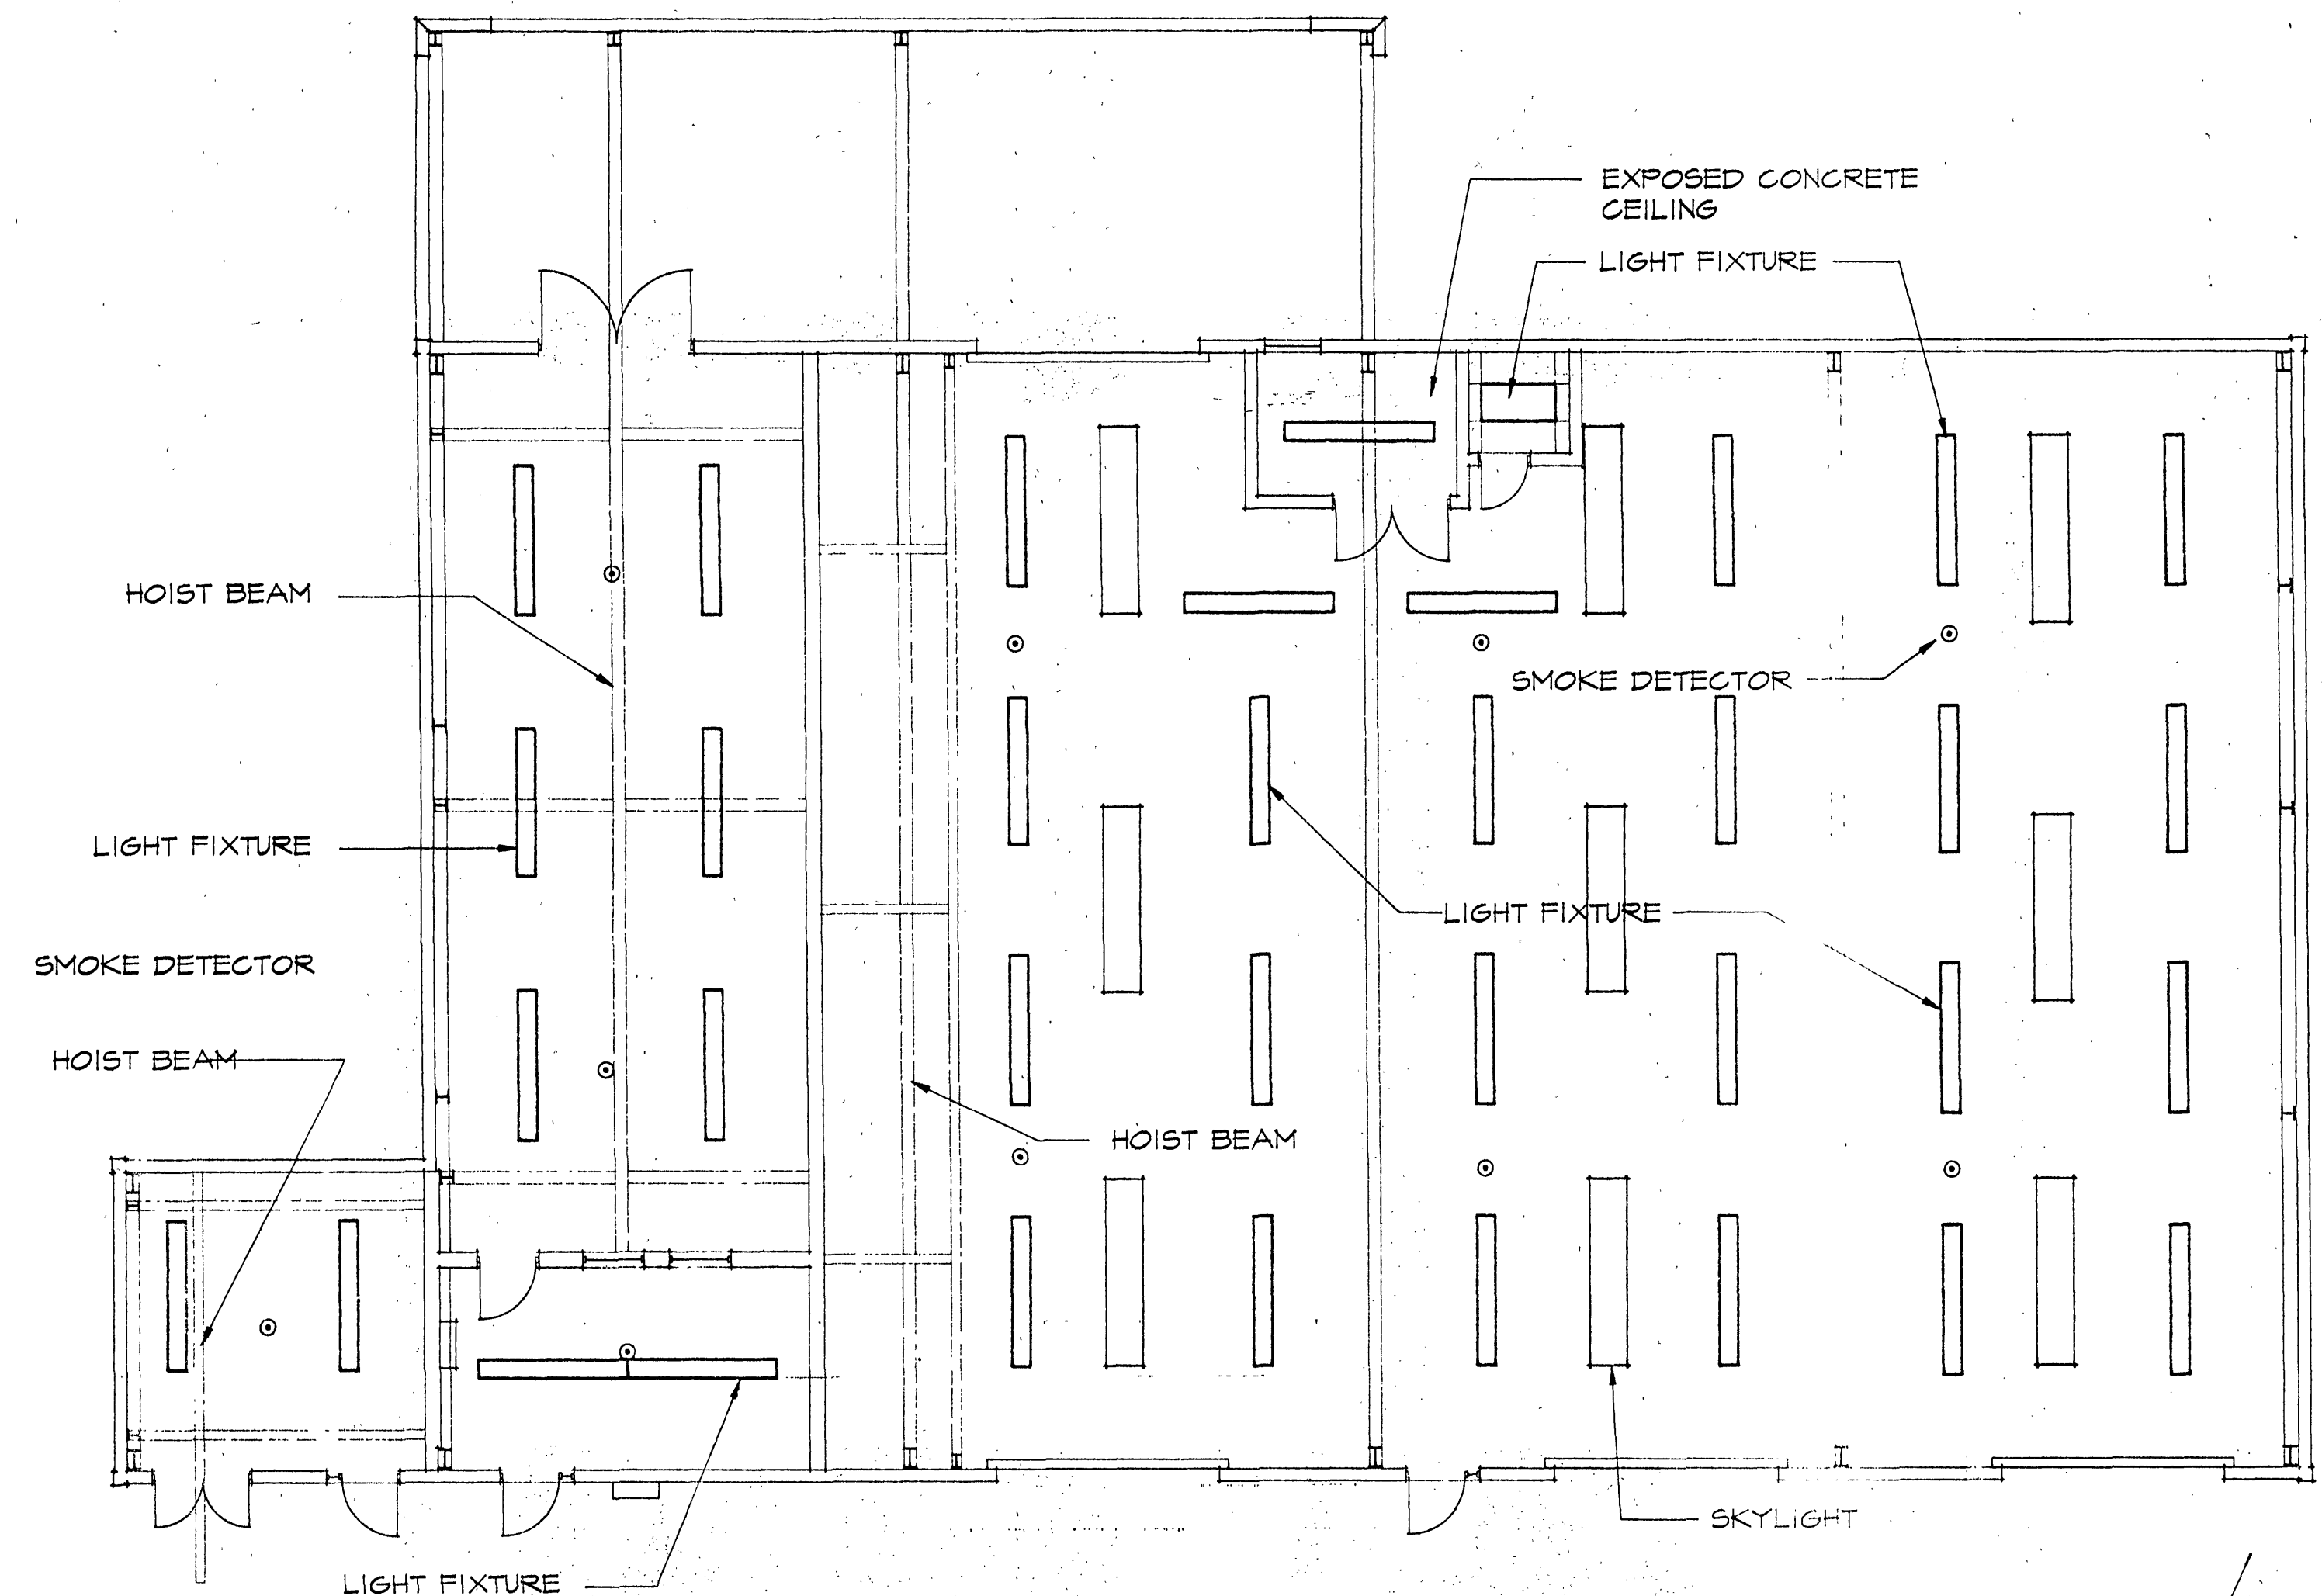


**REFLECTED CEILING DIAGRAM - POST TREATMENT BUILDING**  
SCALE 1/8" = 1'-0"


- NOTES
1. ALL ELEMENTS INDICATED ON THIS SHEET ARE FOR REFLECTED CEILING SYSTEMS ONLY. OTHER BUILDING ELEMENTS SHALL BE AS INDICATED ELSEWHERE
  2. THE CONTRACTOR SHALL CO-ORDINATE THE INSTALLATION OF THE INDICATED SYSTEMS WITH THE OWNER FURNISHED ELEMENTS.

INSPECTOR'S AS-BUILTS 1995

WWW ID# 6LDLUZ

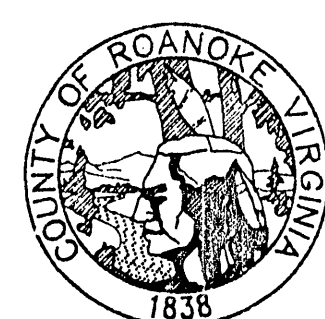

**ROANOKE COUNTY  
WATER TREATMENT  
FACILITY**

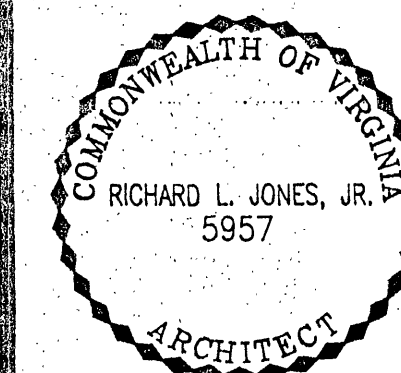

**REFLECTED CEILING DIAGRAM 15**

PROJECT ARCHITECT  
RLJ JR

COMMISSION NUMBER  
1413

TECHNICIAN  
RAT

DATE  
22 SEPT 1994

**B19**