




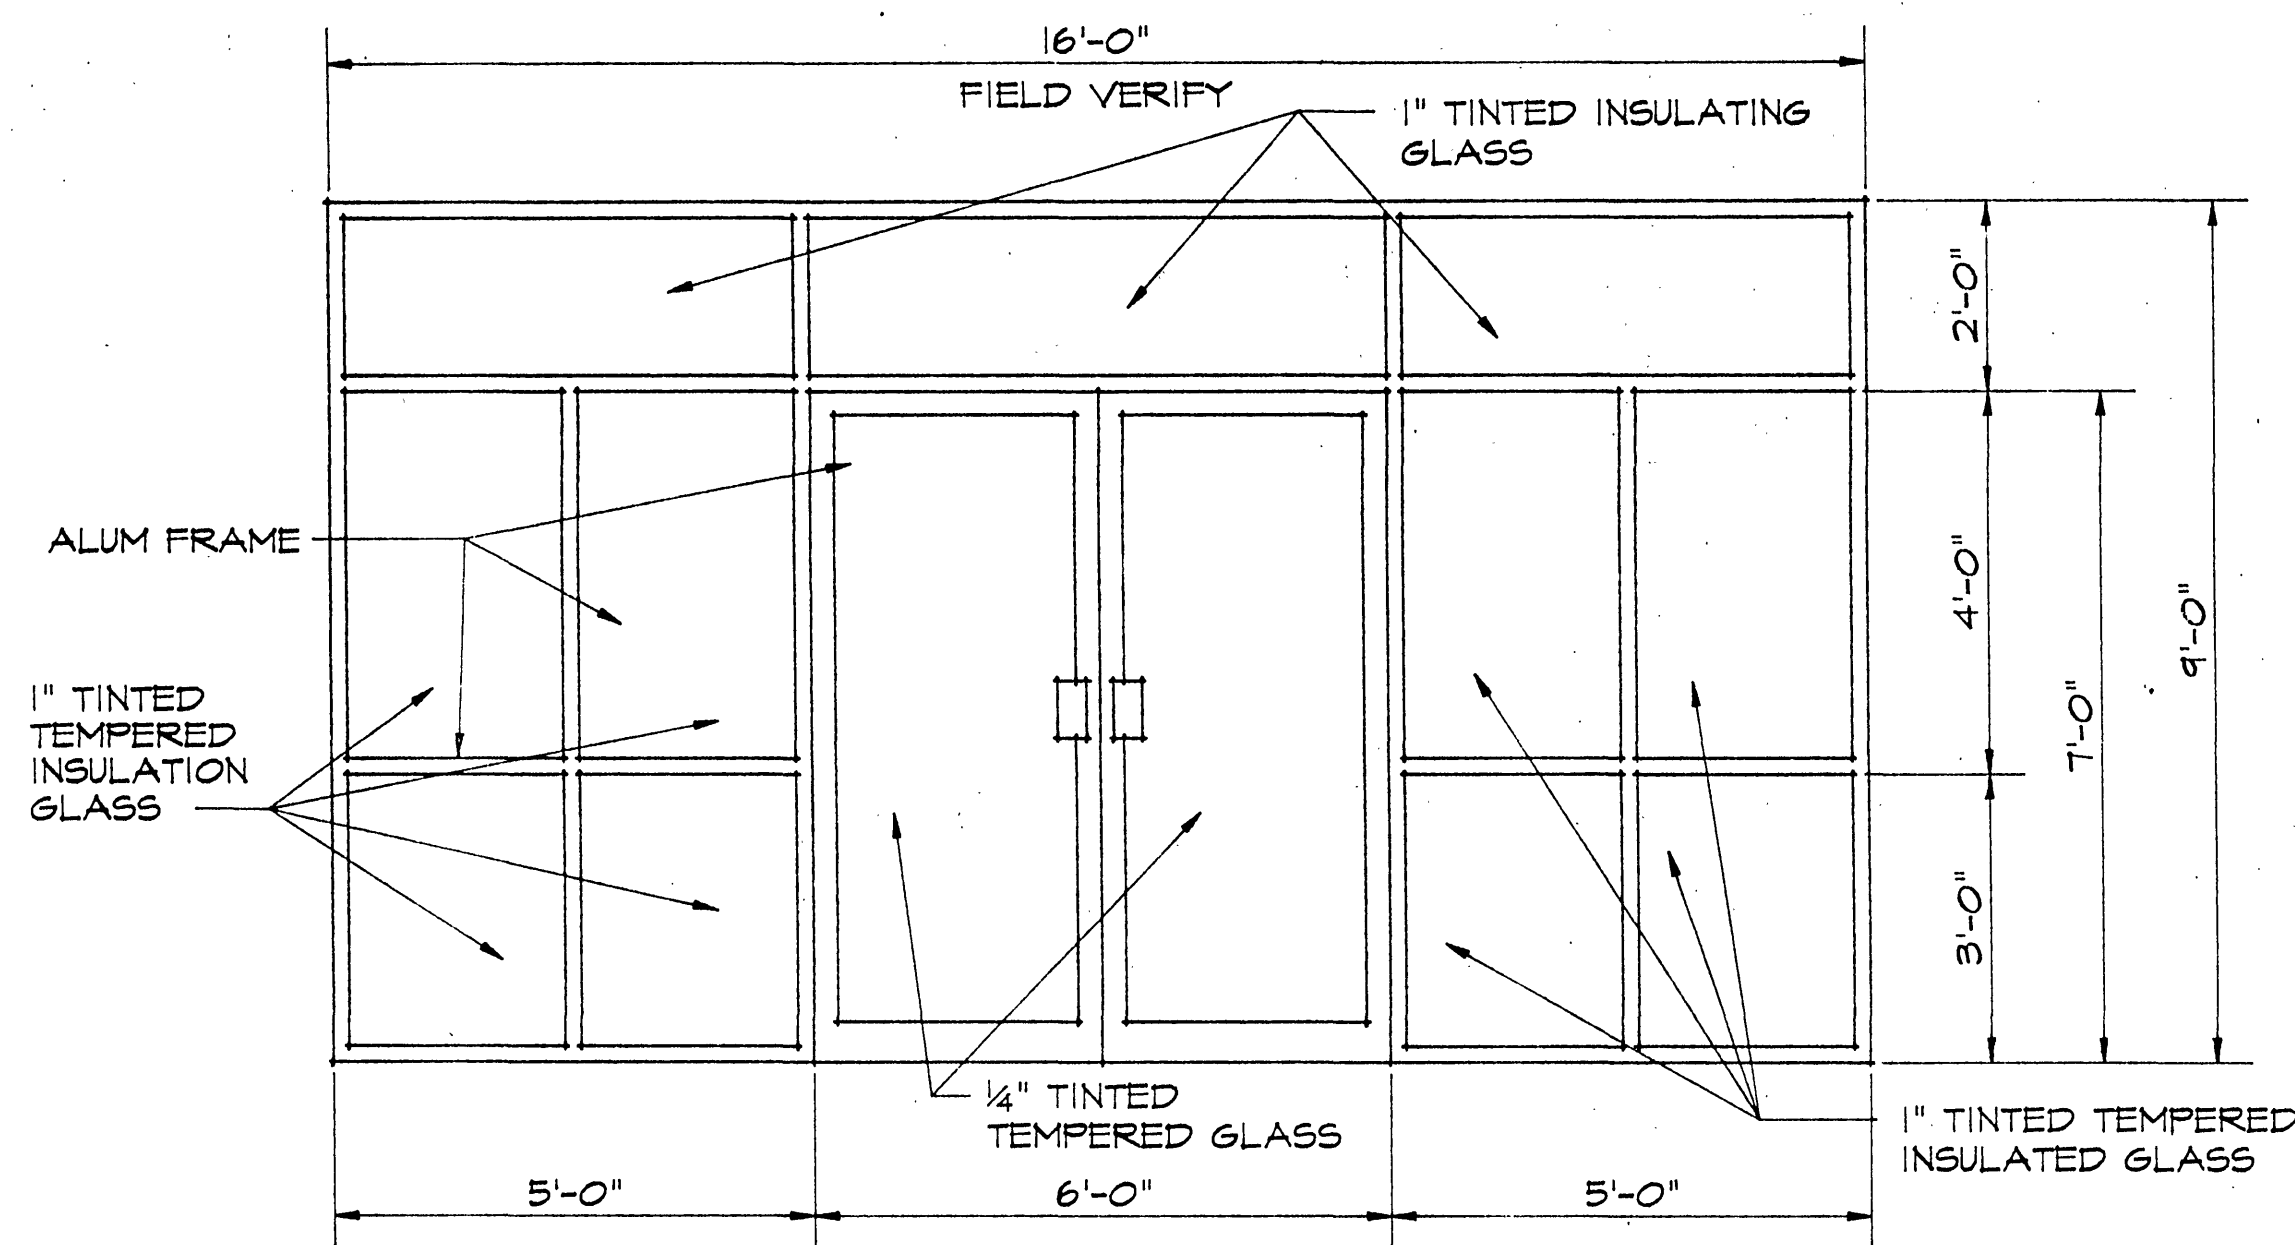


ENTRY ELEVATION AT DOOR 201 - DOOR 202 SIMILAR
SCALE 1/2" = 1'-0"

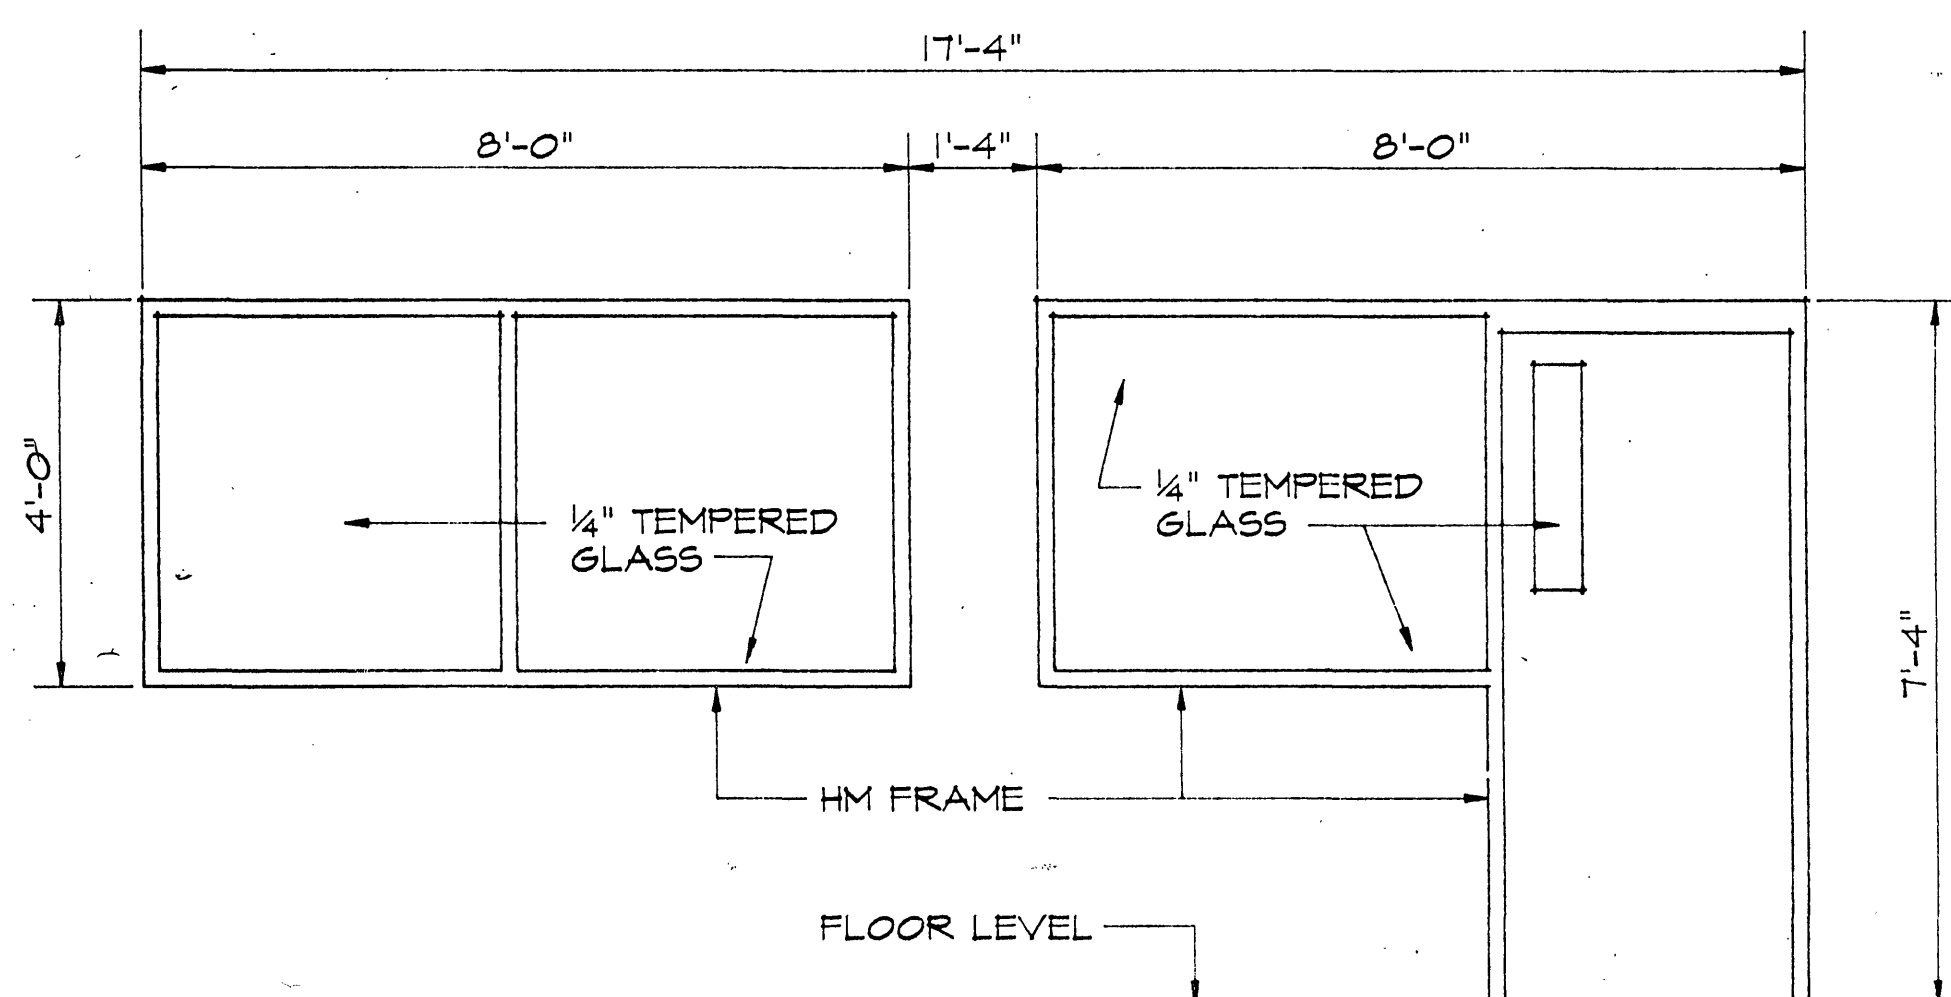


ENTRY ELEVATION
SCALE 1/2" = 1'-0"

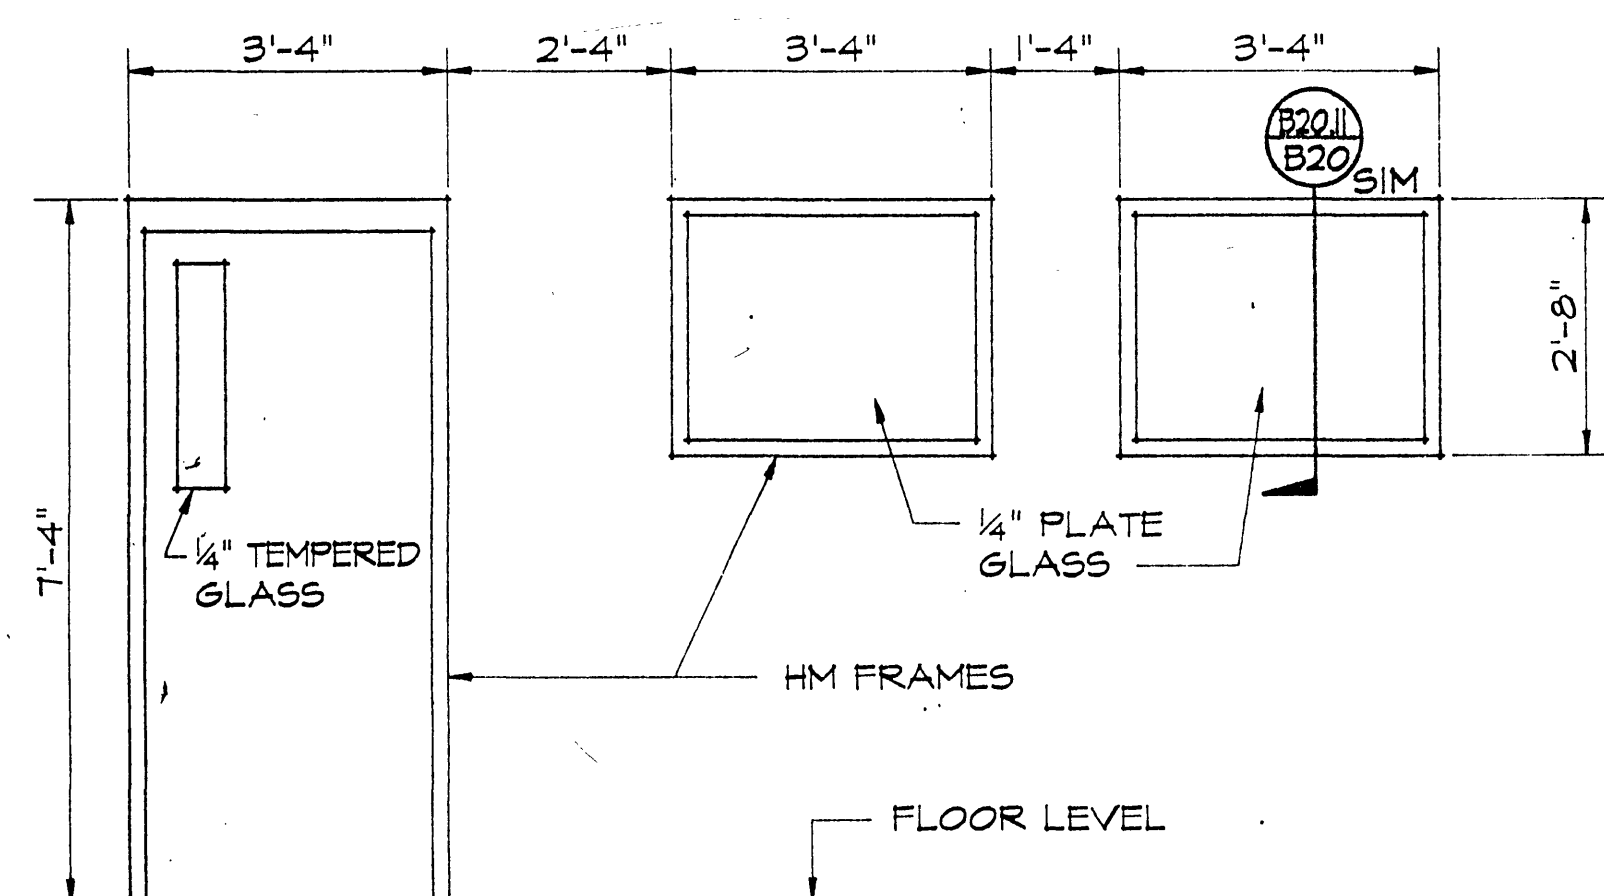


ELEVATION
SCALE 1/2" = 1'-0"

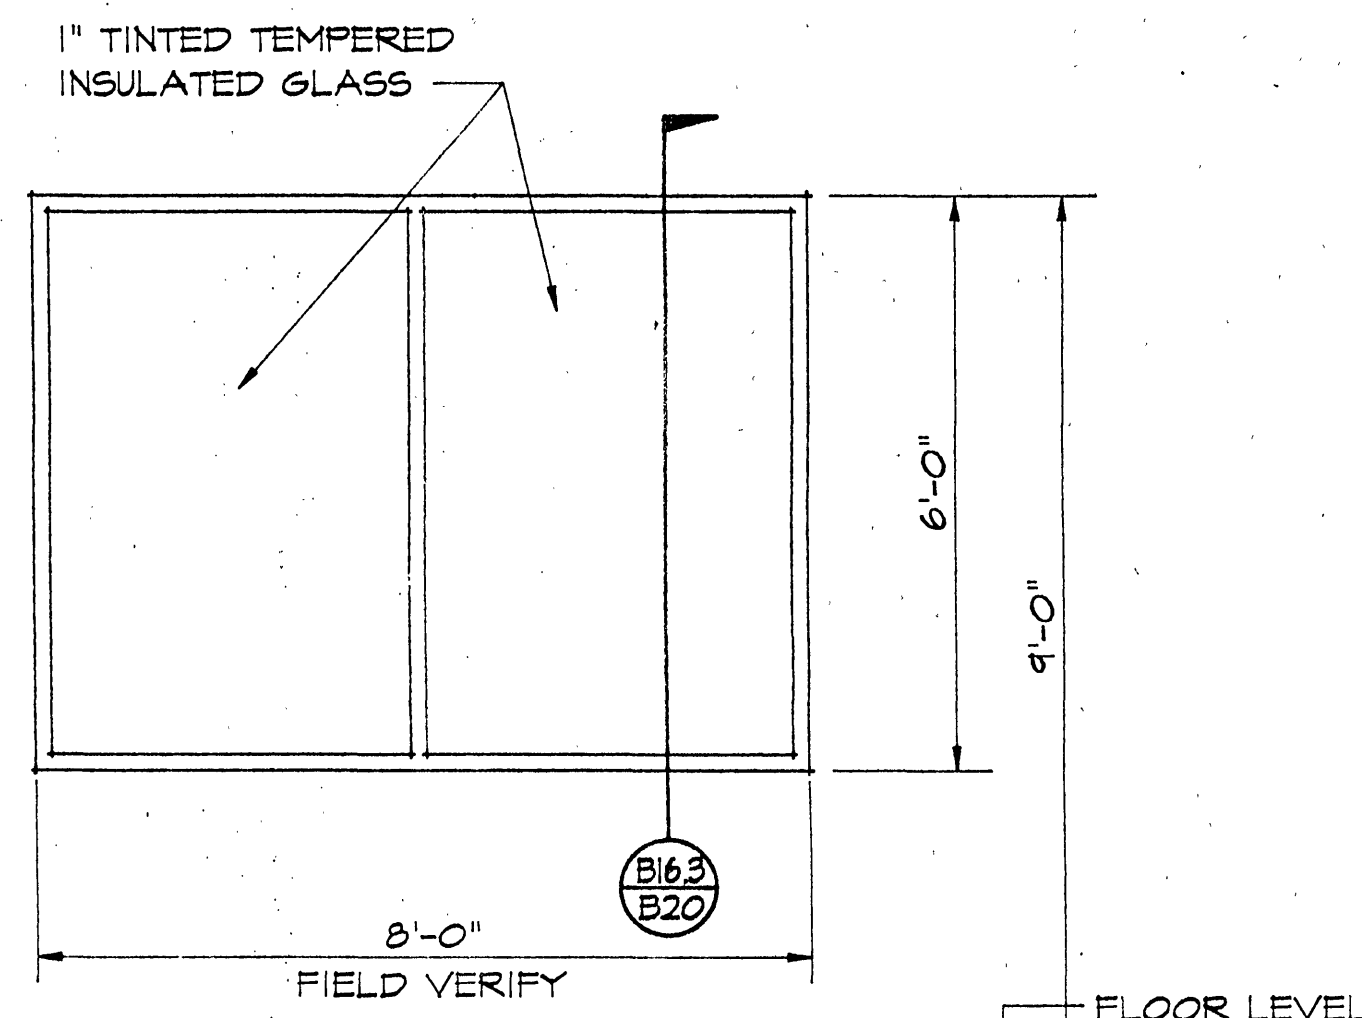


TYPICAL WINDOW TYPE A
WINDOW ELEVATION
SCALE 1/2" = 1'-0"

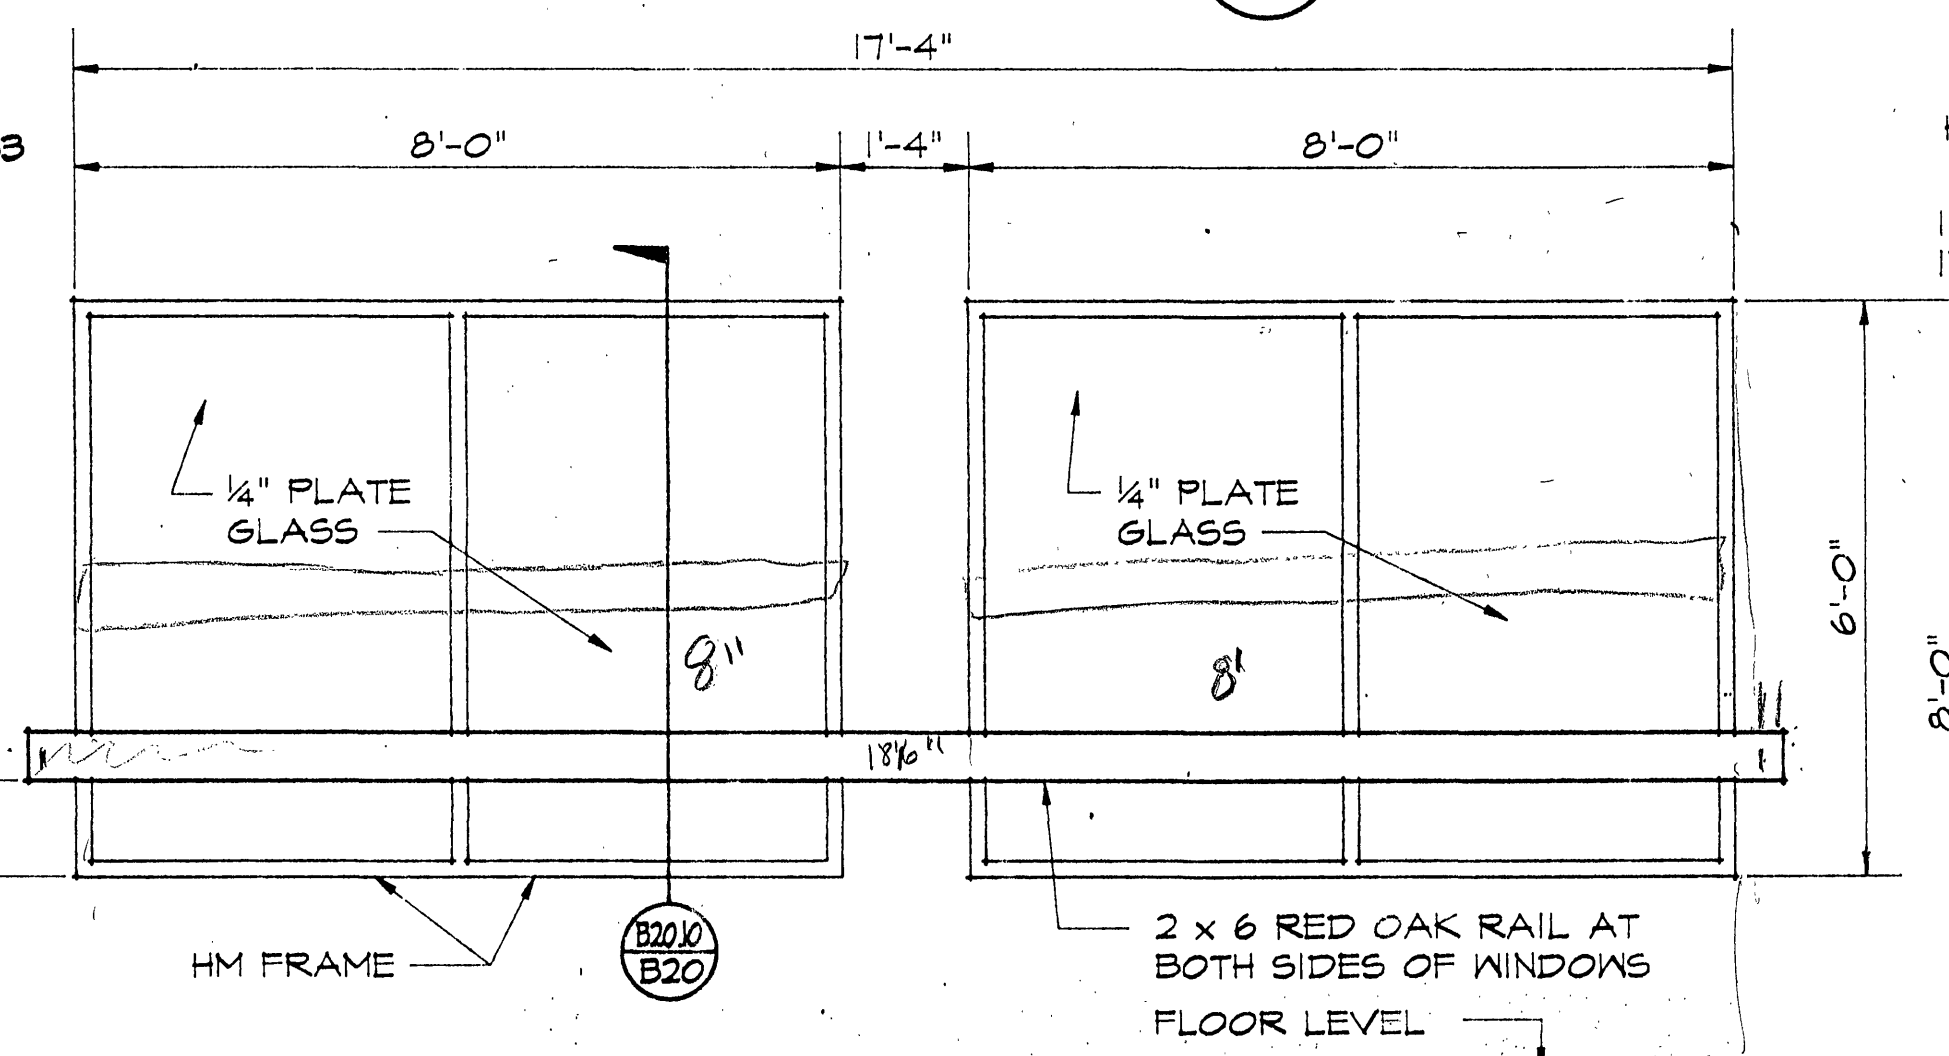


WINDOW ELEVATION
SCALE 1/2" = 1'-0"

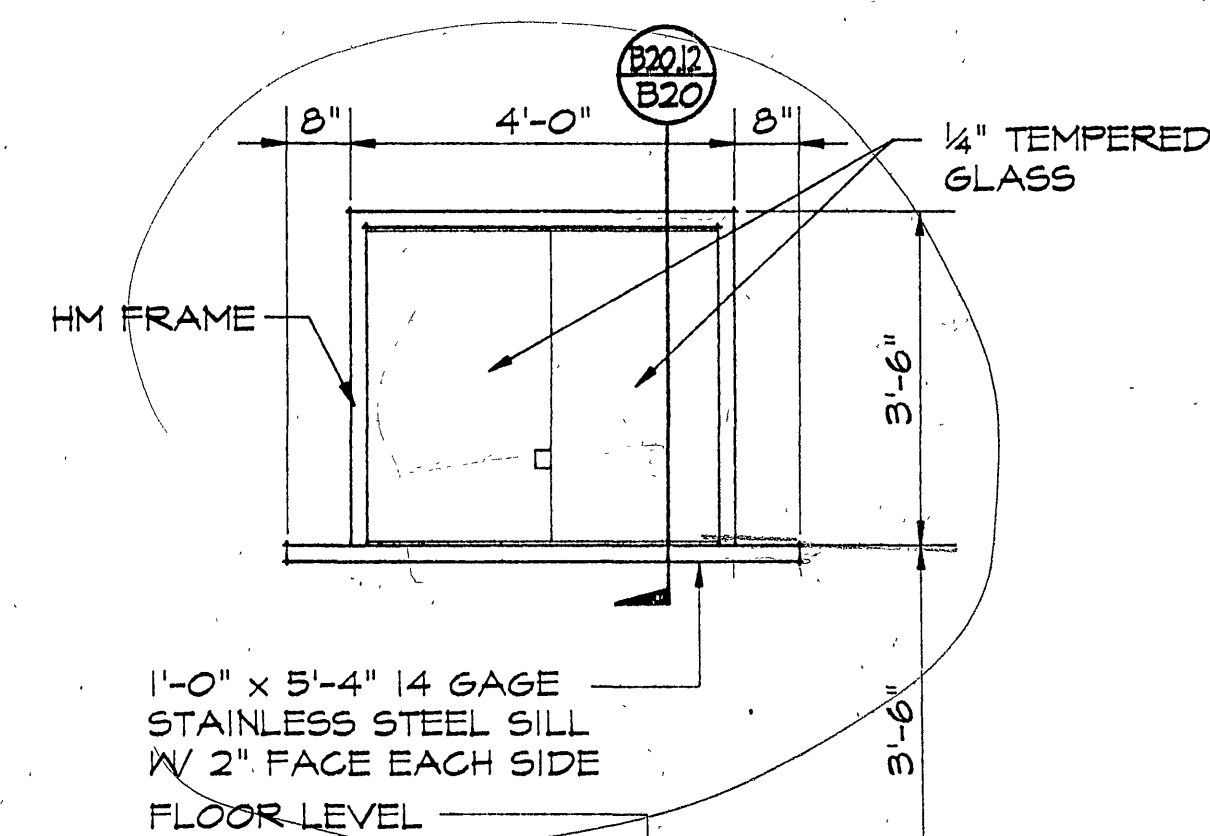

WINDOW ELEVATION
SCALE 1/2" = 1'-0"

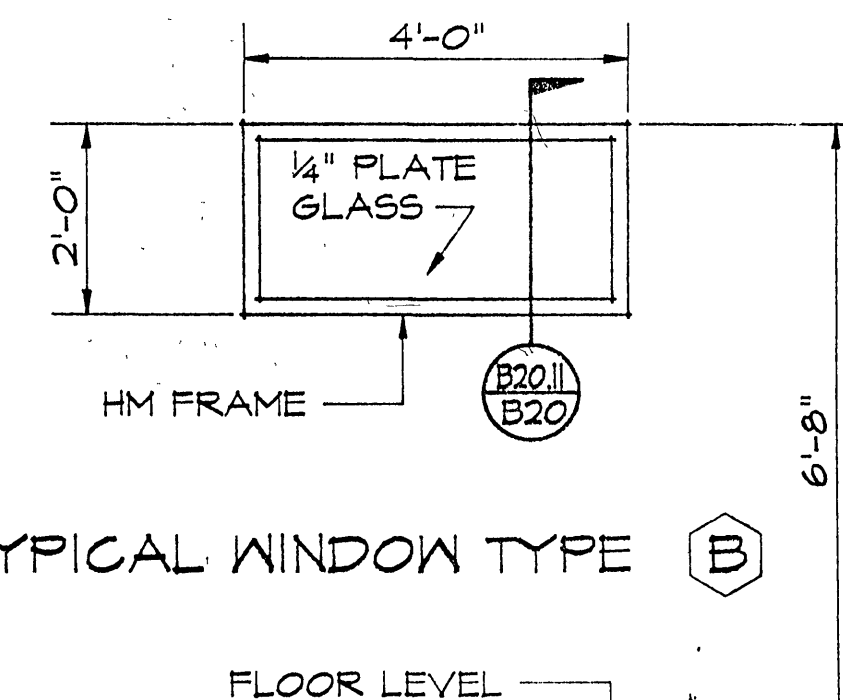


TYPICAL WINDOW TYPE B
WINDOW ELEVATION
SCALE 1/2" = 1'-0"

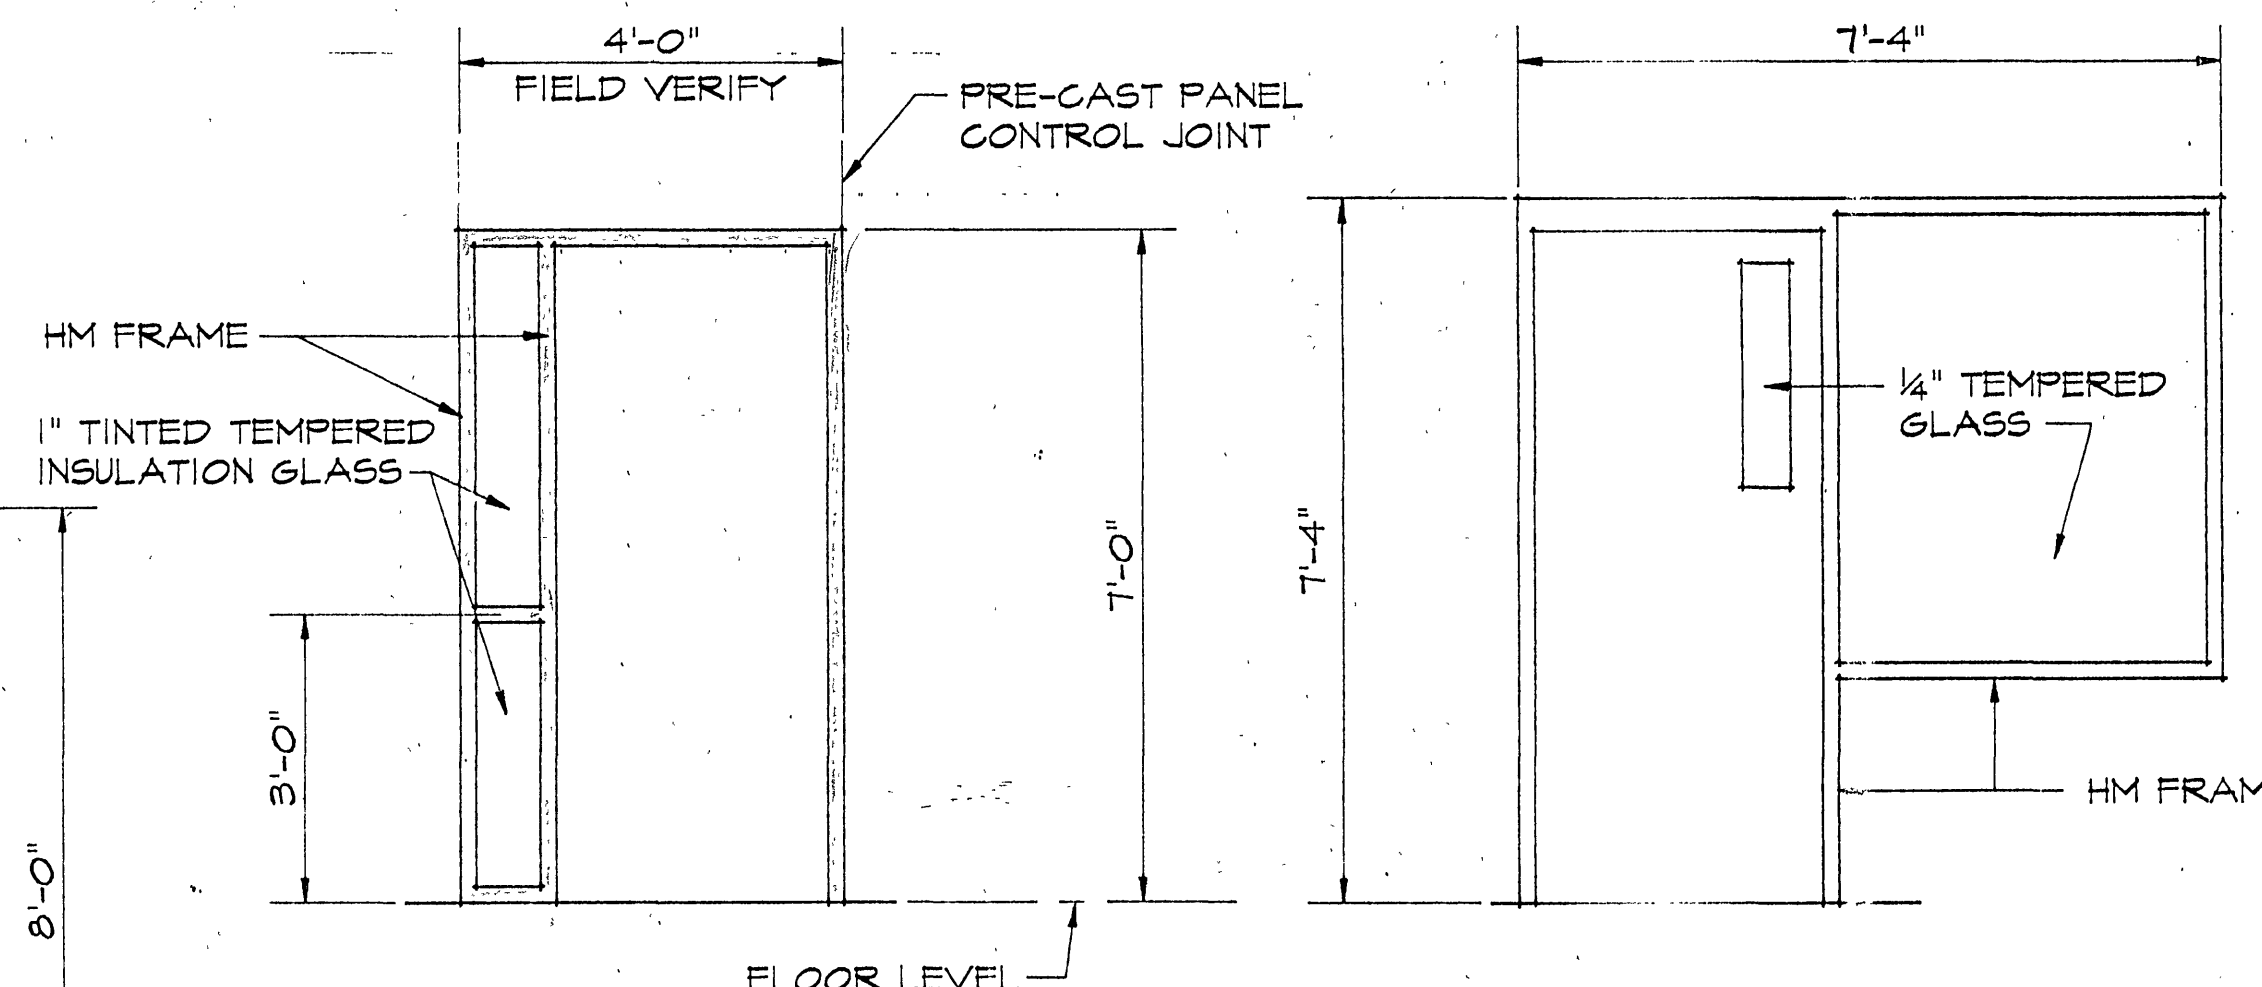


ENTRY ELEVATION
SCALE 1/2" = 1'-0" (TYPICAL OF TEN)


ENTRY ELEVATION
SCALE 1/2" = 1'-0"

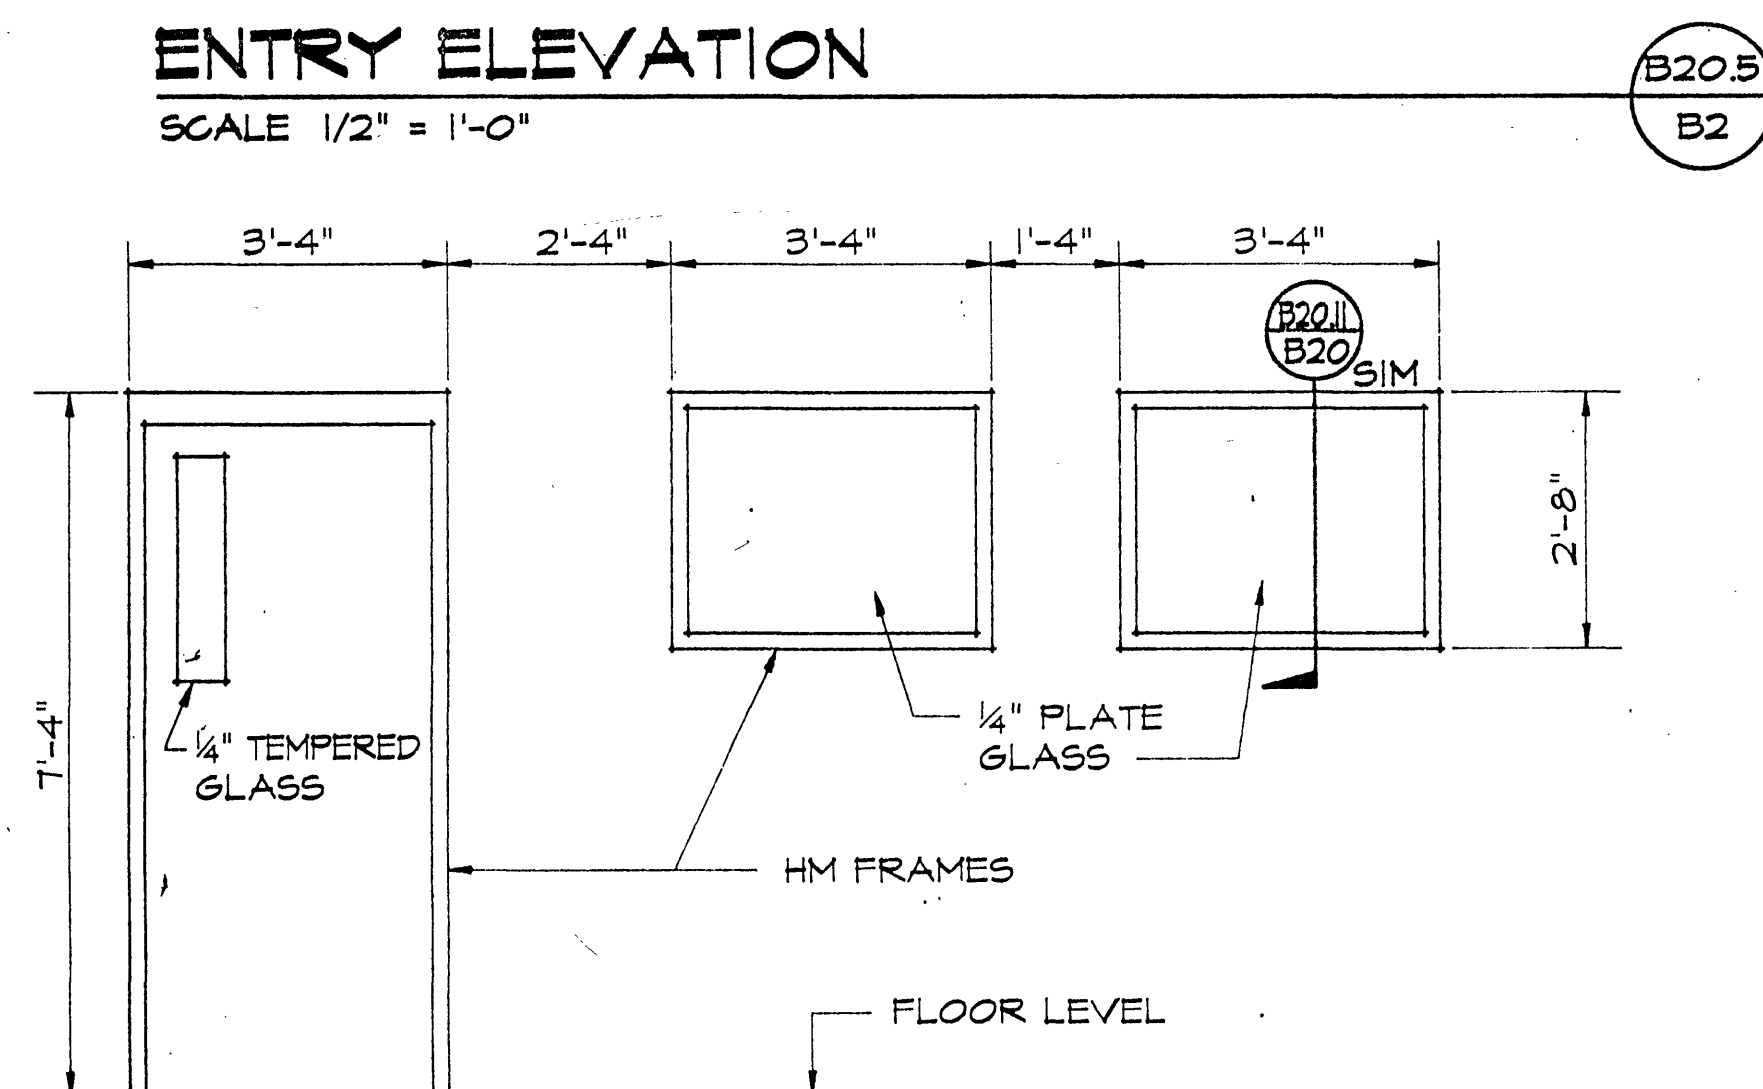


ELEVATION
SCALE 1/2" = 1'-0"

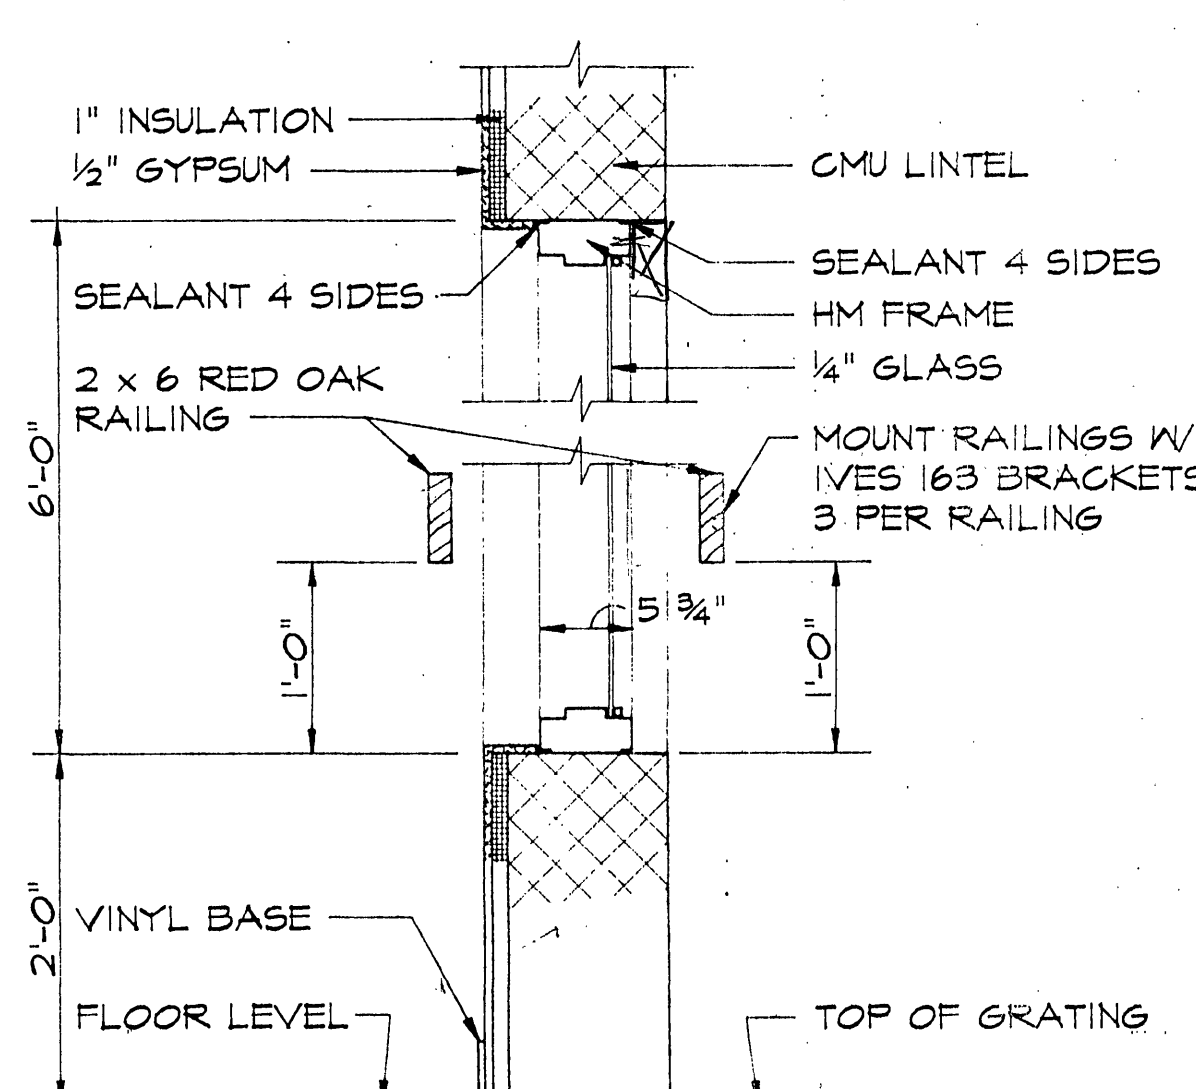


ELEVATION
SCALE 1" = 1'-0"

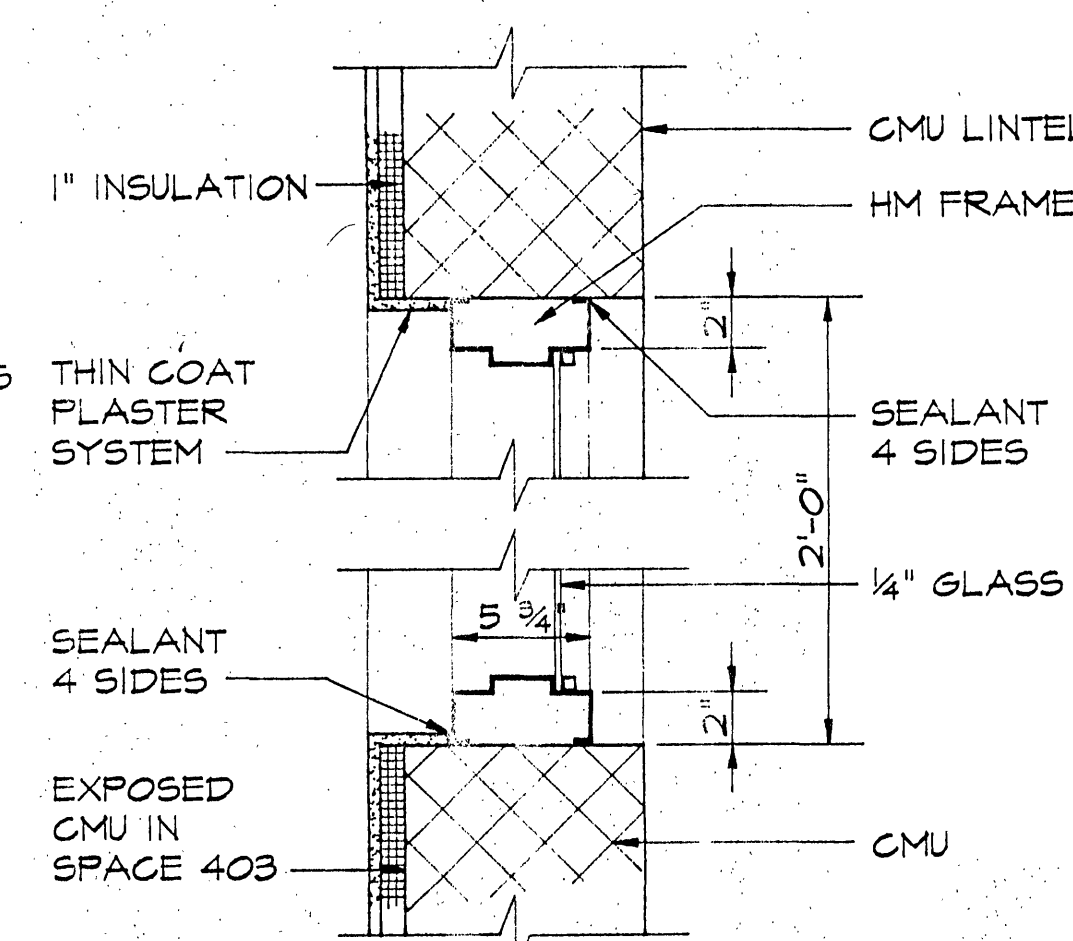

ELEVATION
SCALE 1 1/2" = 1'-0"

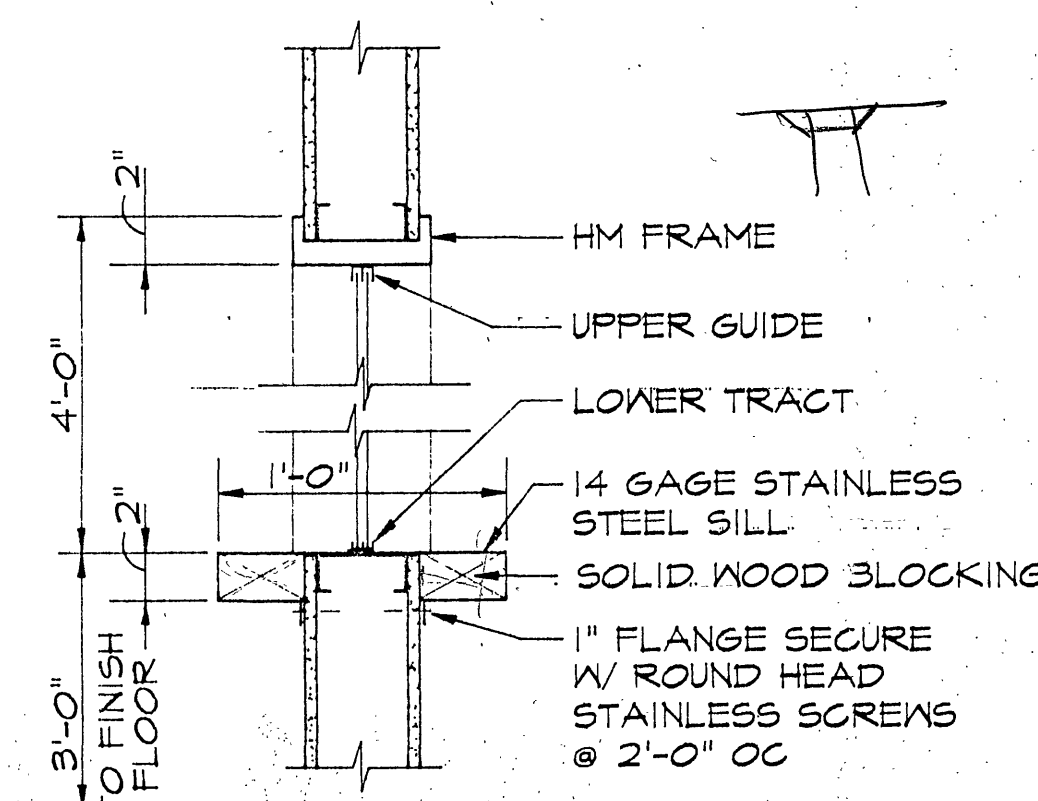

SECTION
SCALE 1 1/2" = 1'-0"

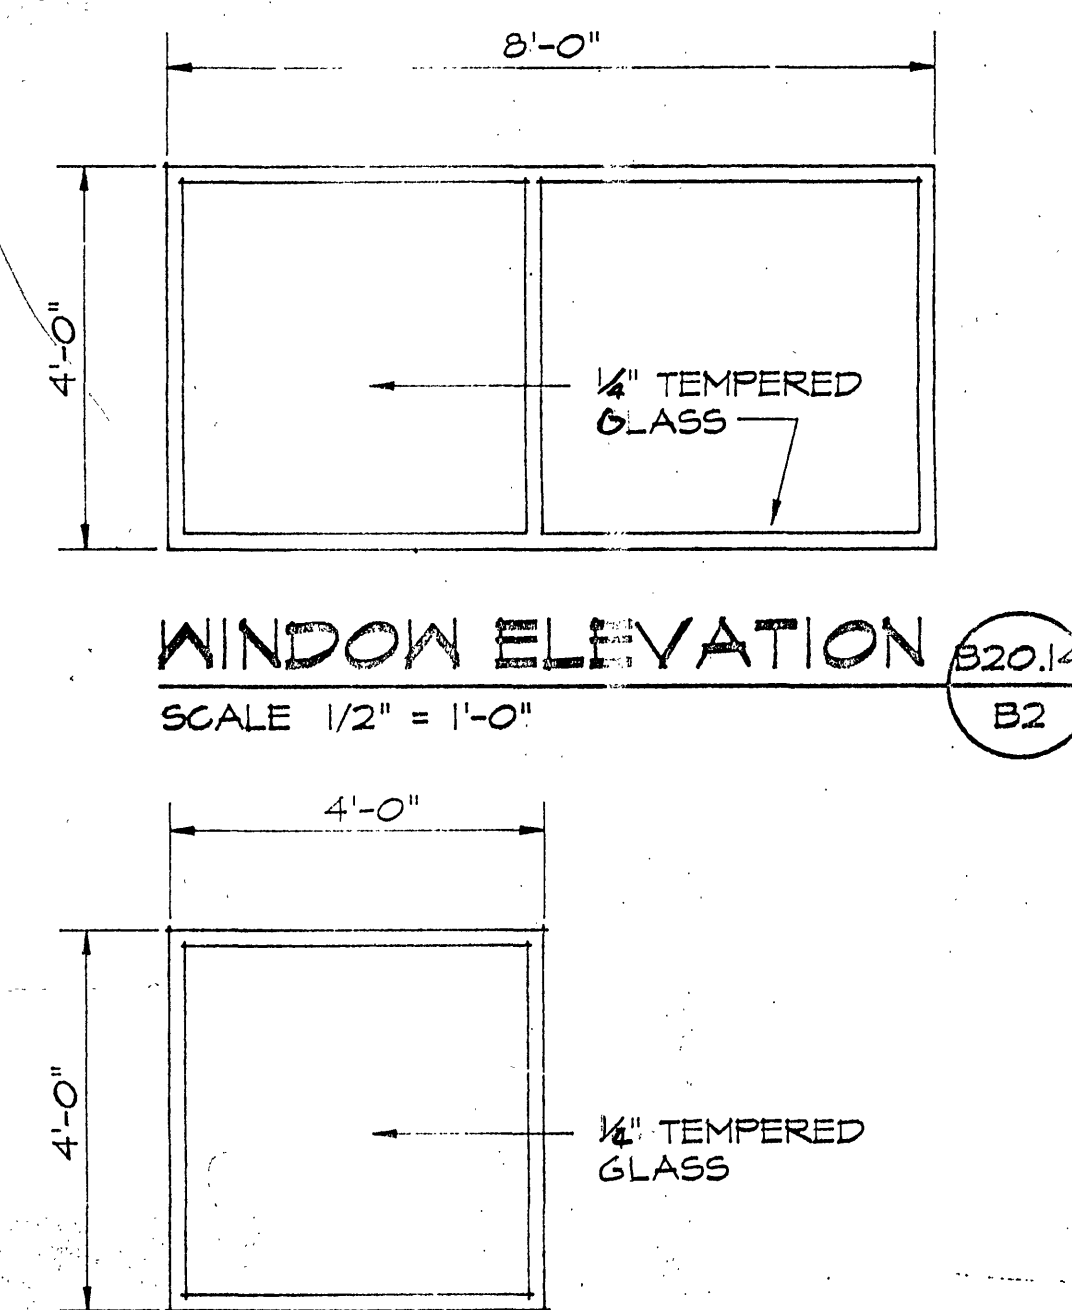


WINDOW ELEVATION
SCALE 1/2" = 1'-0"


WINDOW ELEVATION
SCALE 1/2" = 1'-0"

INSPECTOR'S AS-BUILTS 1995

WWW.ID# 6LDLJZ

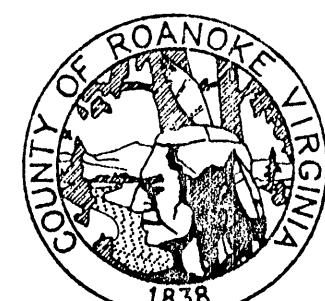

**ROANOKE COUNTY
WATER TREATMENT
FACILITY**

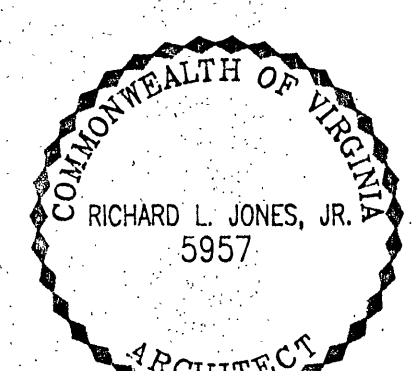

WINDOW AND ENTRY ELEVATIONS

PROJECT ARCHITECT
RLJ JR

COMMISSION NUMBER
1913

TECHNICIAN
RWT

DATE
22 SEPT 1994

B20

JONES & JONES ASSOCIATES / ARCHITECTS PC