




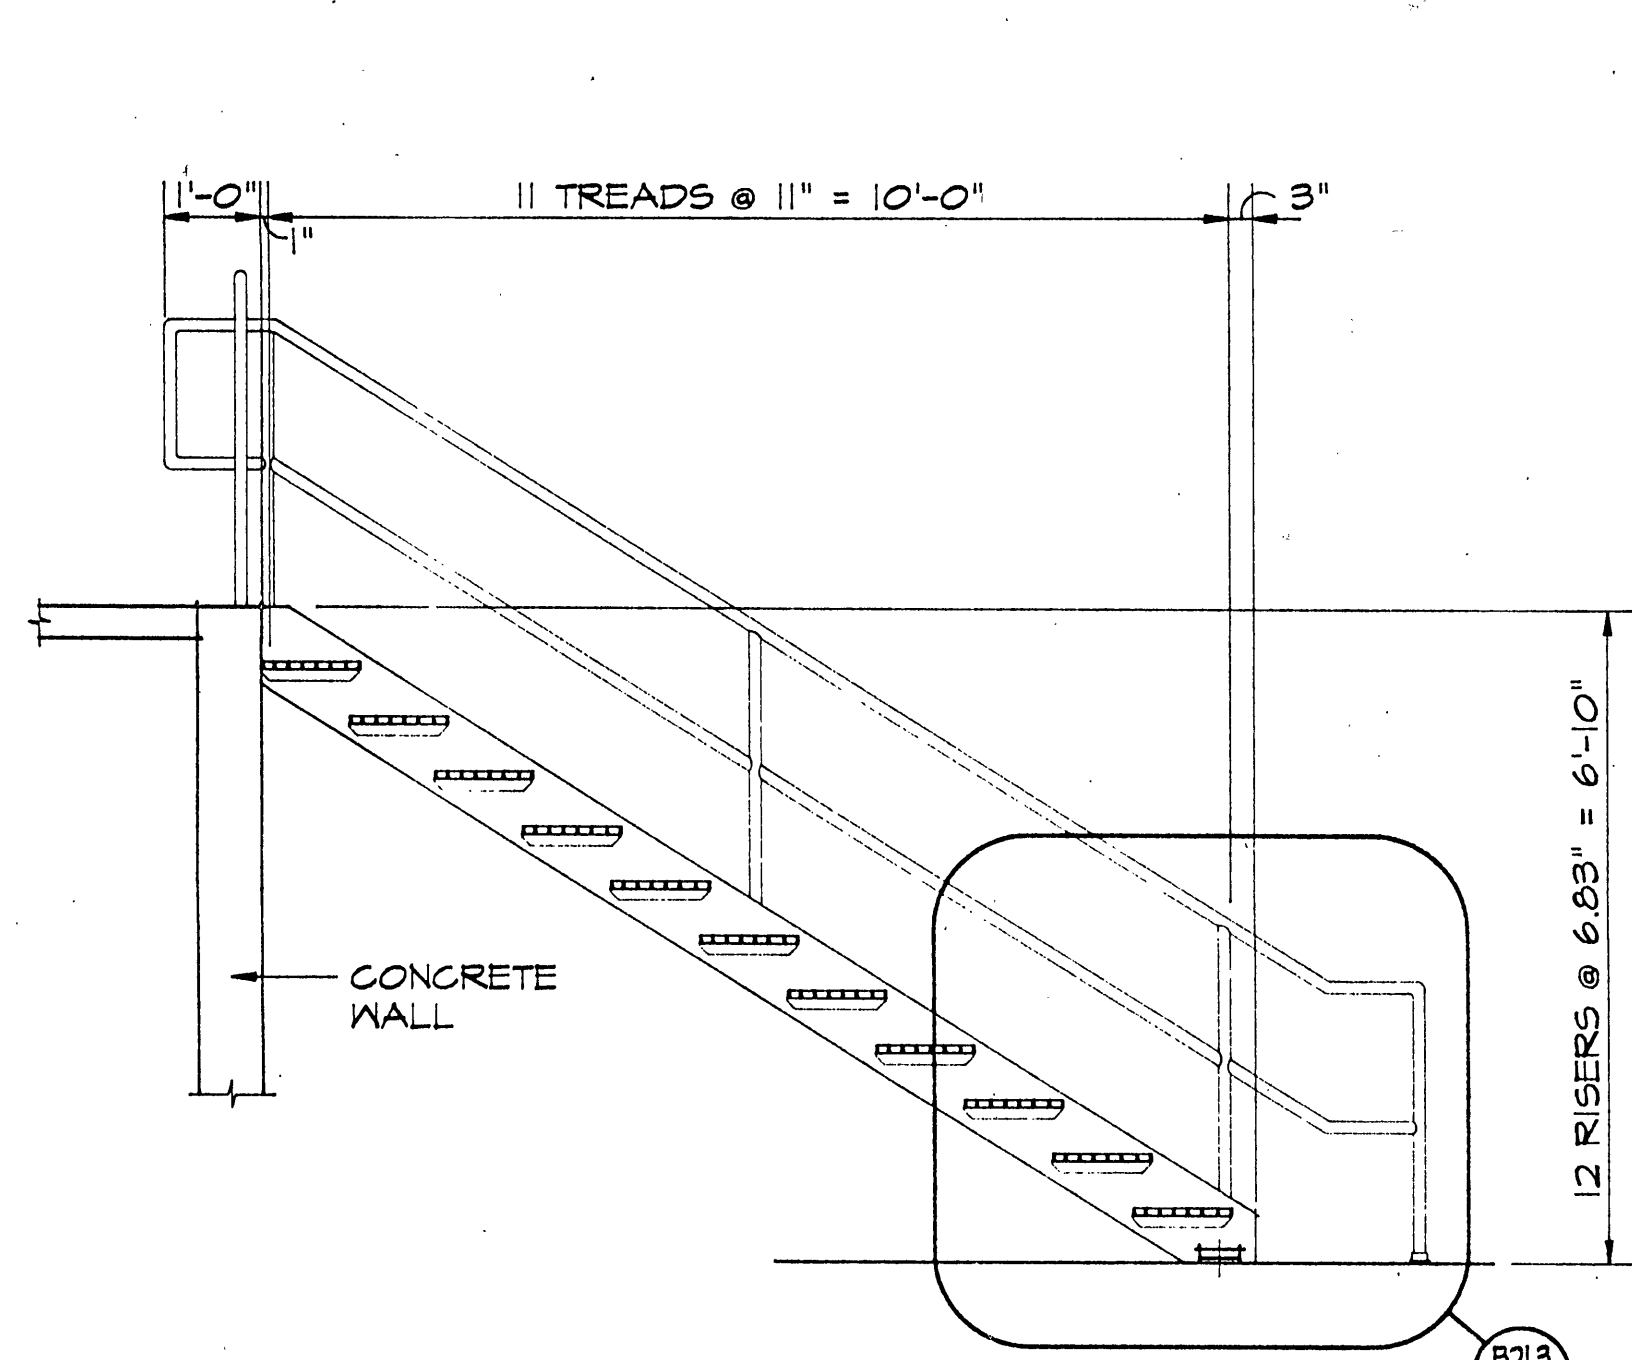


STAIR SECTION
SCALE 1/2" = 1'-0"

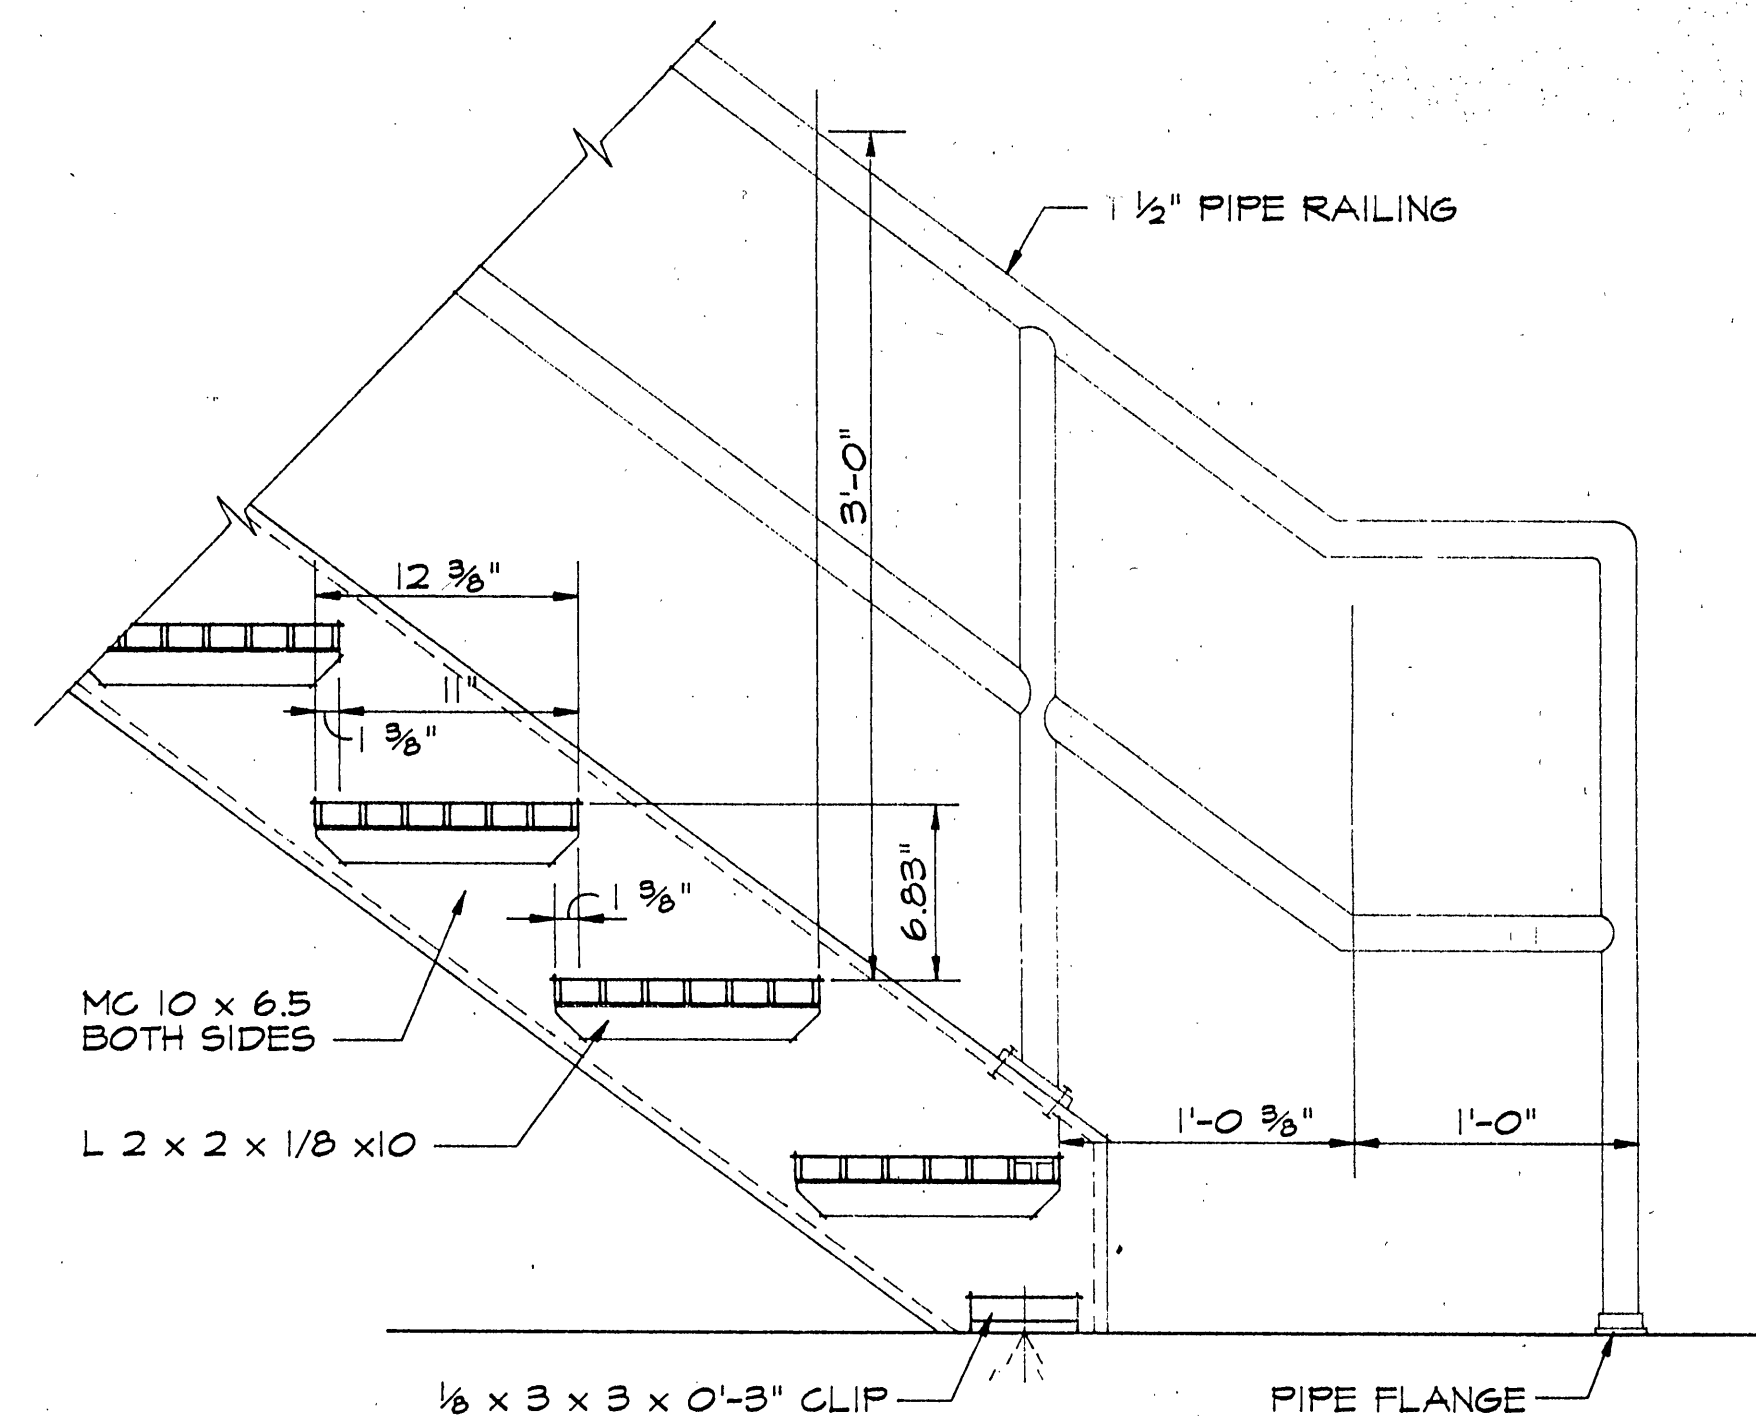

SECTION - TYPICAL STAIR CONSTRUCTION
SCALE 1/2" = 1'-0"

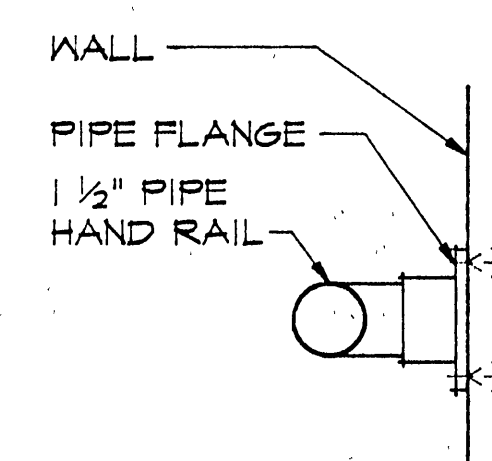


TYPICAL WALL RAILING
SCALE 3" = 1'-0"

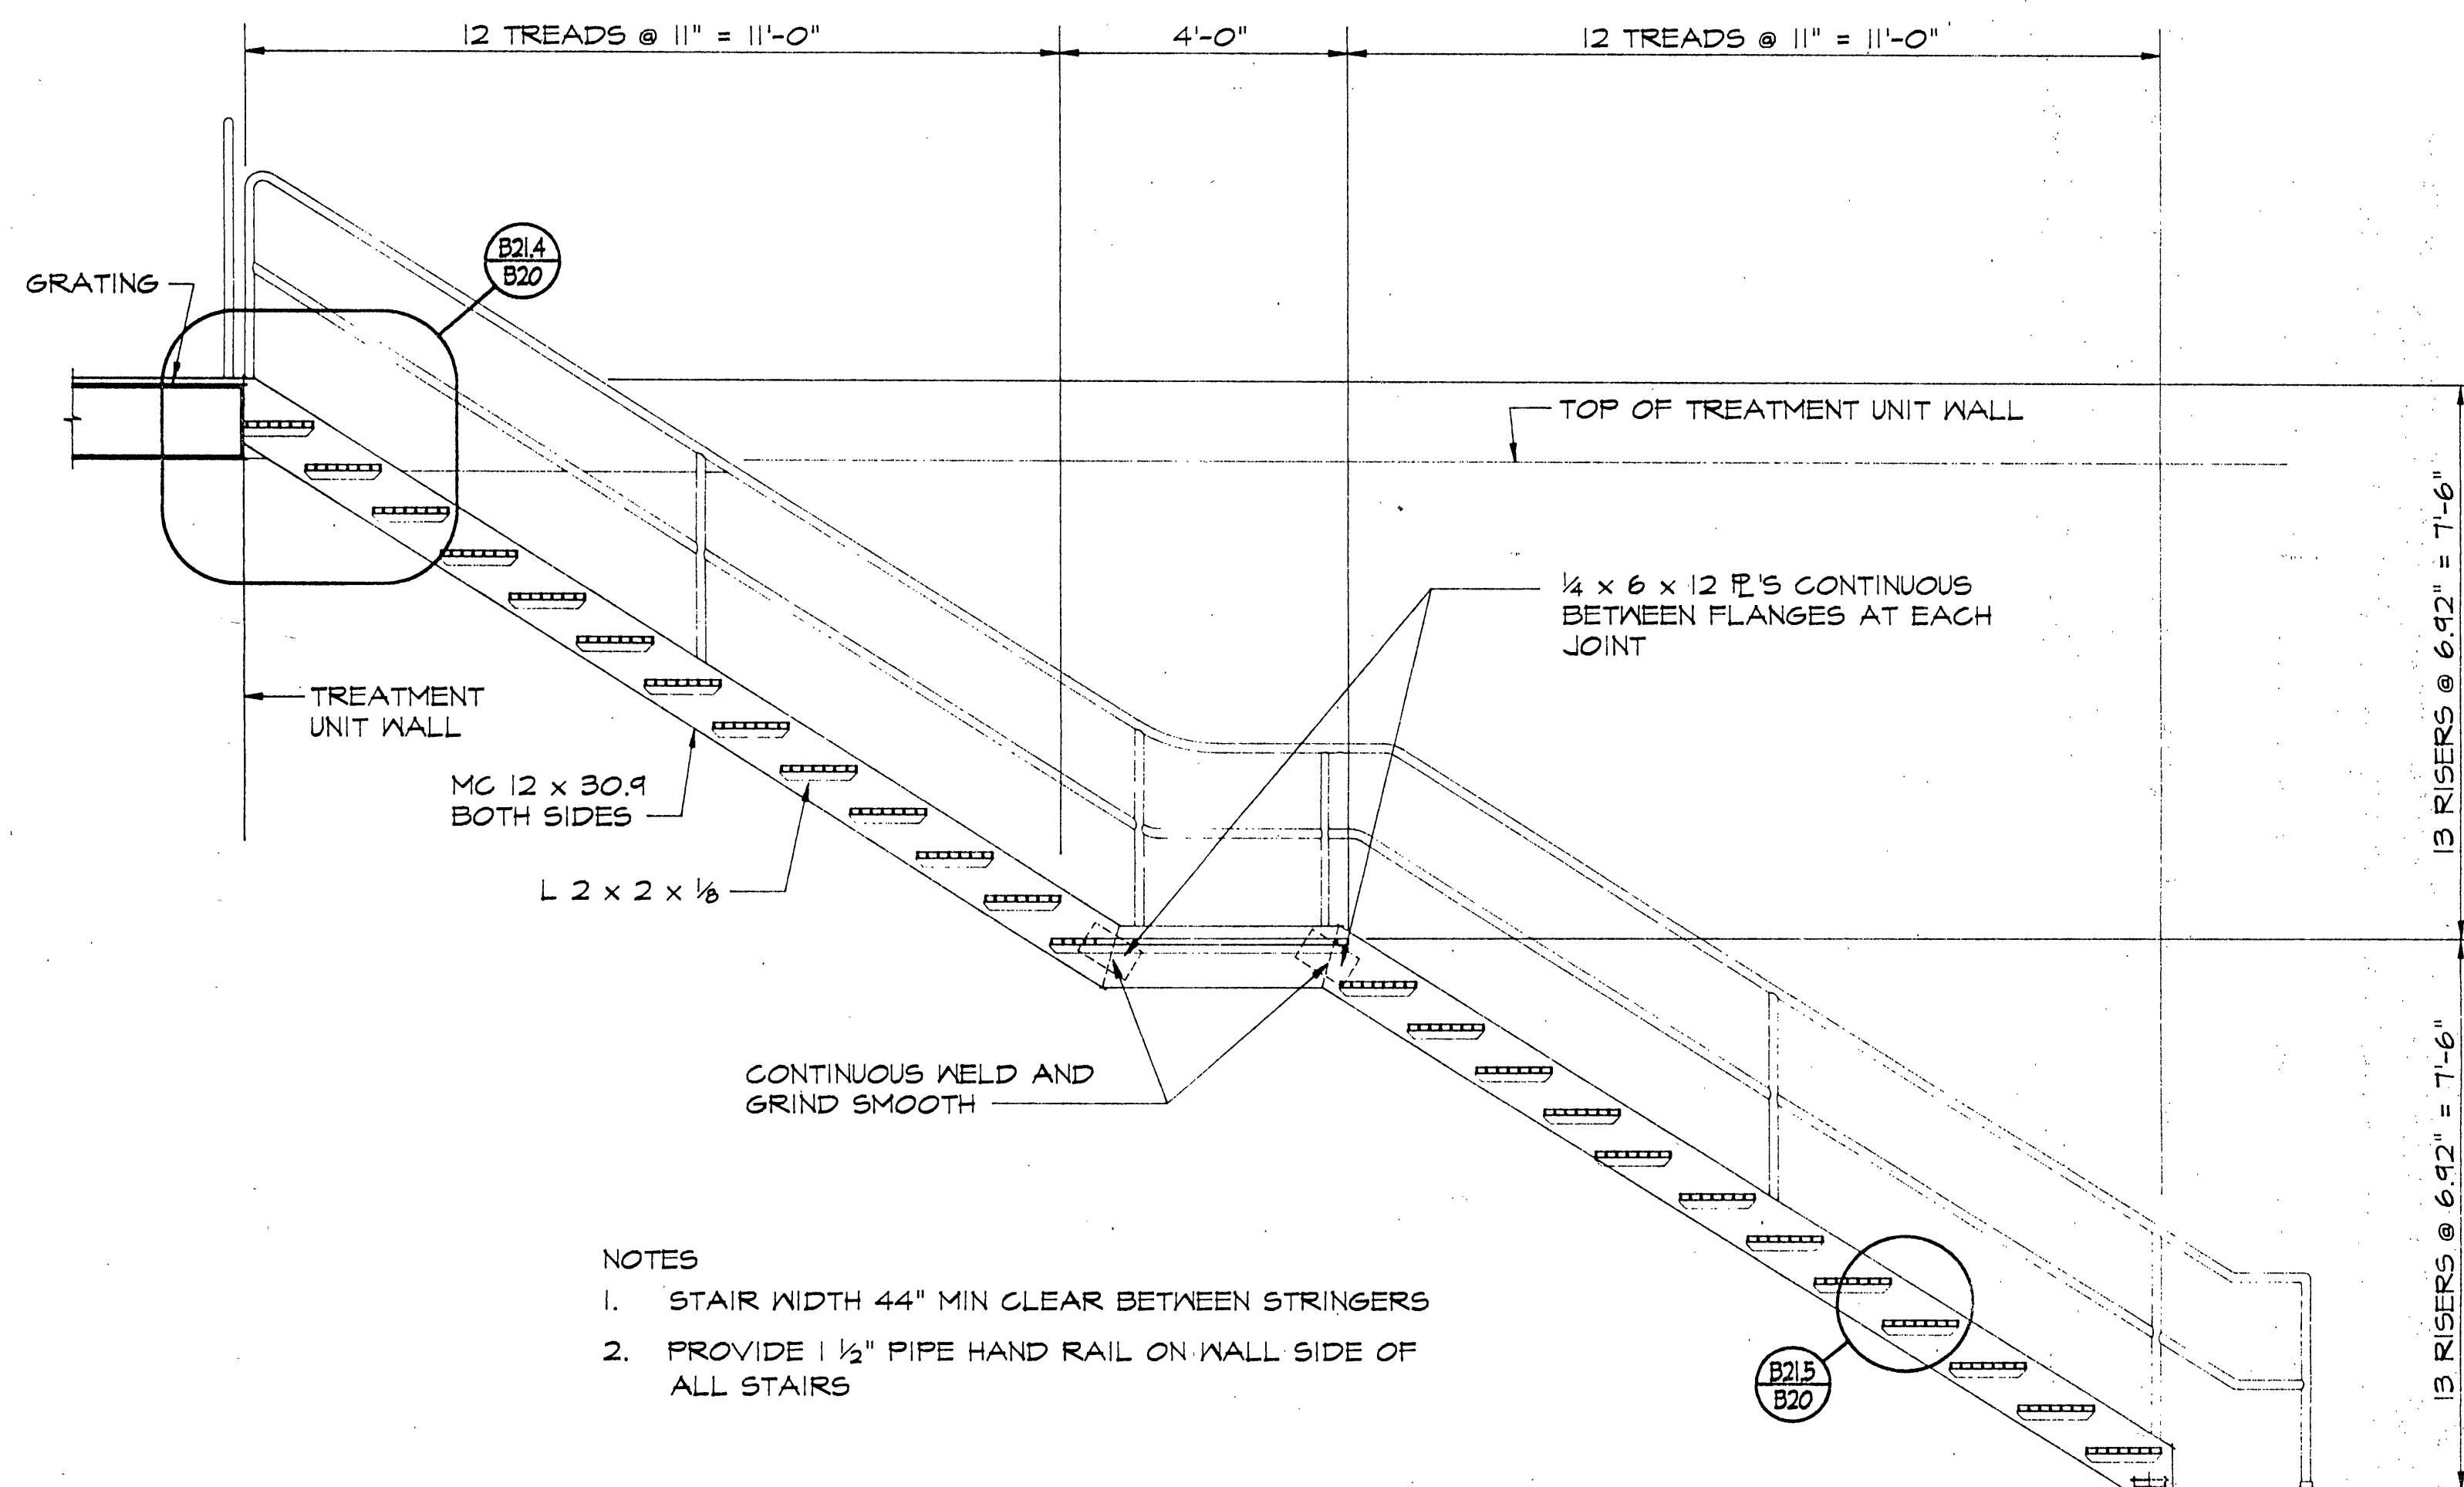


STAIR SECTION
SCALE 1/2" = 1'-0"

- NOTES
1. STAIR WIDTH 44" MIN CLEAR BETWEEN STRINGERS
 2. PROVIDE 1 1/2" PIPE HAND RAIL ON WALL SIDE OF ALL STAIRS


SECTION
SCALE 1/2" = 1'-0"

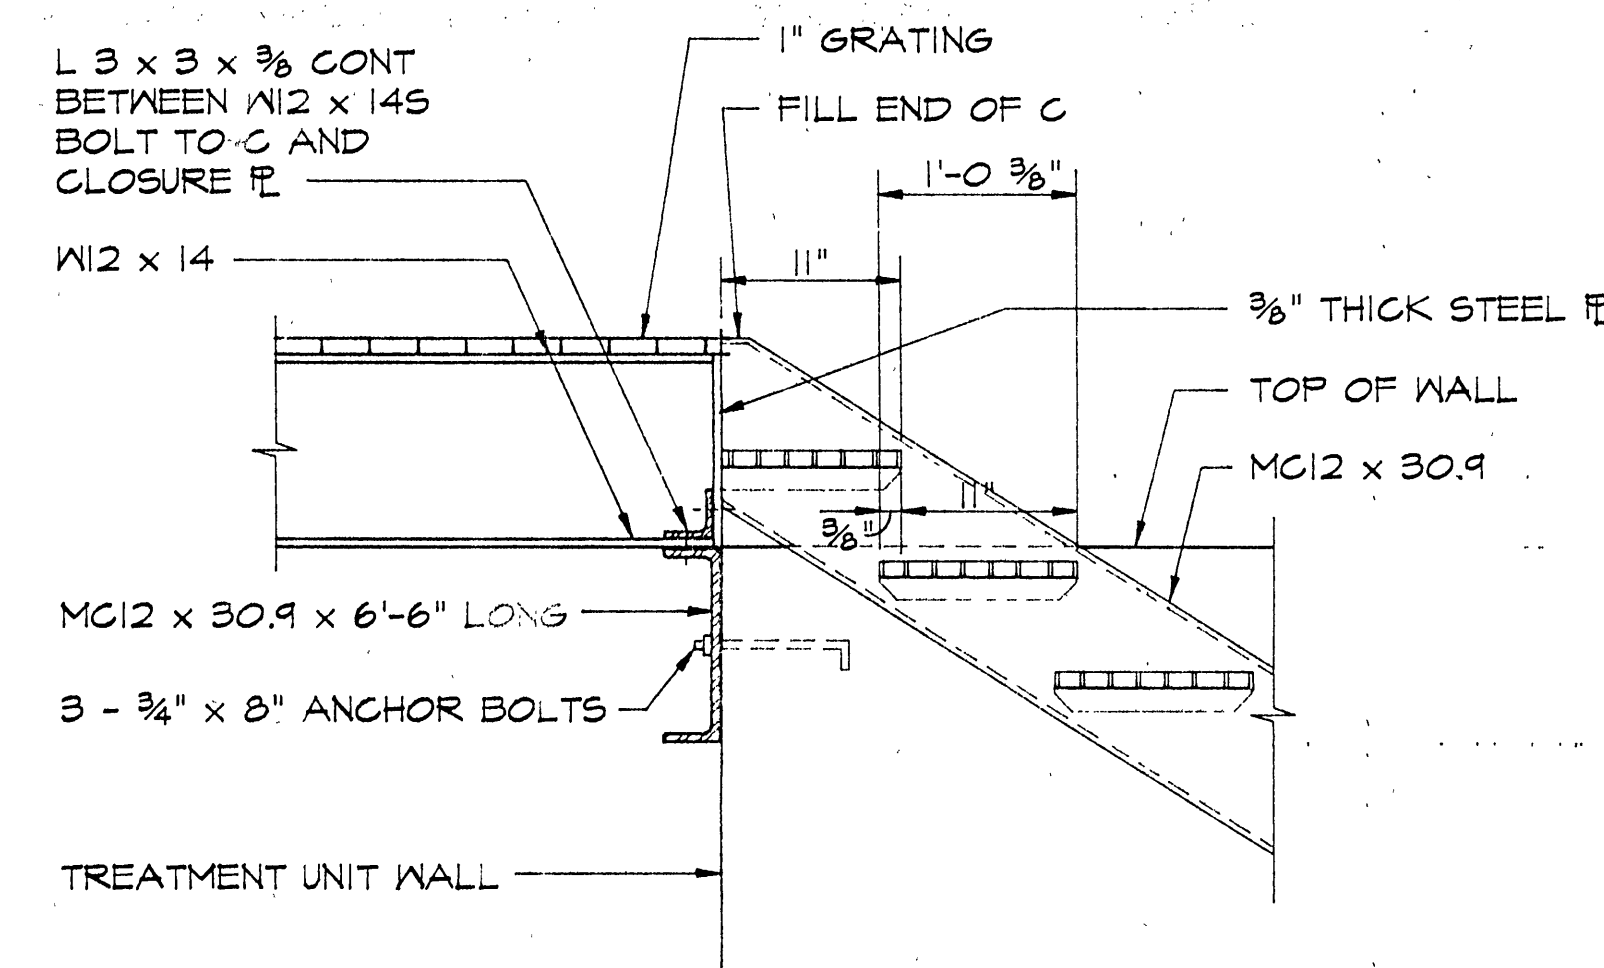


SECTION
SCALE 1" = 1'-0"

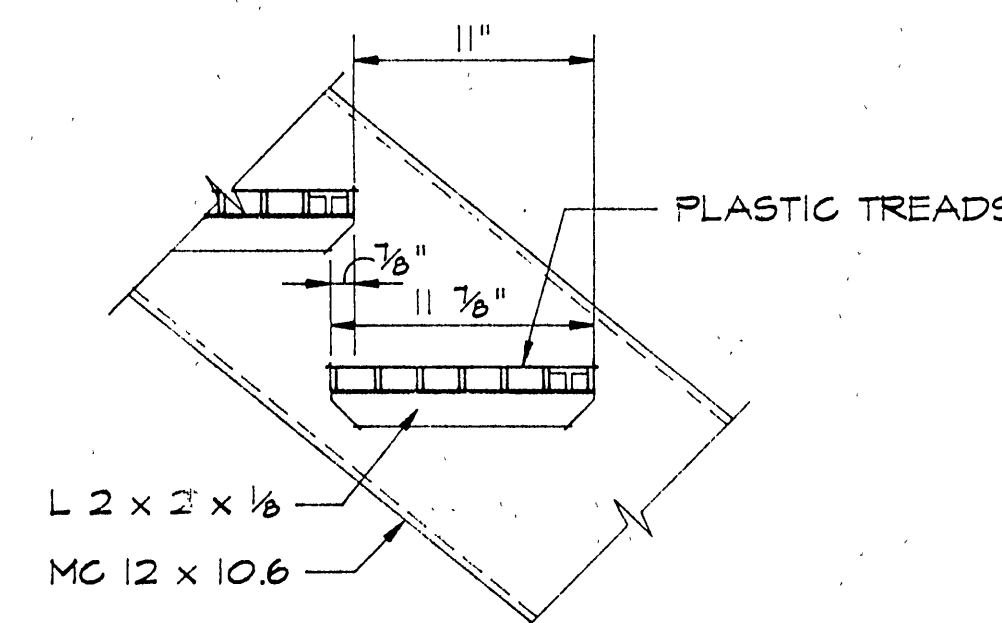

SECTION
SCALE 1/2" = 1'-0"

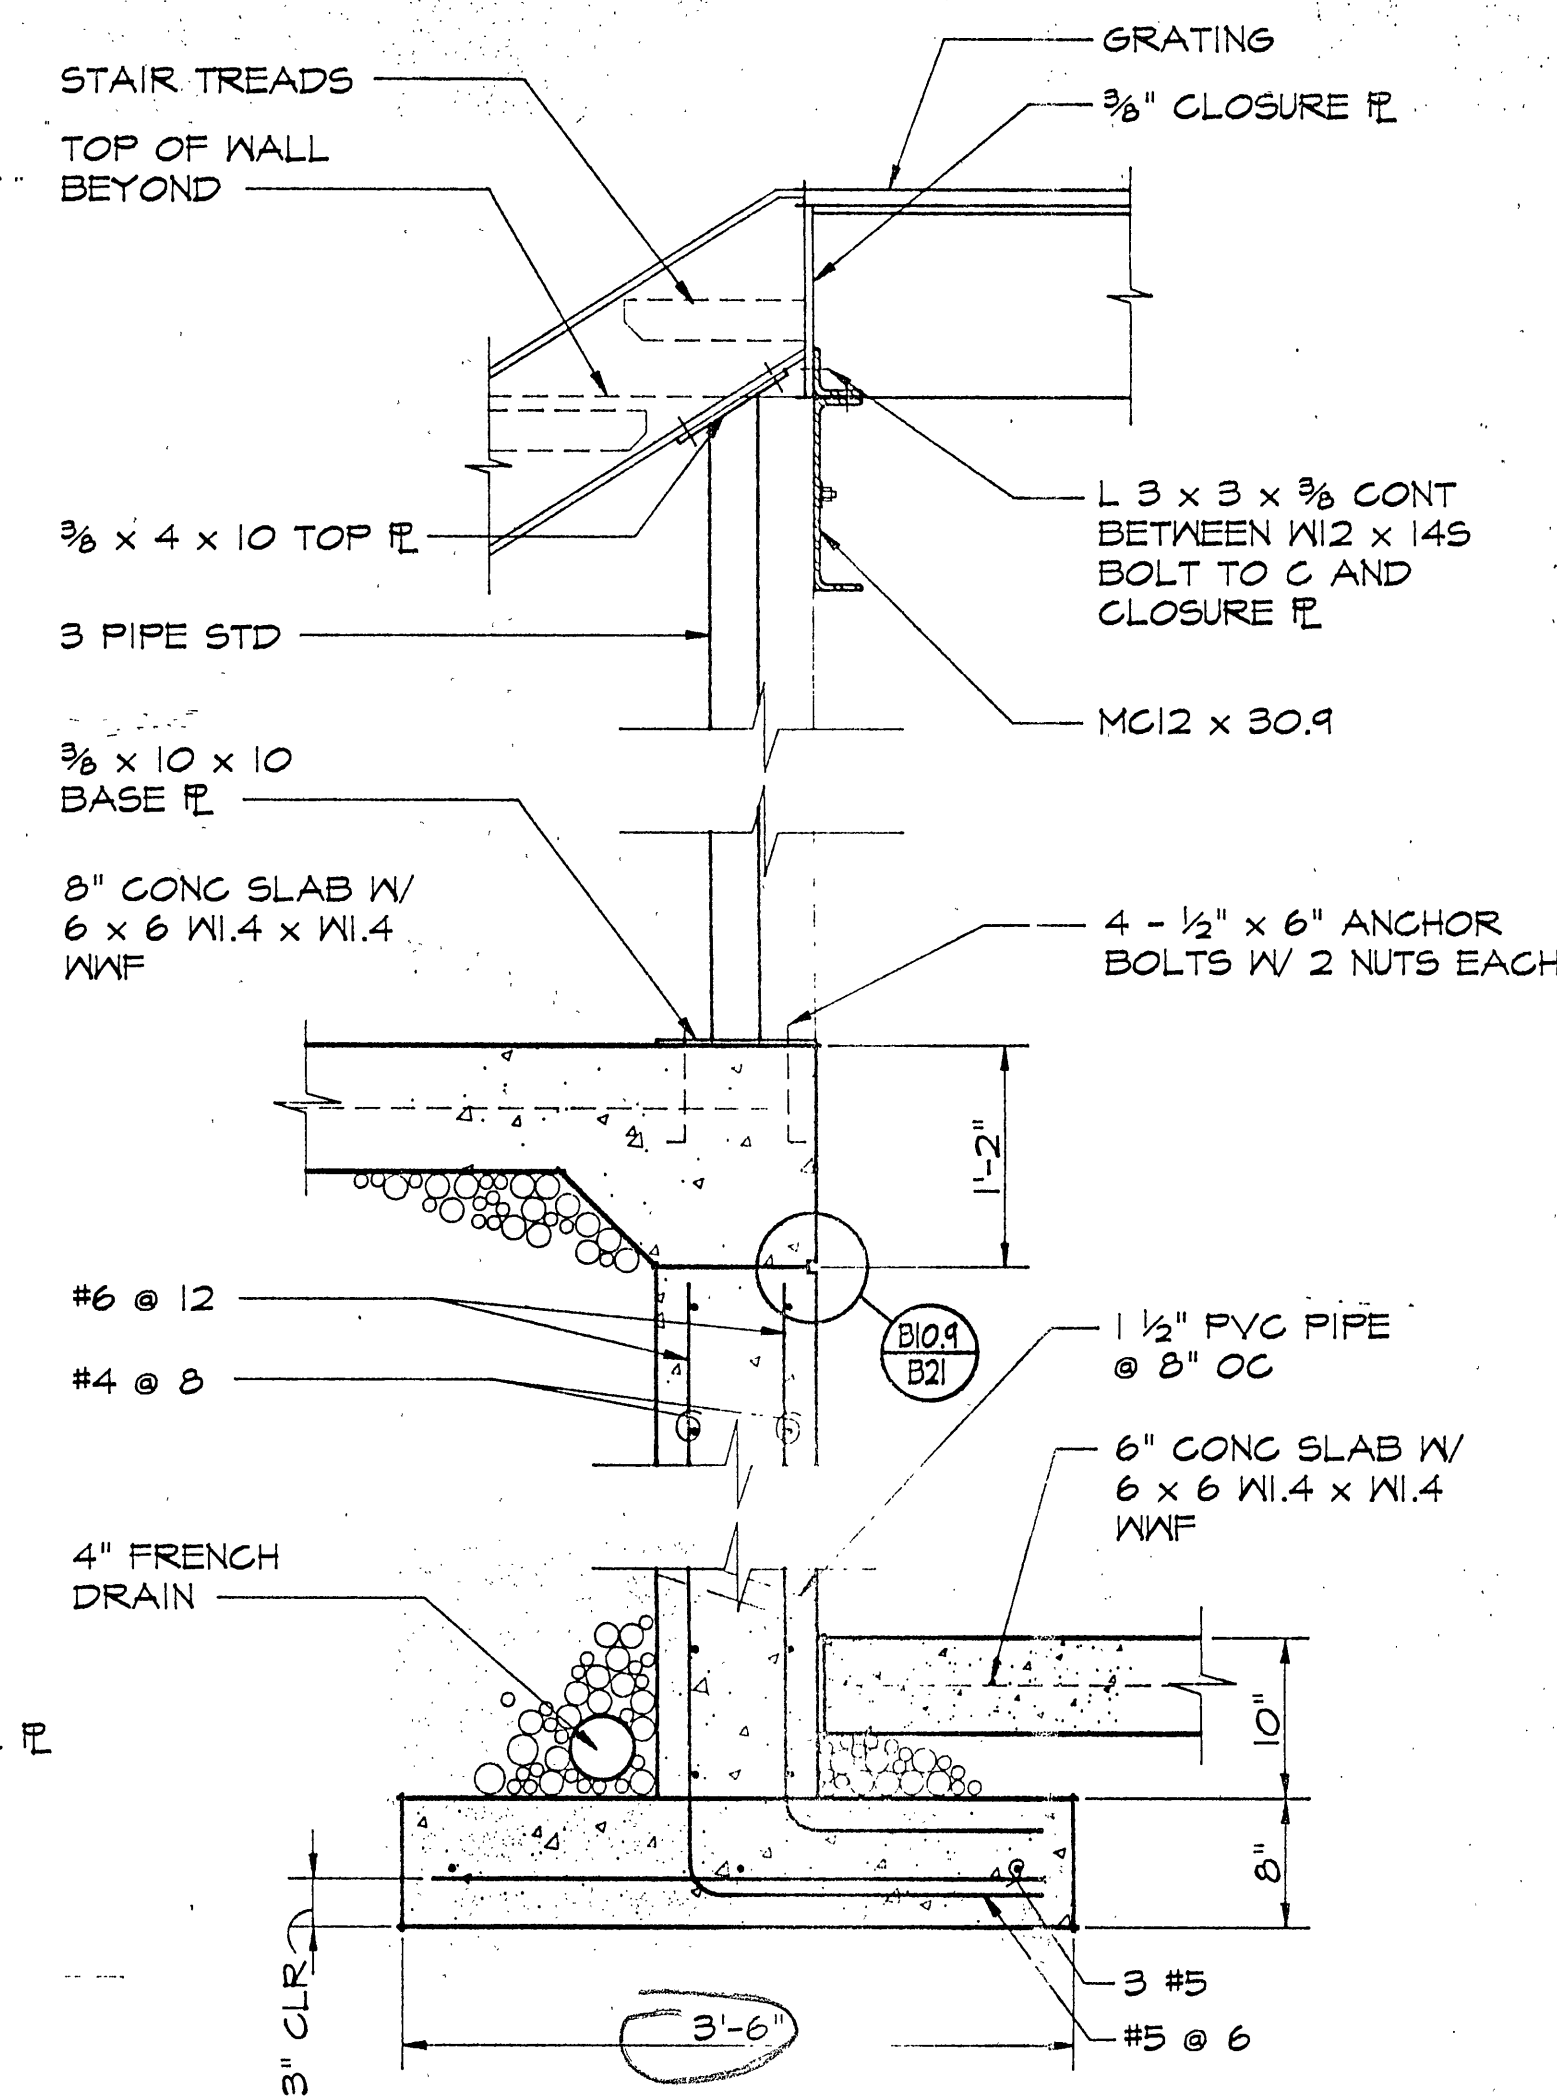


SECTION
SCALE 1" = 1'-0"

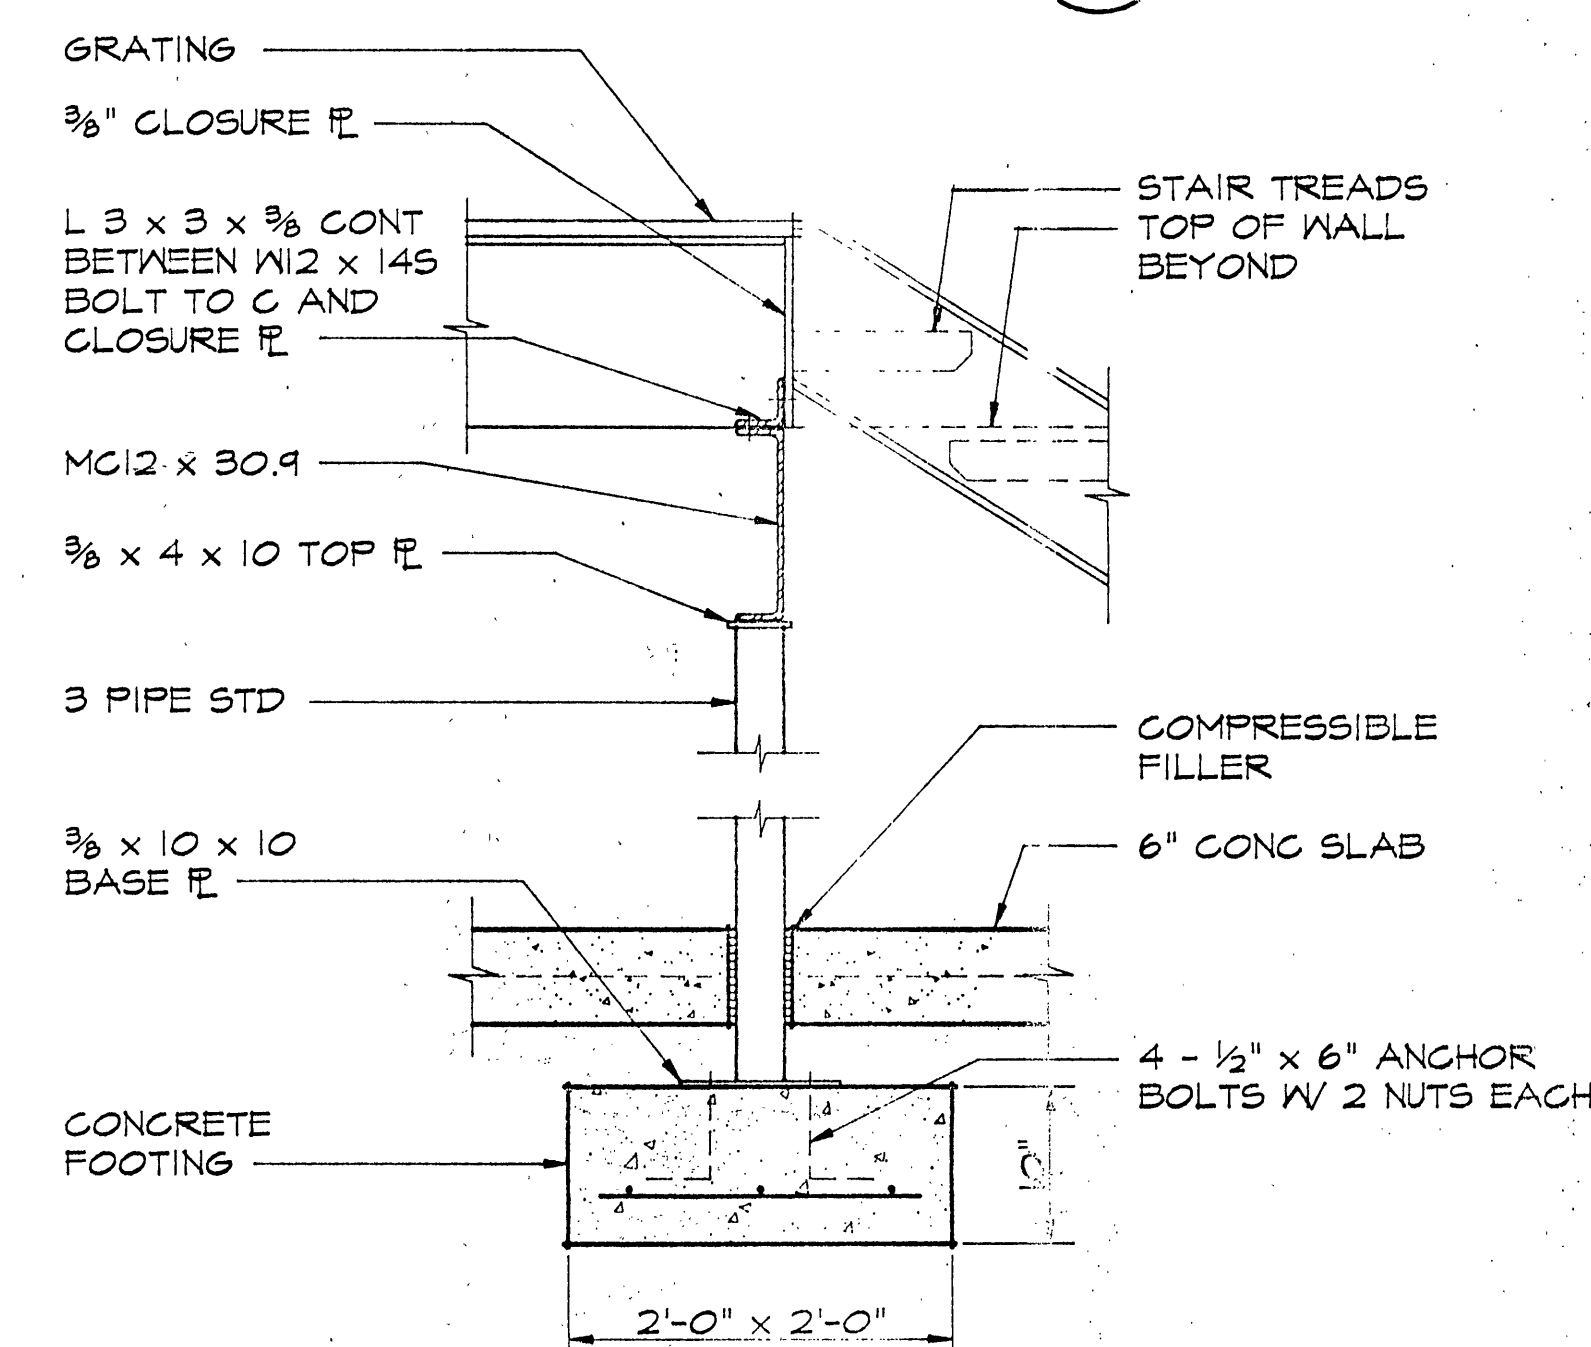


SECTION
SCALE 1" = 1'-0"

INSPECTOR'S AS-BUILTS 1995

WWW.ID# 6LDLWZ

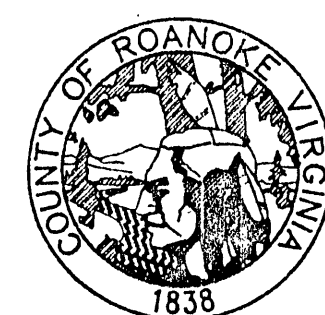

**ROANOKE COUNTY
WATER TREATMENT
FACILITY**

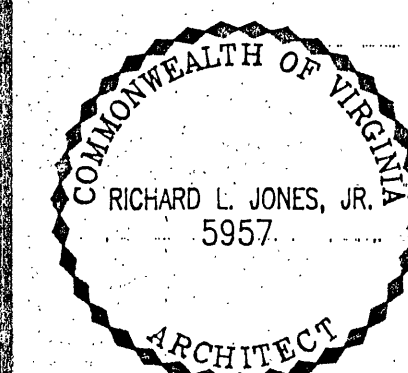

STAIR SECTIONS

PROJECT ARCHITECT
RLJ JR

COMMISSION NUMBER
1913

TECHNICIAN
RAT

DATE
22 SEPT 1994

B21