


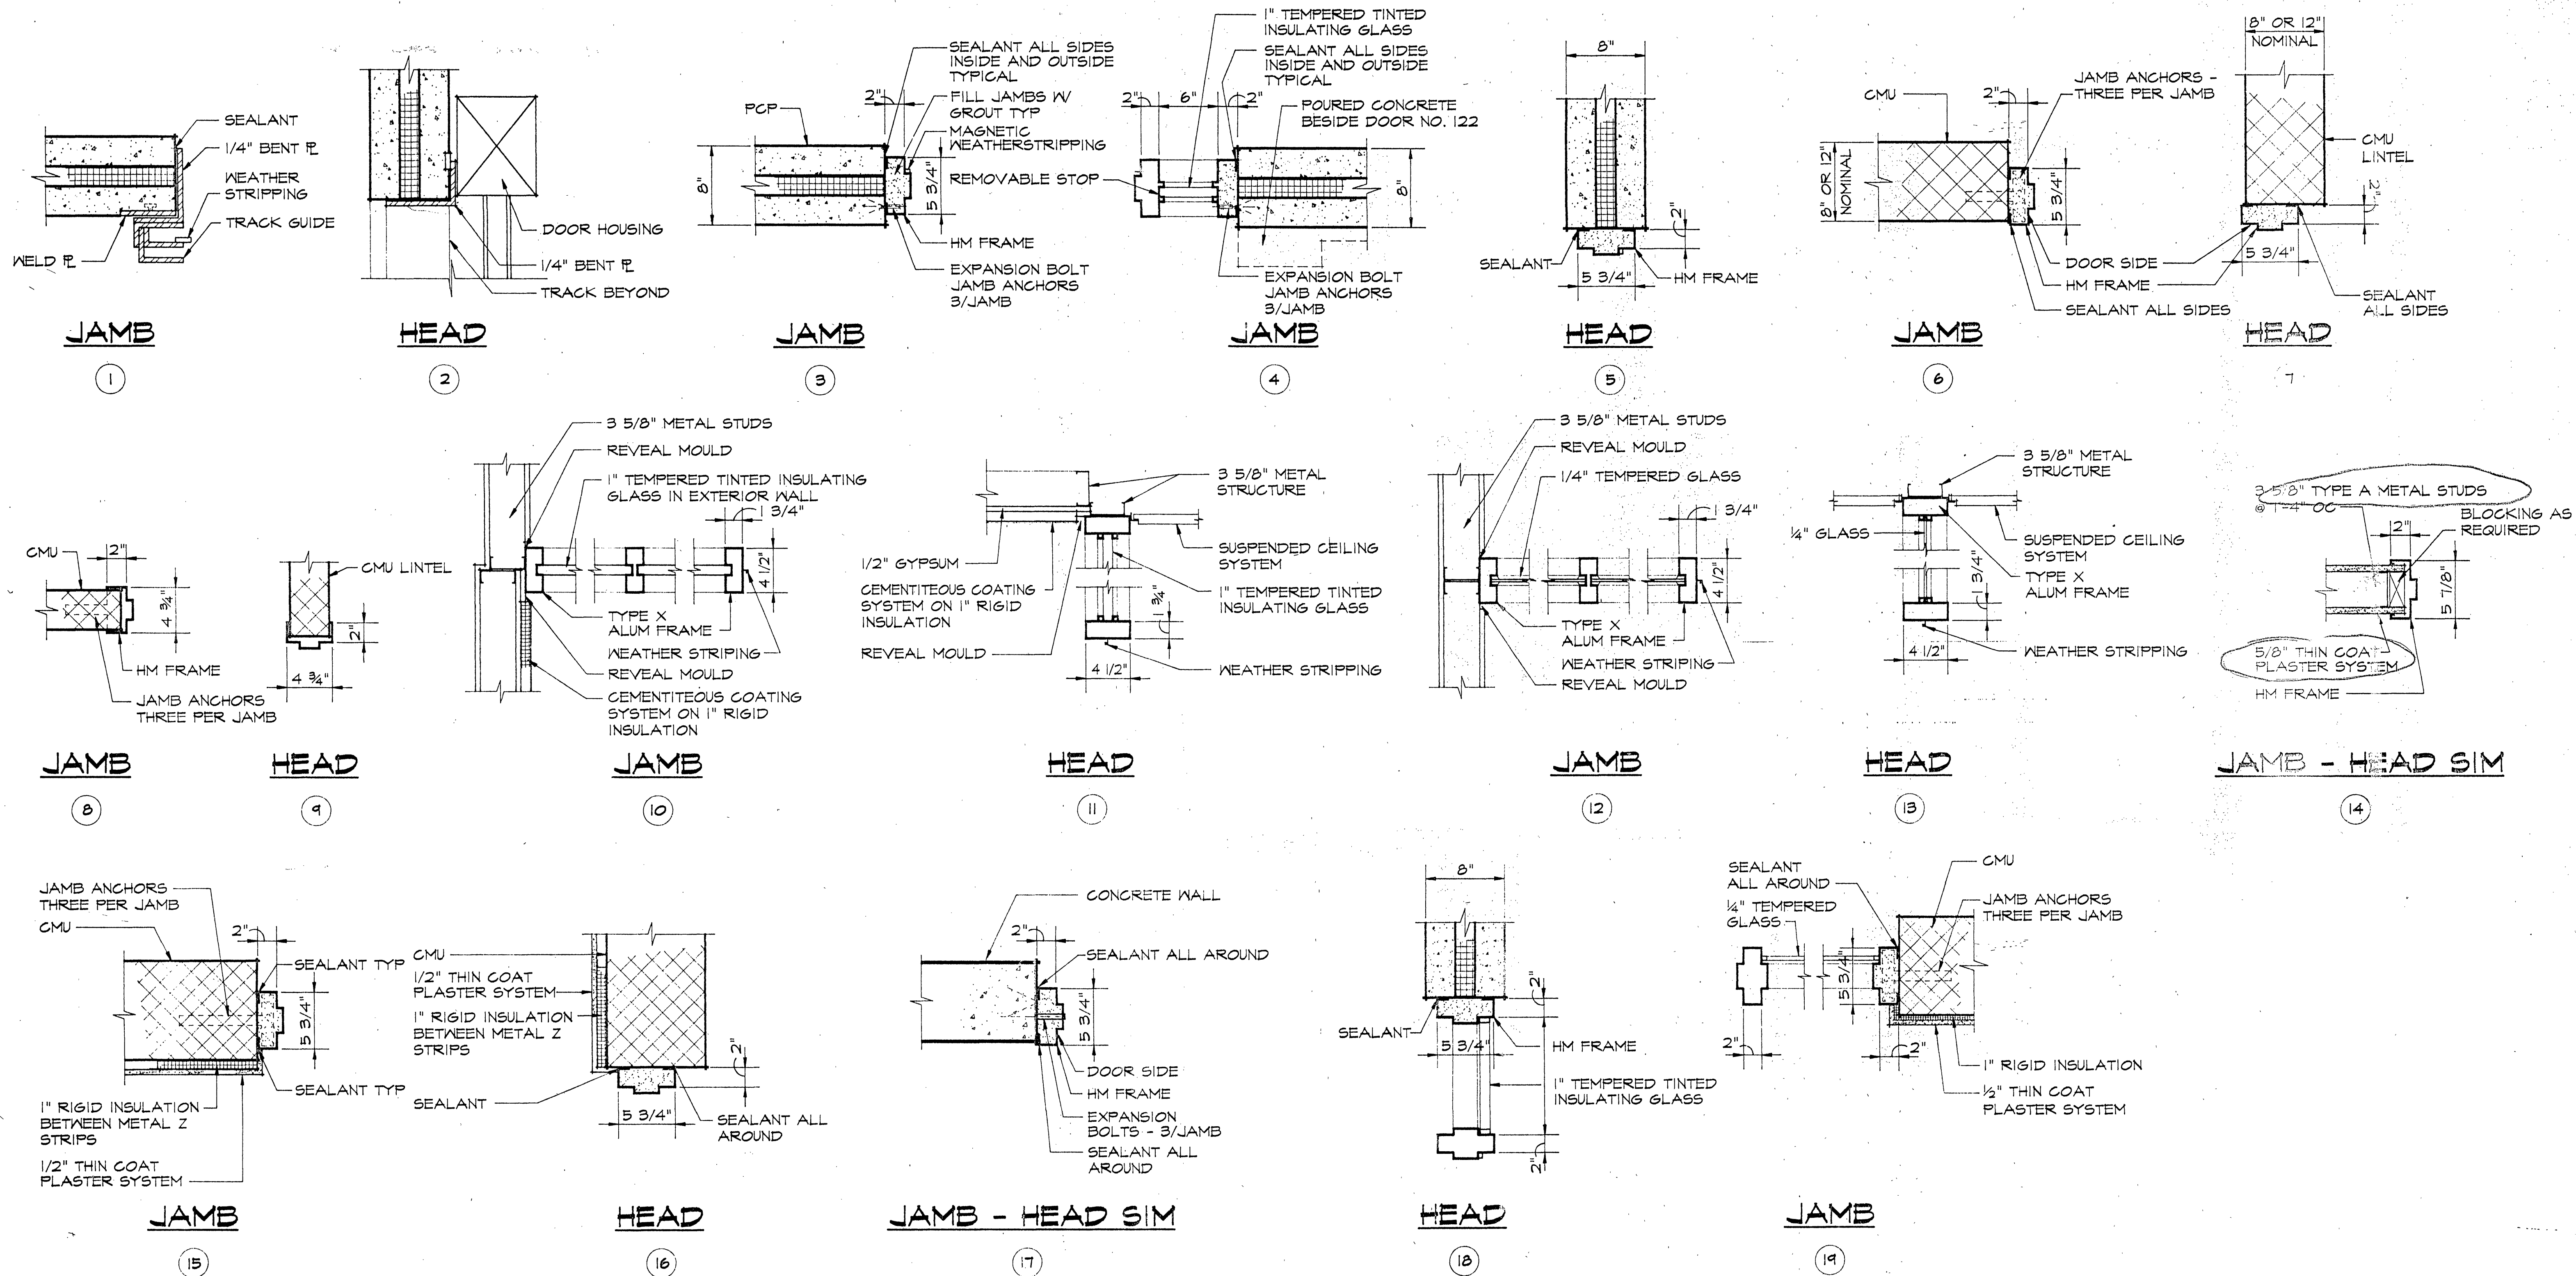


# FRAME TYPES


- NOTES**  
1. FILL ALL FRAMES WITH GROUT  
2. EACH JAMB SIDE SHALL HAVE A MINIMUM OF THREE ANCHORS

INSPECTOR'S AS-BUILTS 1995

WWW ID# 8DLUZ

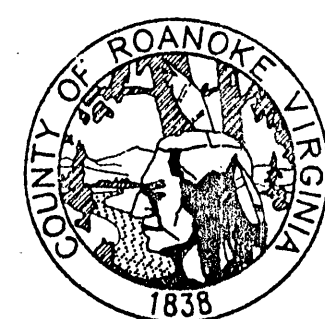

## ROANOKE COUNTY WATER TREATMENT FACILITY

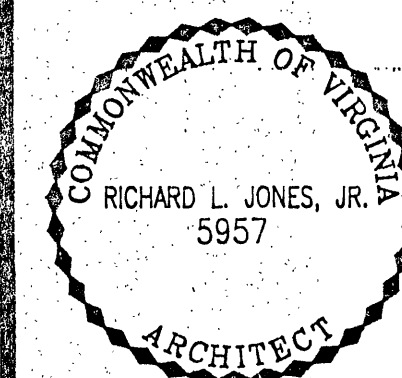

### FRAME TYPES

PROJECT ARCHITECT  
RLJ JR

COMMISSION NUMBER  
913

TECHNICIAN  
RWT

DATE  
22 SEPT 1994

B23