



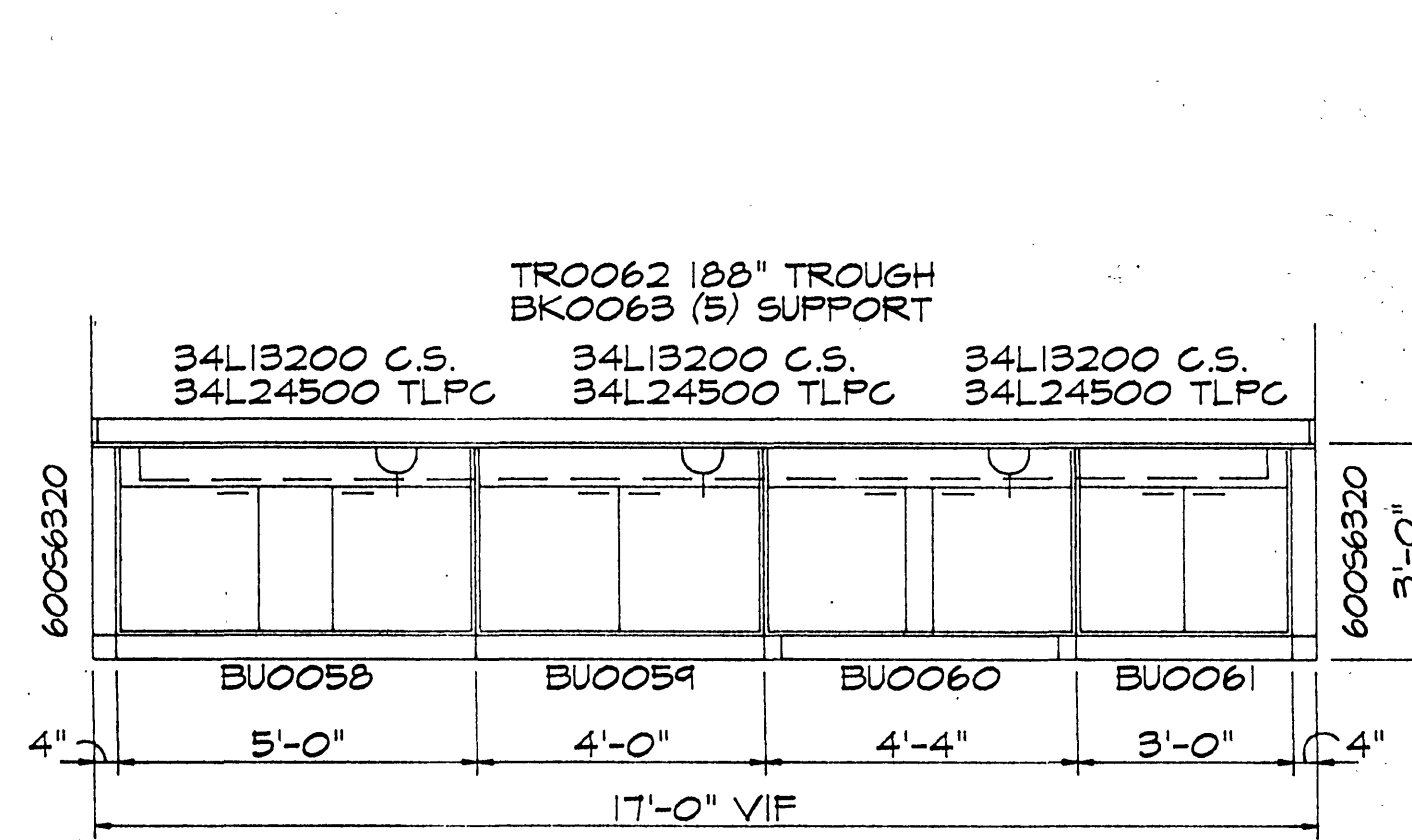


ELEVATION
SCALE 3/8" = 1'-0"

B24.1
B3

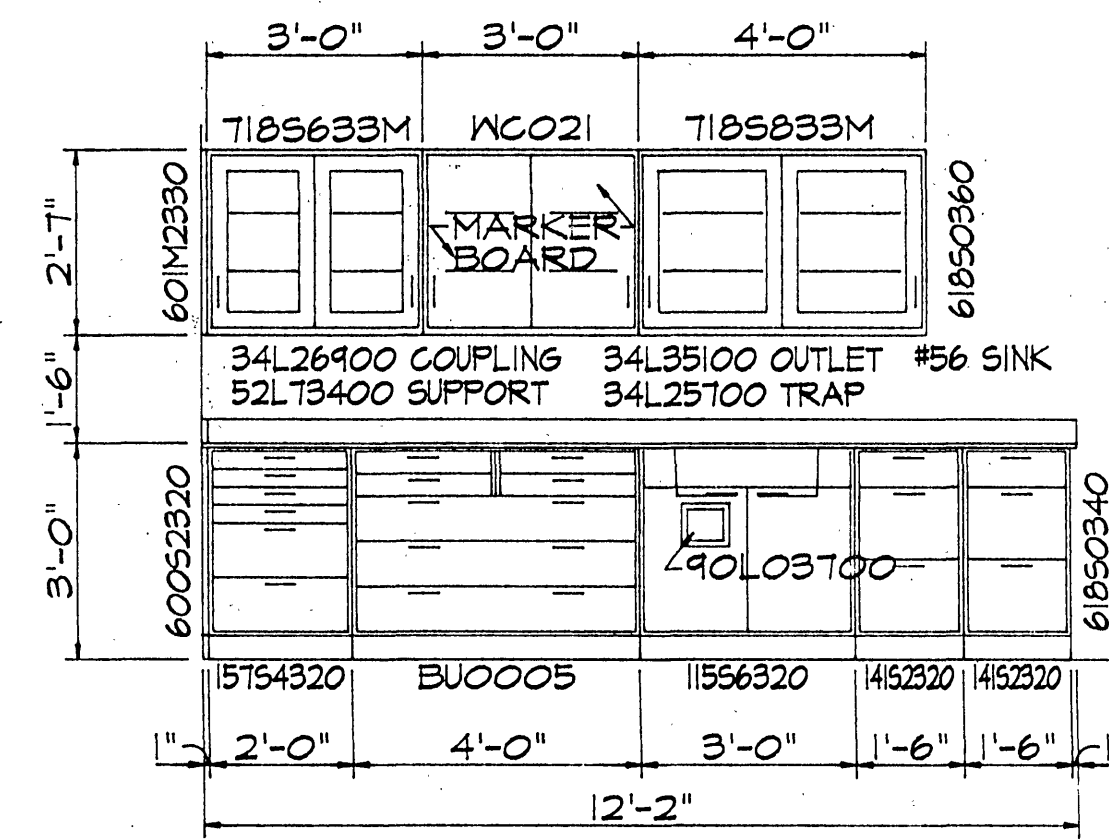


ELEVATION
SCALE 3/8" = 1'-0"

B24.2
B3

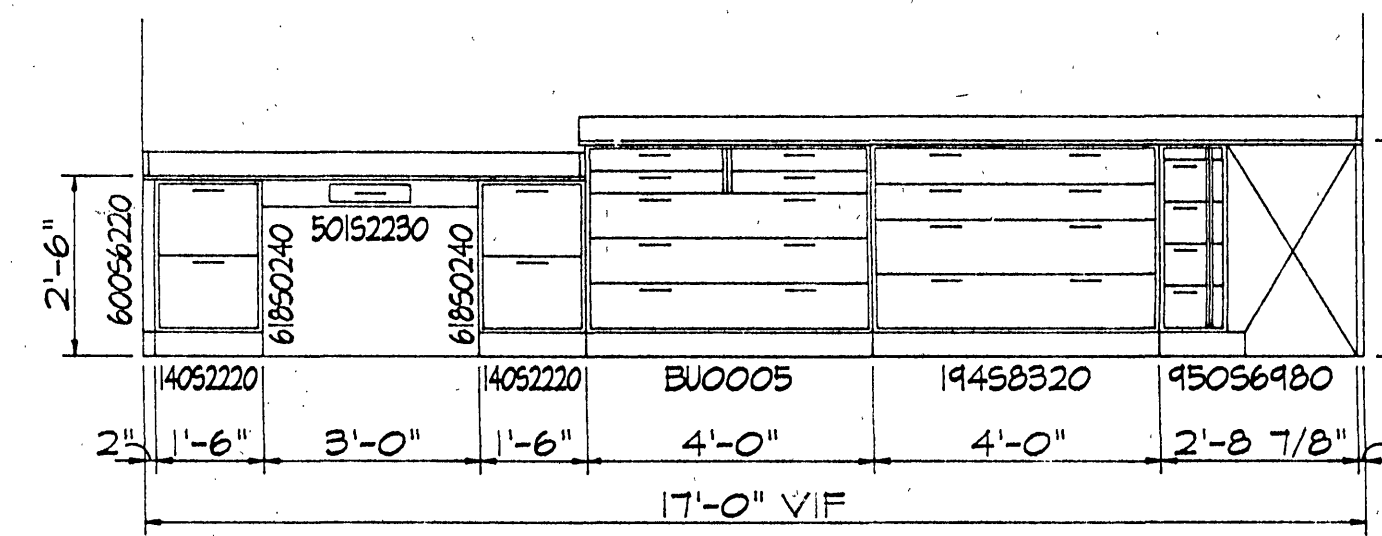


ELEVATION
SCALE 3/8" = 1'-0"

B24.3
B3

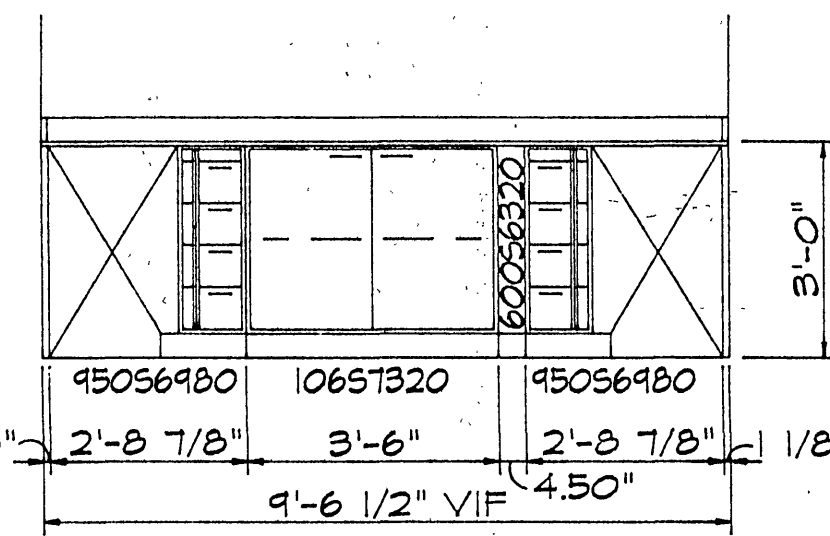


ELEVATION
SCALE 3/8" = 1'-0"

B24.4
B3

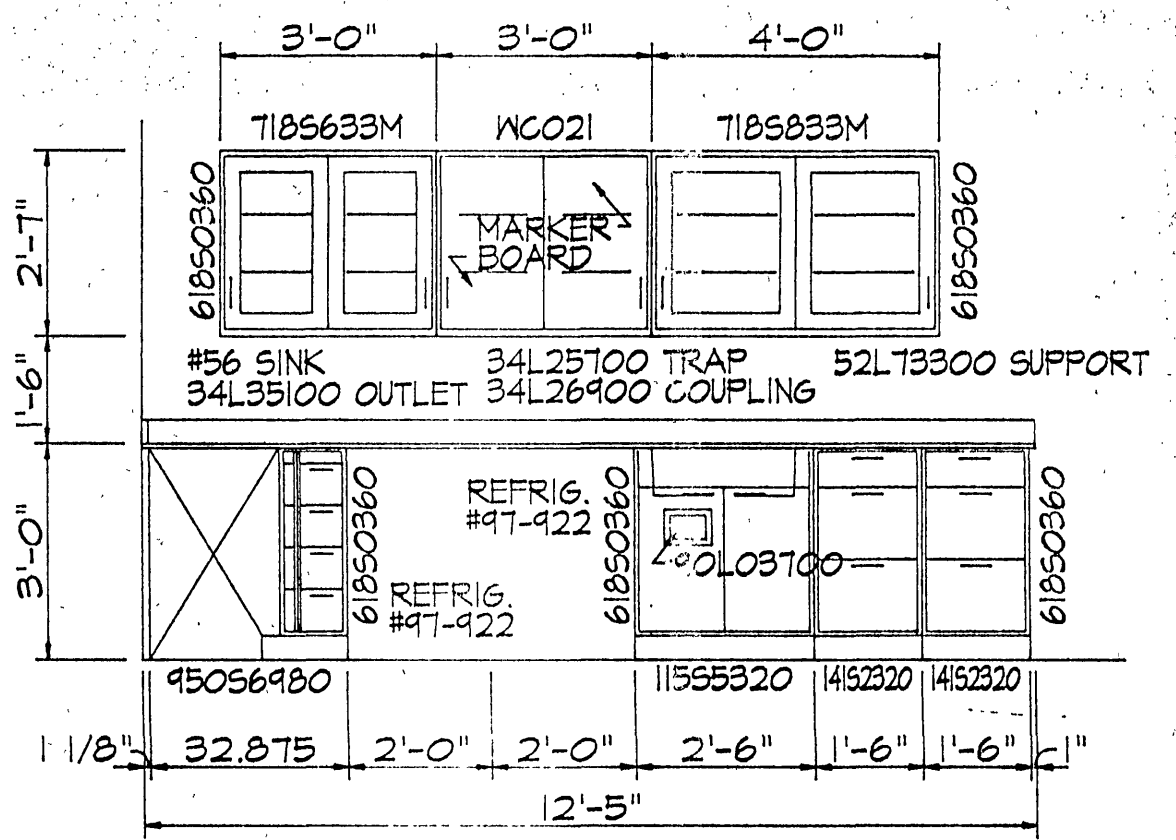


ELEVATION
SCALE 3/8" = 1'-0"

B24.5
B3

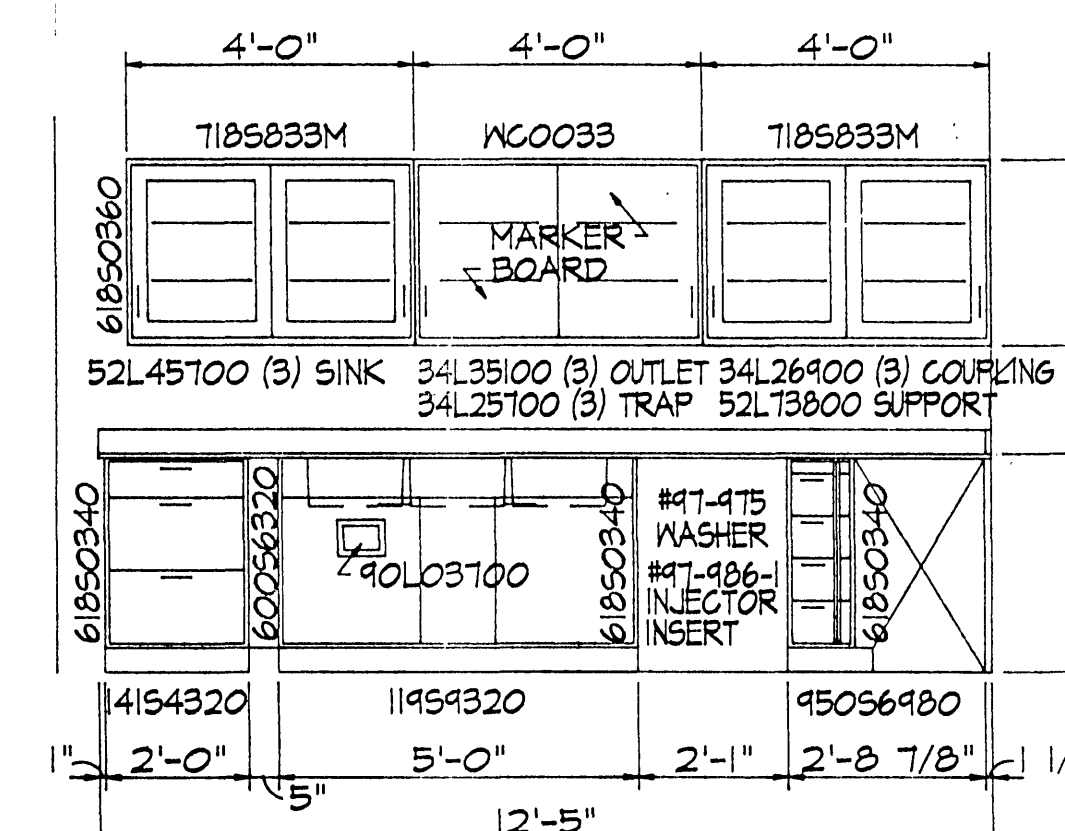


ELEVATION
SCALE 3/8" = 1'-0"

B24.6
B3

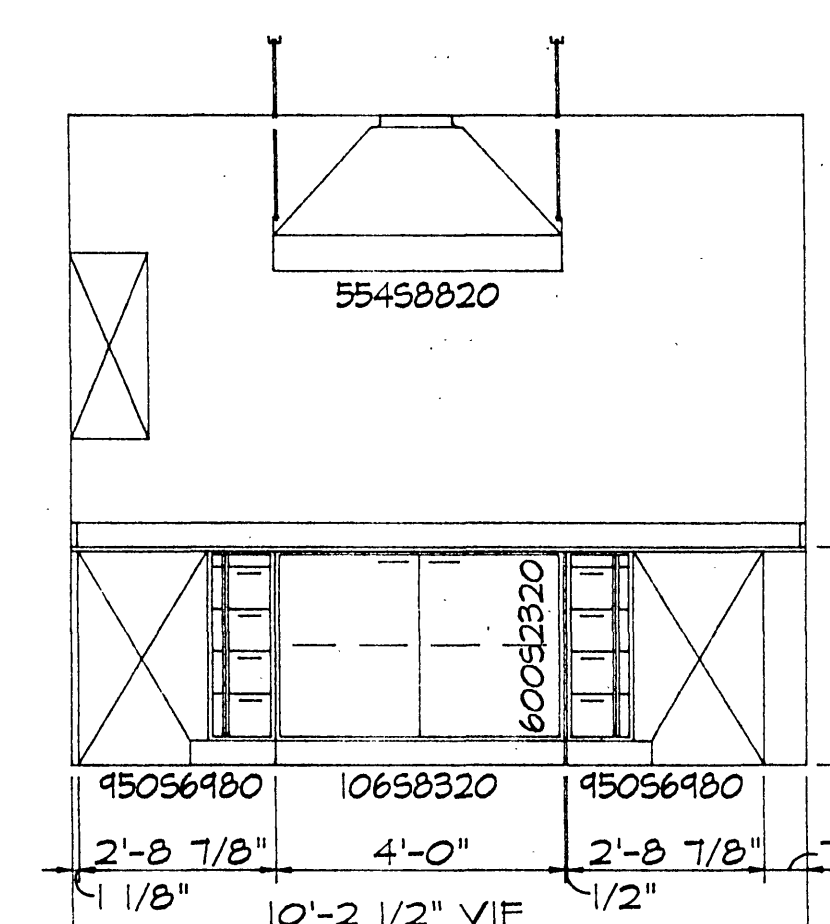


ELEVATION
SCALE 3/8" = 1'-0"

B24.7
B3

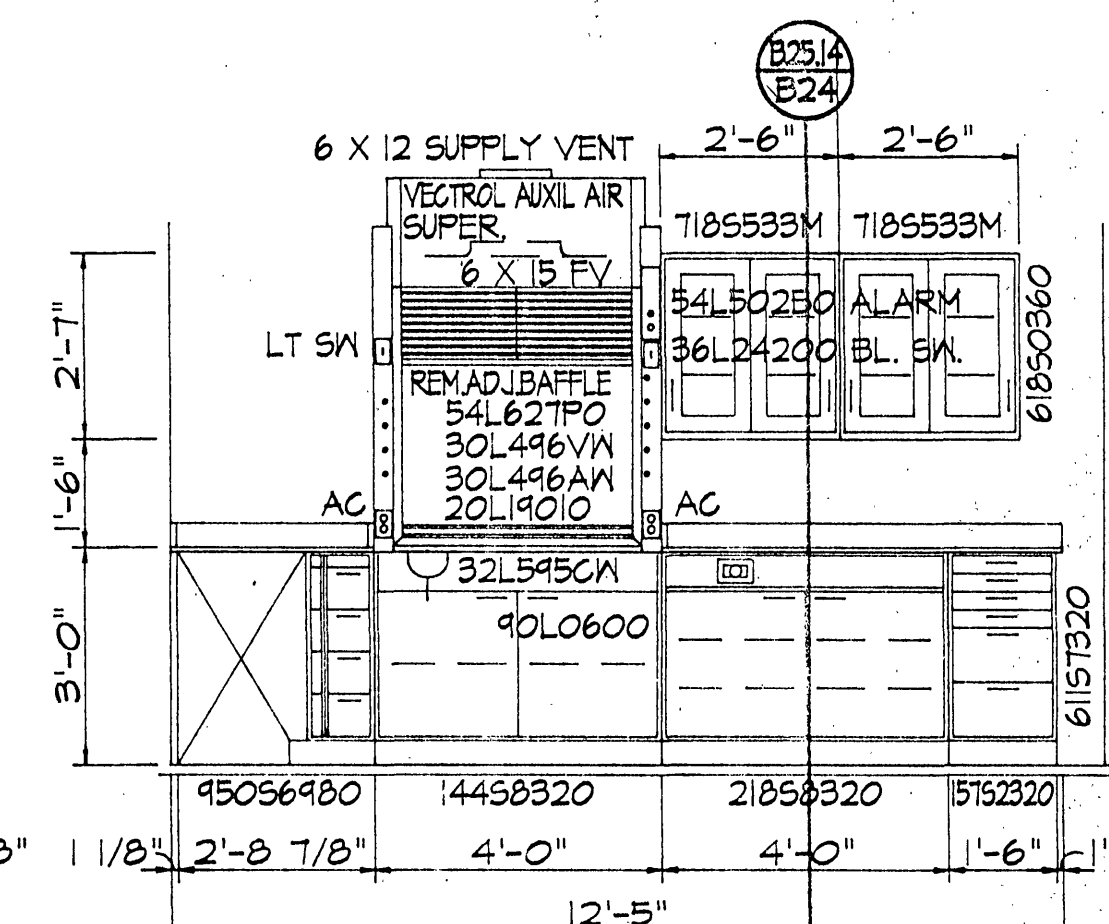


ELEVATION
SCALE 3/8" = 1'-0"

B24.8
B3

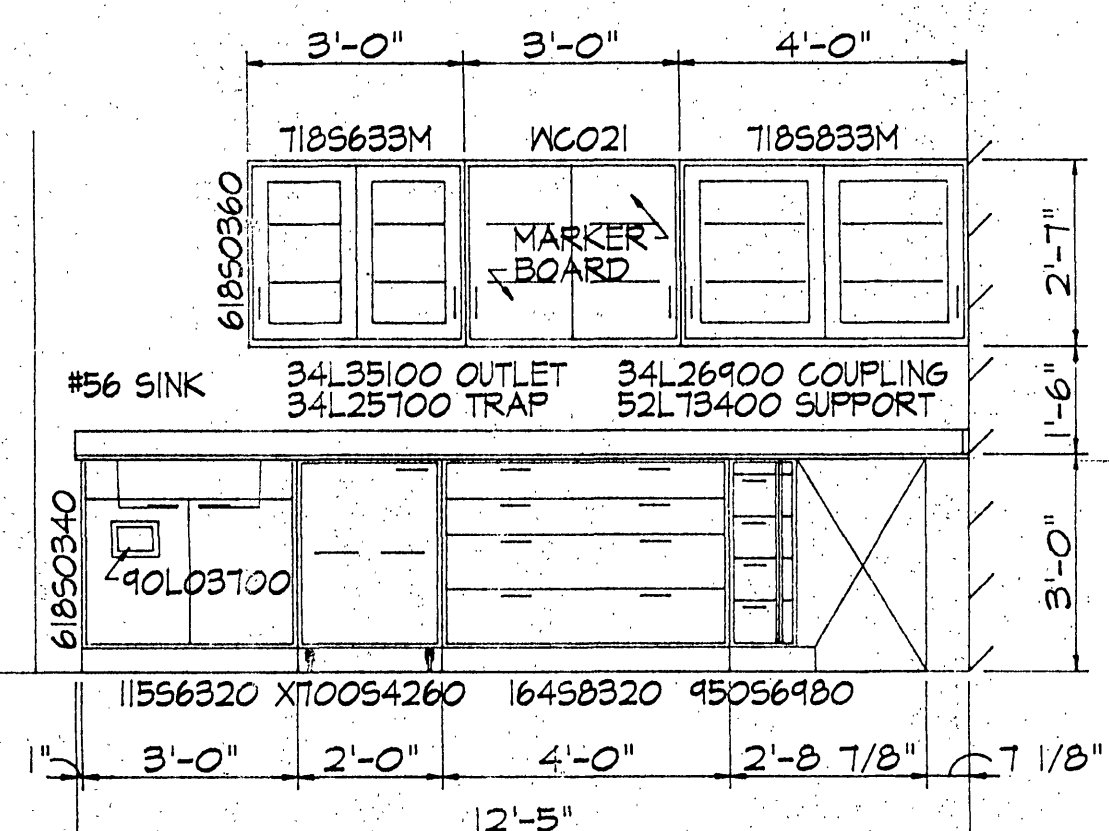


ELEVATION
SCALE 3/8" = 1'-0"

B24.9
B3

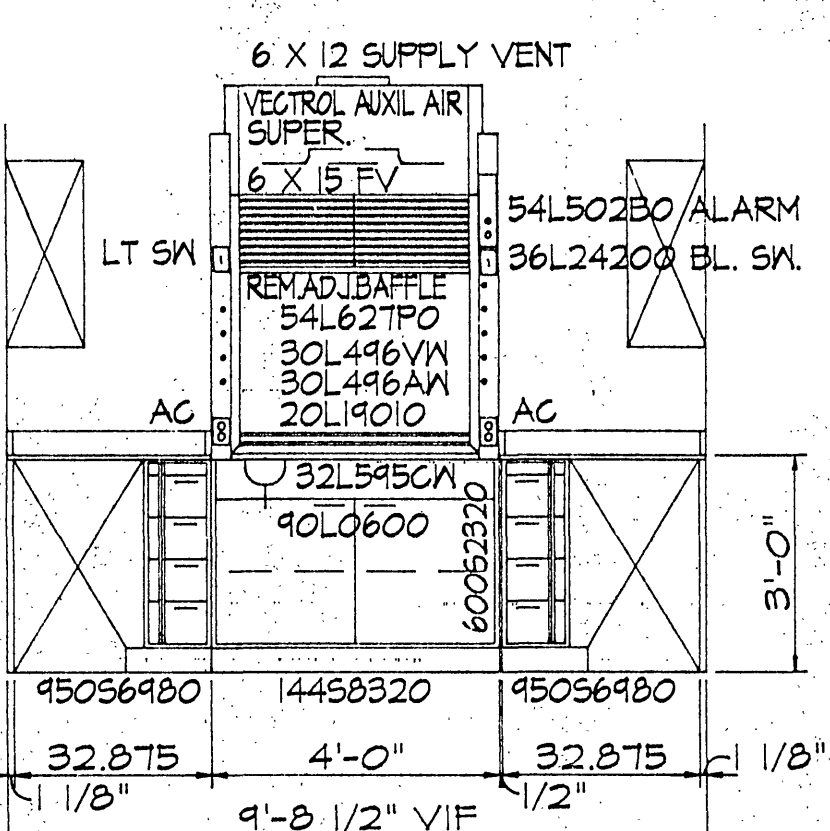


ELEVATION
SCALE 3/8" = 1'-0"

B24.10
B3

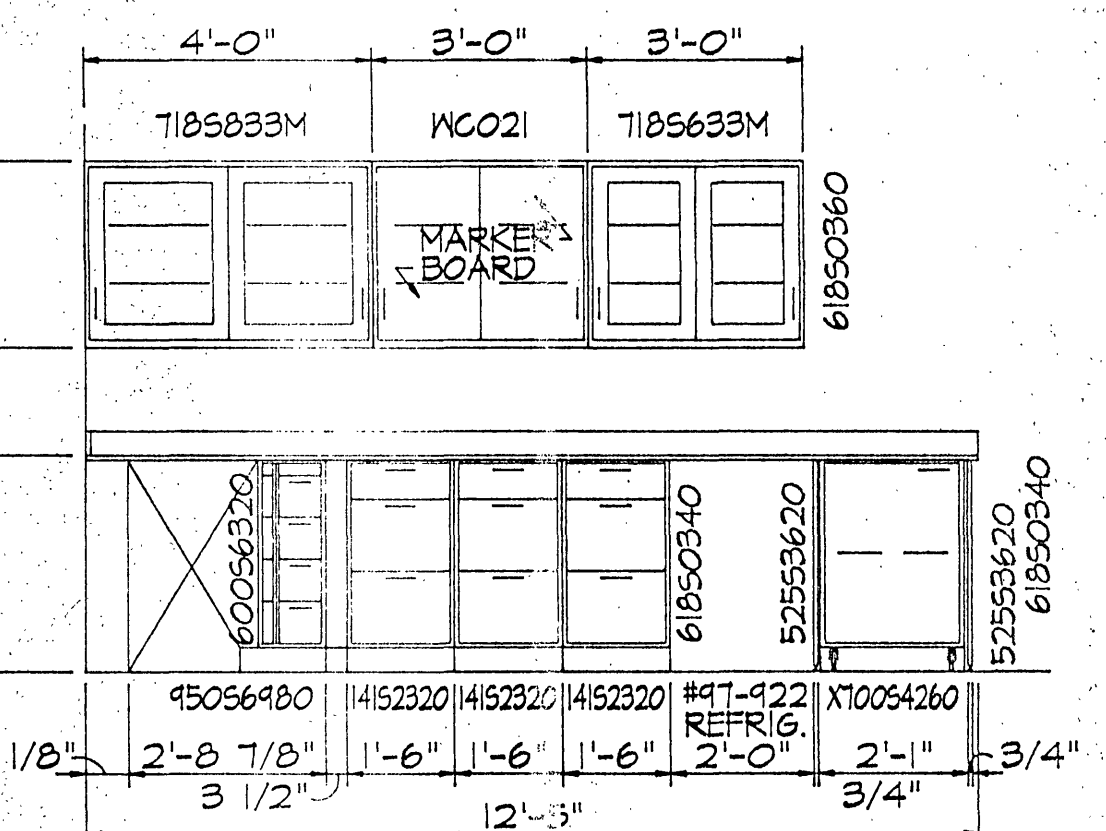


ELEVATION
SCALE 3/8" = 1'-0"

B24.11
B3

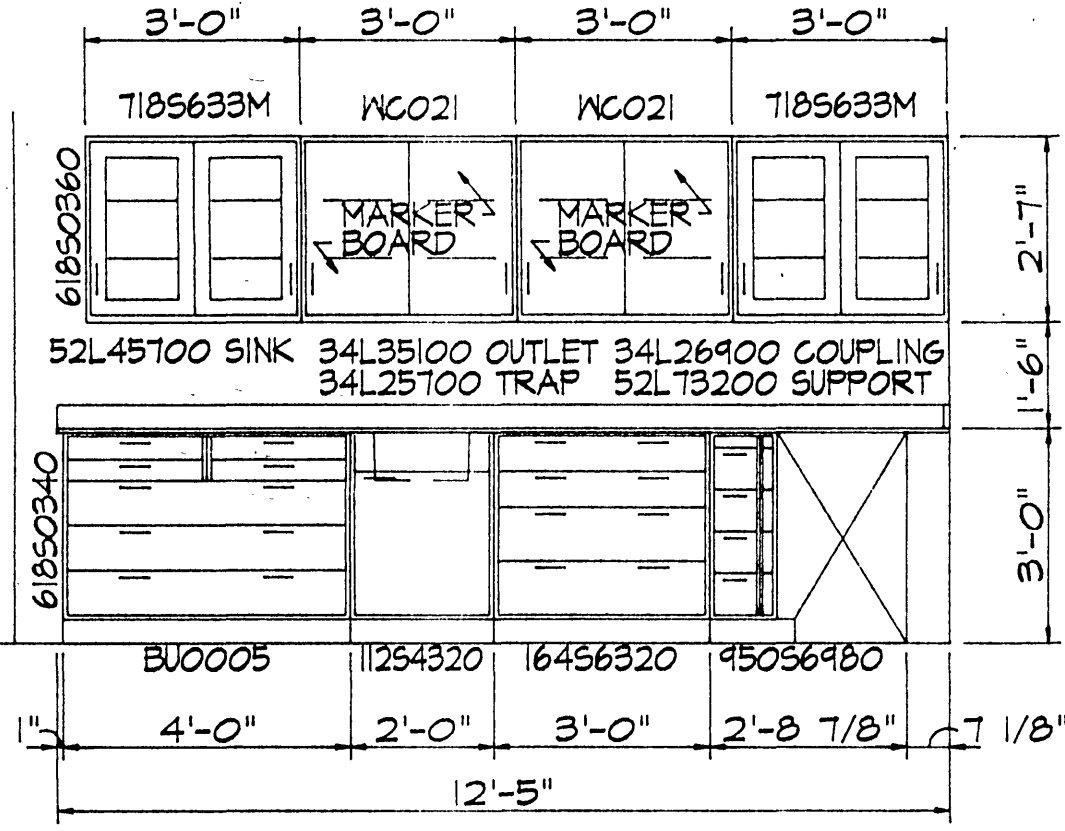


ELEVATION
SCALE 3/8" = 1'-0"

B24.12
B3

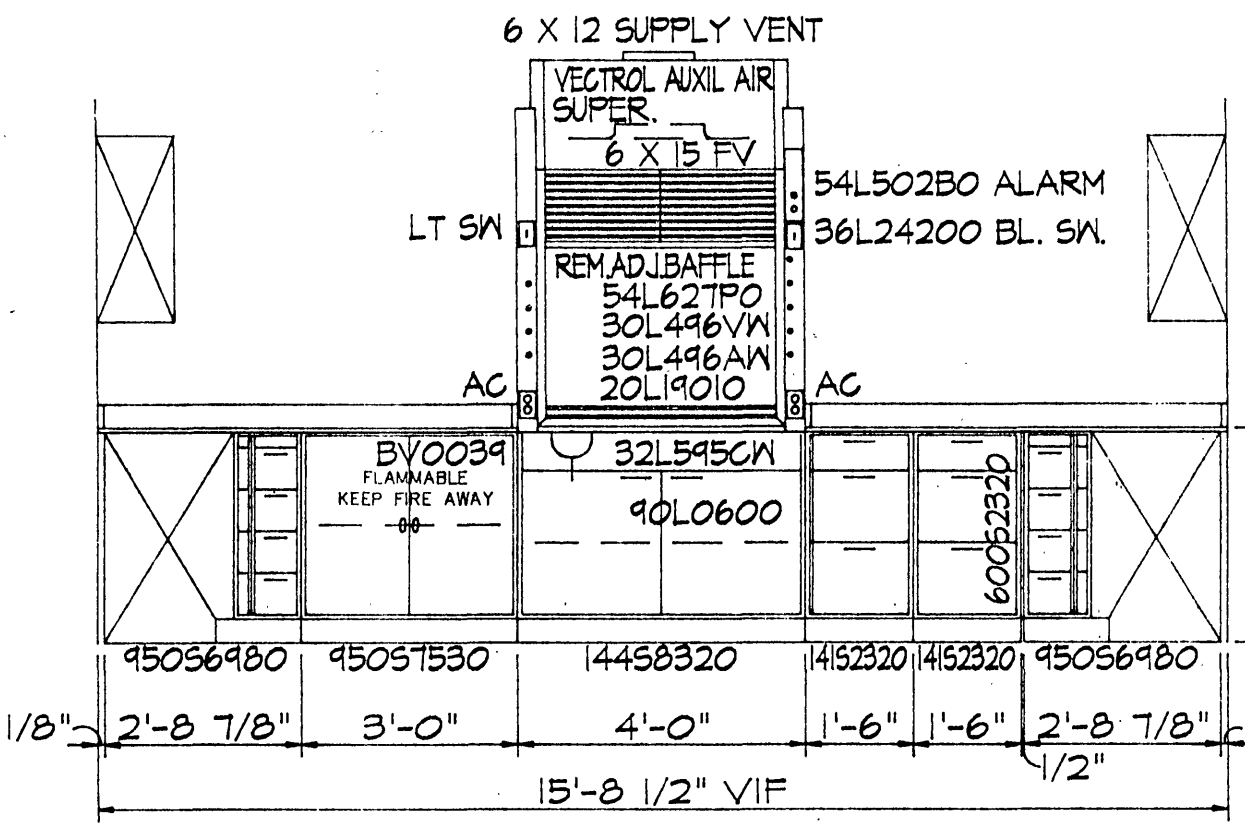


ELEVATION
SCALE 3/8" = 1'-0"

B24.13
B3

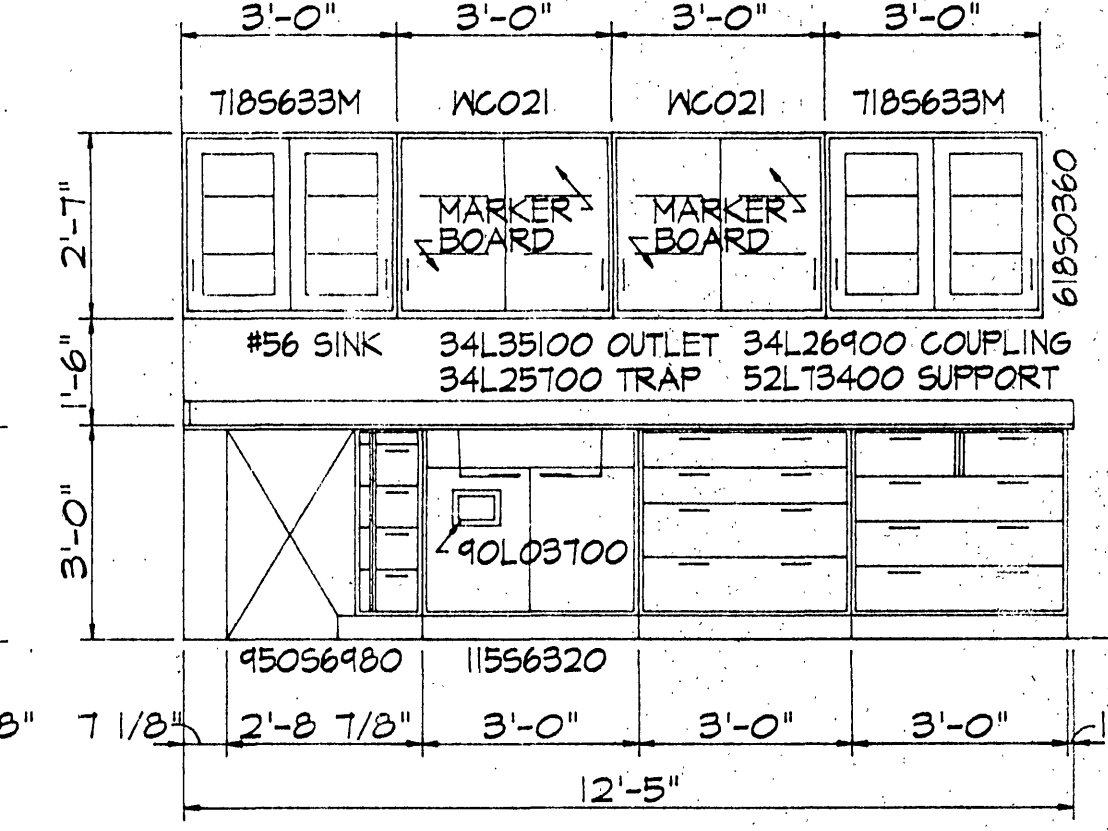


ELEVATION
SCALE 3/8" = 1'-0"

B24.14
B3

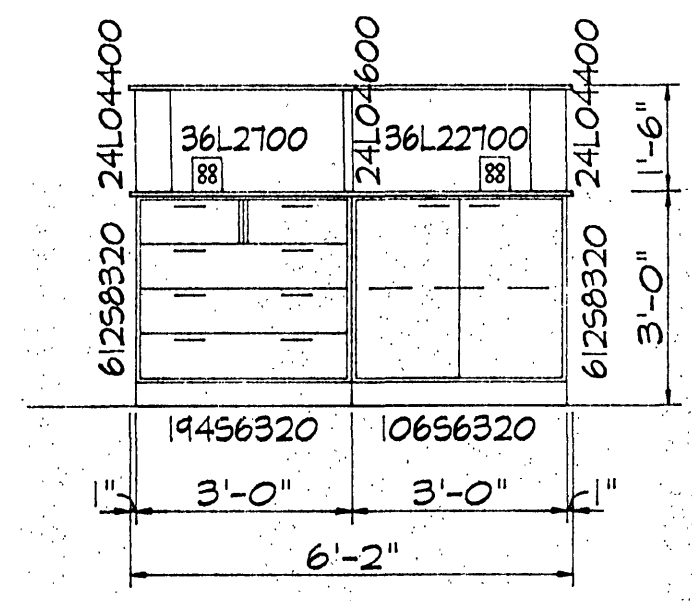


ELEVATION
SCALE 3/8" = 1'-0"

B24.15
B3

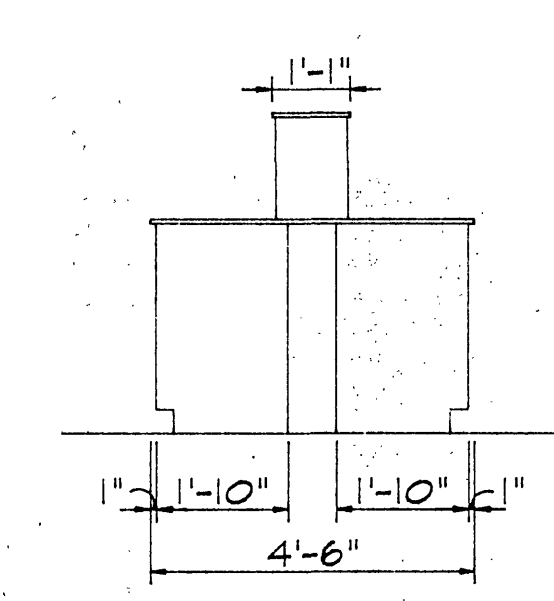

ELEVATION
SCALE 3/8" = 1'-0"

B24.16
B3

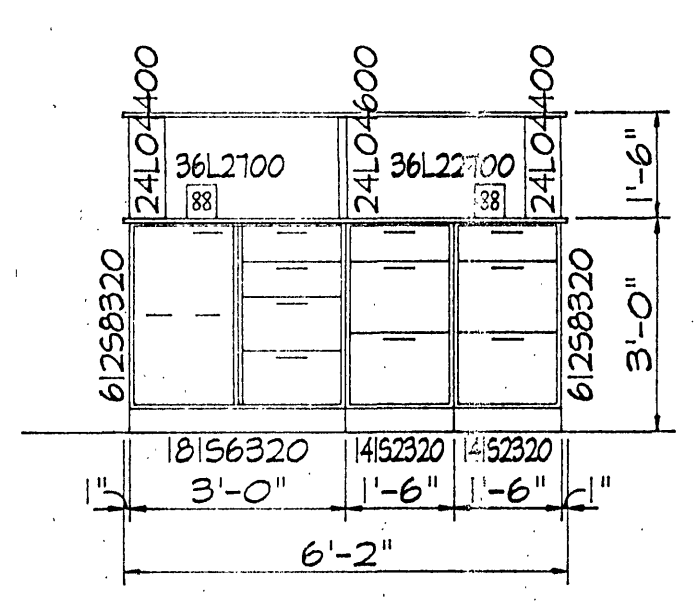


ELEVATION
SCALE 3/8" = 1'-0"


B24.17
B3

INSPECTOR'S AS-BUILTS 1995

WWW.ID# BDLUZ

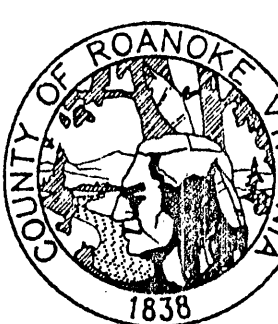

**ROANOKE COUNTY
WATER TREATMENT
FACILITY**

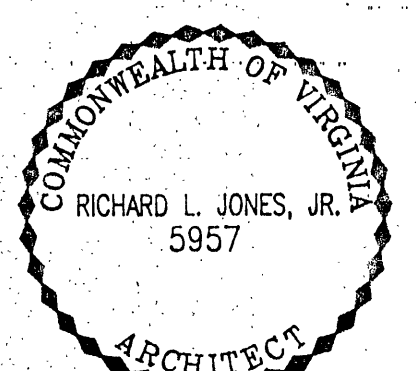

CABINET ELEVATIONS	
PROJECT ARCHITECT RLJ JR	COMMISSION NUMBER 1913
TECHNICIAN RLJ	DATE 22 SEPT 1994

B24

JONES & JONES ASSOCIATES / ARCHITECTS, PC