



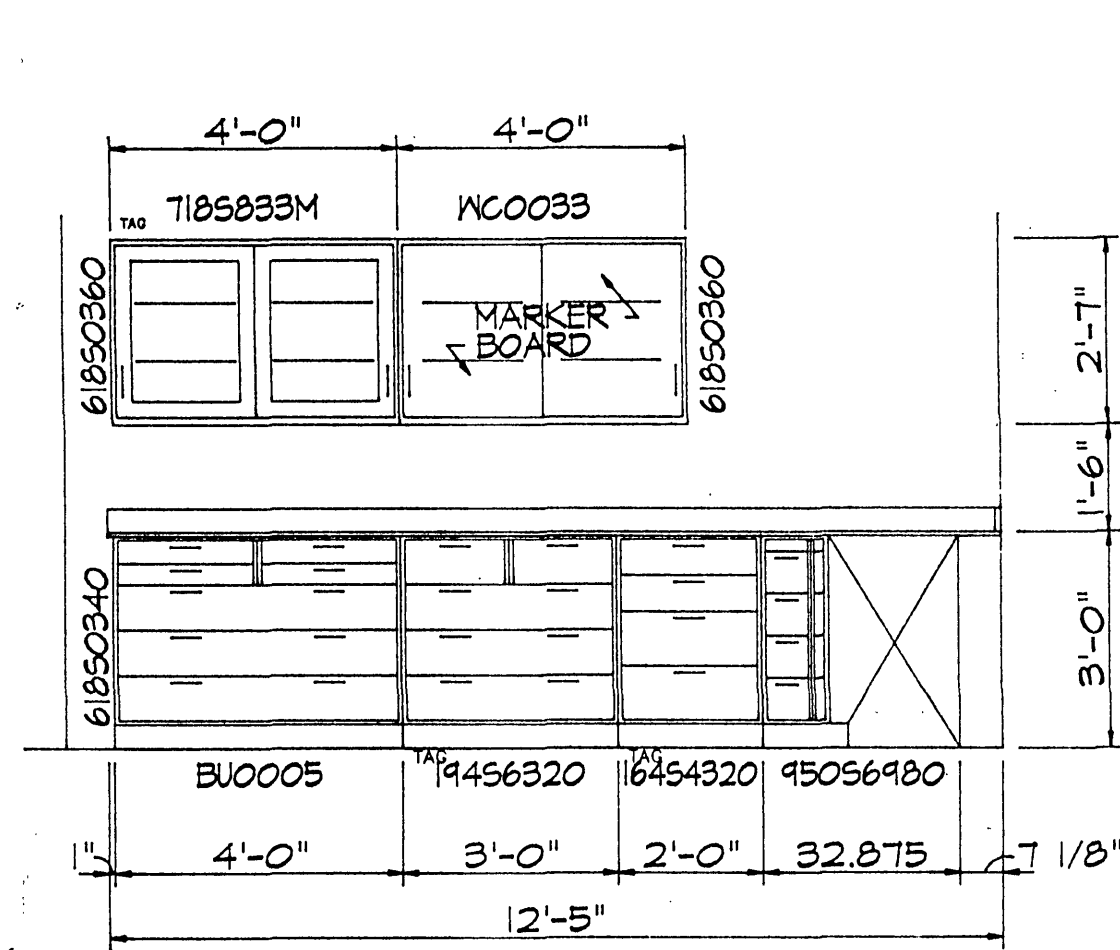


ELEVATION
SCALE 3/8" = 1'-0"

B25.1
B3

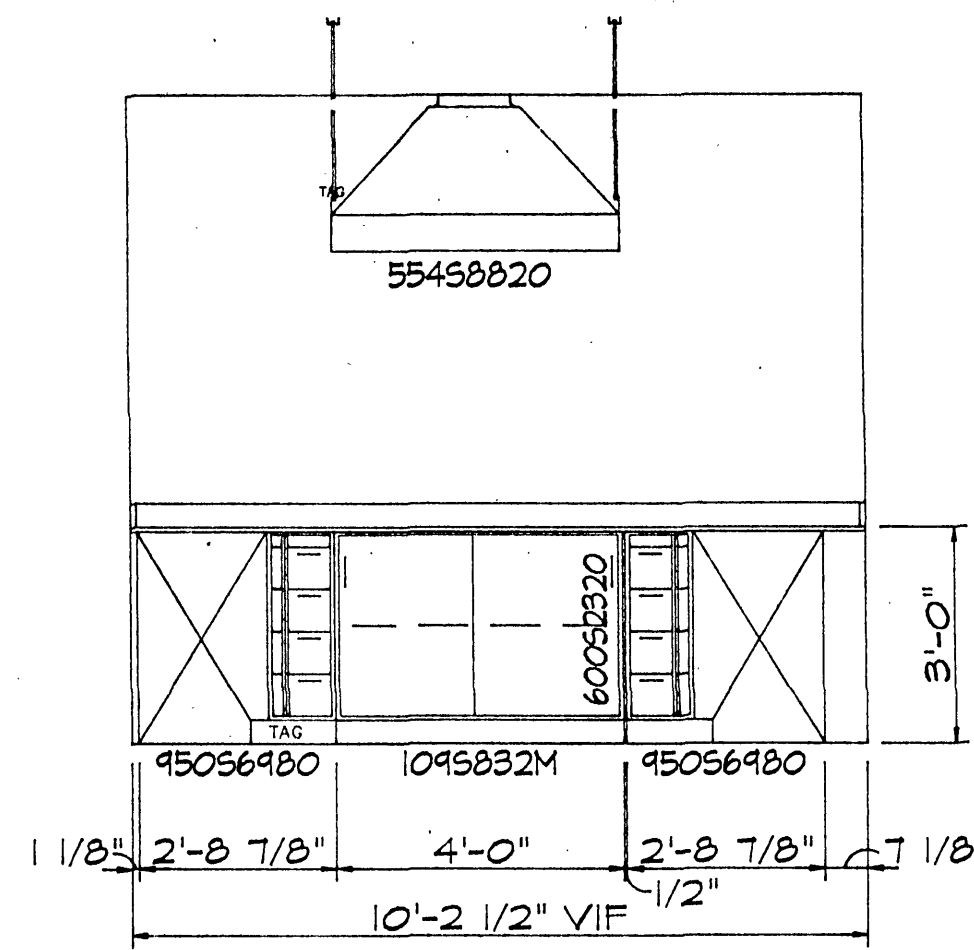


ELEVATION
SCALE 3/8" = 1'-0"

B25.2
B3

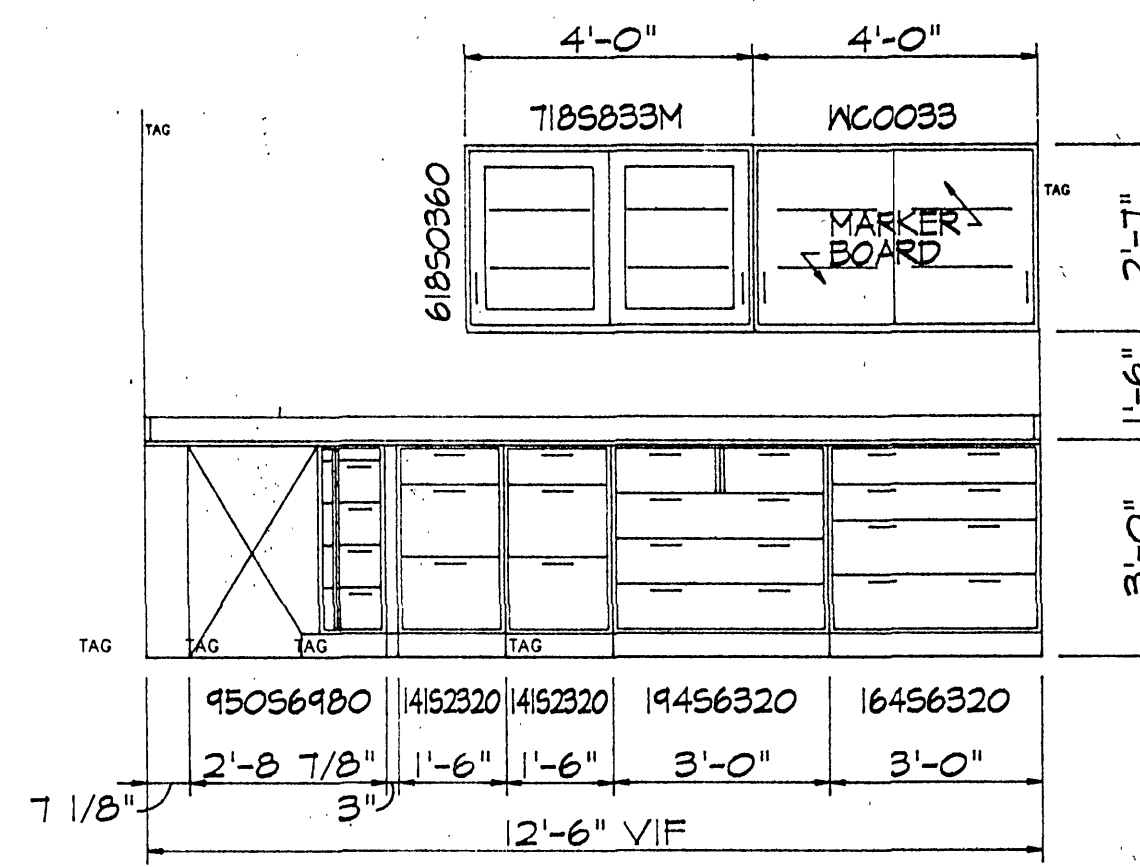


ELEVATION
SCALE 3/8" = 1'-0"

B25.3
B3

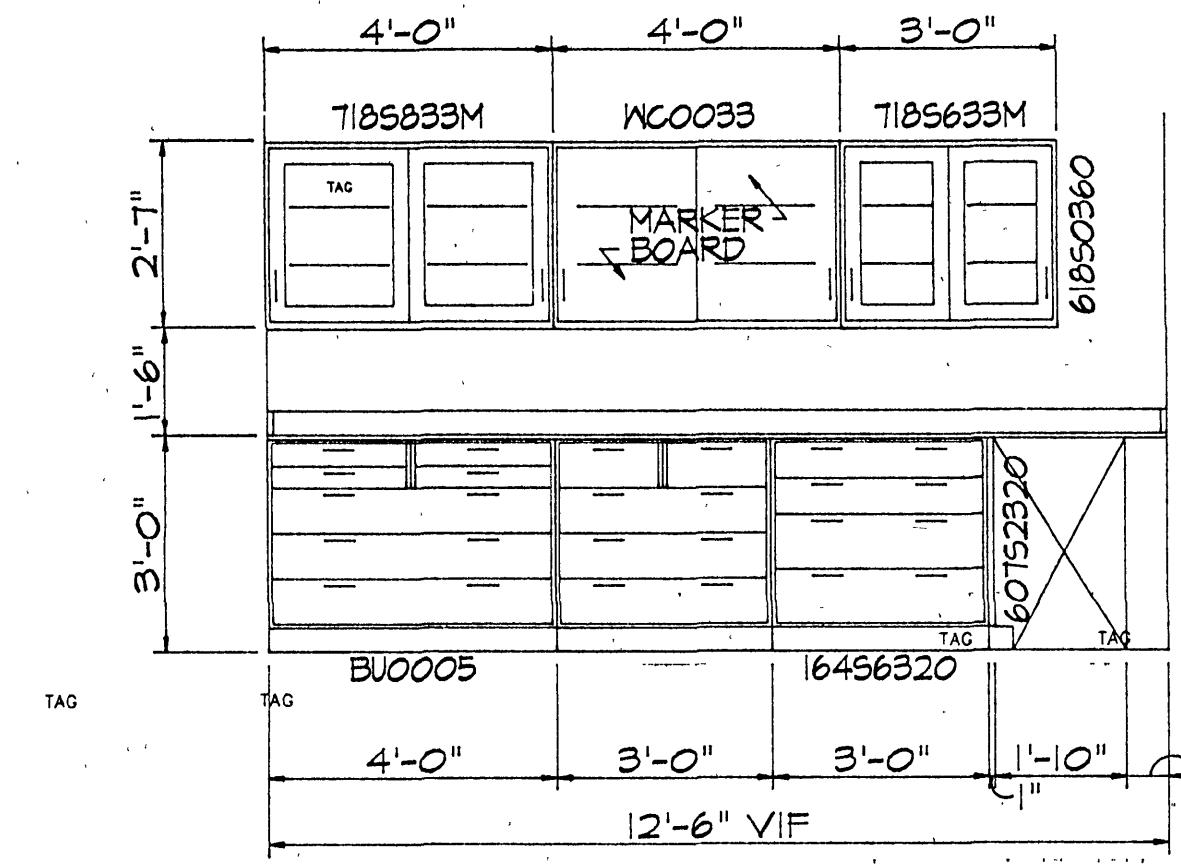


ELEVATION
SCALE 3/8" = 1'-0"

B25.4
B3

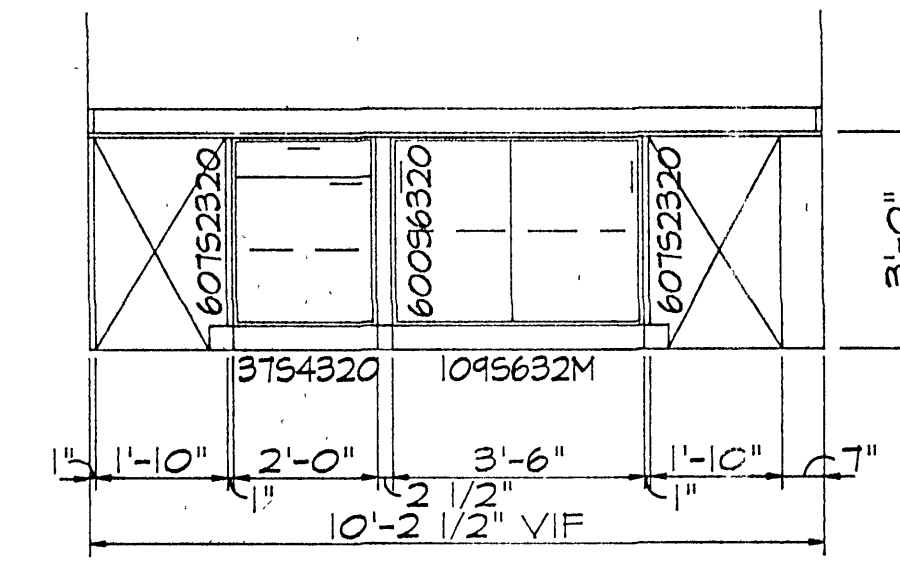


ELEVATION
SCALE 3/8" = 1'-0"

B25.5
B3

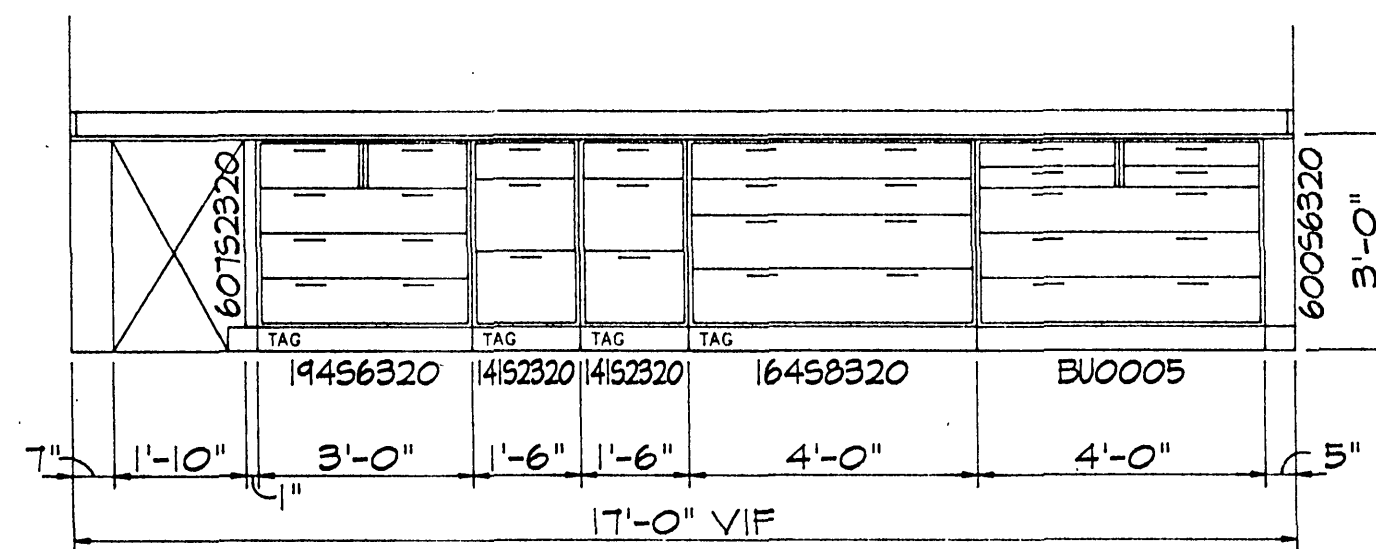


ELEVATION
SCALE 3/8" = 1'-0"

B25.6
B3

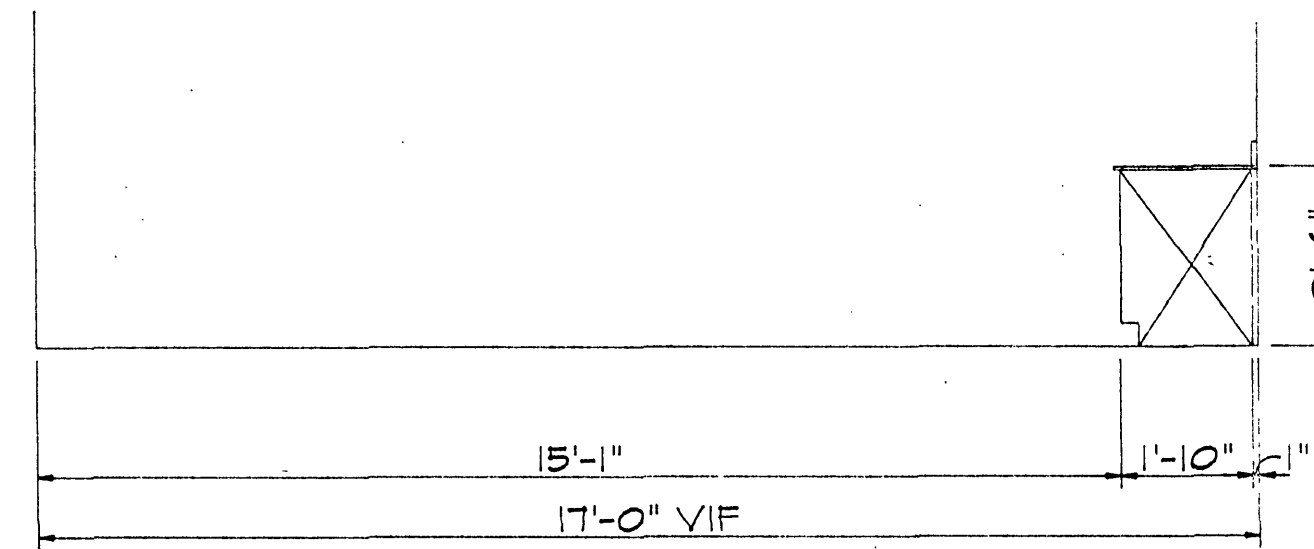


ELEVATION
SCALE 3/8" = 1'-0"

B25.7
B3

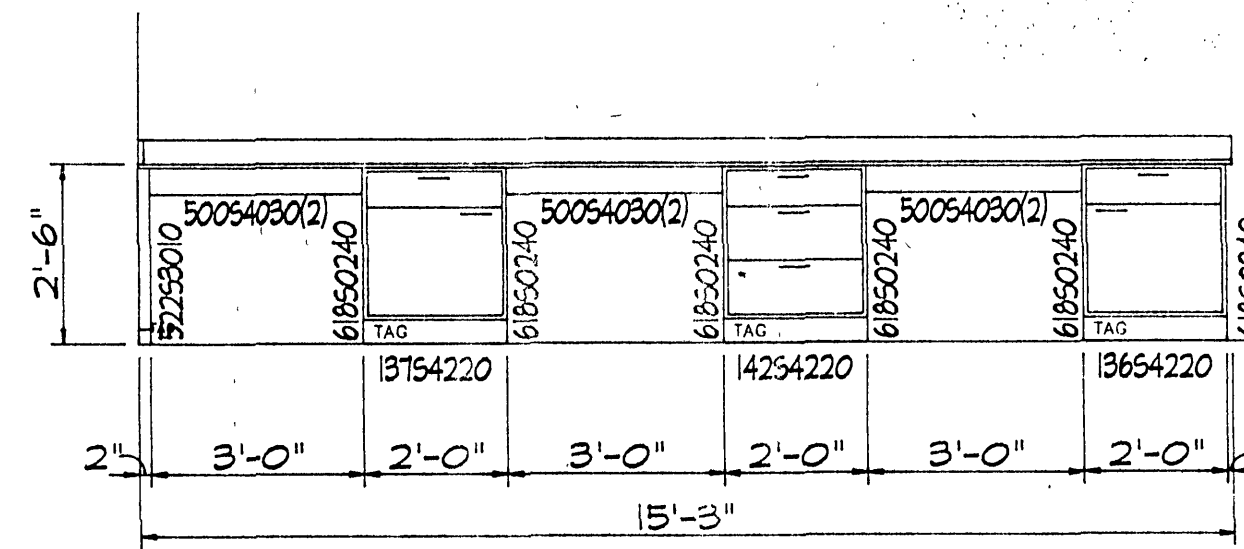


ELEVATION
SCALE 3/8" = 1'-0"

B25.8
B3

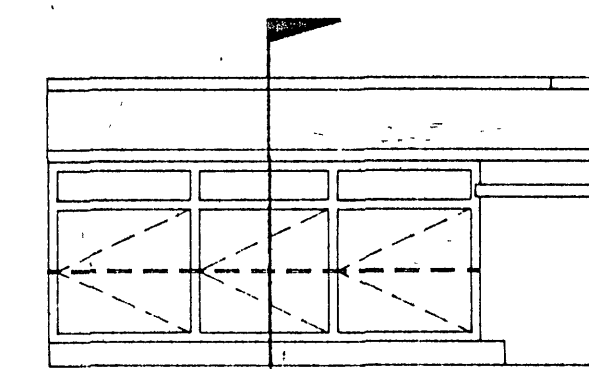


ELEVATION
SCALE 3/8" = 1'-0"

B25.9
B3

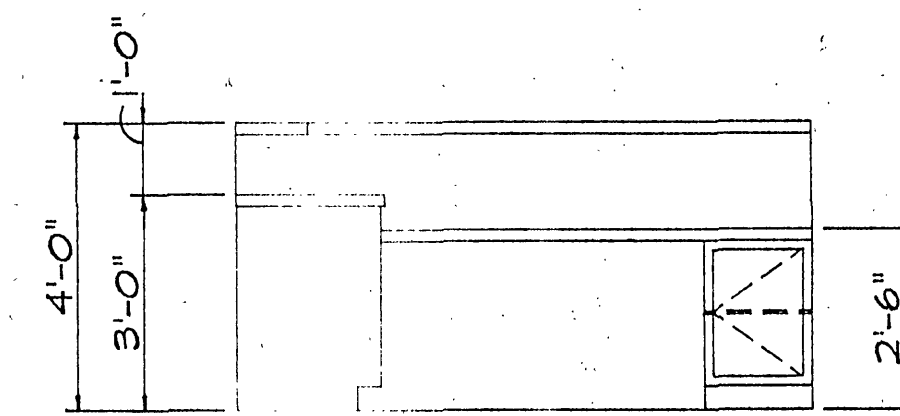

ELEVATION
SCALE 3/8" = 1'-0"


B25.10
B3

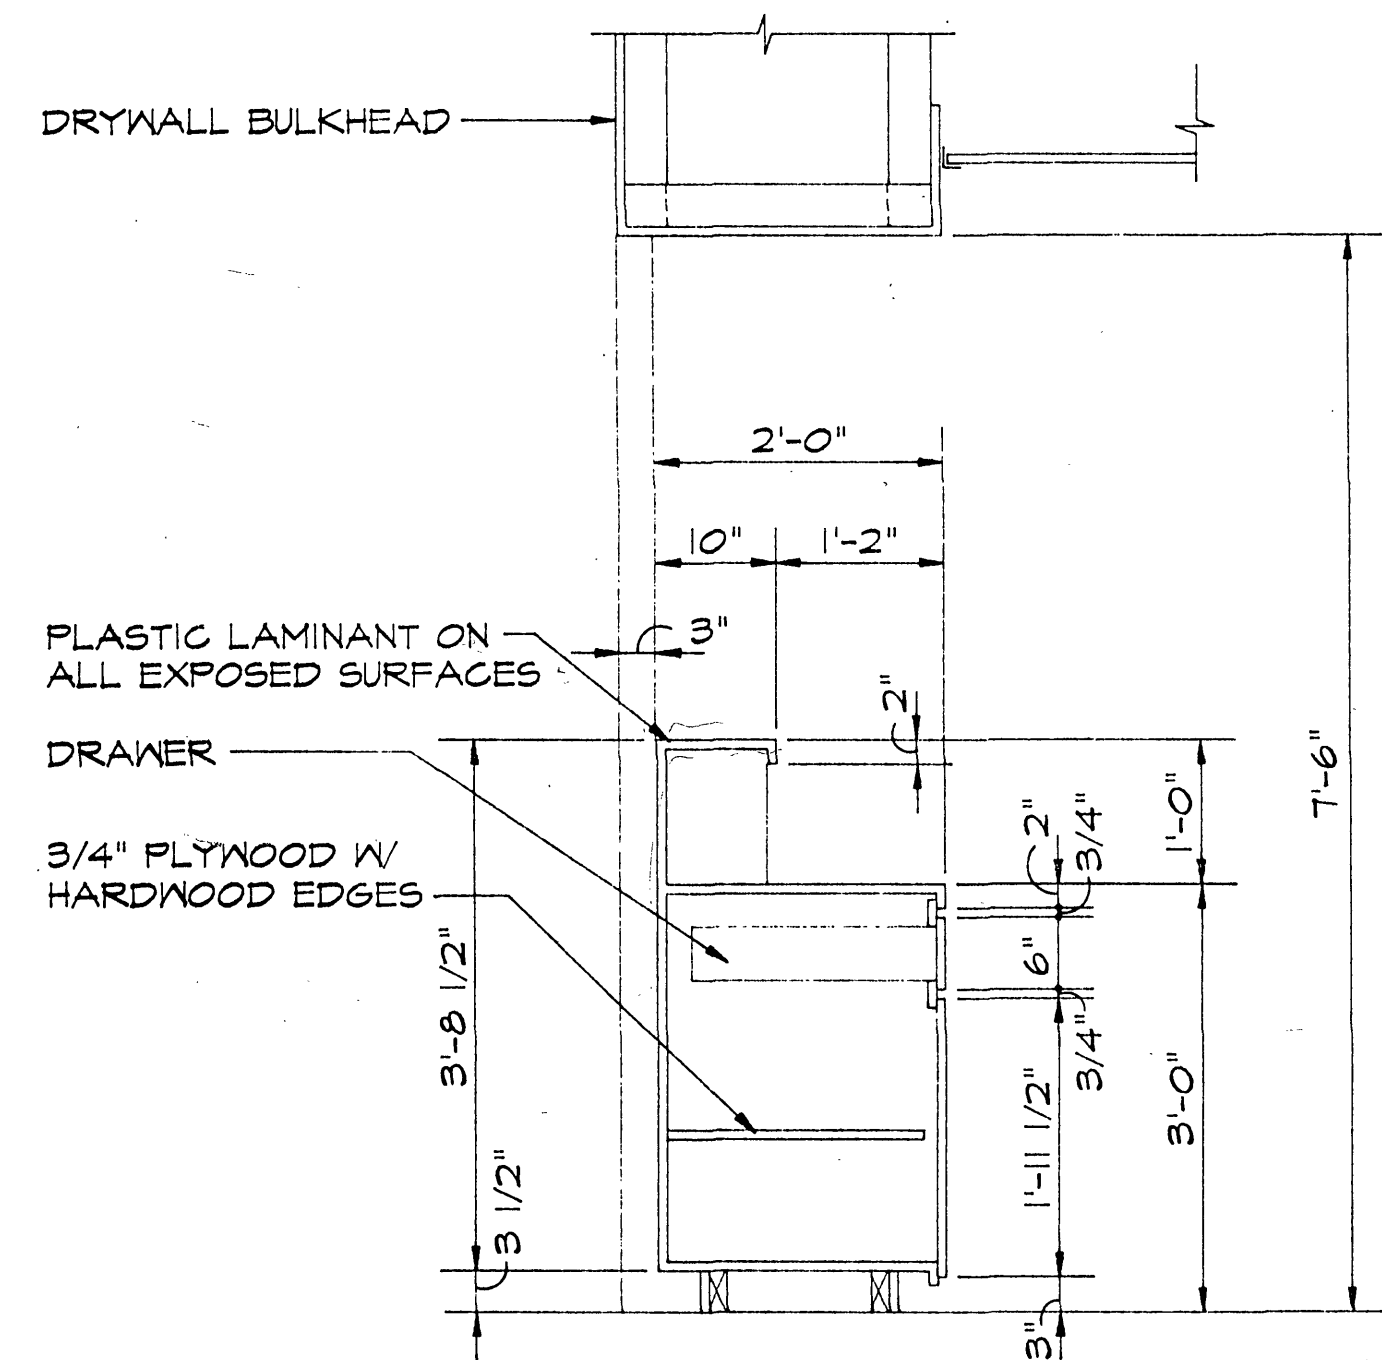

RECEPTION CABINET SECTION
SCALE 3/4" = 1'-0"

B25.13
B3

B25

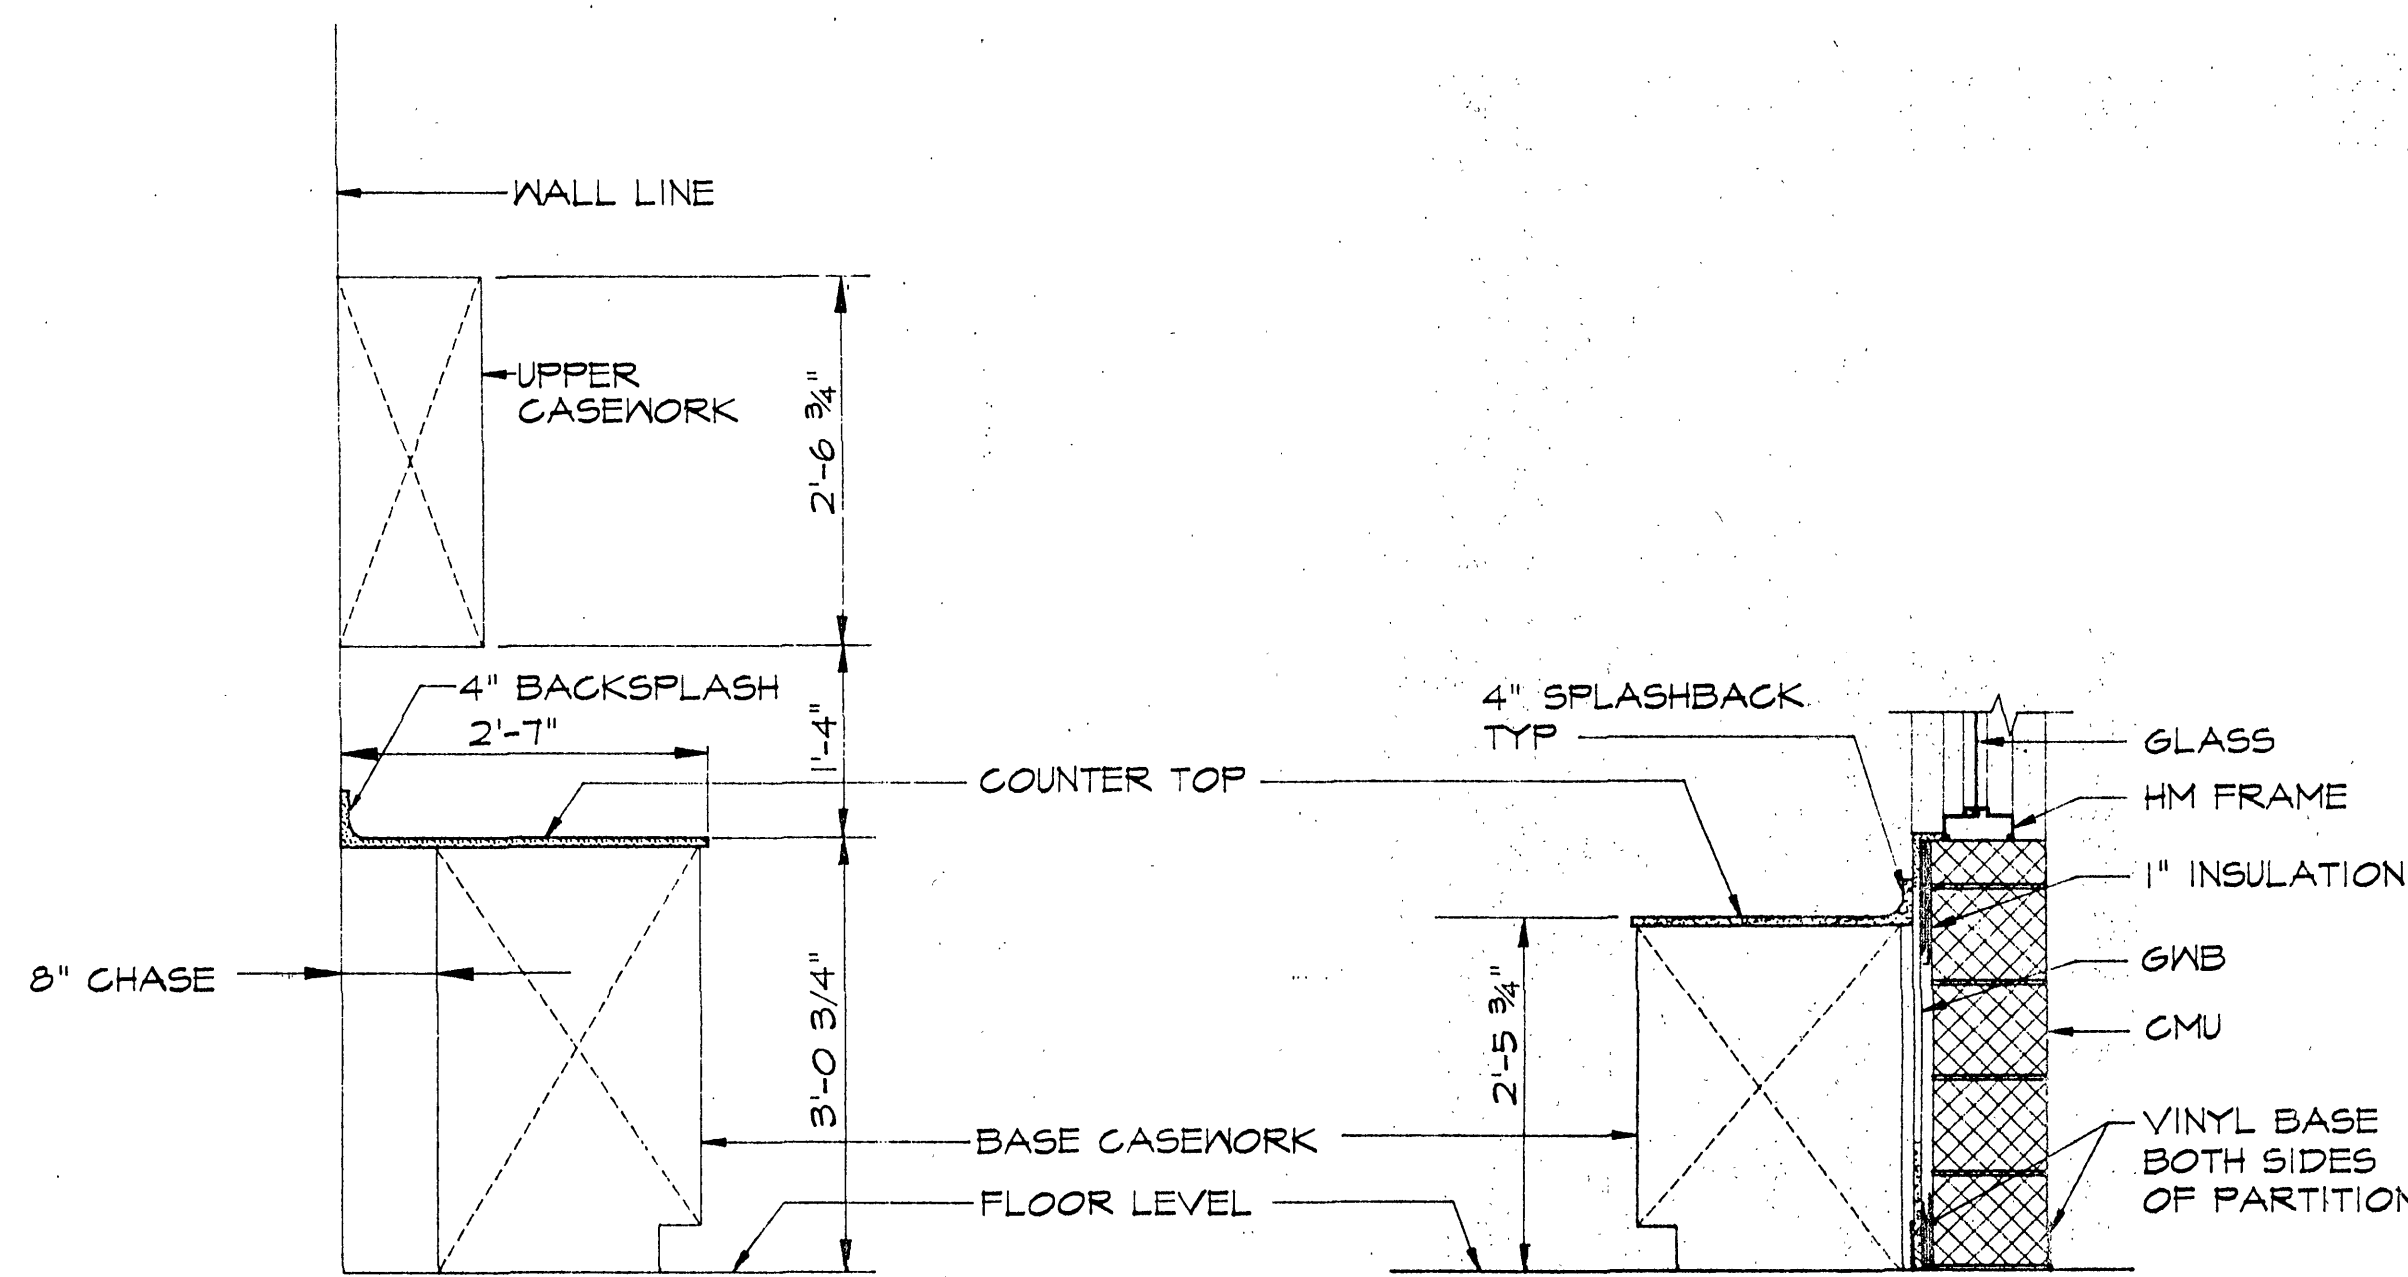


SECTION
SCALE 3/4" = 1'-0"

B25.14
B24

SECTION
SCALE 3/4" = 1'-0"

B25.15
B24

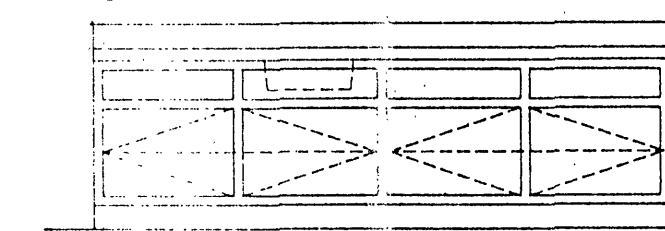


ELEVATION
SCALE 3/8" = 1'-0"


B25.11
B3

INSPECTOR'S AS-BUILTS 1995

WWW.ID# 6LDLIZ

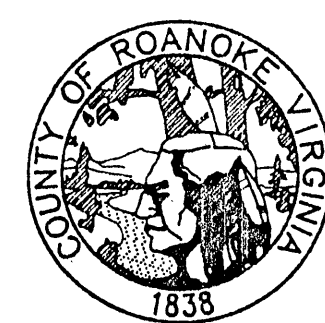

**ROANOKE COUNTY
WATER TREATMENT
FACILITY**

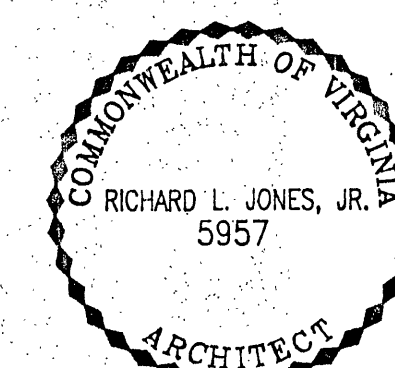

CABINET ELEVATIONS

PROJECT ARCHITECT
RLJ JR

COMMISSION NUMBER
1913

TECHNICIAN
RLJ

DATE
22 SEPT 1994

B25

JONES & JONES ASSOCIATES / ARCHITECTS PC