
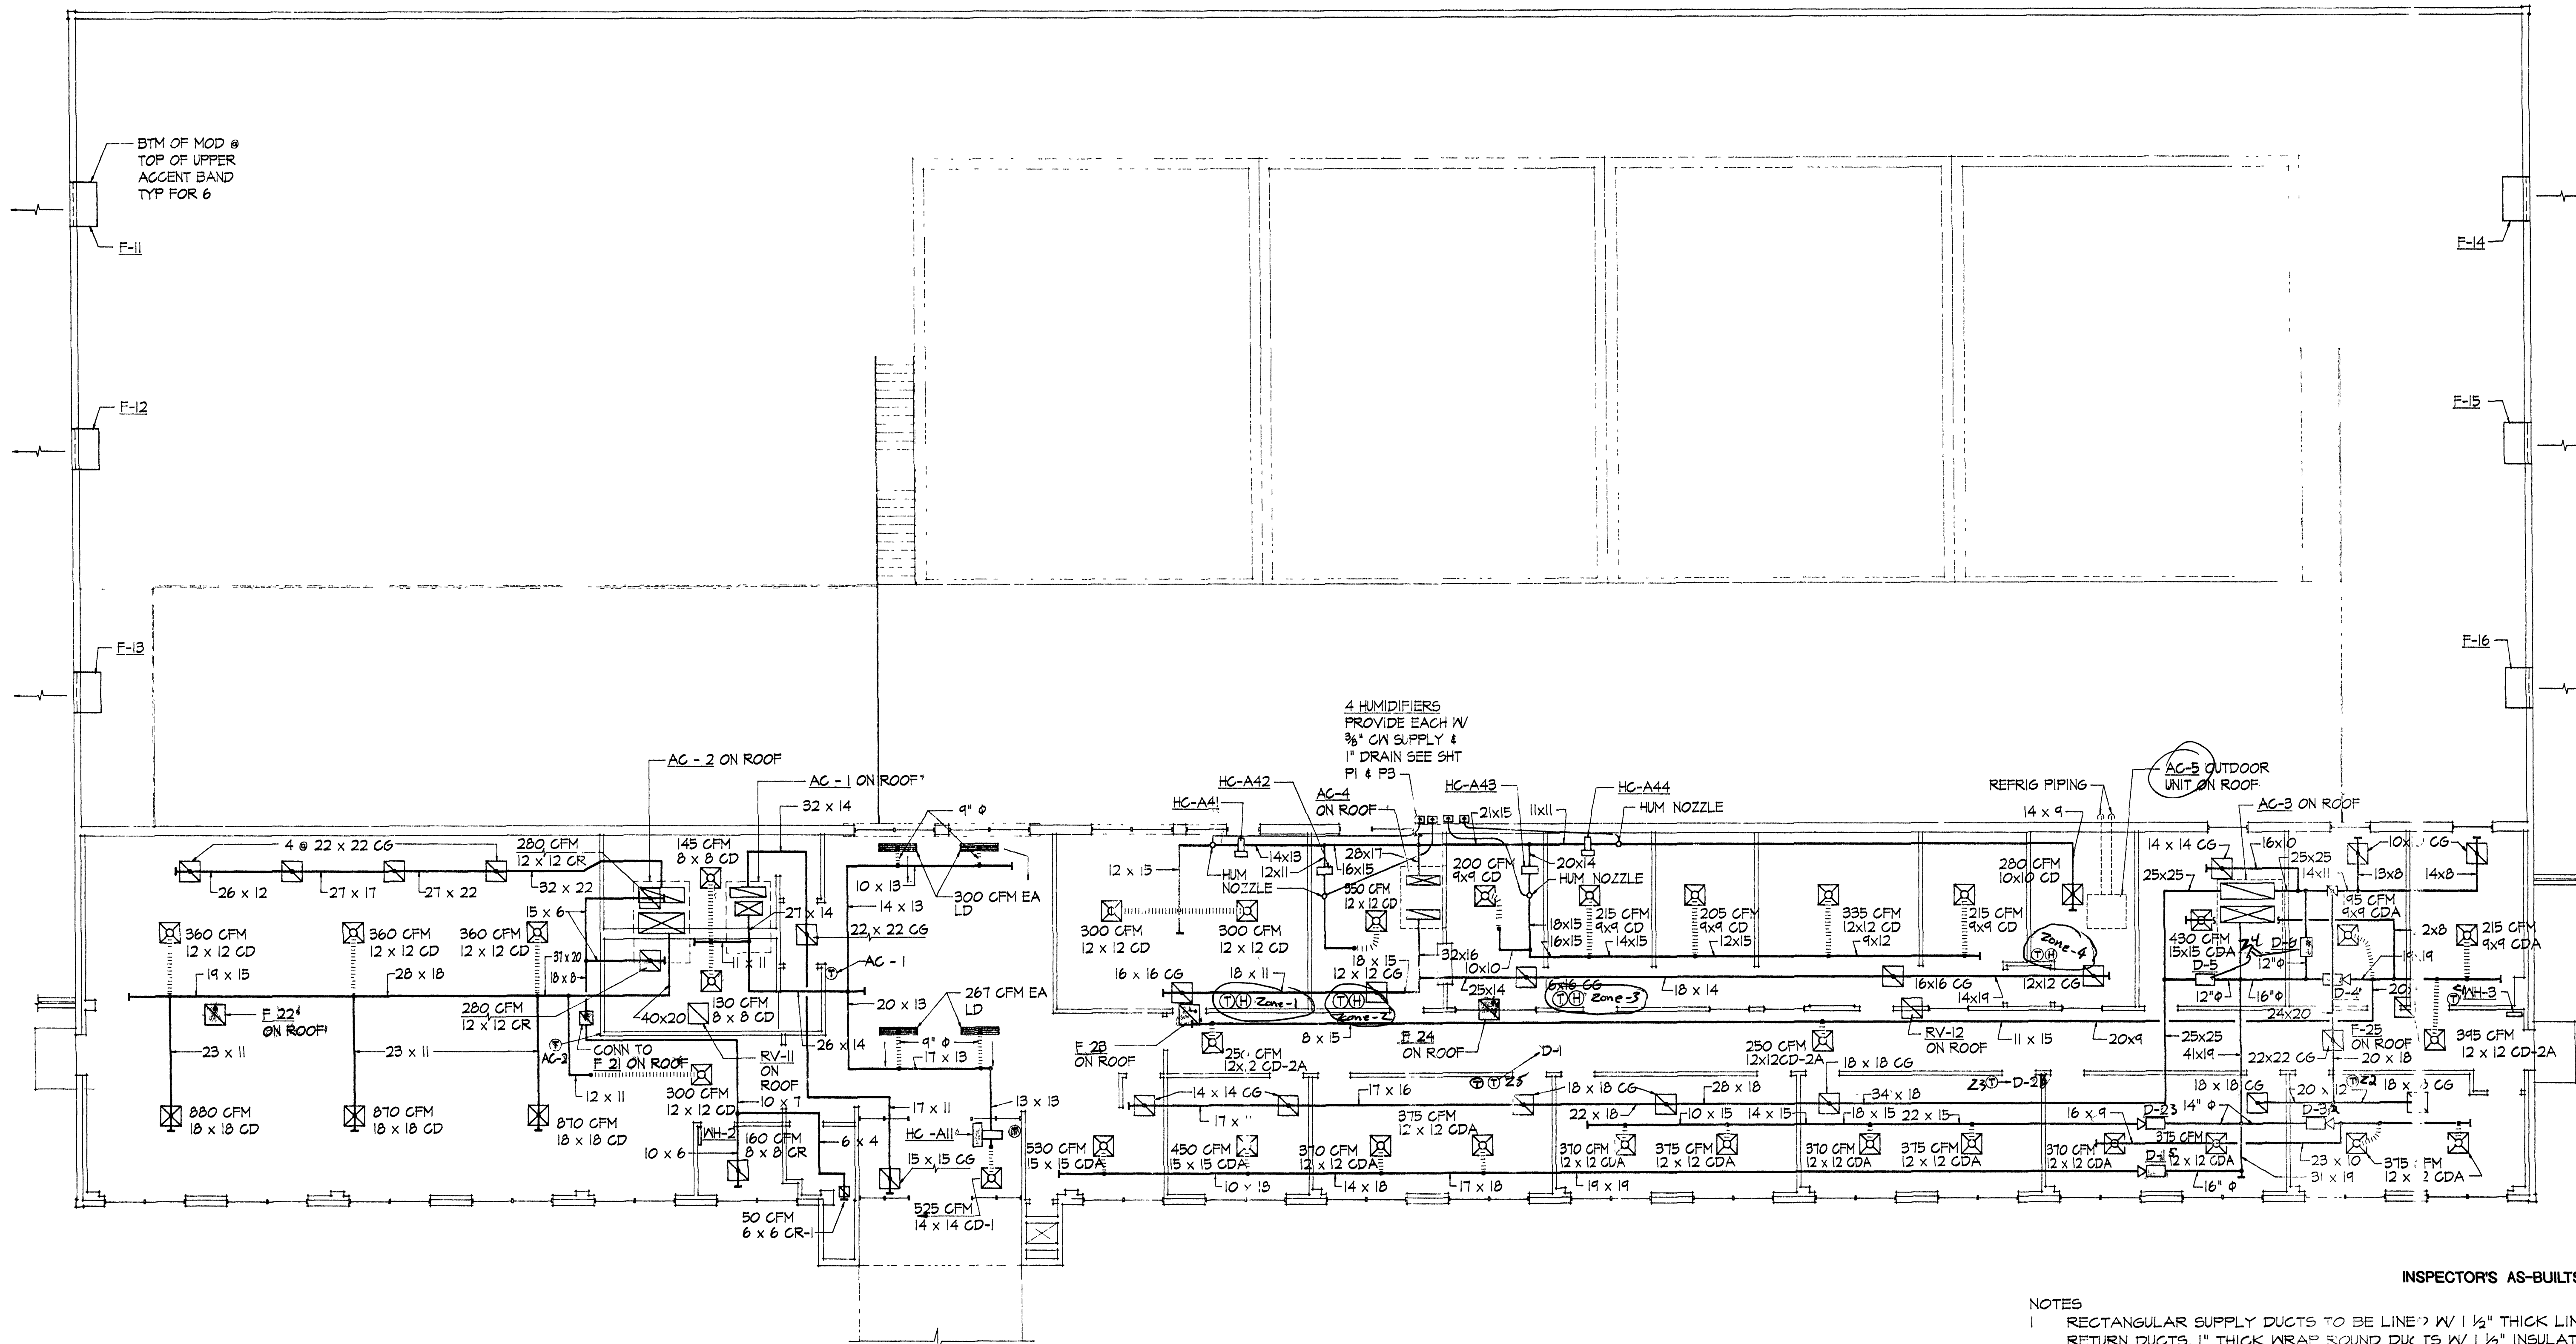


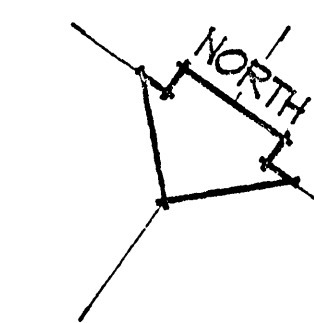


SECOND LEVEL MECHANICAL DIAGRAM - TREATMENT BUILDING
SCALE 1/8" = 1'-0"


INSPECTOR'S AS-BUILTS 1995

NOTES
1 RECTANGULAR SUPPLY DUCTS TO BE LINE 1/2" W/ 1 1/2" THICK LINING, RETURN DUCTS, 1" THICK WRAP AROUND DUCTS W/ 1 1/2" INSULATION. ALL DIMENSIONS ARE EXTERNAL
2 MAXIMUM LENGTH OF FLEXIBLE DUCT TO BE 3 FEET

WWW.IDP.6LDLIZ

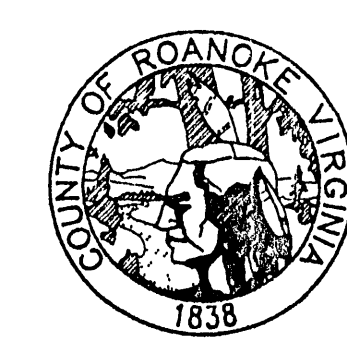

ROANOKE COUNTY WATER TREATMENT FACILITY

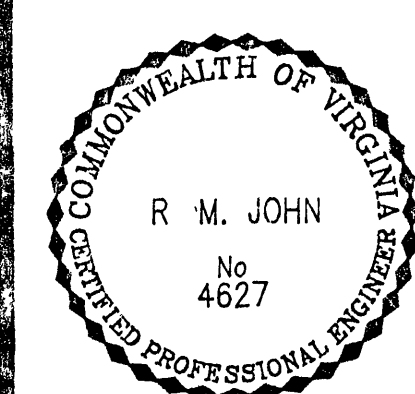

MECHANICAL DIAGRAM	
PROJECT ARCHITECT	COMMISSION NUMBER
RLJ	1913
TECHNICIANS	DATE
IRAT	22 SEPT 1994



JONES & JONES ASSOCIATES, INC. ARCHITECTS, P.C.