


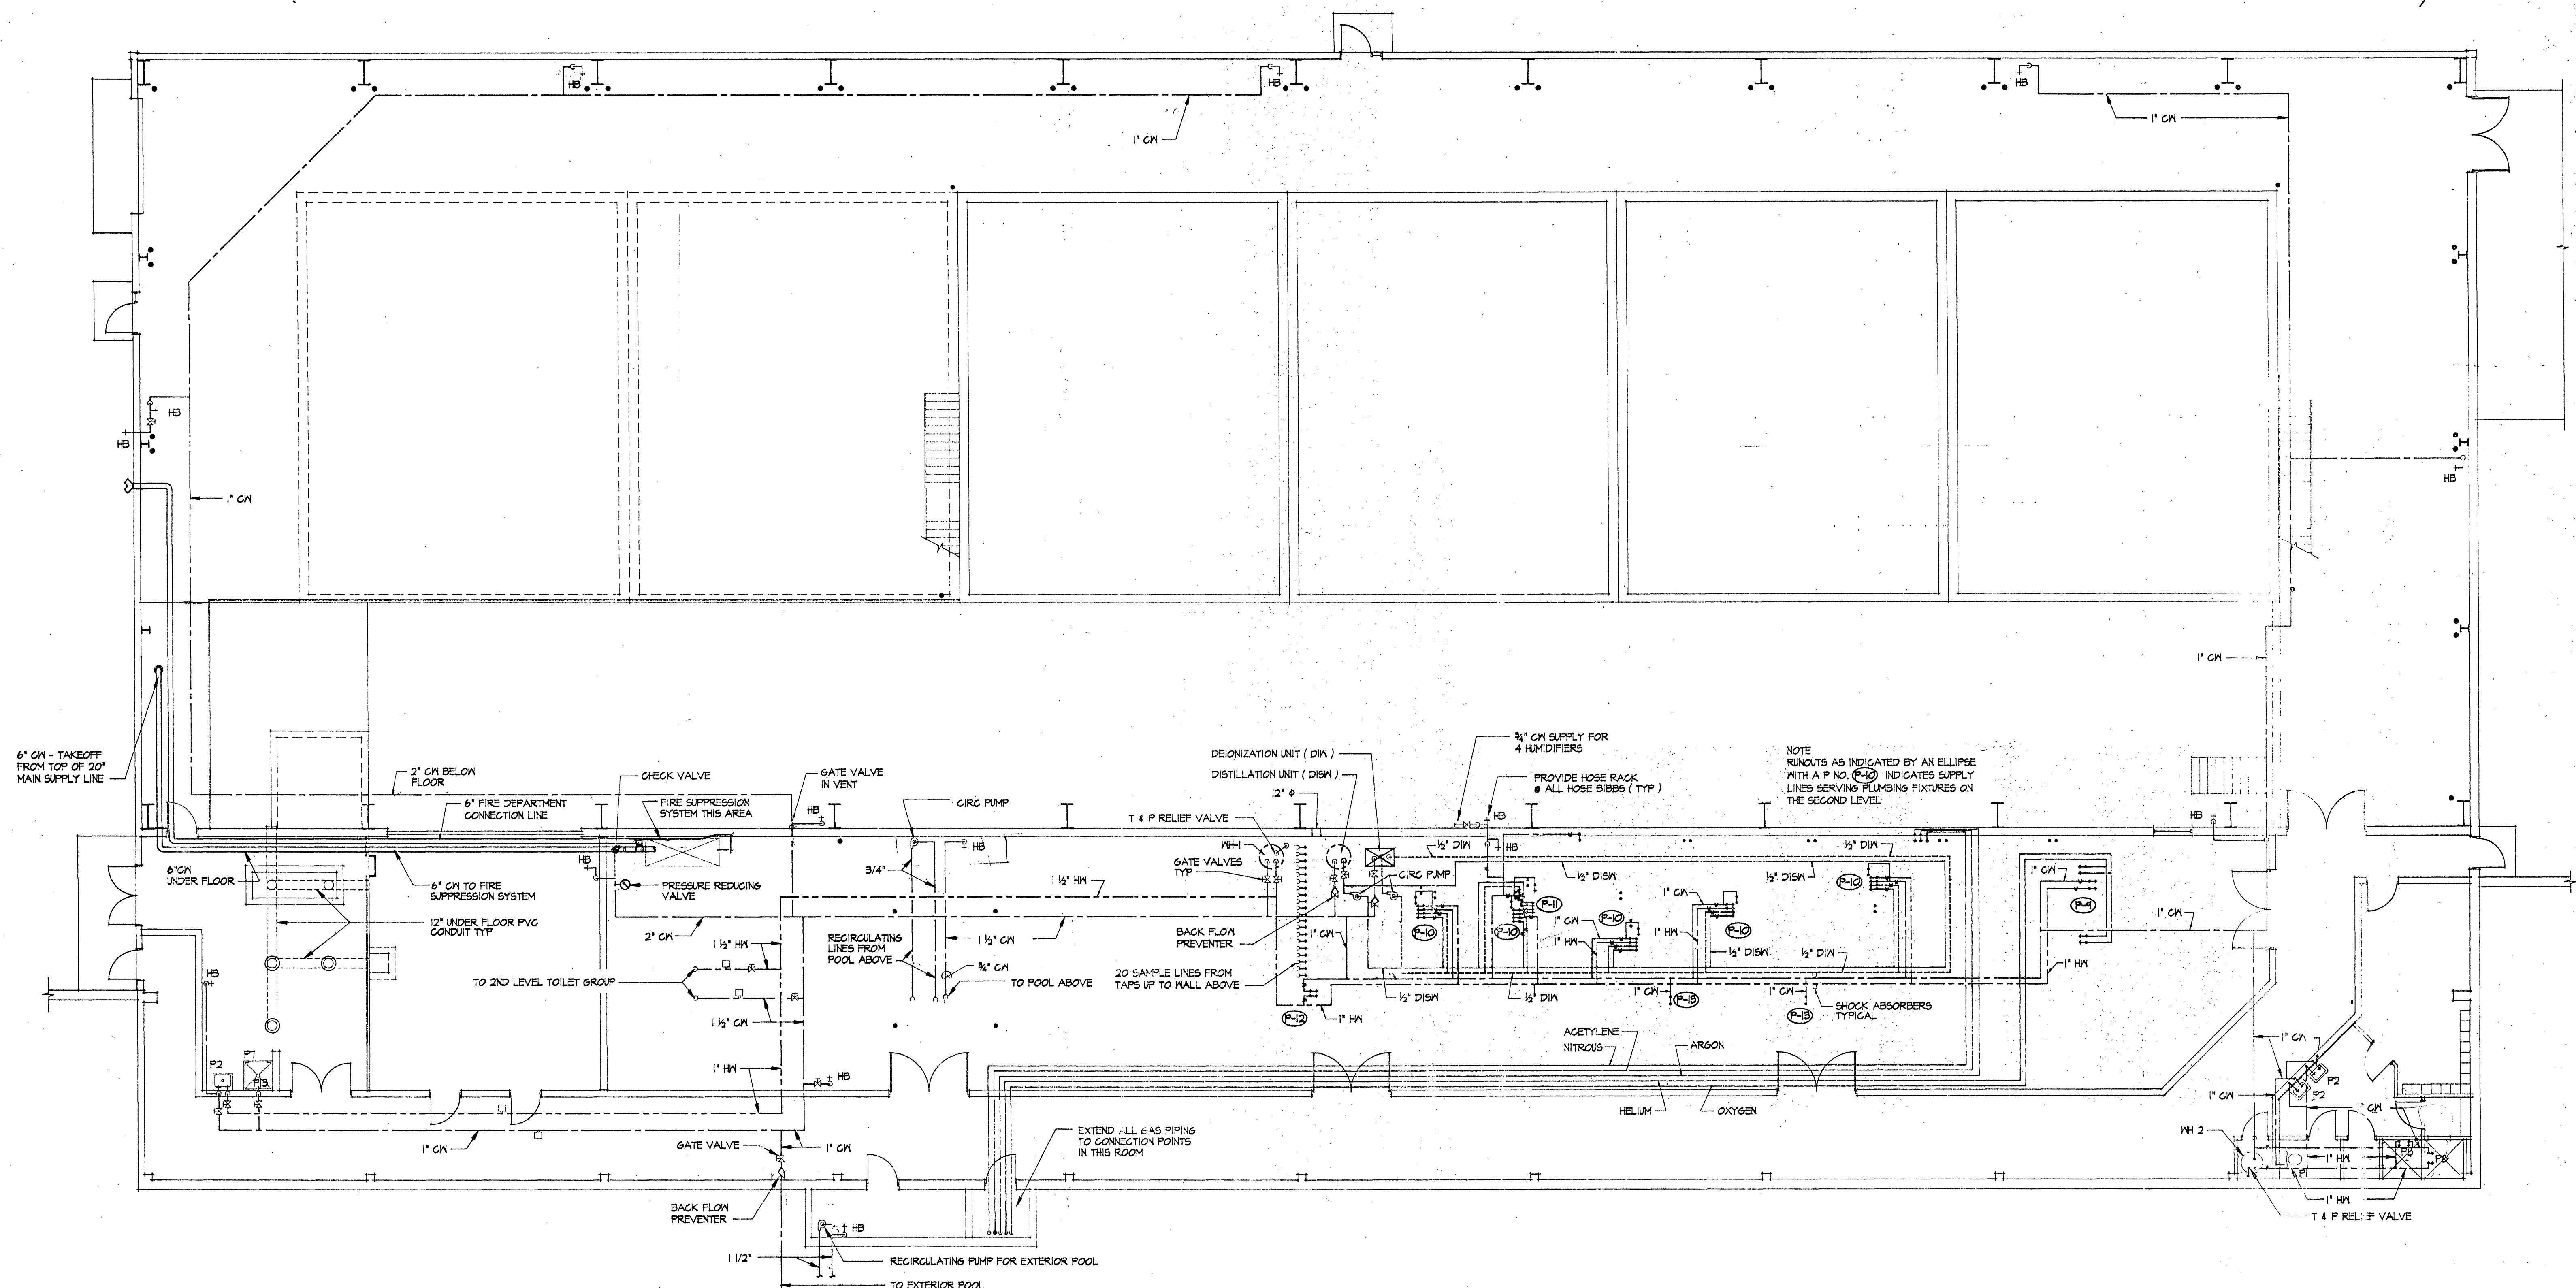


FIRST LEVEL PLAN - TREATMENT BUILDING - PLUMBING SUPPLY DIAGRAM


SCALE 1/8" = 1'-0"

INSPECTOR'S AS-BUILTS 1995

WWW.ID# 6LDL2

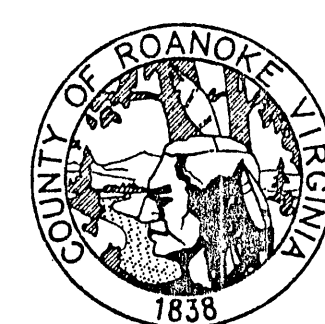

ROANOKE COUNTY WATER TREATMENT FACILITY

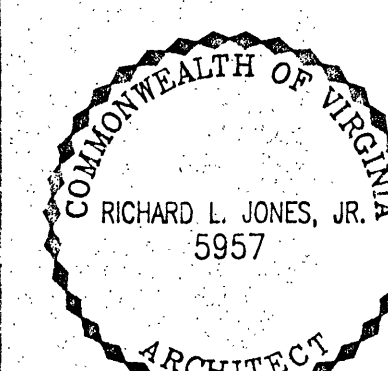

PLUMBING DIAGRAM - TREATMENT BLD.

PROJECT ARCHITECT

RLJ JR

COMMISSION NUMBER

1913

TECHNICIANS

BAIT RLJ

DATE

22 SEPT 1994

P1

JONES & JONES ASSOCIATES / ARCHITECTS PC