


PLUMBING SUPPLY DIAGRAM - LAB AREA
SCALE 1/4" = 1'-0"

PLUMBING SUPPLY DIAGRAM - PUBLIC TOILETS
SCALE 1/4" = 1'-0"

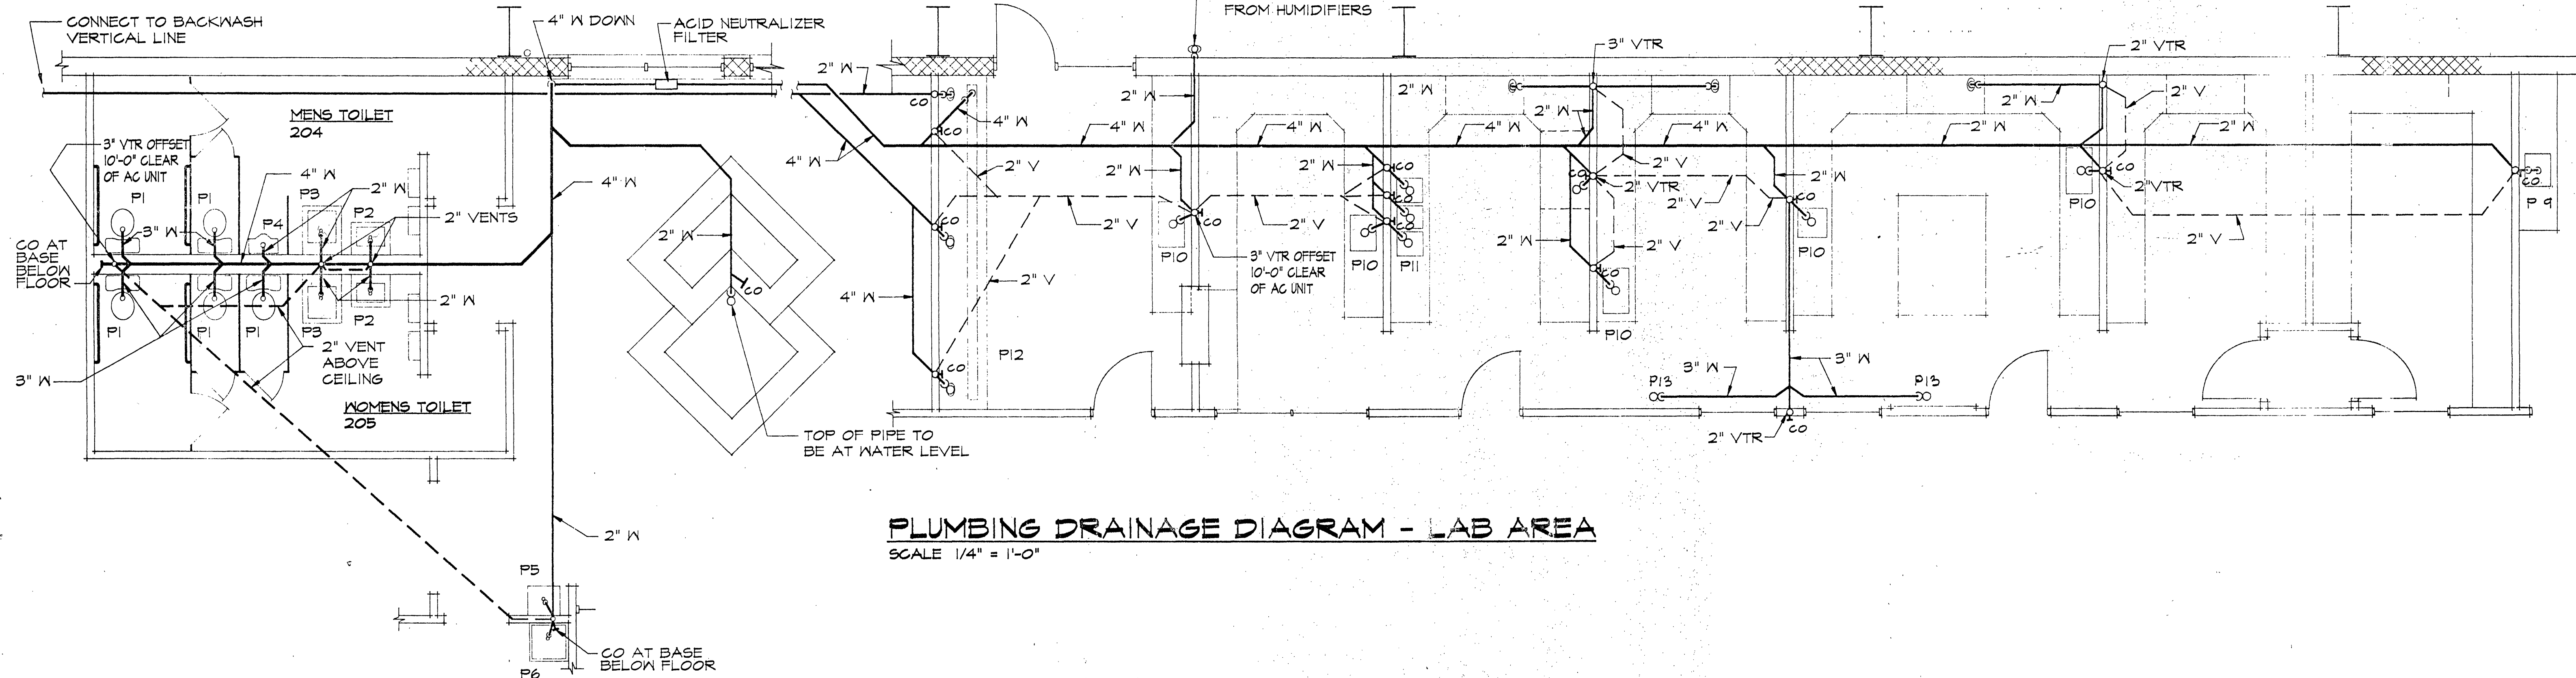


PLUMBING DRAINAGE DIAGRAM - LAB AREA
SCALE 1/4" = 1'-0"


PLUMBING DRAINAGE DIAGRAM - PUBLIC TOILETS
SCALE 1/4" = 1'-0"

INSPECTOR'S AS-BUILTS 1995

WWW ID# 6LDL UZ

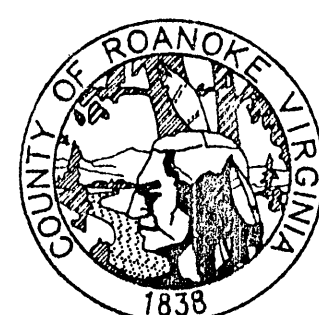

**ROANOKE COUNTY
WATER TREATMENT
FACILITY**

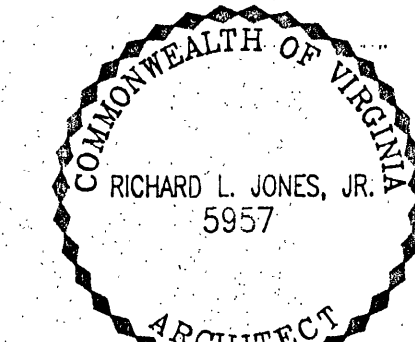

PLUMBING - LABS AND TOILETS

PROJECT ARCHITECT

R. L. J.

COMMISSION NUMBER

1412

TECHNICIANS

EWAT

DATE

22 SEPT 1994

P3

JONES & JONES ASSOCIATES / ARCHITECTS PC