

TREATMENT SYSTEM SITE PLAN SCALE 1" = 25'-0"

NOT IN THIS CONTRACT
SLUDGE TANK

TOP @ 1310
OUT. @ 1277
112'x28'
2 M.G.

NOT IN THIS CONTRACT
SLUDGE TANK

TOP @ 1310
OUT. @ 1277
112'x28'
2 M.G.

NOT IN THIS CONTRACT
CLEAR WELL

TOP @ 1303
BOT. @ 1275
112'x28'
2 M.G.



ROANOKE COUNTY UTILITY DEPARTMENT

INSPECTOR'S AS-BUILTS 1995

WWW.ID# 6LDLUIZ



ROANOKE COUNTY WATER TREATMENT FACILITY

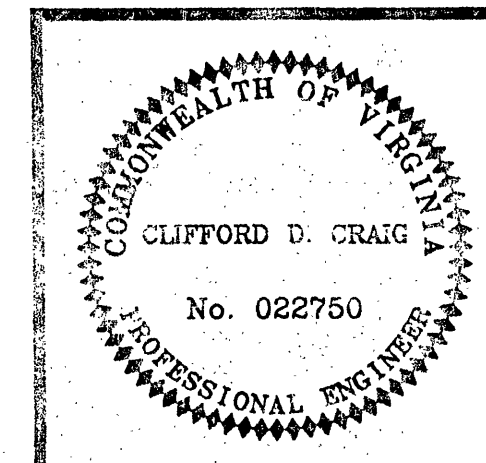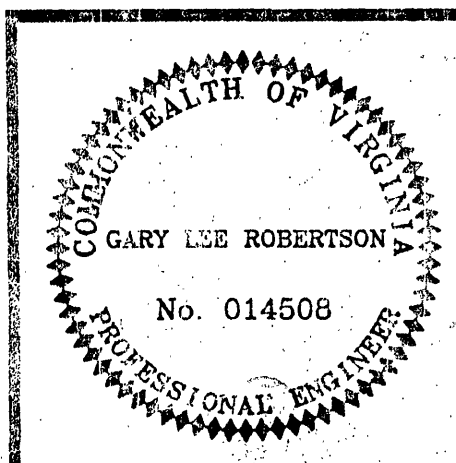

TREATMENT SYSTEM SITE PLAN

DESIGN ENGINEER
CLIFFORD D. CRAIG

COMMISSION NUMBER
1912

PROJECT NUMBER
ATF-1

DATE
9 SEPT. 1994

T1