




NORTH WALL ELEVATION - 15MG T3.1
SCALE 1" = 5'-0"
T2

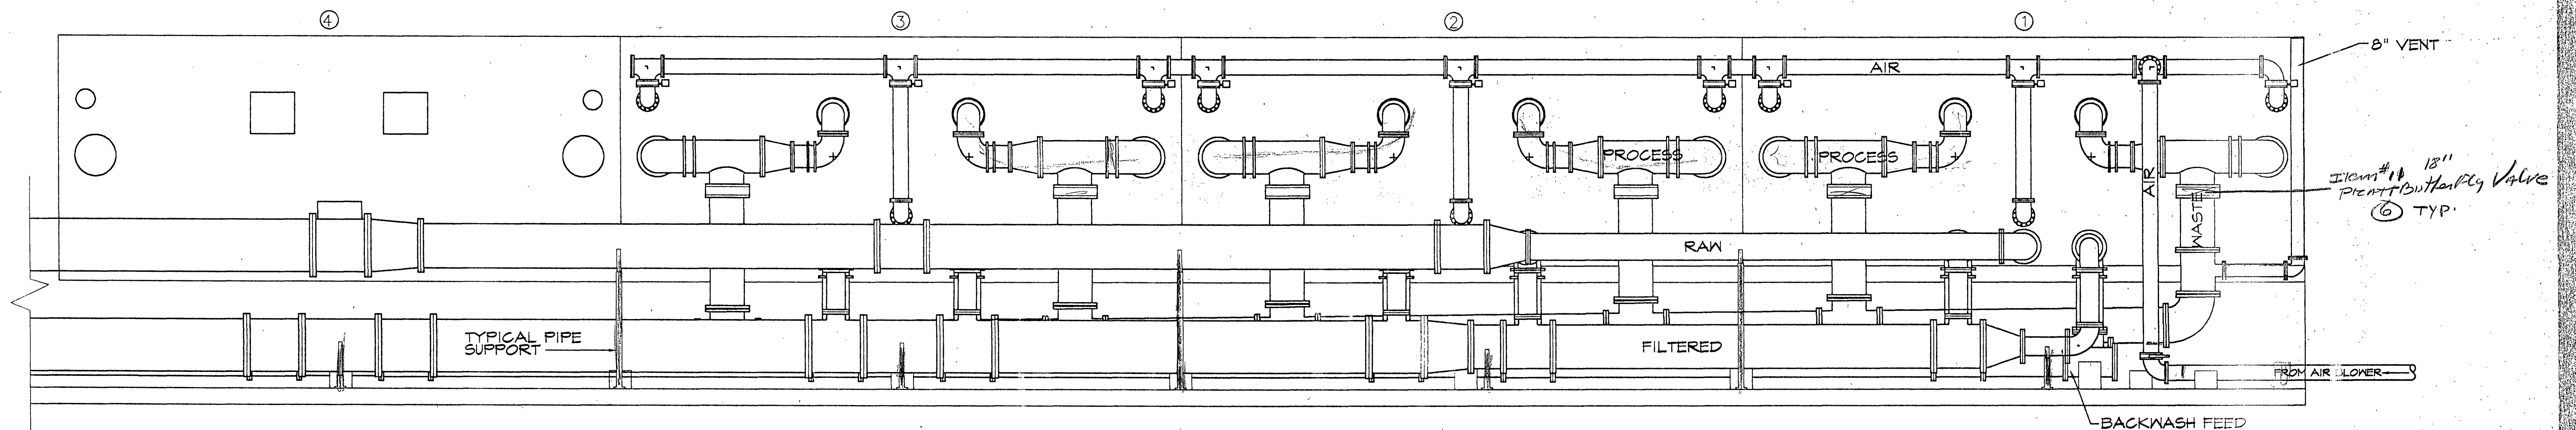


NORTH WALL PIPING ELEVATION - 15MG T3.2
SCALE 1" = 5'-0"
T2

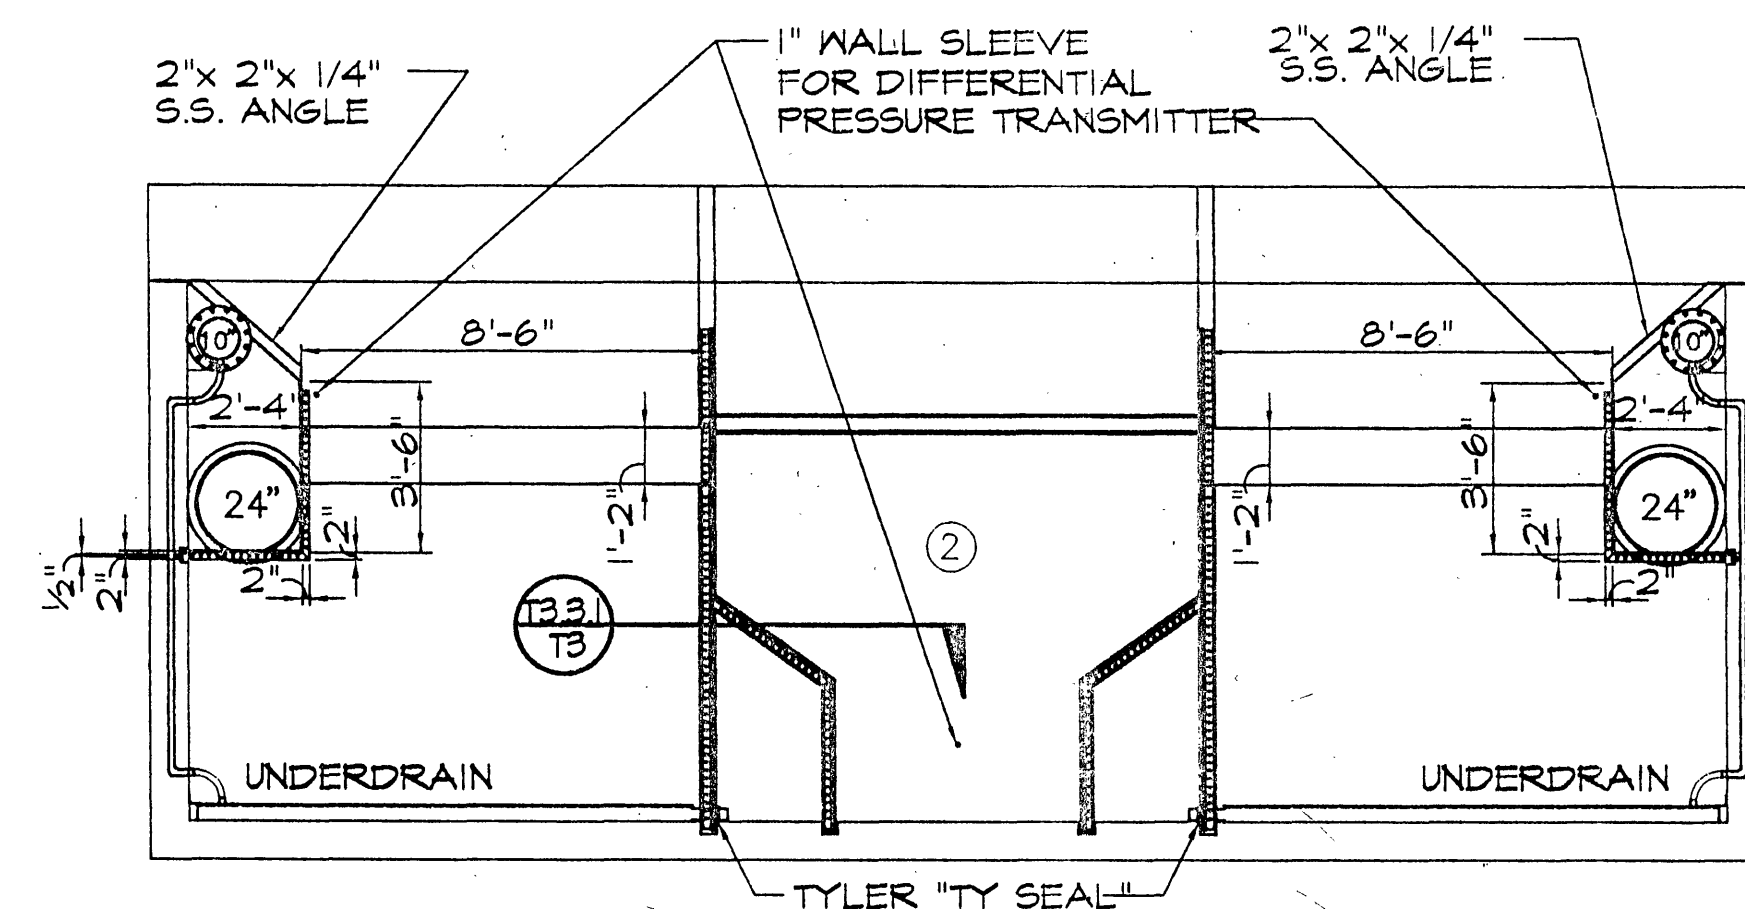


SECTION - TREATMENT UNIT NO. 2 T3.3
NOT TO SCALE
T2

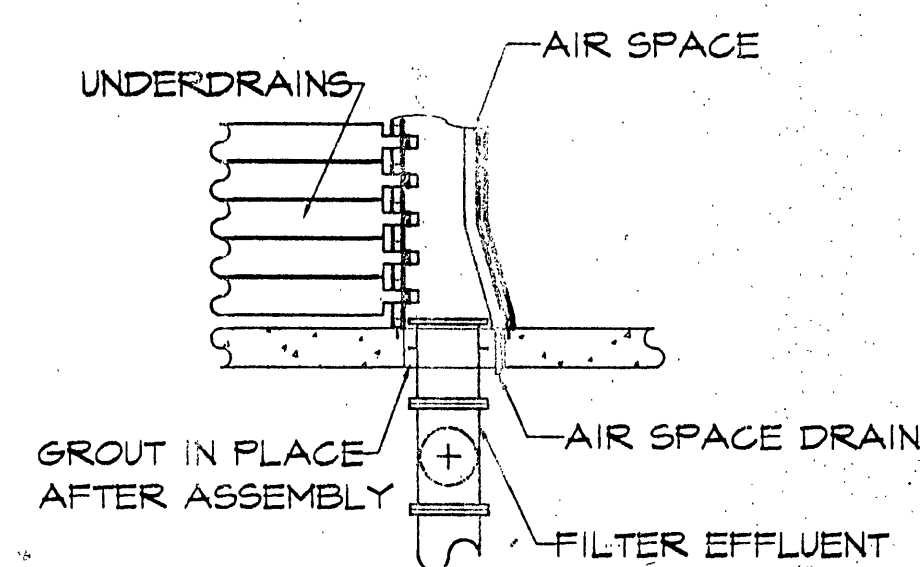

SECTION - 18" FILTERED PIPE T3.3.1
SCALE 1" = 5'-0"
T3

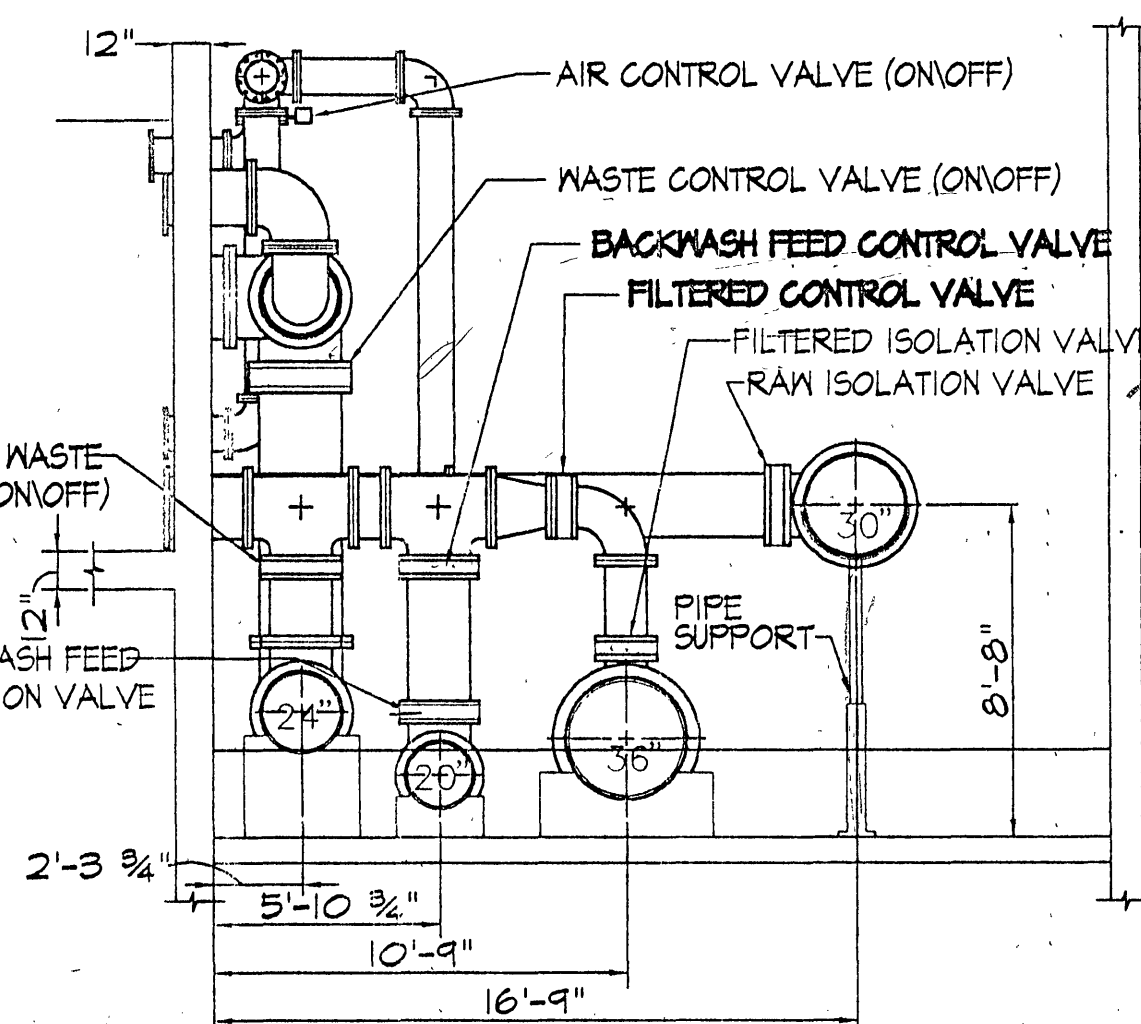


SECTION - PIPE GALLERY 15 MG T3.4
SCALE 1" = 5'-0" @ BASIN NO. 2
T2

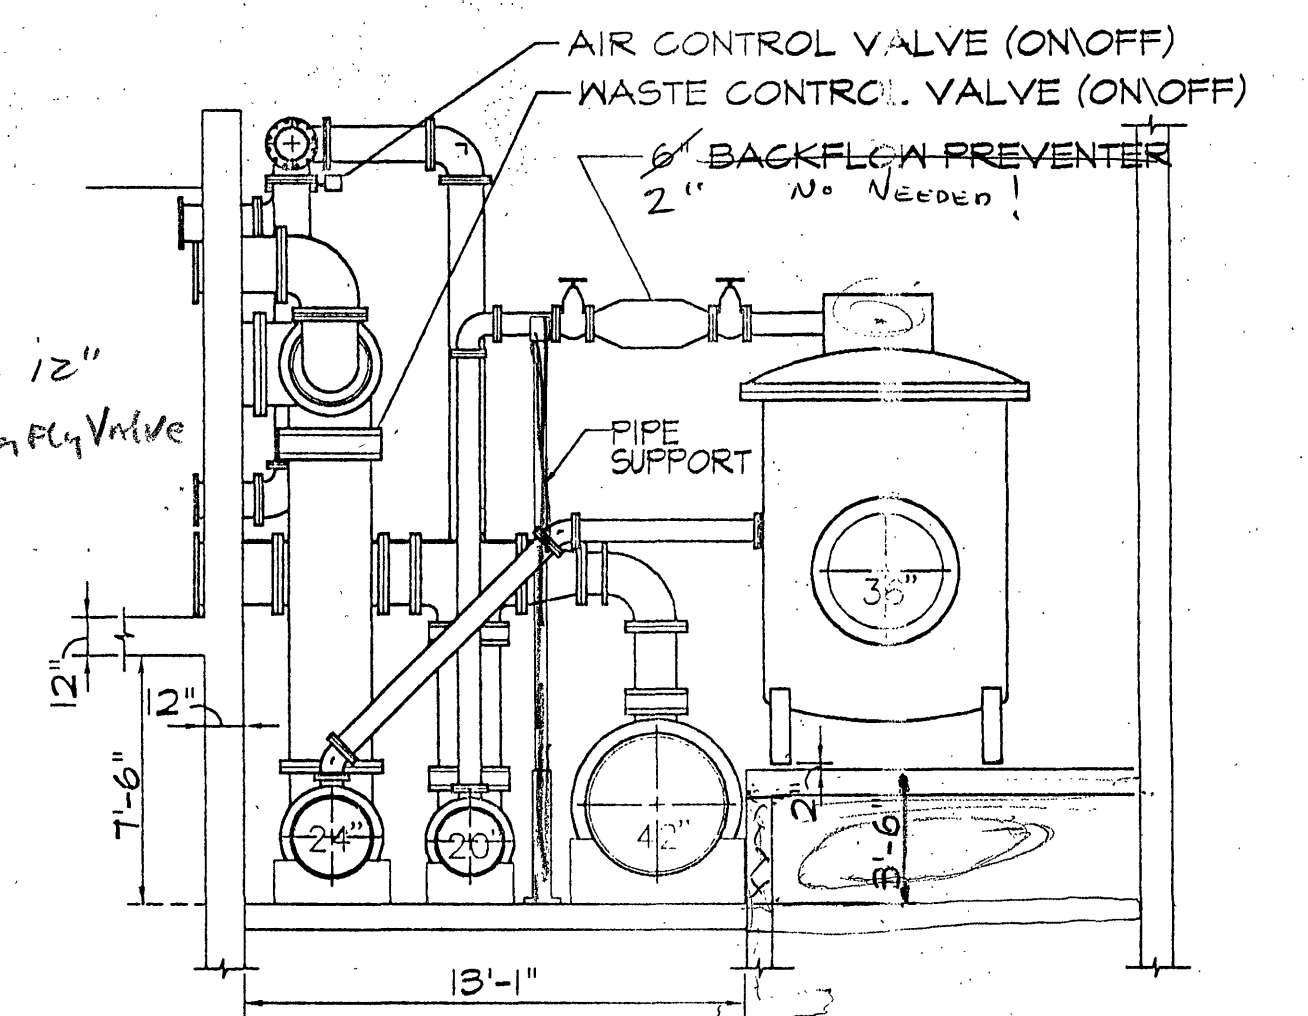



SECTION - PIPE GALLERY 5 MG T3.5
SCALE 1" = 5'-0"
T2

NOTES:
ALL CONTROL VALVES TO BE SUPPLIED BY OTHERS
CONTROL VALVE: MOTORIZED MODULATING BUTTERFLY VALVE WITH HAND OPERATOR
CONTROL VALVE (ON/OFF): MOTORIZED ON/OFF BUTTERFLY VALVE WITH HAND OPERATOR

INSPECTOR'S AS-BUILTS 1995

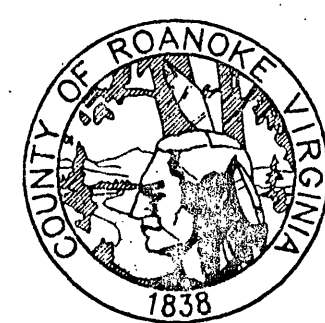

**ROANOKE COUNTY
WATER TREATMENT
FACILITY**

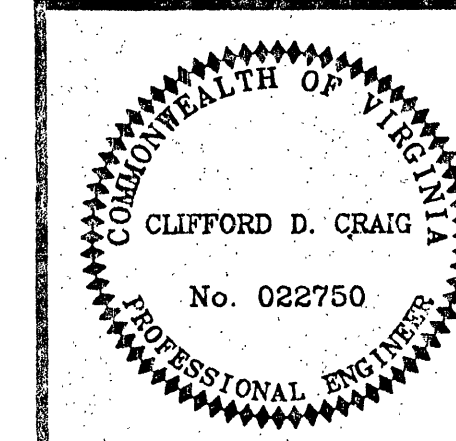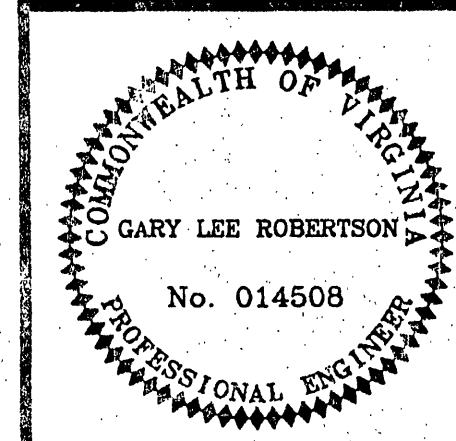

**TREATMENT BUILDING
TREATMENT SYSTEM ELEVATIONS**

DESIGN ENGINEER
CLIFFORD D. CRAIG

COMMISSION NUMBER
1913

RCUD NUMBER
WTF-1

DATE
9 SEPT. 1994

T3

ROANOKE COUNTY UTILITY DEPARTMENT

WWW.D#8LDLZ