


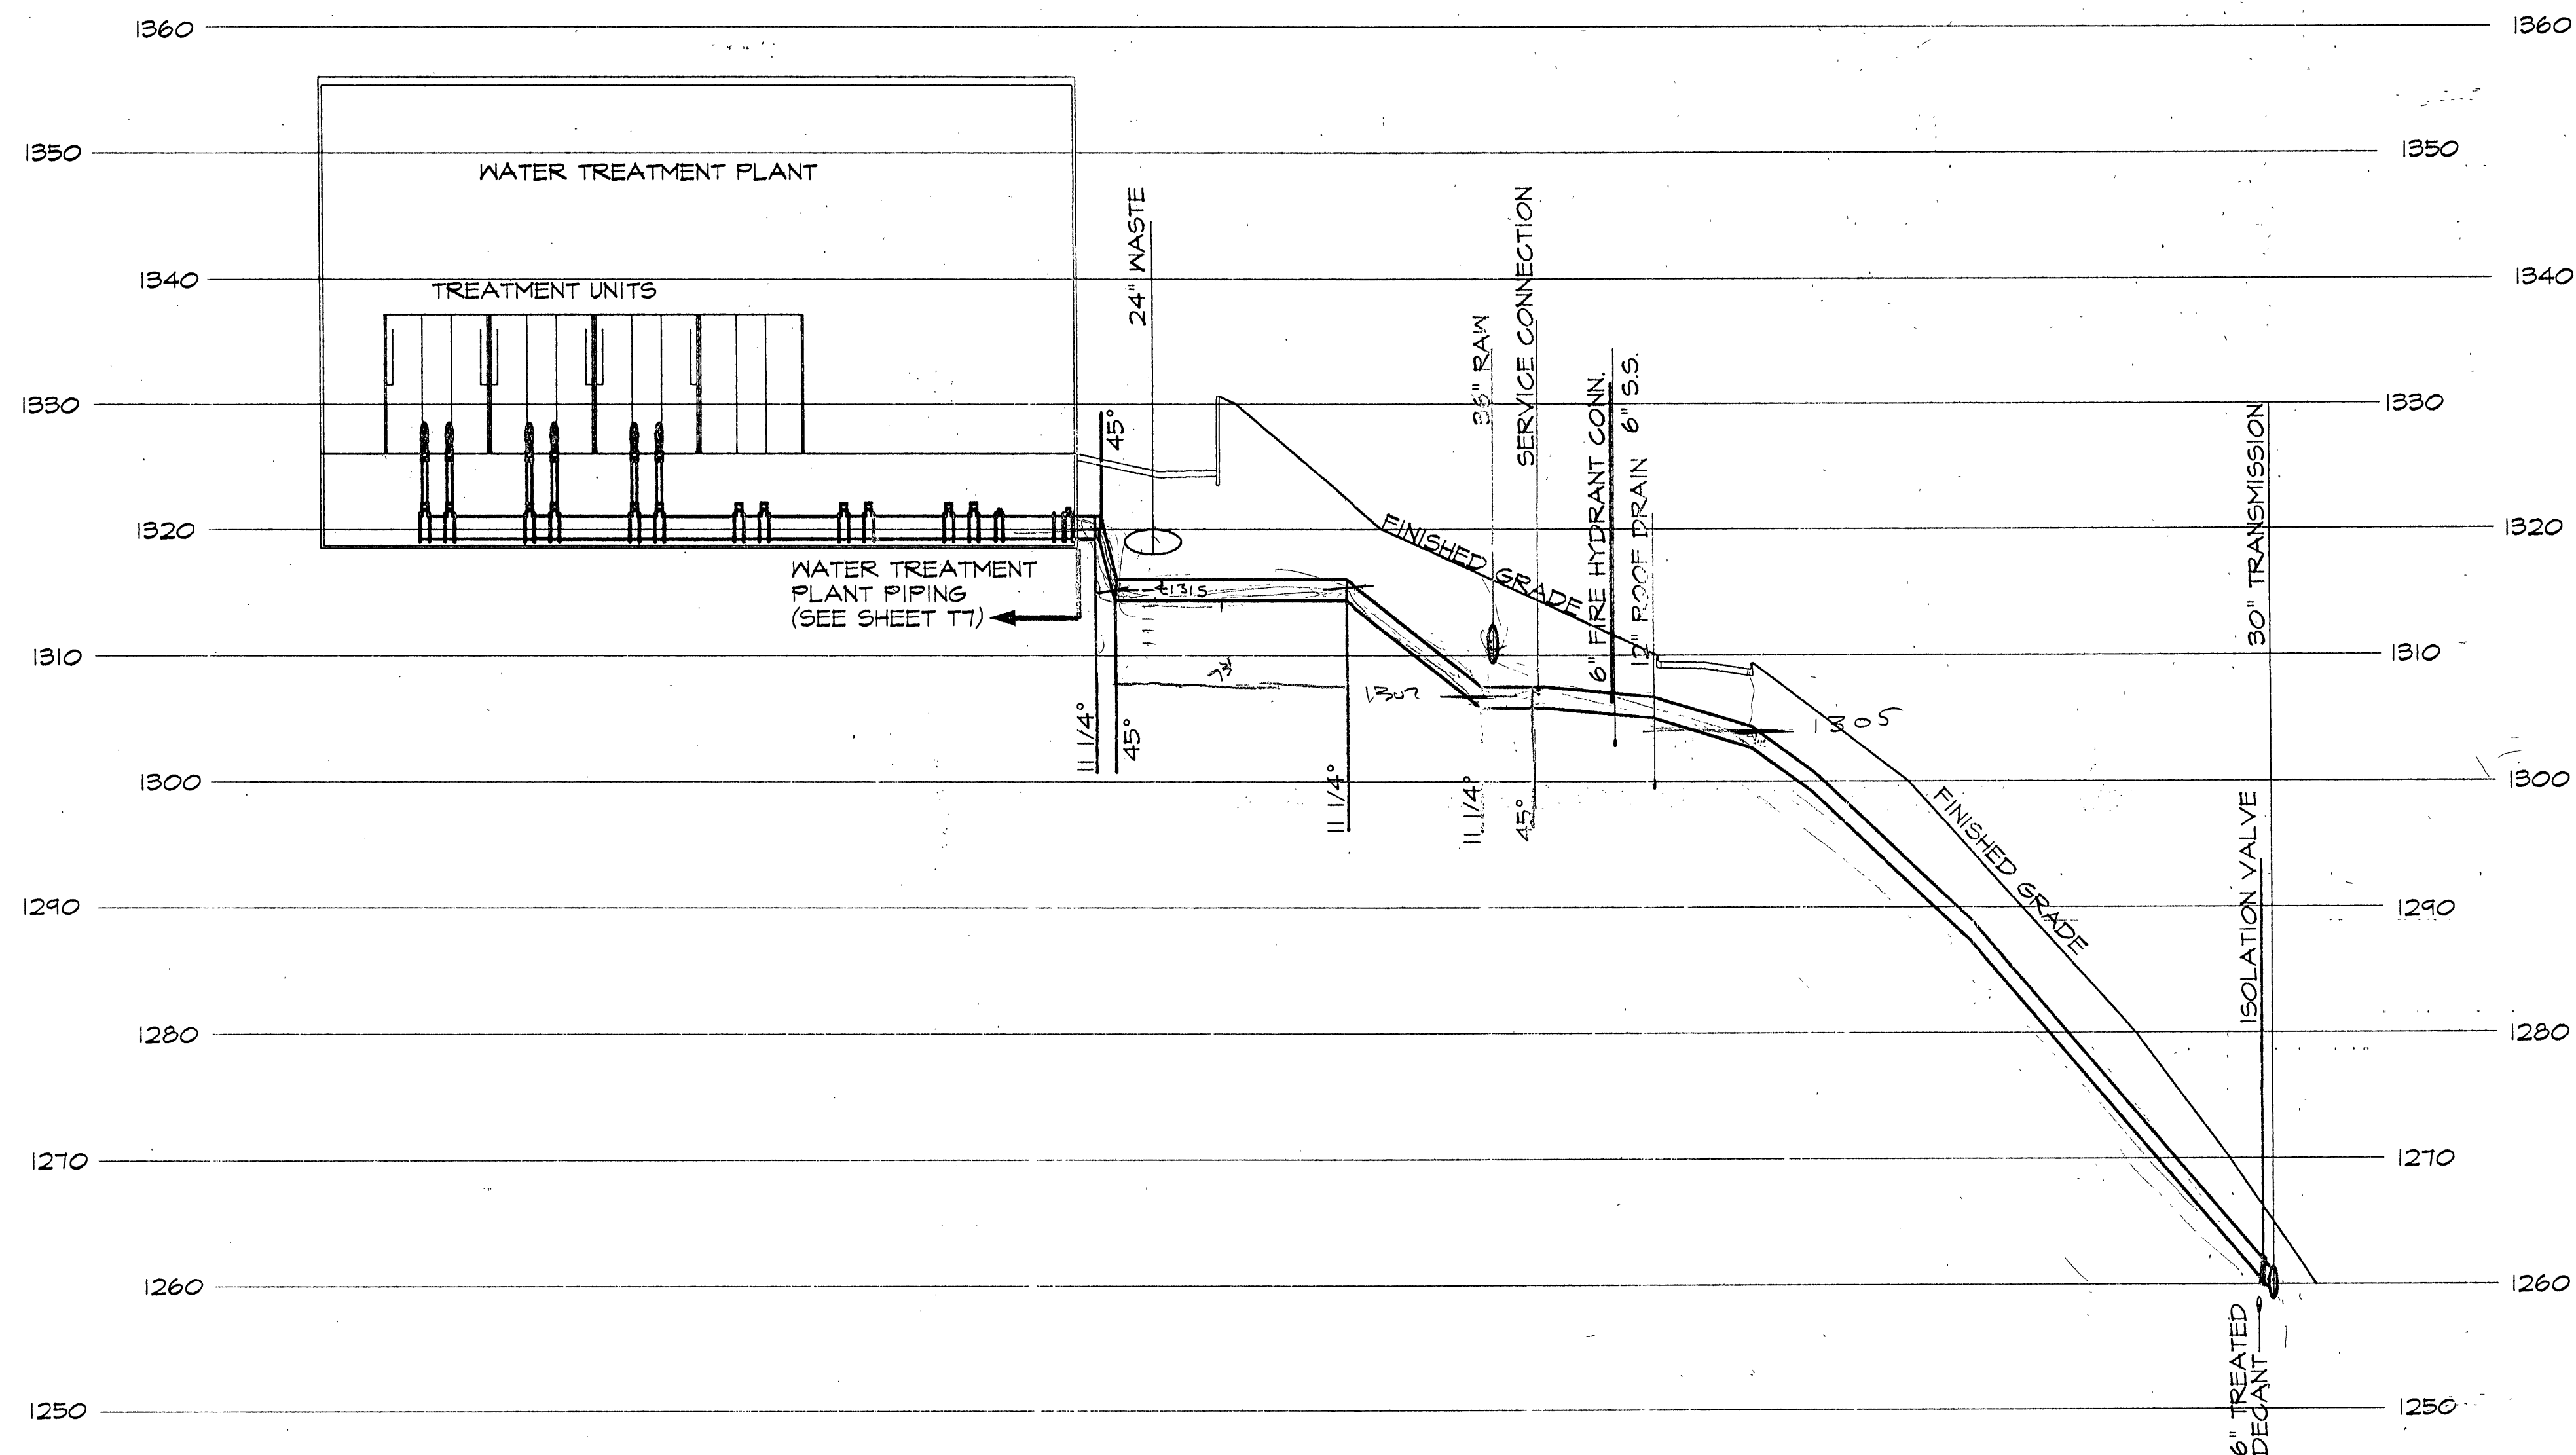


BACKWASH FEED LINE PROFILE
 SCALE VERT 1" = 10'-0"
 HORIZ 1" = 40'-0"

NOTE



1. ALL BACKWASH FEED PIPING AND FITTINGS TO BE CLASS 52 DUCTILE IRON EXCEPT FOR WATER TREATMENT PLANT PIPING

INSPECTOR'S AS-BUILTS 1995

WWW ID# 8LDLUIZ

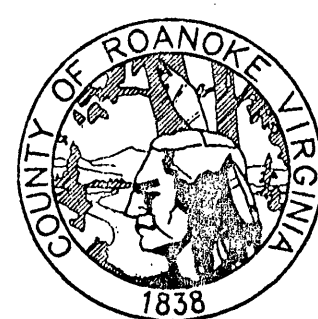

ROANOKE COUNTY WATER TREATMENT FACILITY

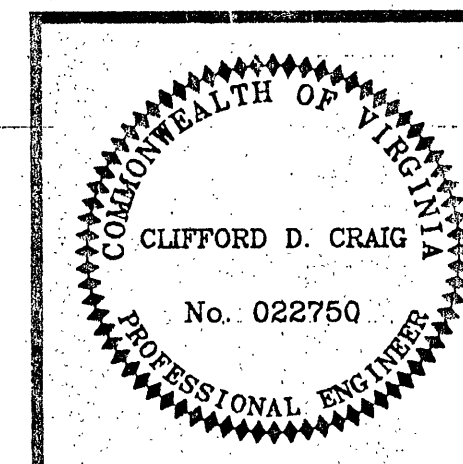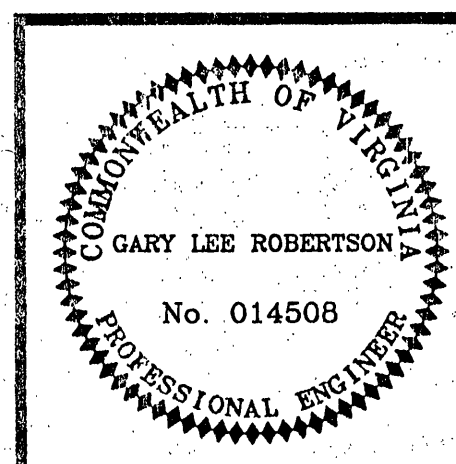

BACKWASH FEED LINE PROFILE	
DESIGN ENGINEER CLIFFORD D. CRAIG	COMMISSION NUMBER 1913
RCUD NUMBER WTF-1	DATE 12 SEPT. 1994

T14