


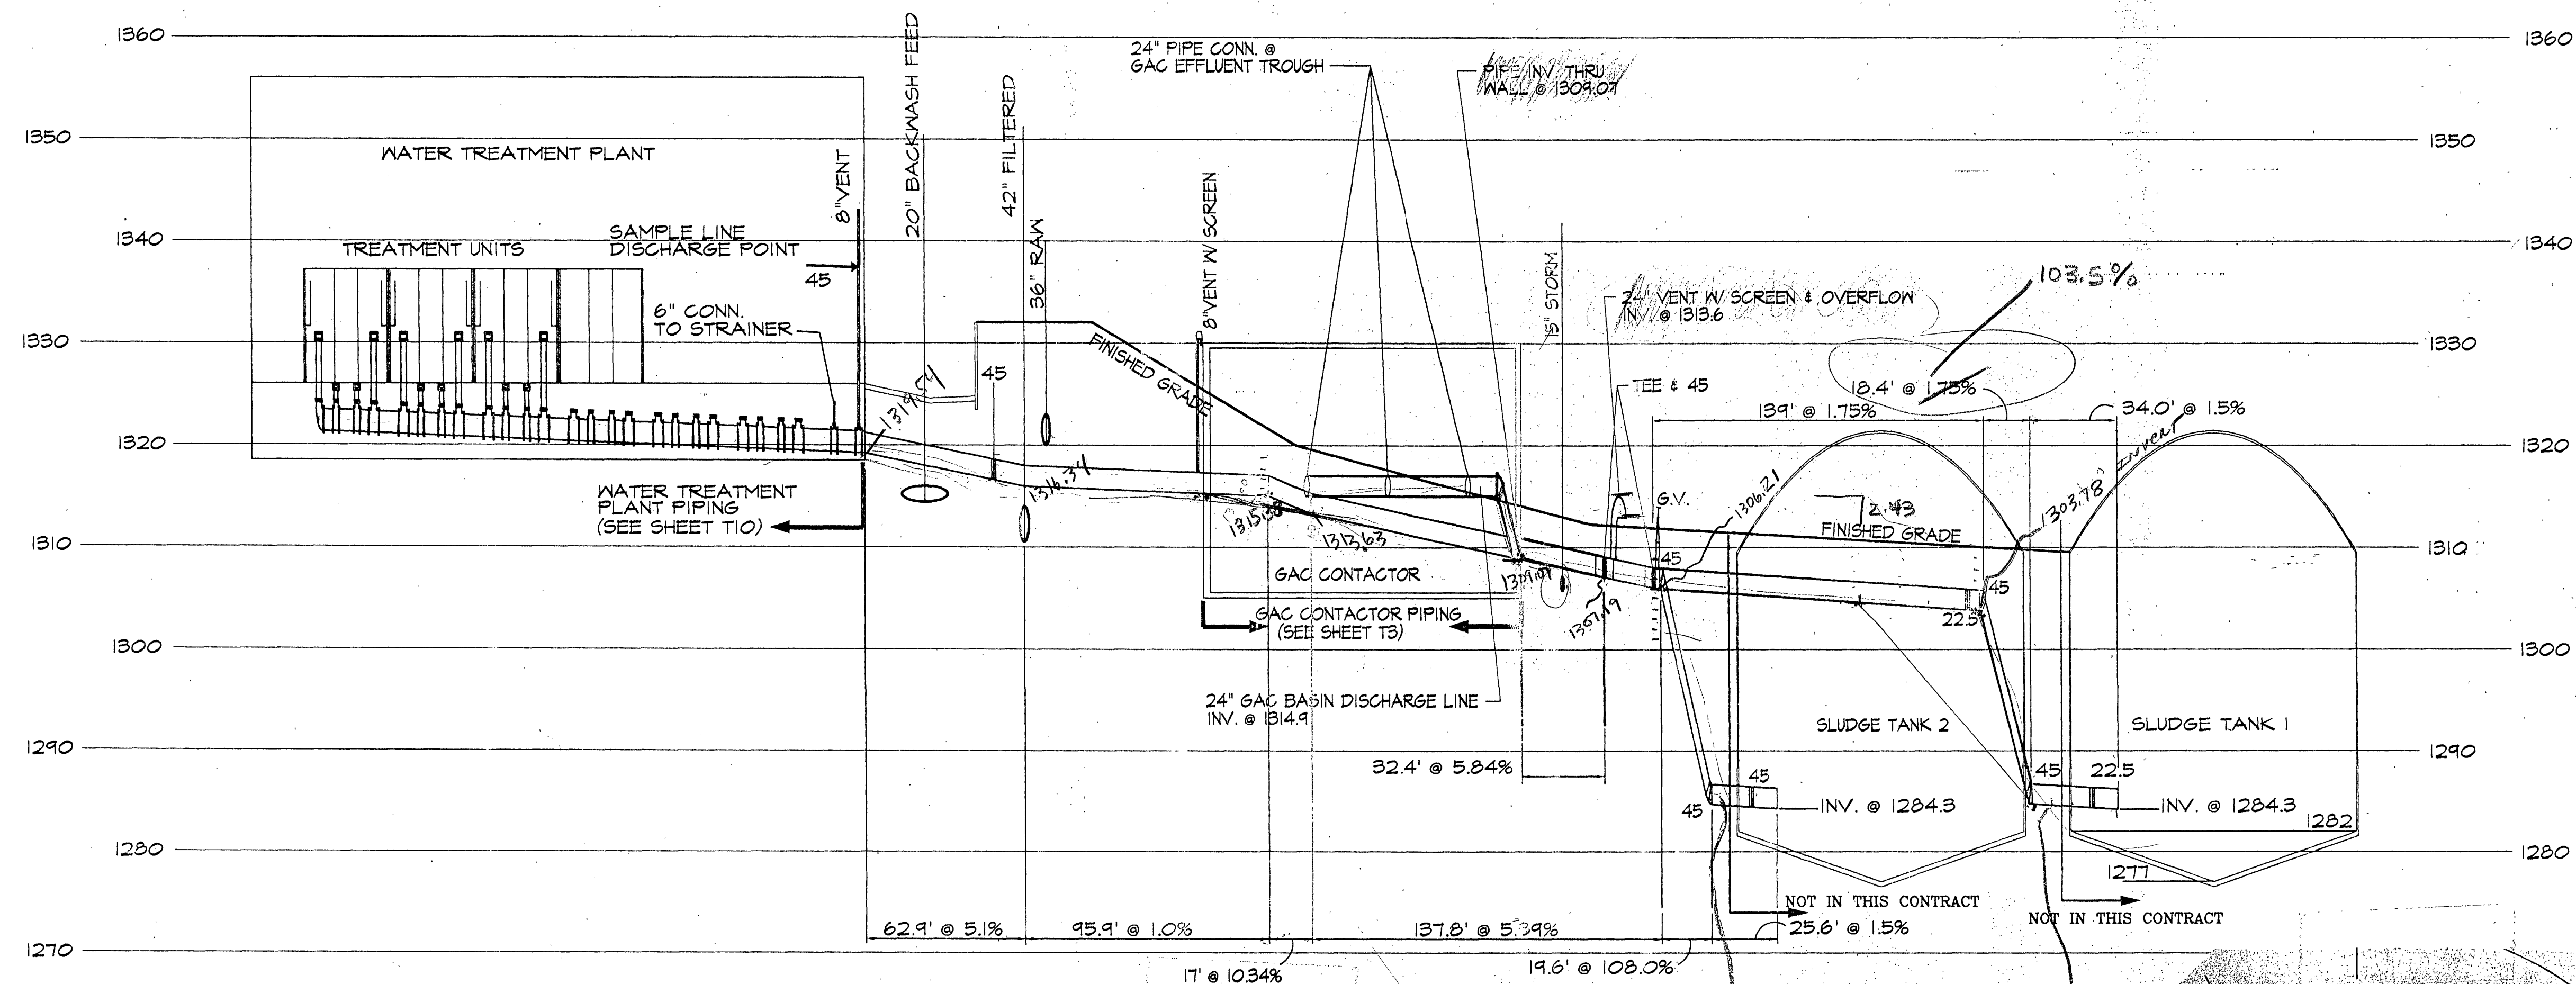




WASTE LINE PROFILE
SCALE VERT 1" = 10'-0"
HORIZ 1" = 40'-0"

NOTES



1. ALL WASTE PIPING AND FITTINGS TO BE CLASS 52 DUCTILE IRON EXCEPT FOR WATER TREATMENT PLANT PIPING
2. SEE SHEET T3 FOR PIPING IN GRANULAR ACTIVATED CARBON (GAC) CONTACTOR
3. COORDINATE WITH TANK INSTALLATION FOR CONNECTIONS TO SLUDGE TANKS
4. ALL EXTERIOR VENTS SHALL BE PROPERLY SCREENED

INSPECTOR'S AS-BUILTS 1995

WWW.ID# 6LDLUIZ

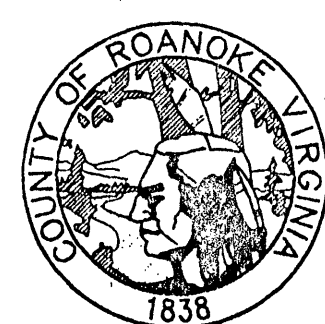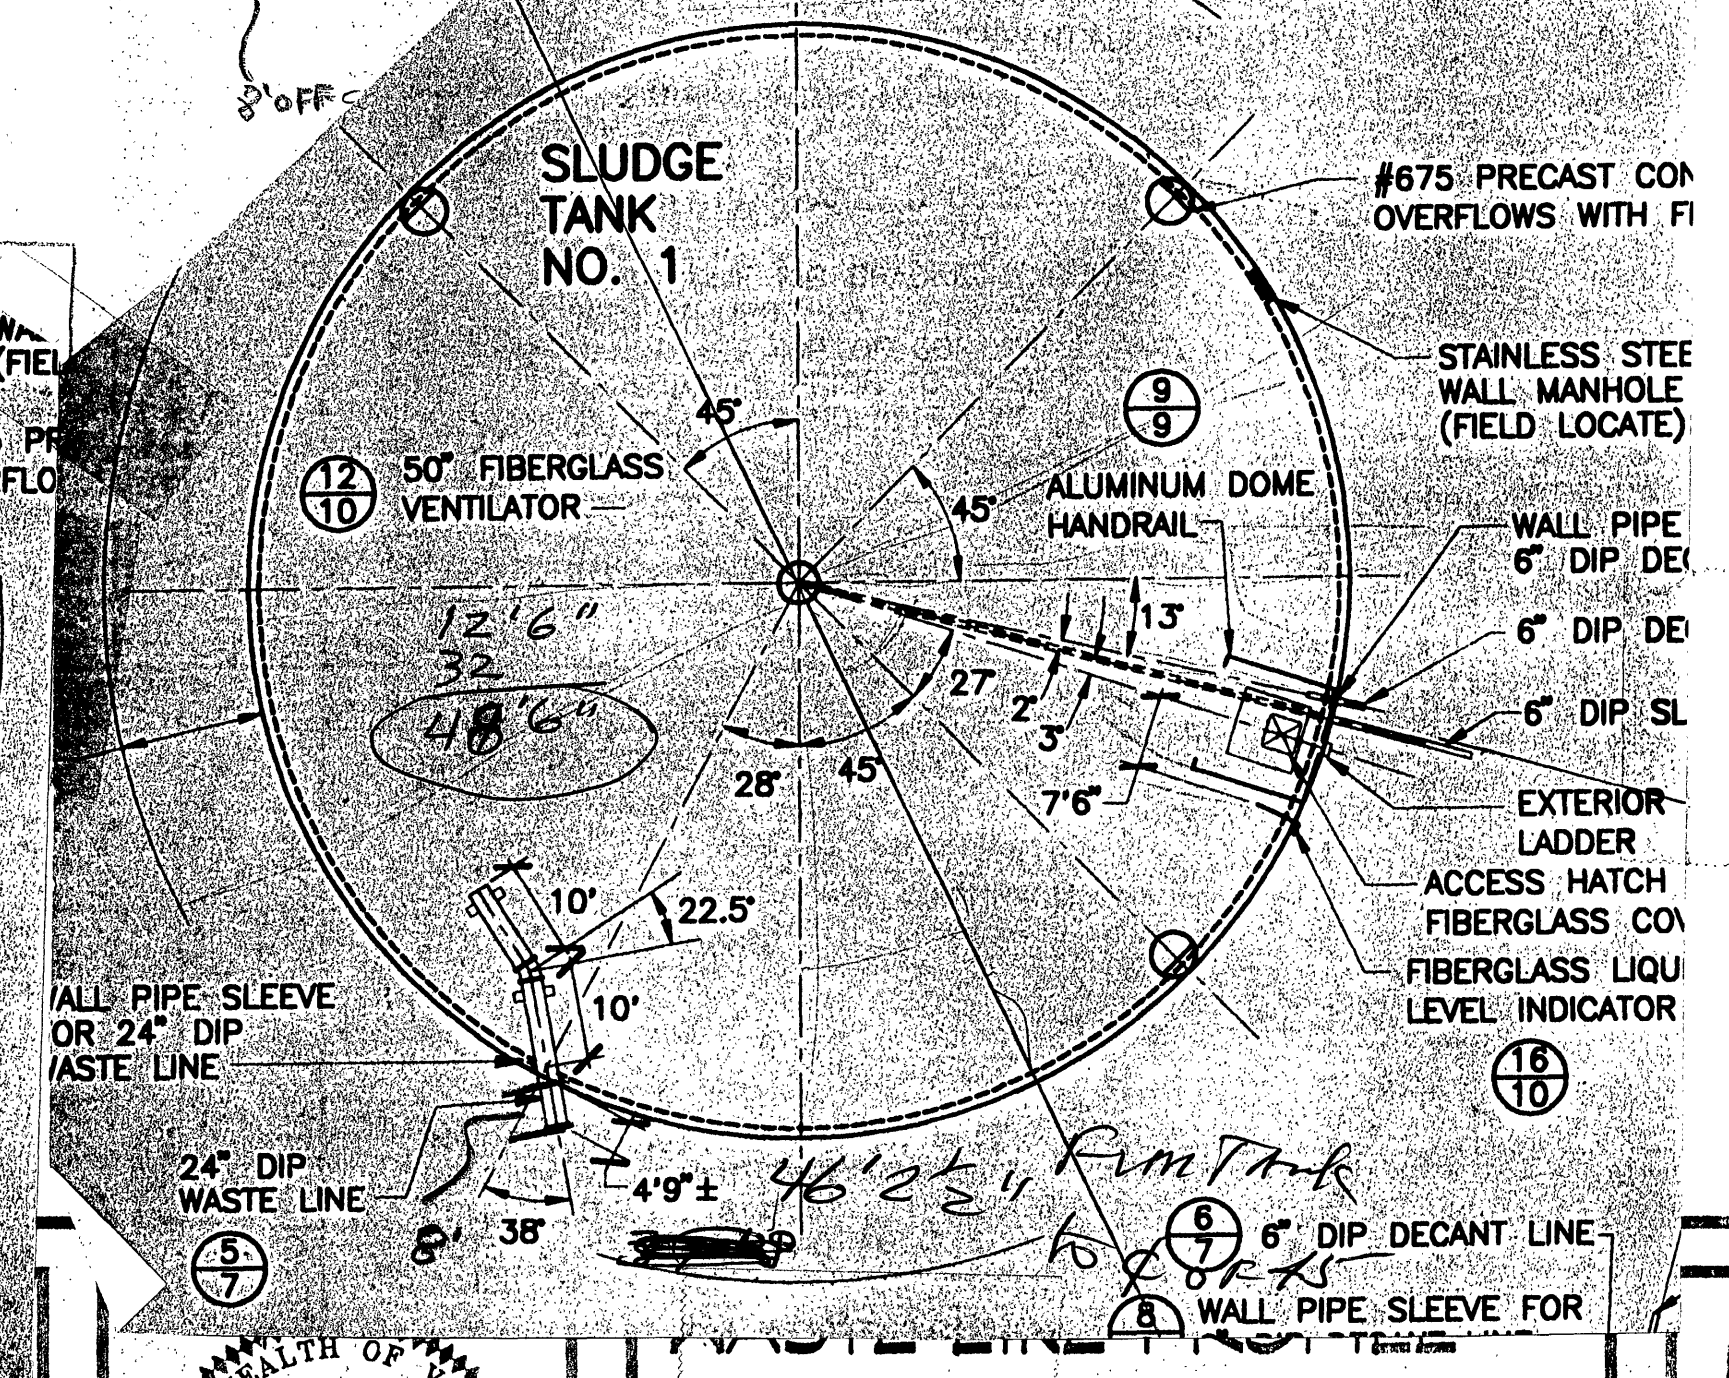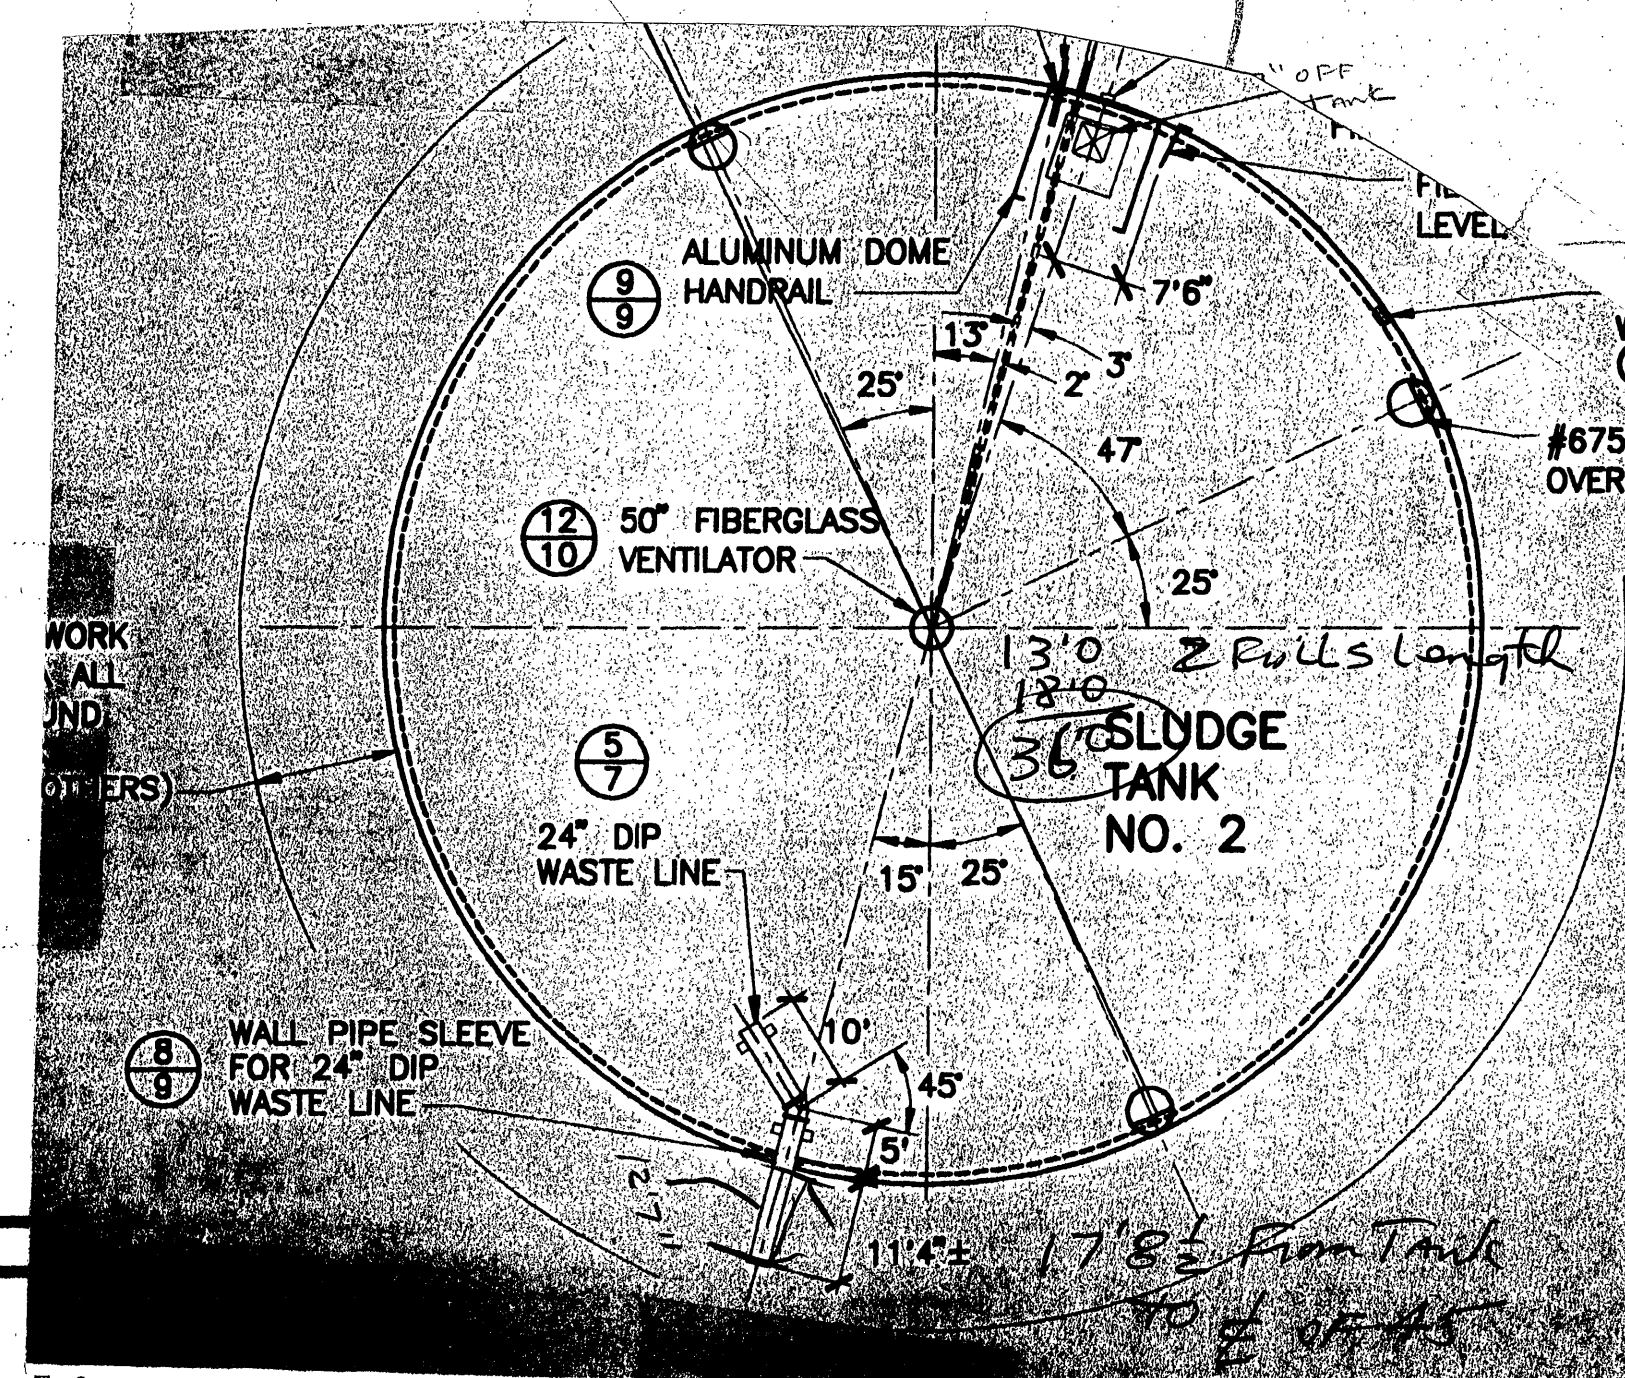

ROANOKE COUNTY
WATER TREATMENT
FACILITY

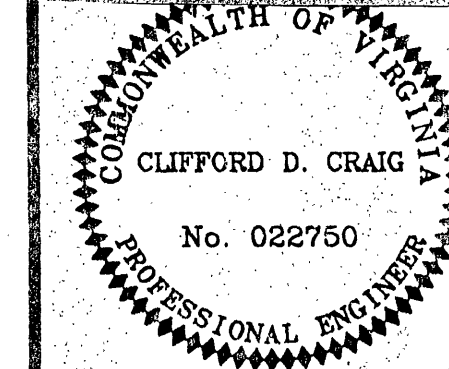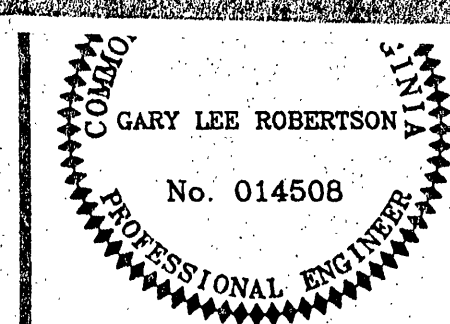

DESIGN ENGINEER
CLIFFORD D. CRAIG

COMMISSION NUMBER
1913

RCUD NUMBER
WTF-1

DATE
12 SEPT. 1994

T15

ROANOKE COUNTY UTILITY DEPARTMENT