


- NOTES
1. TRANSMISSION LINES AND FITTINGS TO BE CLASS 52 MECHANICAL JOINT DUCTILE IRON
 2. 6 INCH TREATED DECANT LINE AND FITTING TO BE SDR-21 PVC
 3. 4 INCH SANITARY SEWER FORCE MAIN TO BE SDR-21 PVC





INSPECTOR'S AS-BUILTS 1995

WVWA ID# 6LDLUZ

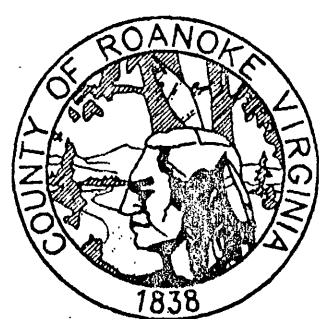

ROANOKE COUNTY WATER TREATMENT FACILITY

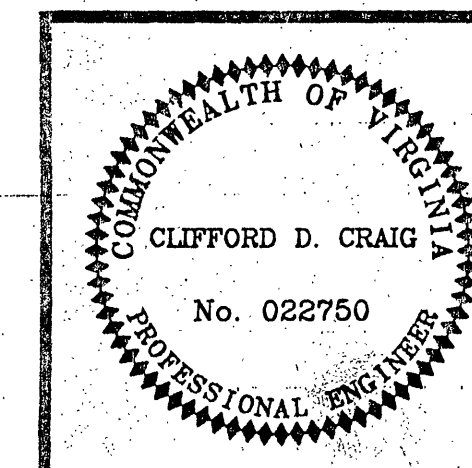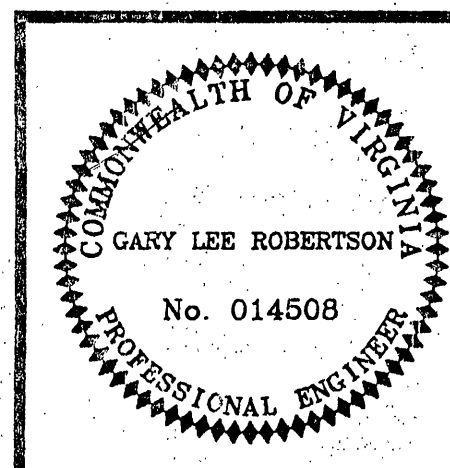

DATE
15 SEPT. 1994

T17

ROANOKE COUNTY UTILITY DEPARTMENT