



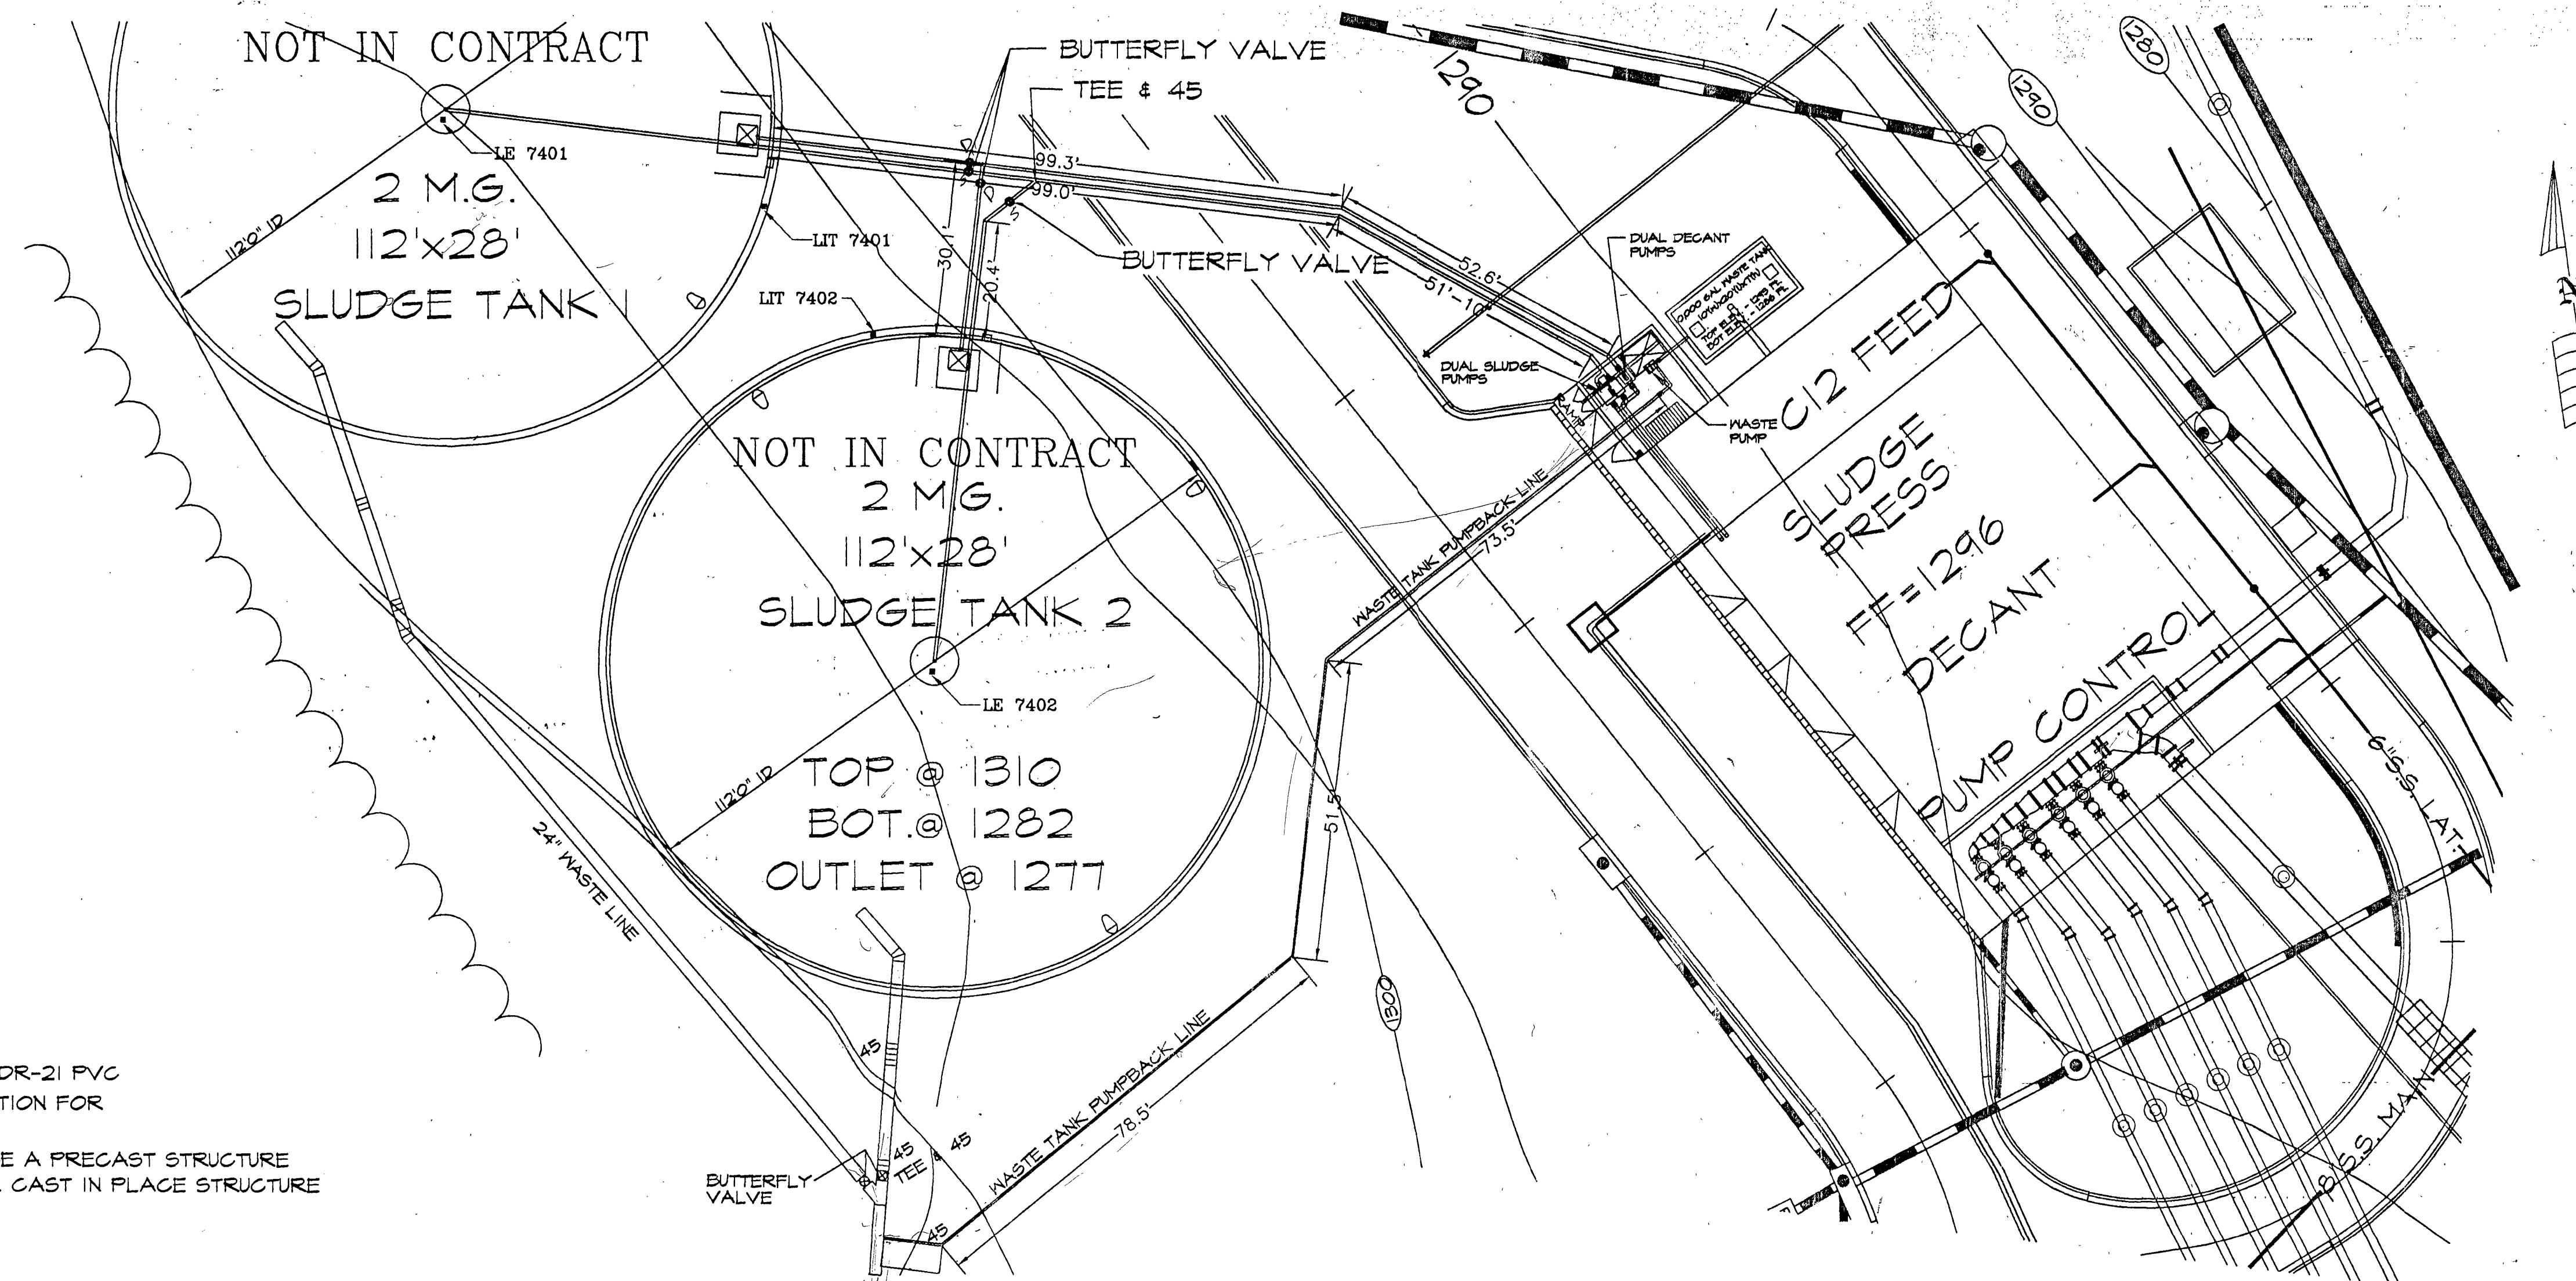

- NOTES
1. ALL PIPING AND FITTINGS TO BE SDR-21 PVC
 2. COORDINATE WITH TANK INSTALLATION FOR CONNECTIONS TO SLUDGE TANKS
 3. 10,000 GALLON WASTE TANK TO BE A PRECAST STRUCTURE DESIGNED FOR THIS USE OR EQUAL CAST IN PLACE STRUCTURE

DECANT TREATMENT AND SLUDGE PRESS FEED LINE
SCALE VERT 1" = 20'-0"

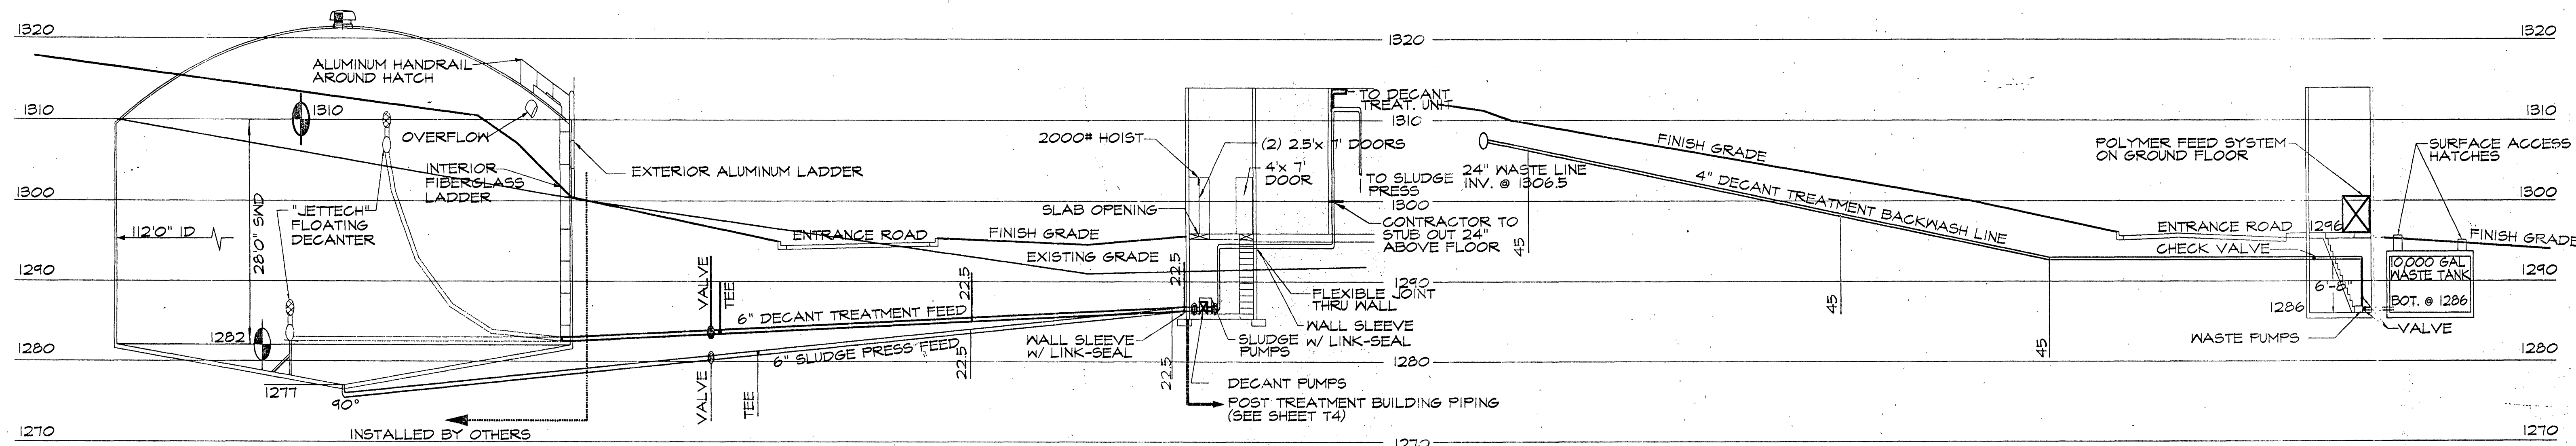


DECANT TREATMENT AND SLUDGE PRESS FEED LINE PROFILE
SCALE VERT 1" = 10'-0"
HORIZ 1" = 20'-0"



WASTE TANK PUMPBACK LINE PROFILE
SCALE VERT 1" = 10'-0"
HORIZ 1" = 20'-0"

INSPECTOR'S AS-BUILTS 1995

WWW.ID# BLDLIZ

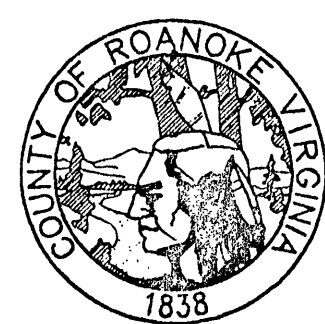

**ROANOKE COUNTY
WATER TREATMENT
FACILITY**

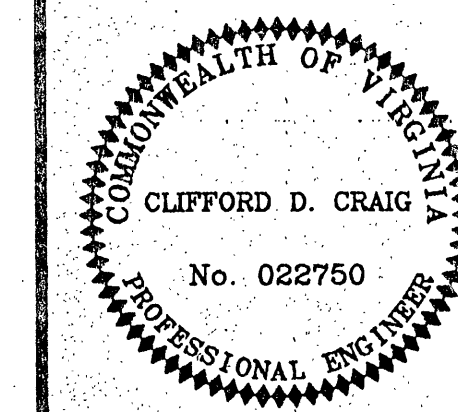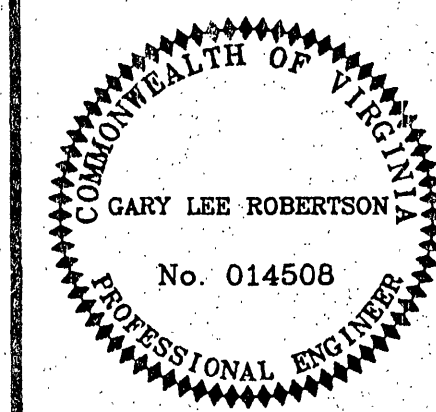

DECANT AND SLUDGE PRESS LINE PROFILE

DESIGN ENGINEER
CLIFFORD D. CRAIG

COMMISSION NUMBER
1913

RCUD NUMBER
WTF-1

DATE
15 SEPT. 1994

T18

ROANOKE COUNTY UTILITY DEPARTMENT