



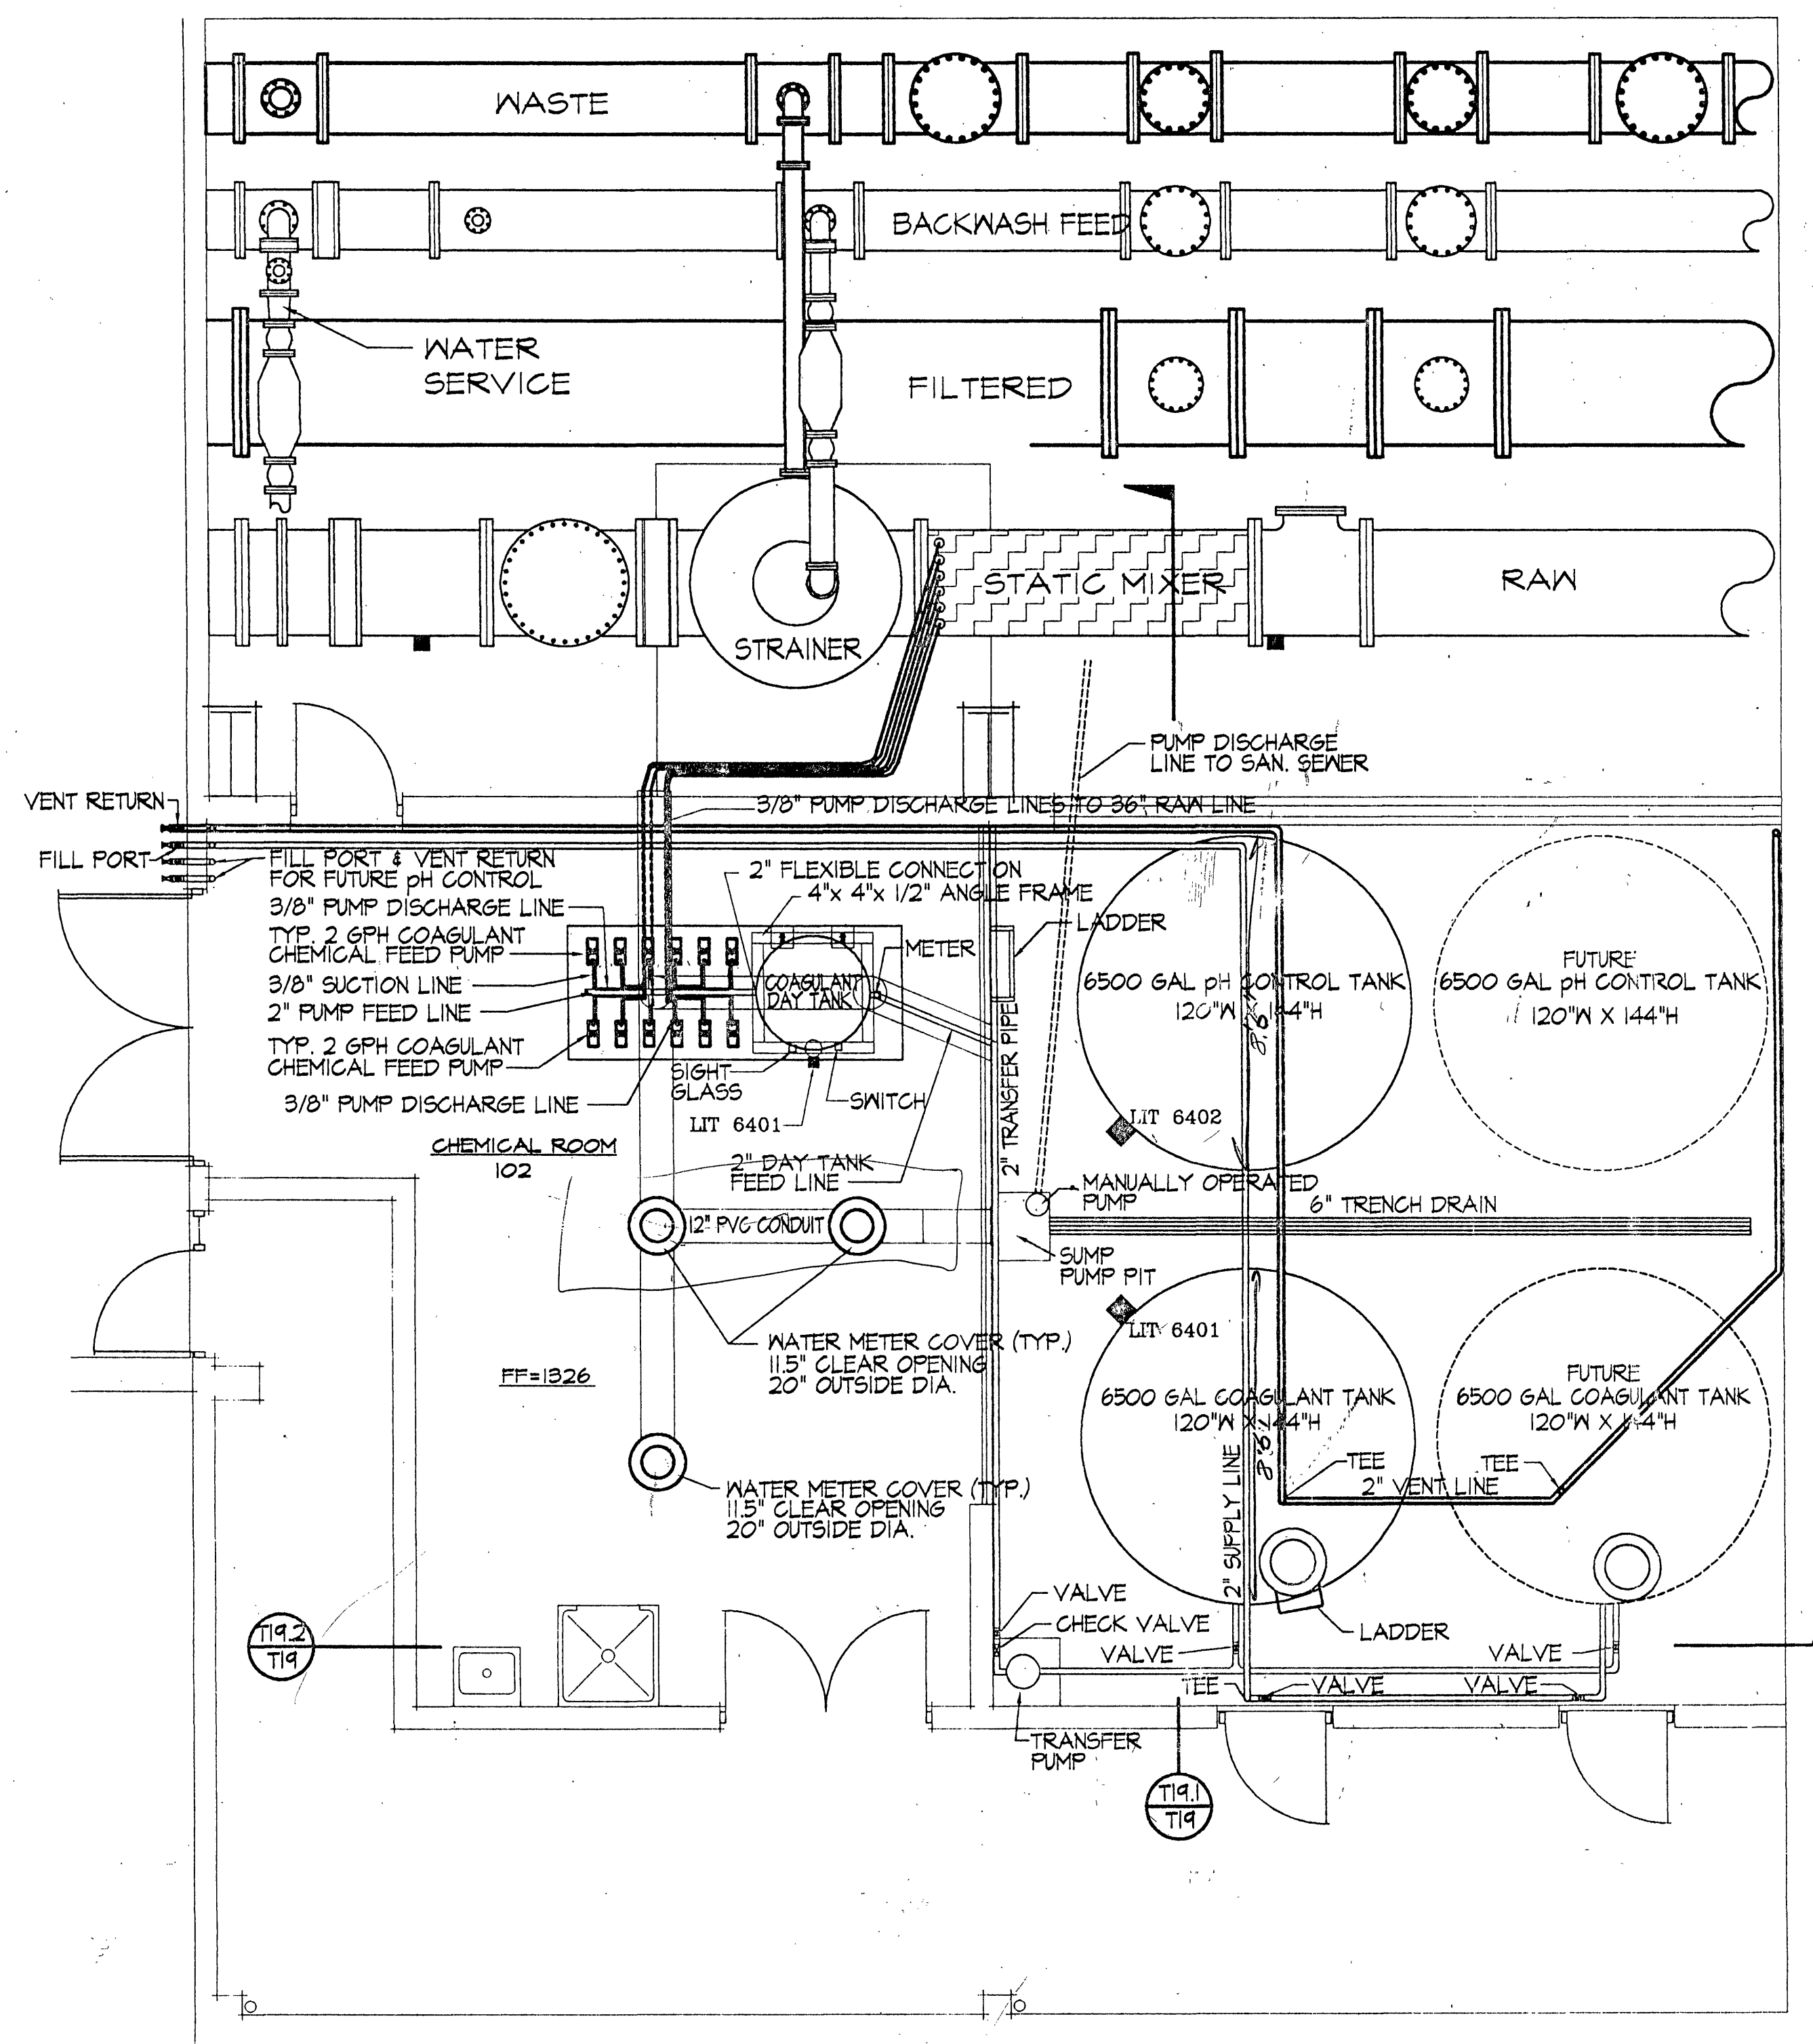


PLAN
SCALE 1" = 5'-0"

INSPECTOR'S AS-BUILTS 1995


WVWA ID# 6LDLUZ

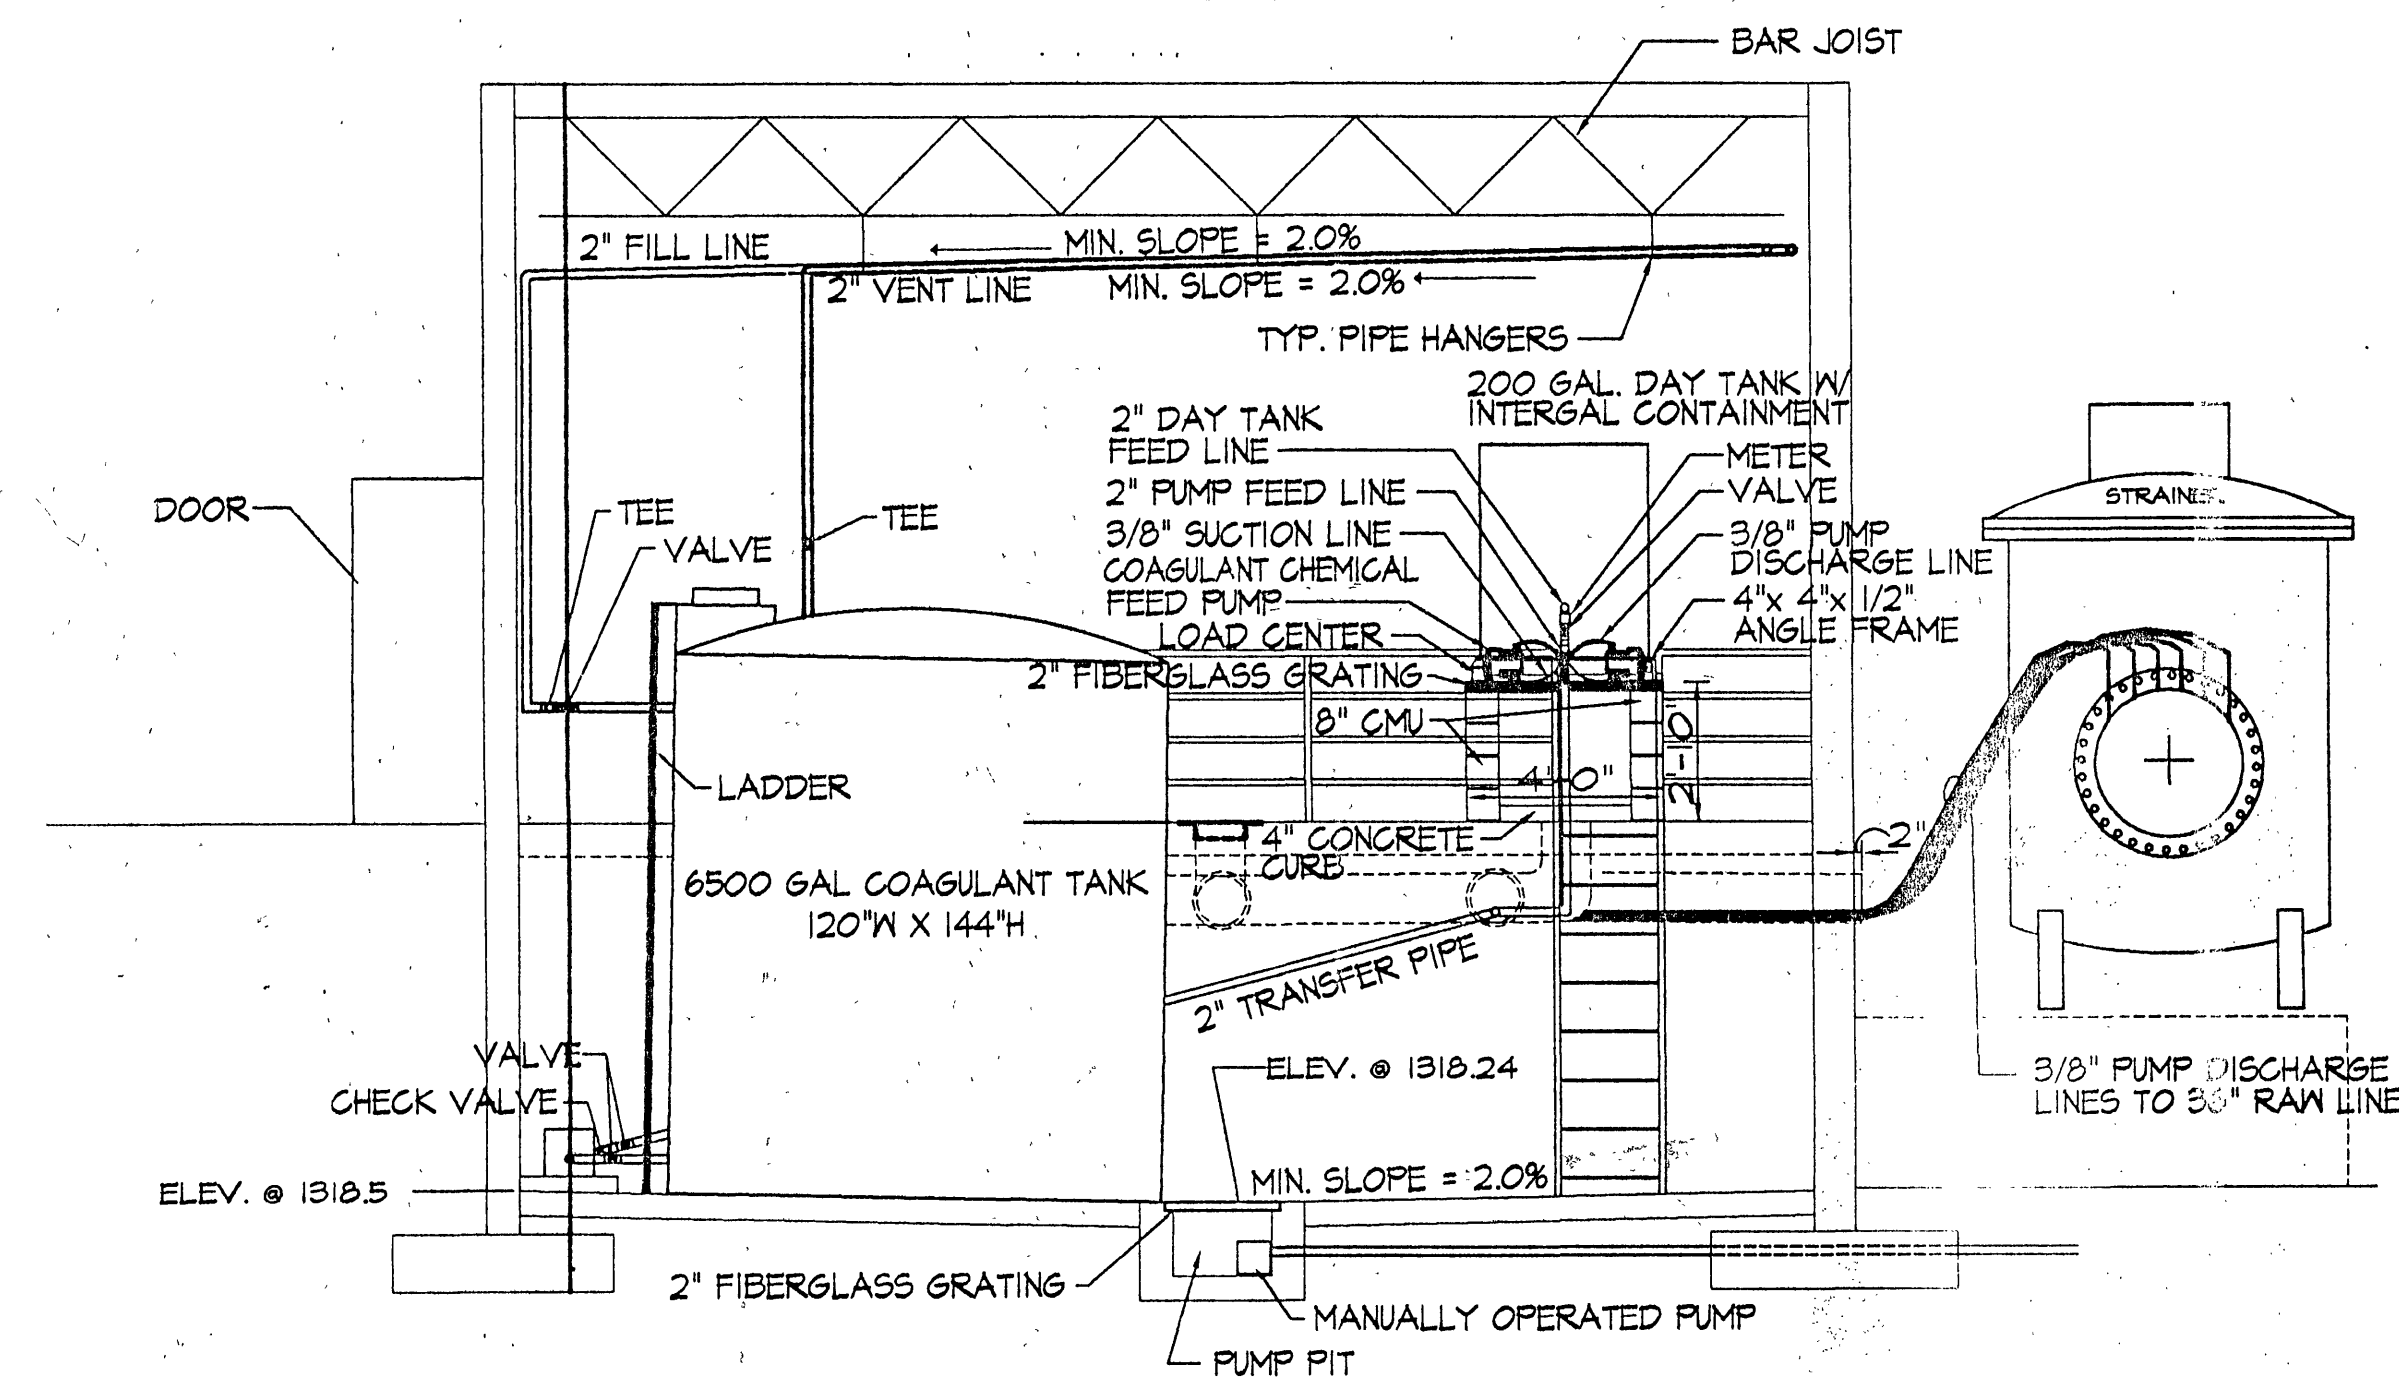



SECTION
SCALE: 1" = 5'-0"

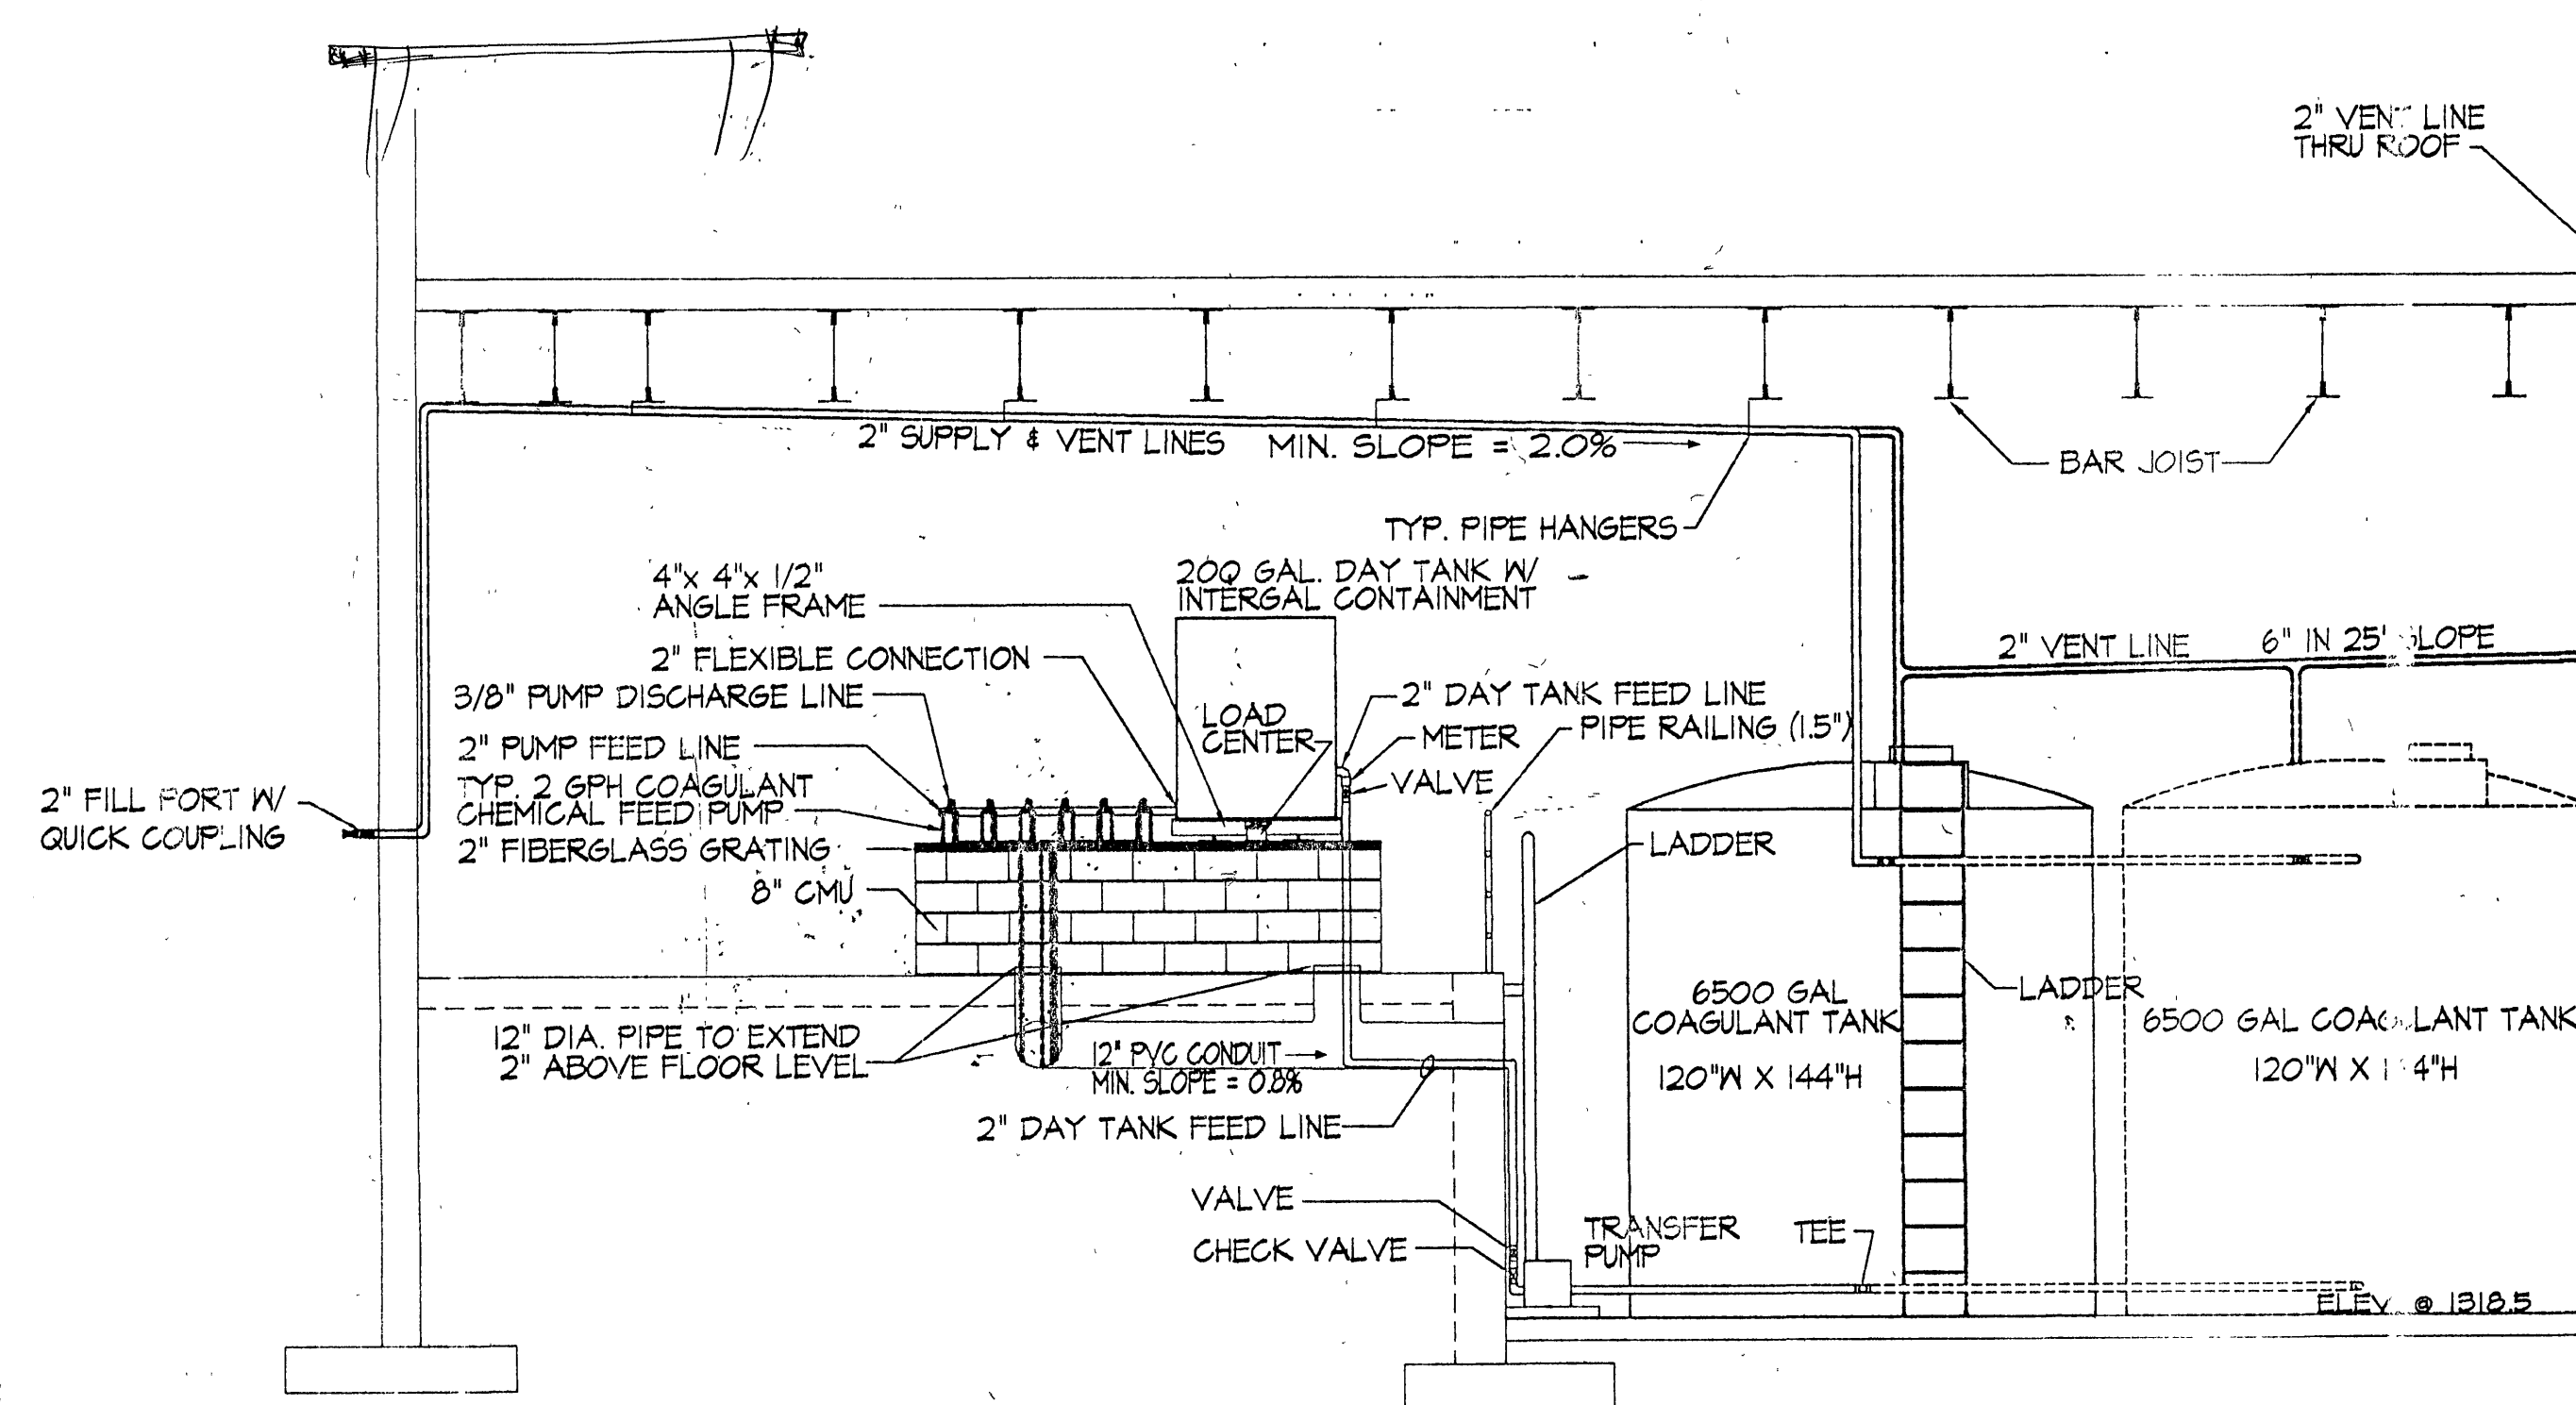

SECTION
SCALE 1" = 5'-0"

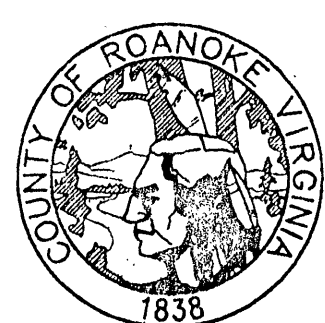

ROANOKE COUNTY WATER TREATMENT FACILITY

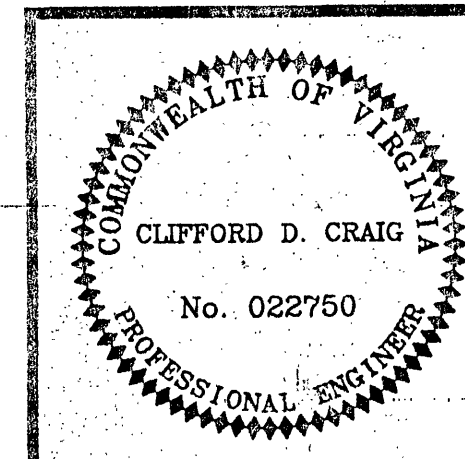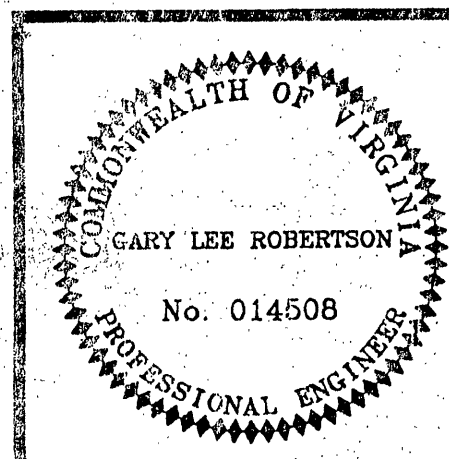

CHEMICAL ROOM DIAGRAMS

DESIGN ENGINEER
CLIFFORD D. CRAIG

COMMISSION NUMBER

1913

RCUD NUMBER
WTF-1

DATE
15 SEPT. 1994

T19

BOANOE COUNTY UTILITY DEPARTMENT