


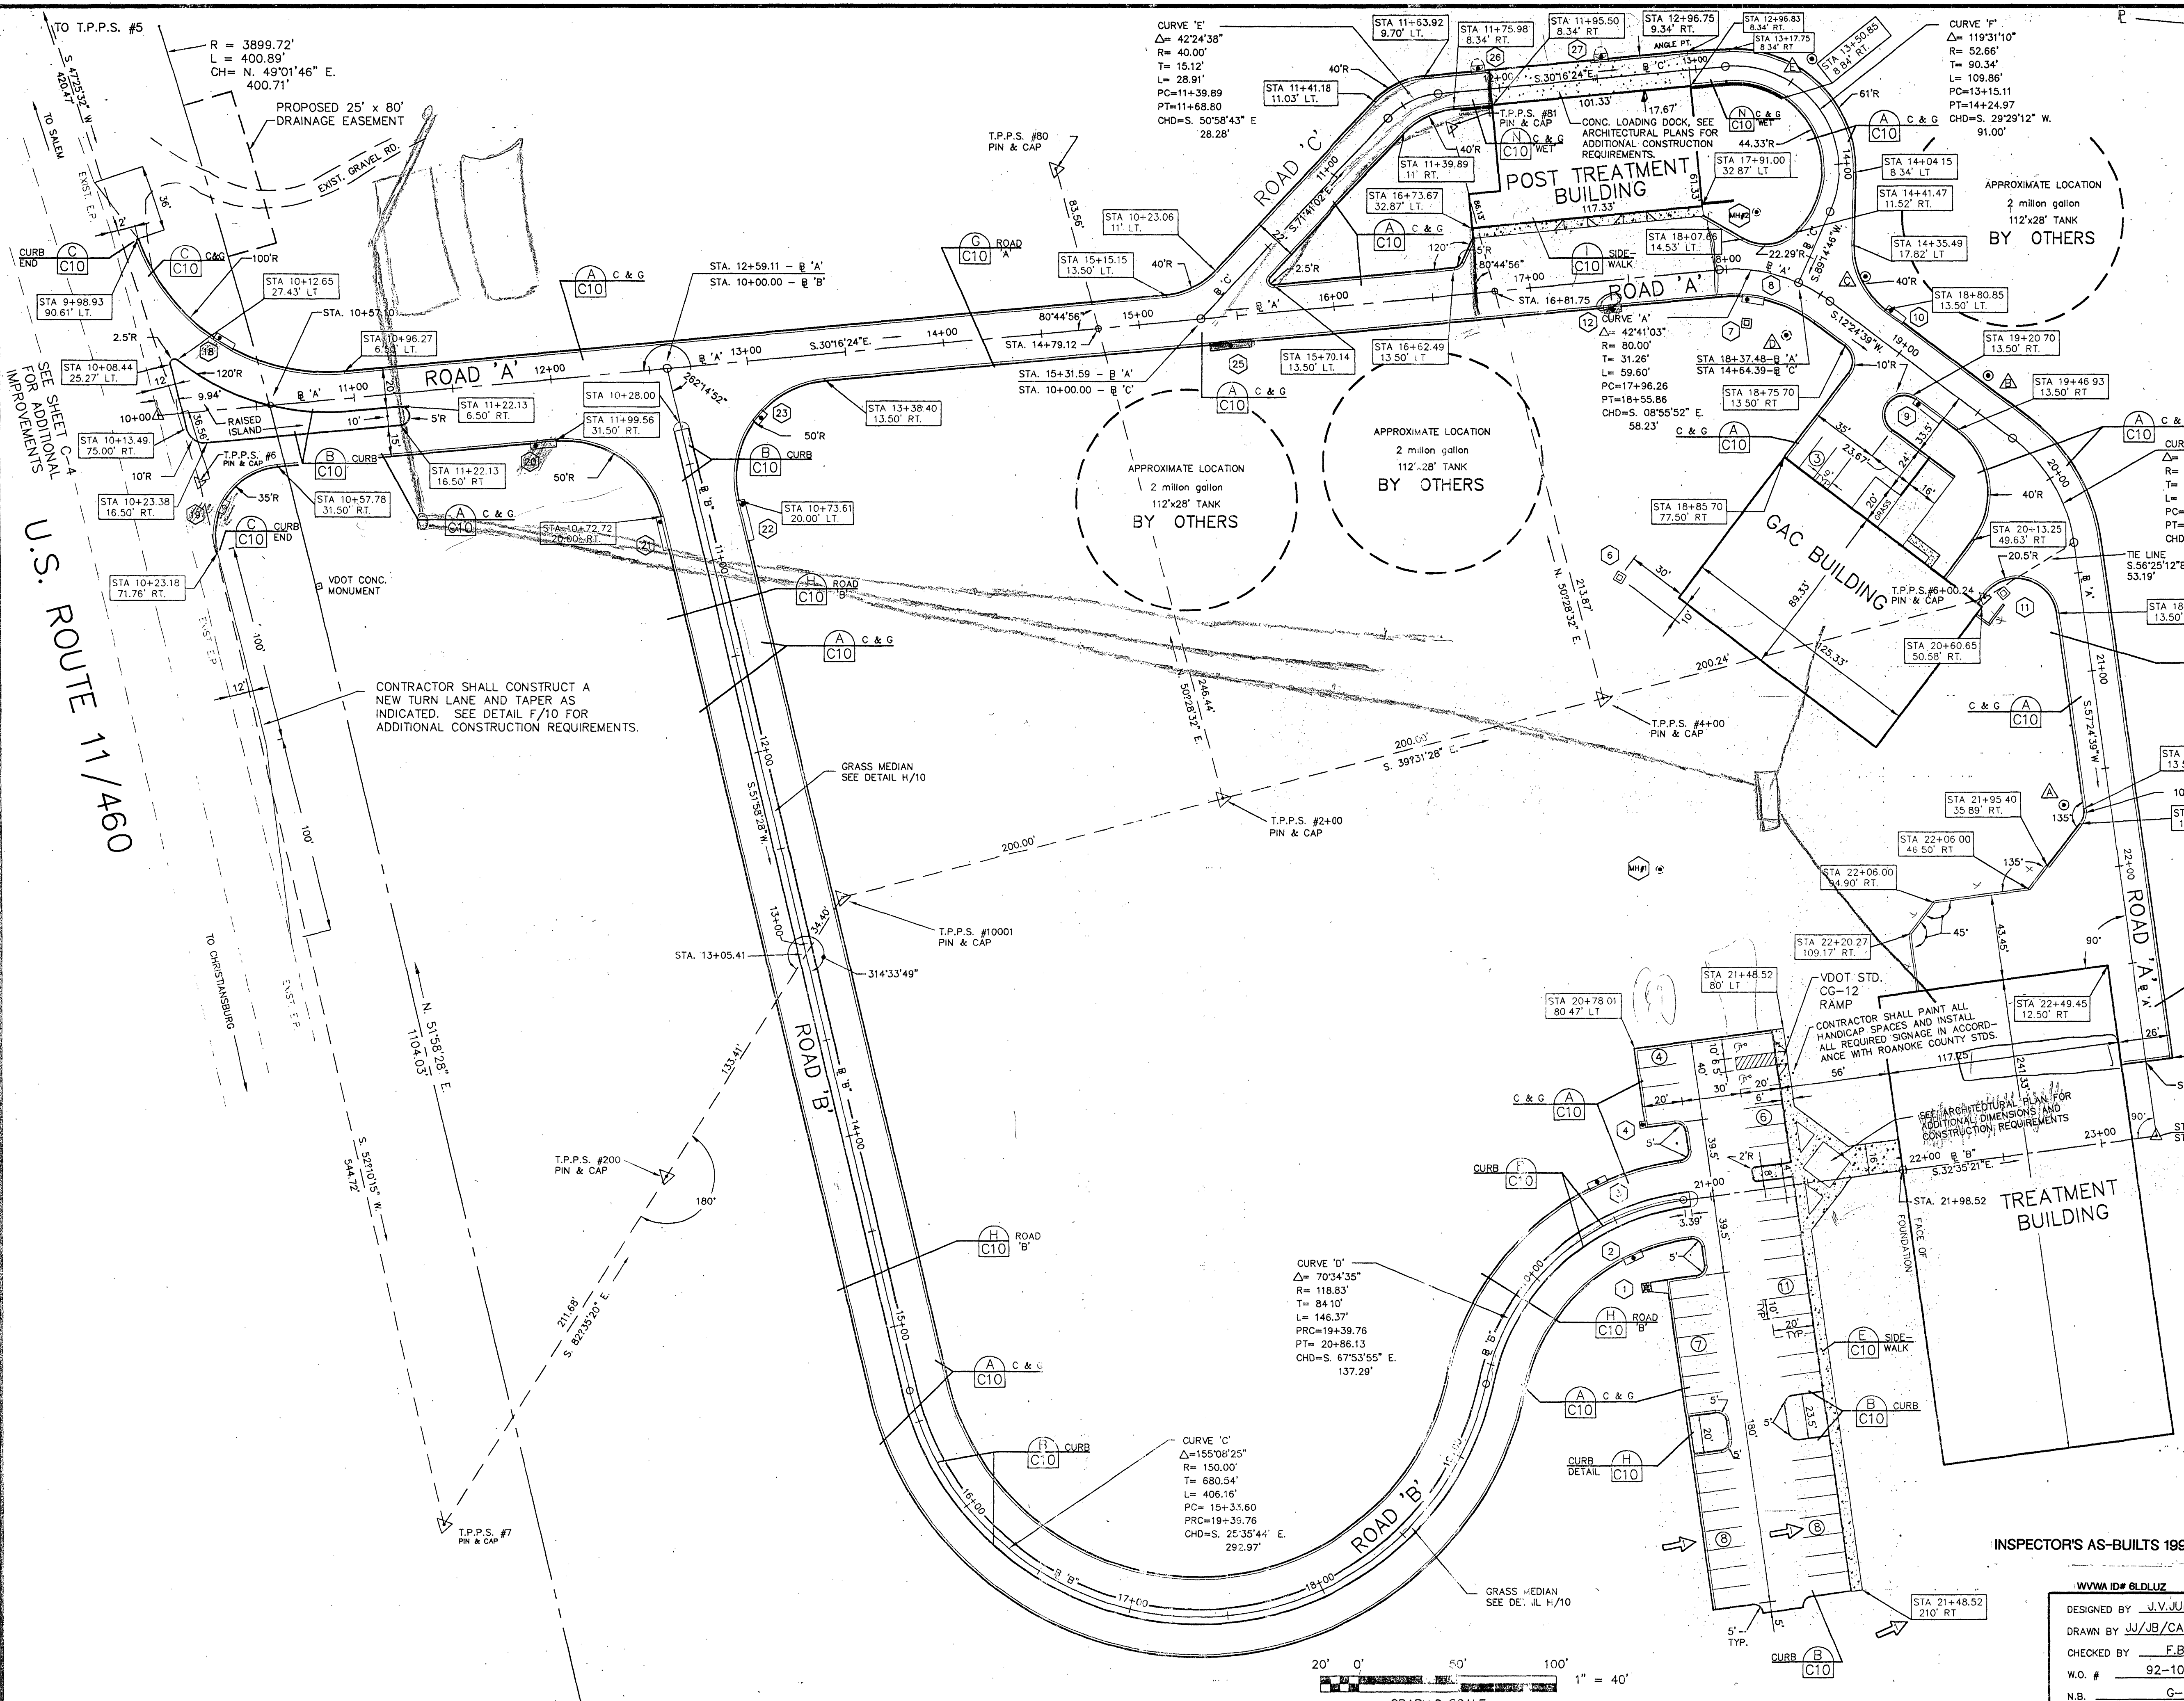

STORM DRAIN STRUCTURES

No.	B	STA.	O/S	TYPE
1	B	18+75.00	21.42' RT.	D.I.-3B, L=12'
2	B	20+00.00	21.39' LT.	D.I.-3B, L=10'
3	B	20+00.00	21.58' RT.	D.I.-3C, L=6'
4	B	20+00.00	40.59' RT.	D.I.-3B, L=6'
5	B	20+77.04	78.77' LT.	D.I.-3A, L=2.5'
6	B	20+97.68	168.3' LT.	MH-2
7	A	19+11.21	27.1' RT.	D.I.-7
8	A	18+11.92	15.16' RT.	D.I.-3B, L=10'
9	A	19+23.22	15.0' RT.	D.I.-3B, L=16'
10	A	18+83.35	15.0' LT.	D.I.-3B, L=10'
11	A	20+03.19	38.9' RT.	D.I.-7
12	A	17+00.50	15.0' RT.	D.I.-3C, L=6'
13	A	18+12.37	29.6' LT.	MH-2
14	A	10+25.00	36.5' LT.	D.I.-3B, L=10'
15	A	10+25.10	48.5' RT.	D.I.-3C, L=6'
16	A	11+81.06	33.0' RT.	D.I.-3B, L=12'
17	A	10+72.22	21.5' RT.	D.I.-3B, L=16'
18	A	10+77.11	21.5' LT.	D.I.-3B, L=20'
19	A	13+00.00	28.45' RT.	D.I.-3C, L=6'
20	A	13+00.00	28.45' RT.	D.I.-3C, L=6'
21	A	13+00.00	28.45' RT.	D.I.-3C, L=6'
22	C	11+90.00	12.83' LT.	D.I.-3FF, L=6'
23	C	12+50.00	12.83' LT.	D.I.-3FF, L=6'


NOTE: ALL STATIONS AND OFFSETS ARE TO CENTER OF MANHOLE BARREL.

SANITARY SEWER STRUCTURES

No.	B	STA.	O/S	TYPE
A	A	24+05.63	23.40' RT.	S.S.MH.
B	A	19+42.70	18.19' LT.	S.S.MH.
C	A	18+02.73	20.74' LT.	S.S.MH.
D	A	18+02.21	26.81' RT.	S.S.MH.
E	C	13+00.00	15.82' RT.	S.S.MH.

NOTE: ALL STATIONS AND OFFSETS ARE TO CENTER OF MANHOLE BARREL.

NOTE: ALL DIMENSIONS FOR THE PROPOSED BUILDINGS ARE TO THE FACE OF THE PRECAST CONCRETE PANELS UNLESS OTHERWISE NOTED.

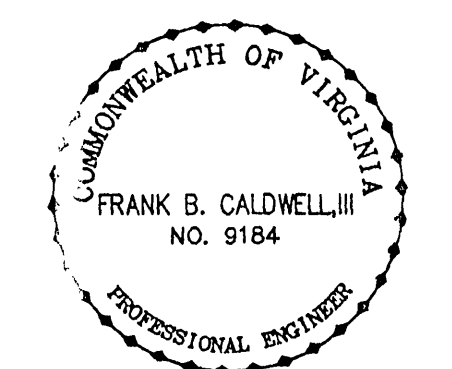


REVISED 9-27-94, per Roanoke County Utility Department


**DIMENSIONAL PLAN FOR
ROANOKE COUNTY
WATER TREATMENT
FACILITY**
OR
ROANOKE COUNTY BOARD OF SUPERVISORS
SITUATE U.S. ROUTES 11 & 460
COUNTY OF ROANOKE, VIRGINIA

INSPECTOR'S AS-BUILTS 1995

DESIGNED BY J.V. JUDY
DRAWN BY JJ/JB/CADD
CHECKED BY F.B.C.
W.O. # 92-1085
N.B. G-94
DATE MAR. 14, 1994

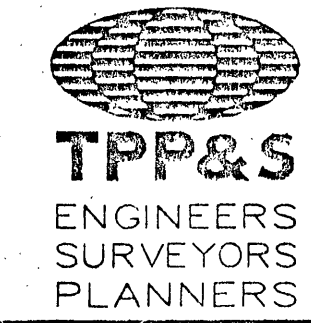

T. P. PARKER & SON
816 Boulevard
Post Office Box 39
Salem, Virginia 24153
Telephone: 703-387-1153
FAX: 703-389-5787

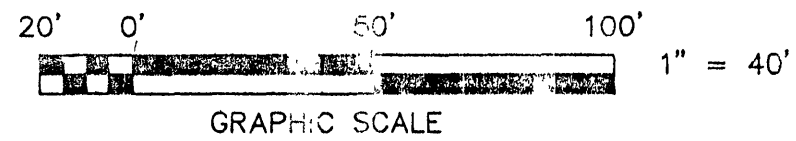

U.S. ROUTE 11/460