
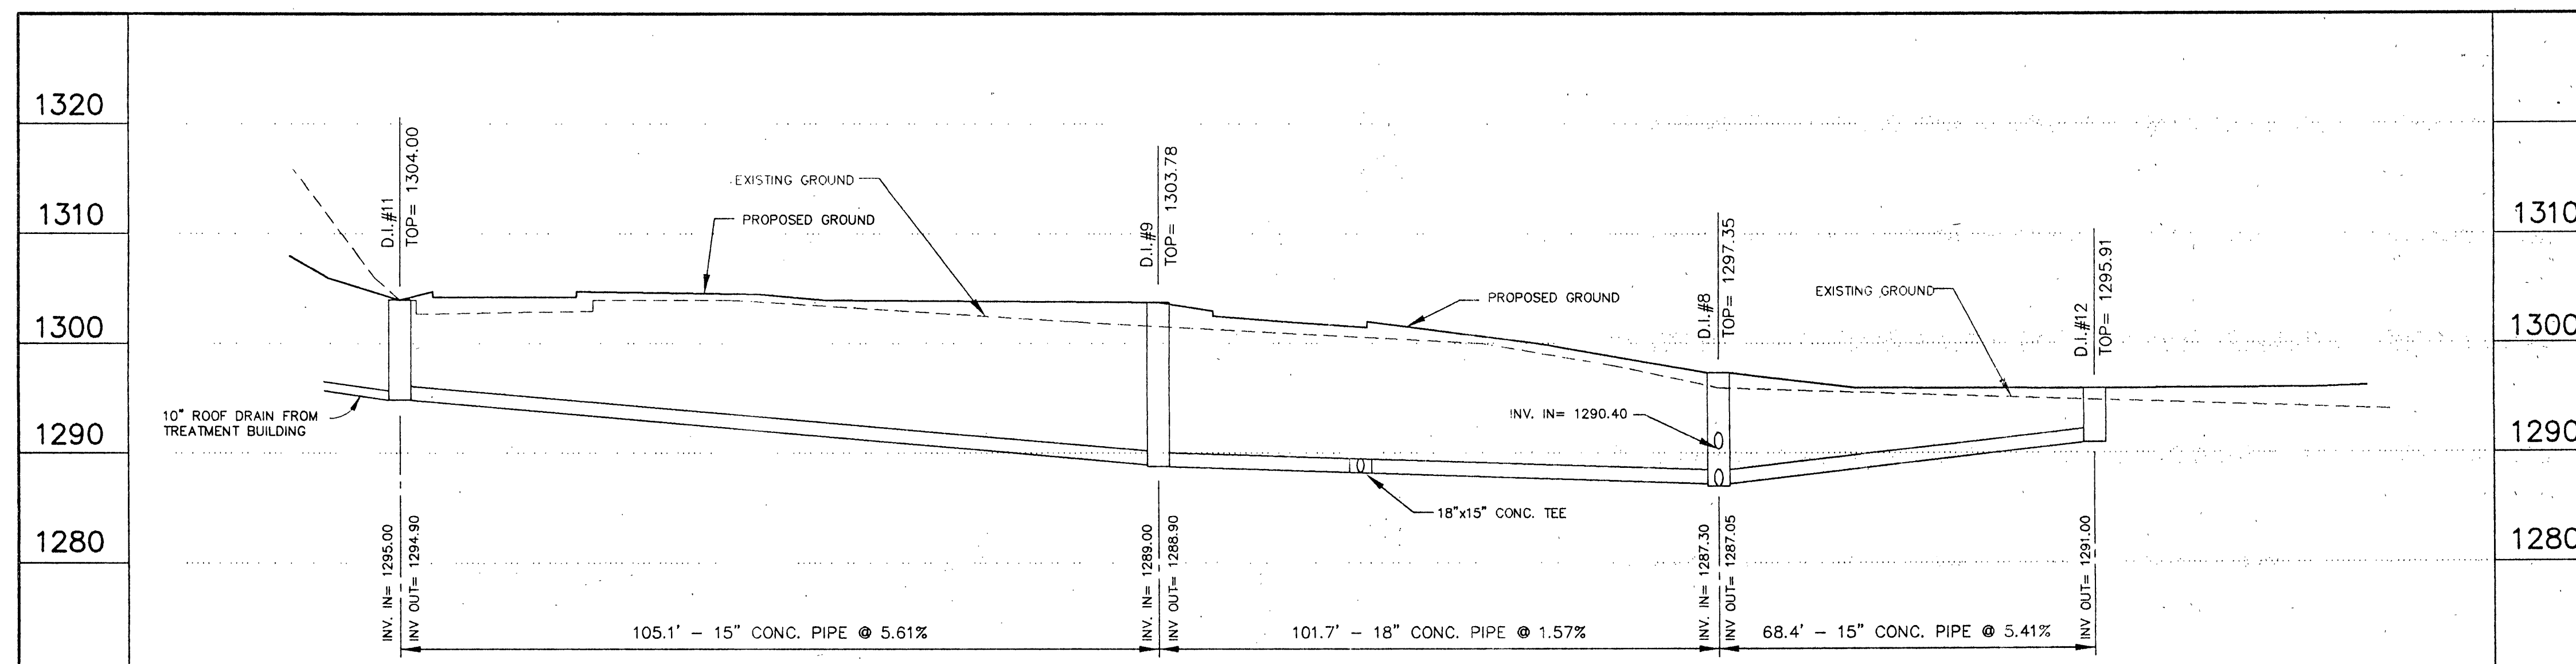
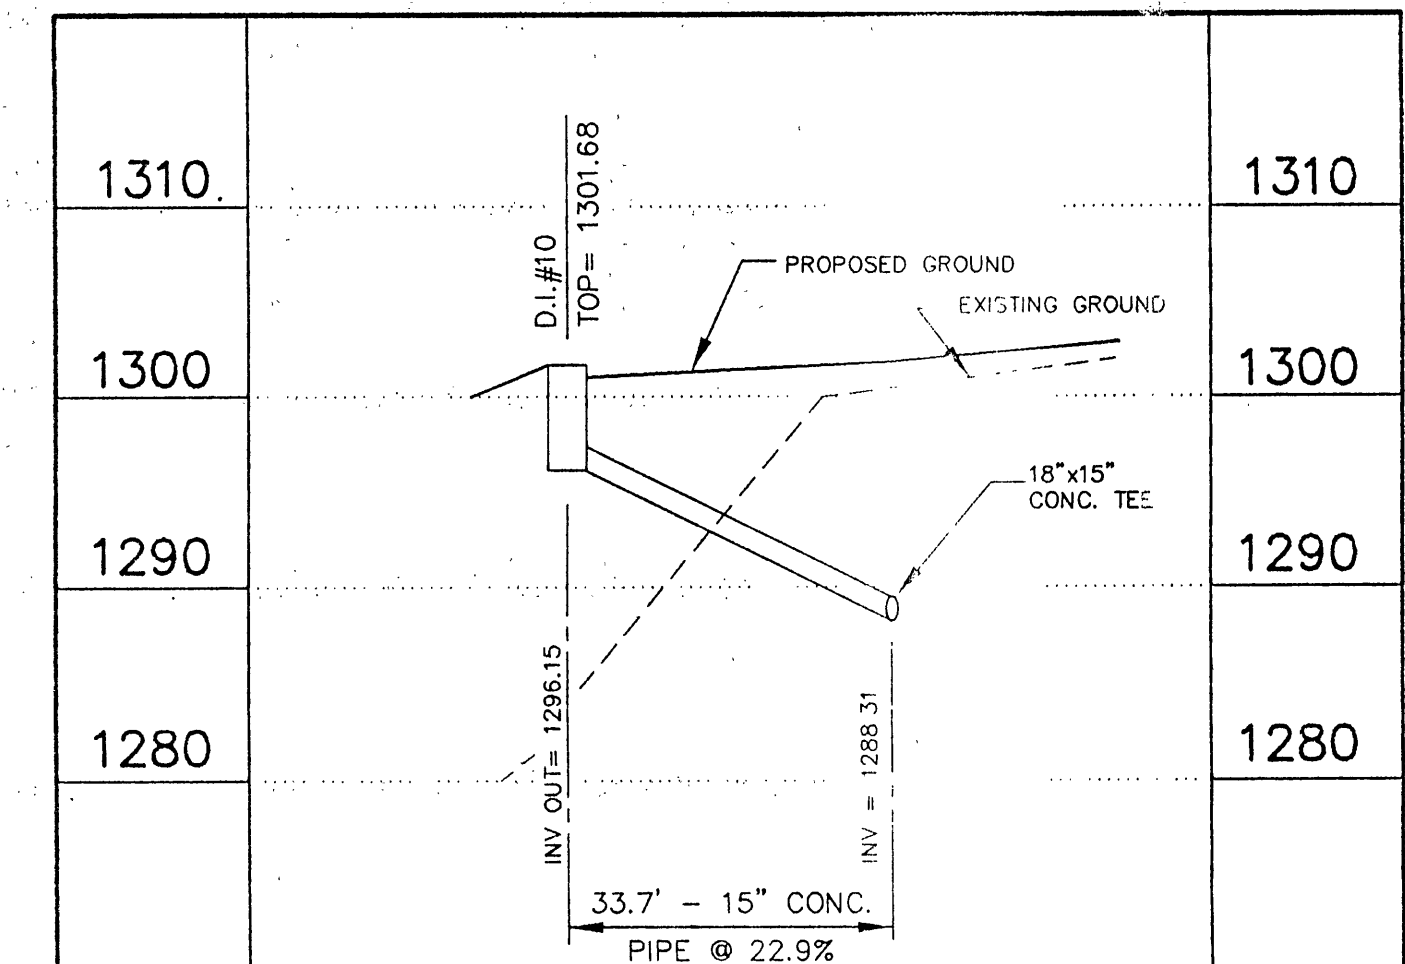
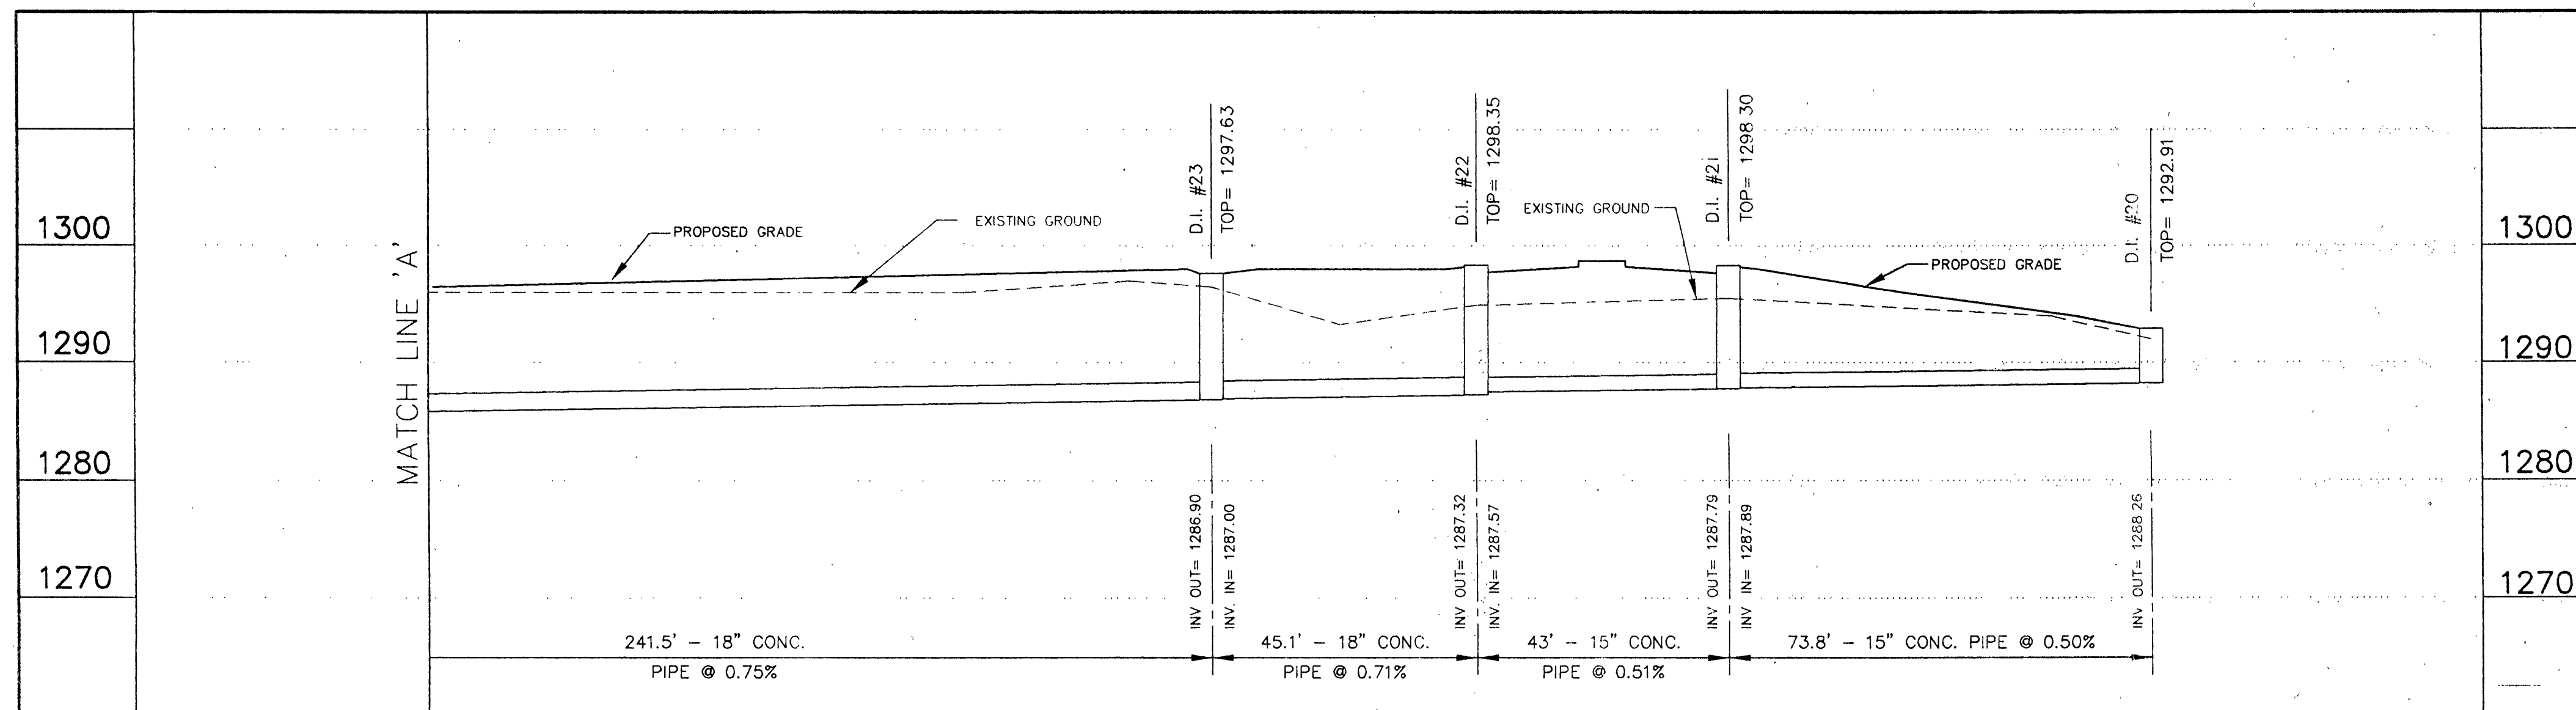


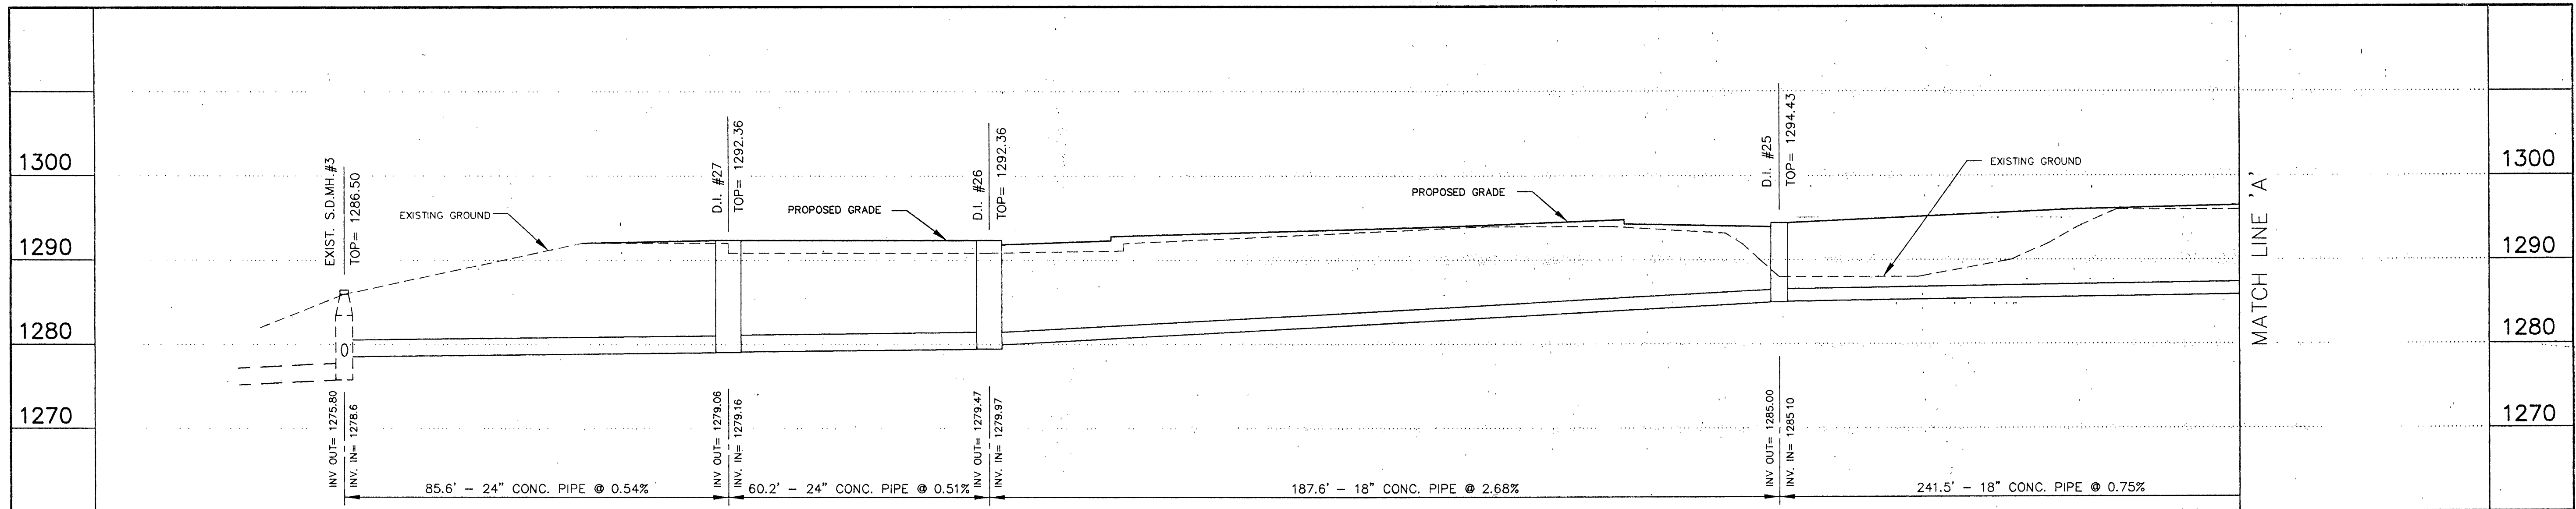

SCALES: HORZ - 1"=20'
VERT. - 1"=10'

REVISED 9-22-94, per Roanoke County Utility Department

	STORM DRAIN PROFILES ROANOKE COUNTY WATER TREATMENT FACILITY	
	FOR ROANOKE COUNTY BOARD OF SUPERVISORS SITUATE U.S. ROUTES 11 & 460 COUNTY OF ROANOKE, VIRGINIA	
DESIGNED BY: J.V. JUDY DRAWN BY: J.J.B./CADD CHECKED BY: F.B.C. W.O. #: 92-1085 N.B.: G-94 DATE: MAR. 14, 1994	 TPP&S ENGINEERS SURVEYORS PLANNERS	T. P. PARKER & SON 816 Boulevard Post Office Box 39 Salem, Virginia 24153 Telephone: 703-387-1153 FAX: 703-389-5787

INSPECTOR'S AS-BUILTS 1995

WWW.DP8LDLIZ