




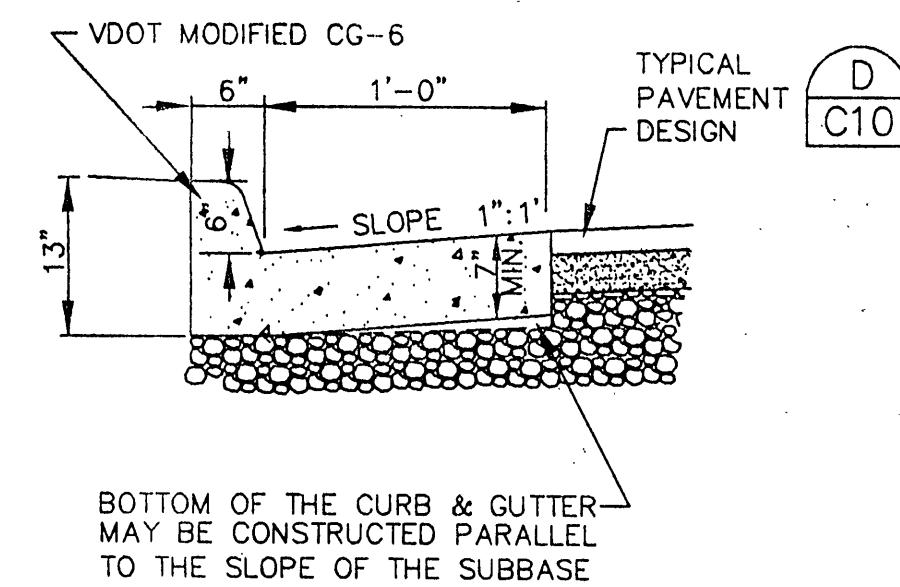


A CURB & GUTTER
C10 NO SCALE

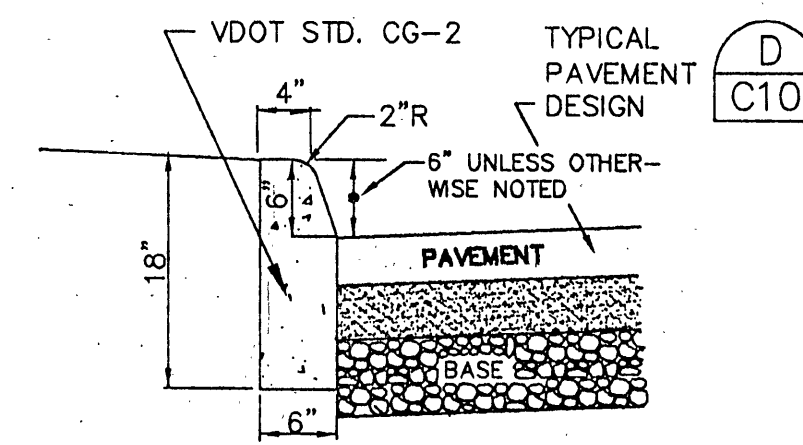


B CONCRETE CURB
C10 NO SCALE

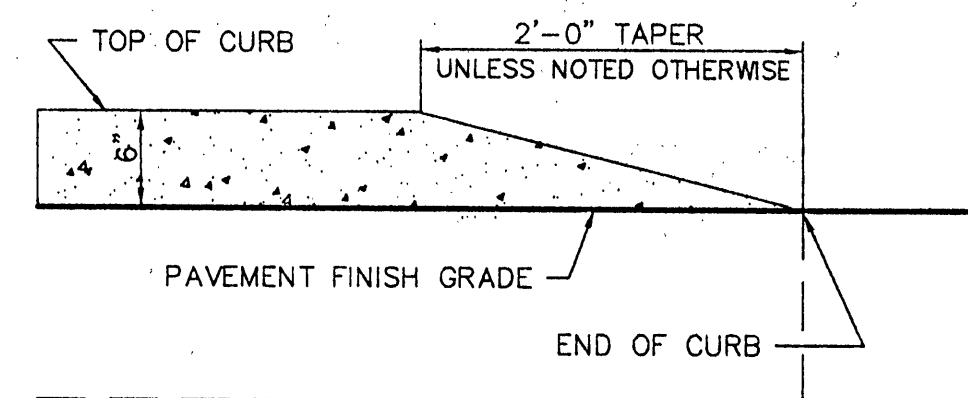


C CURB END ELEVATION
C10 NO SCALE

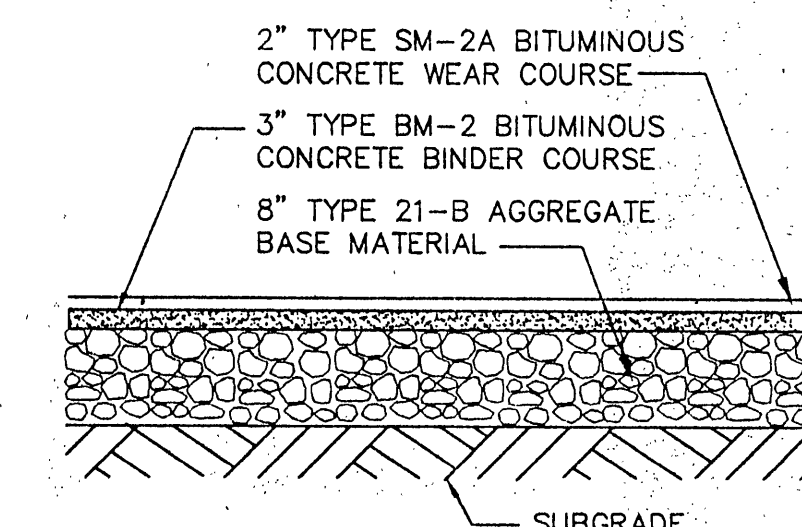


D PAVEMENT DETAIL
C10 NO SCALE

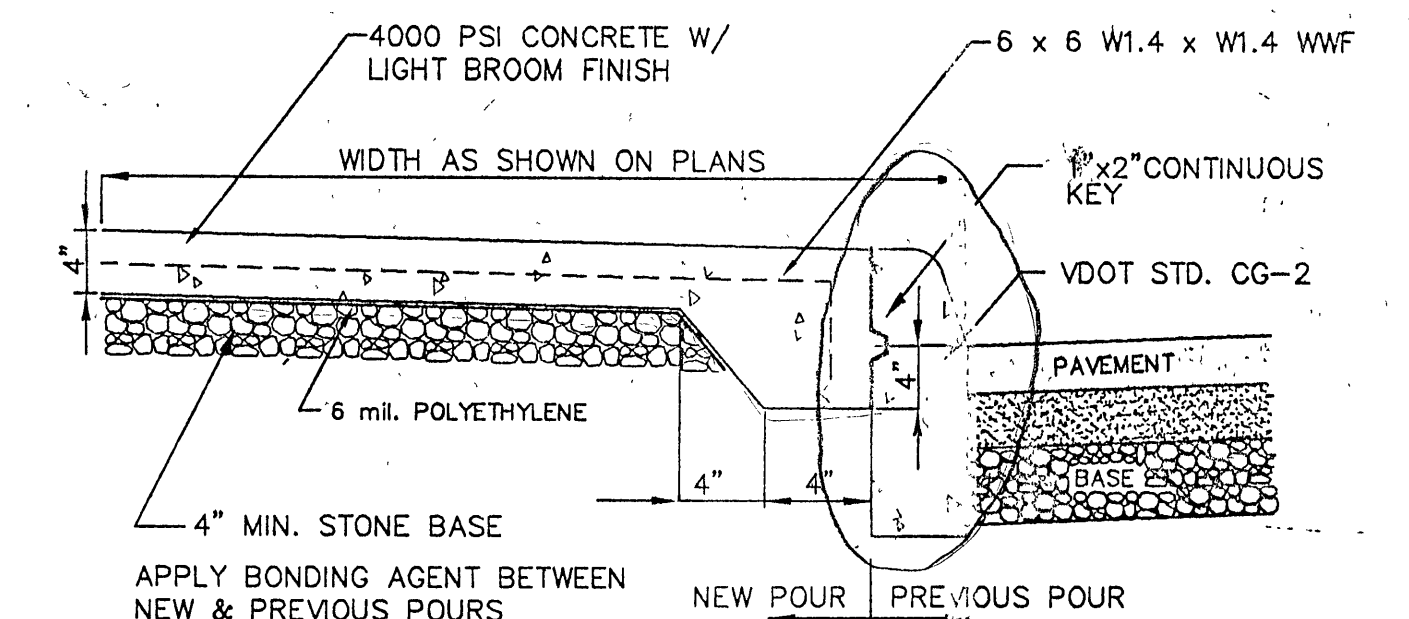


E CONCRETE SIDEWALK
C10 NO SCALE

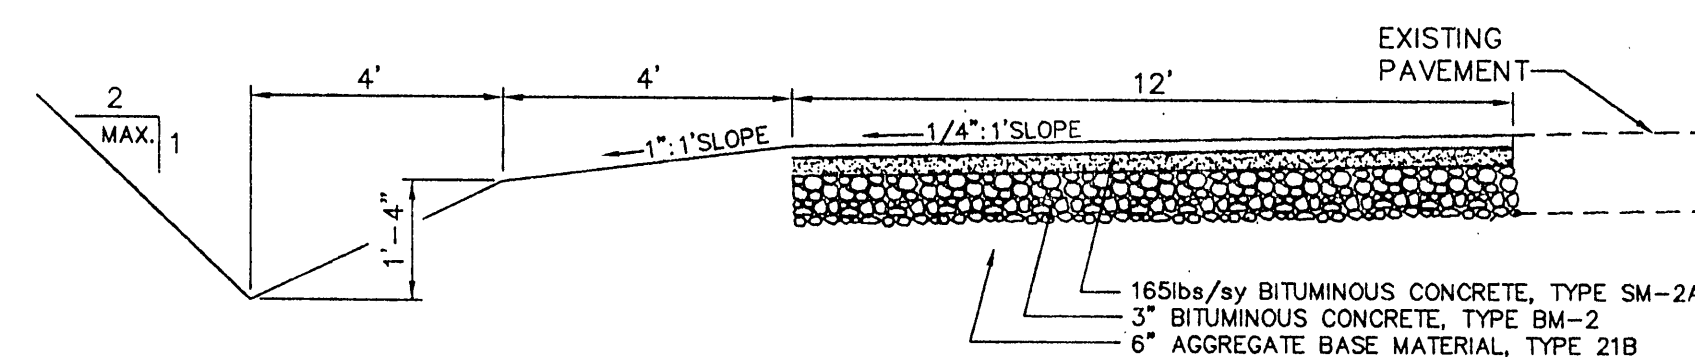


F PAVEMENT WIDENING
C10 NO SCALE

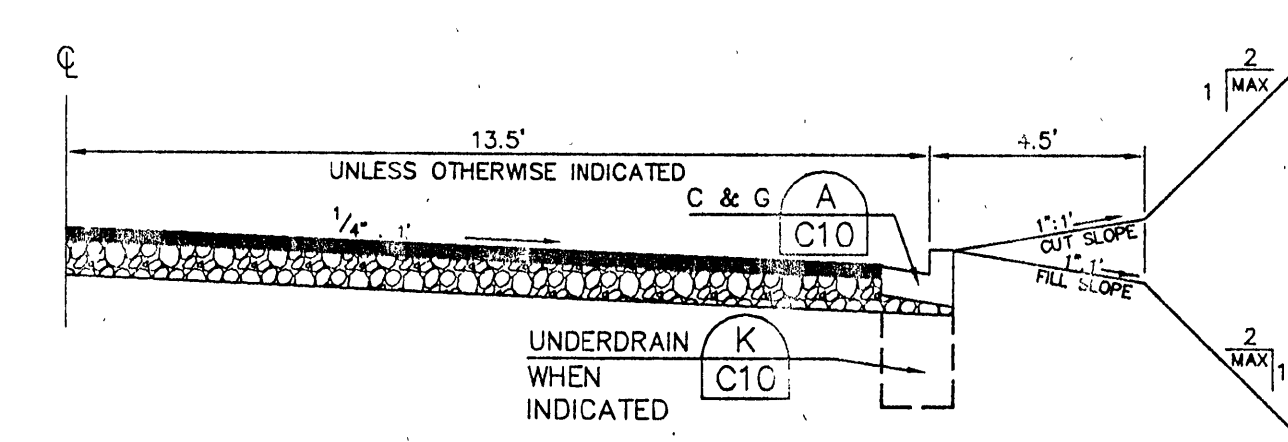


G ROAD 'A' & 'C' SECTION
C10 NO SCALE

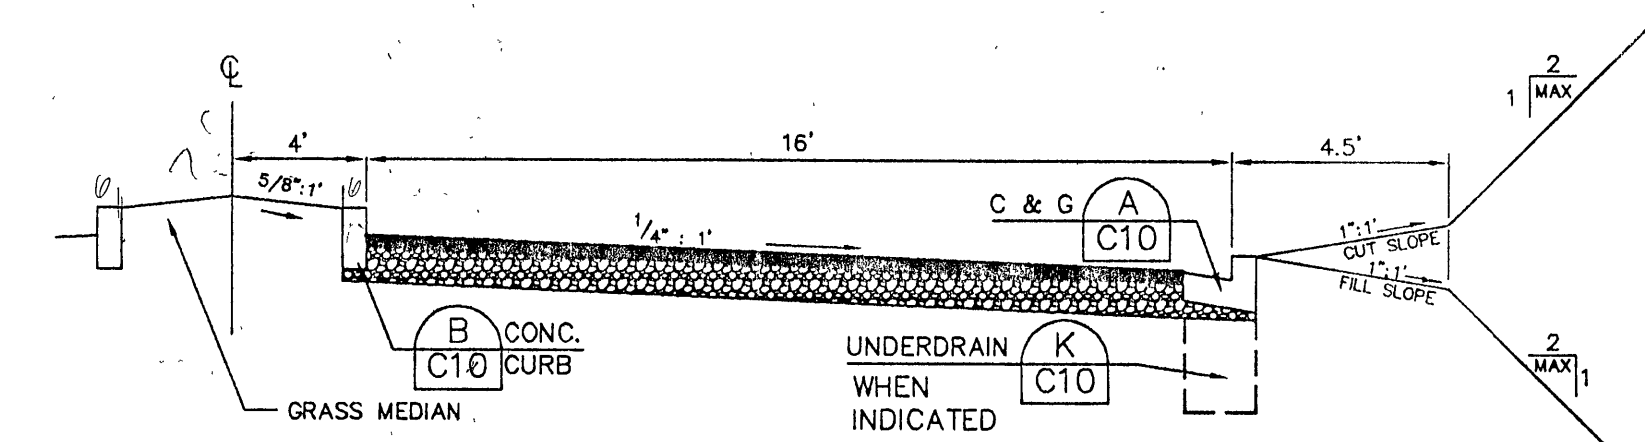


H ROAD 'B' SECTION
C10 NO SCALE

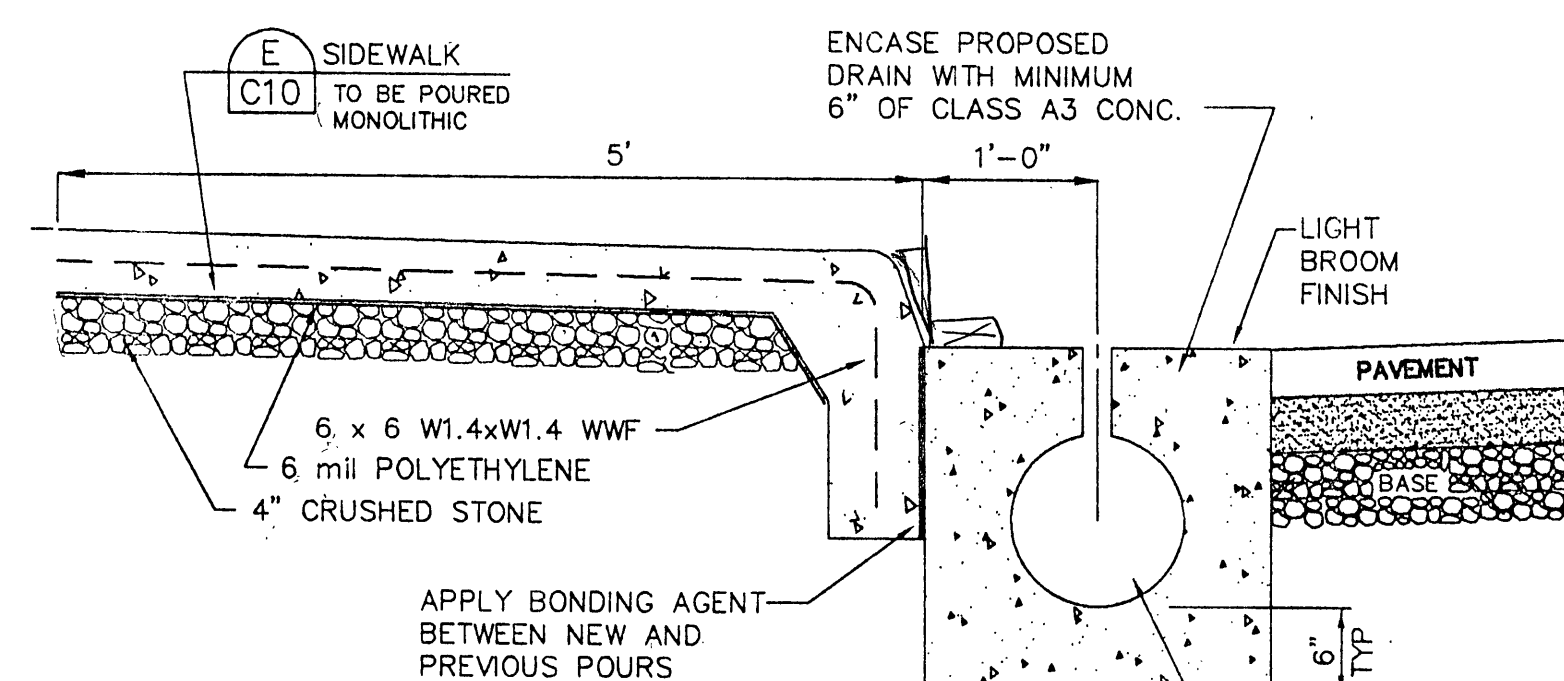



I OPEN TOP DRAIN
C10 NO SCALE

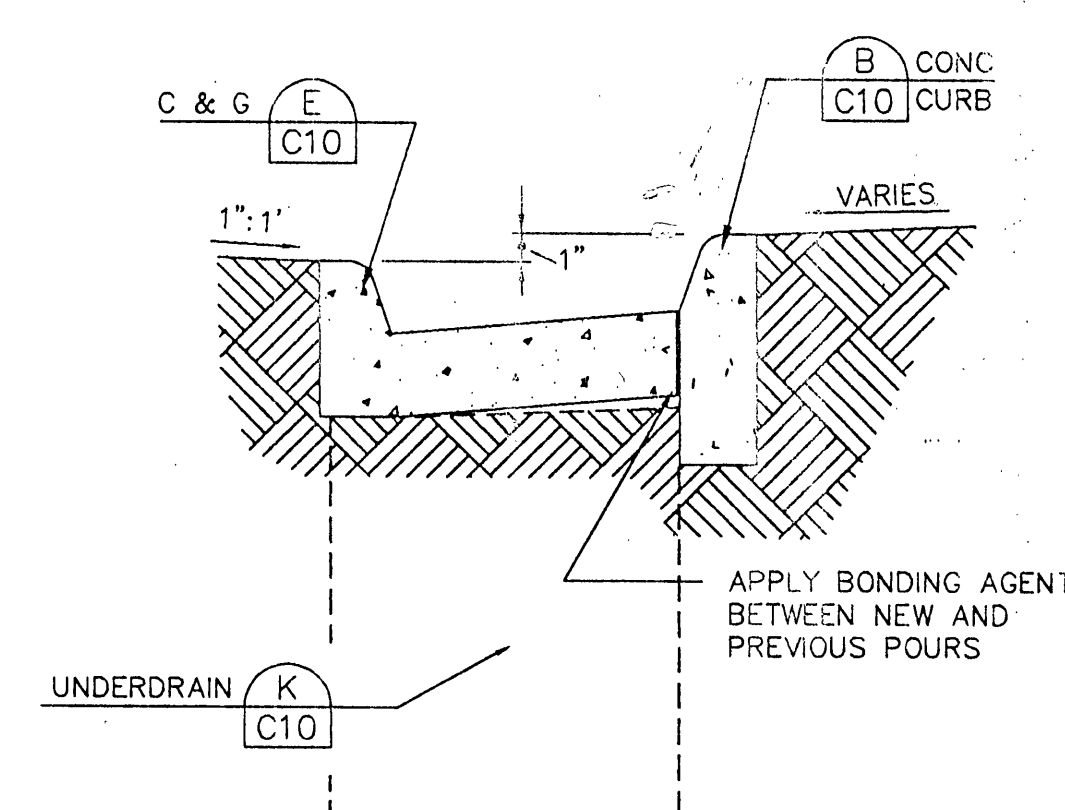

J CURB FLUME
C10 NO SCALE

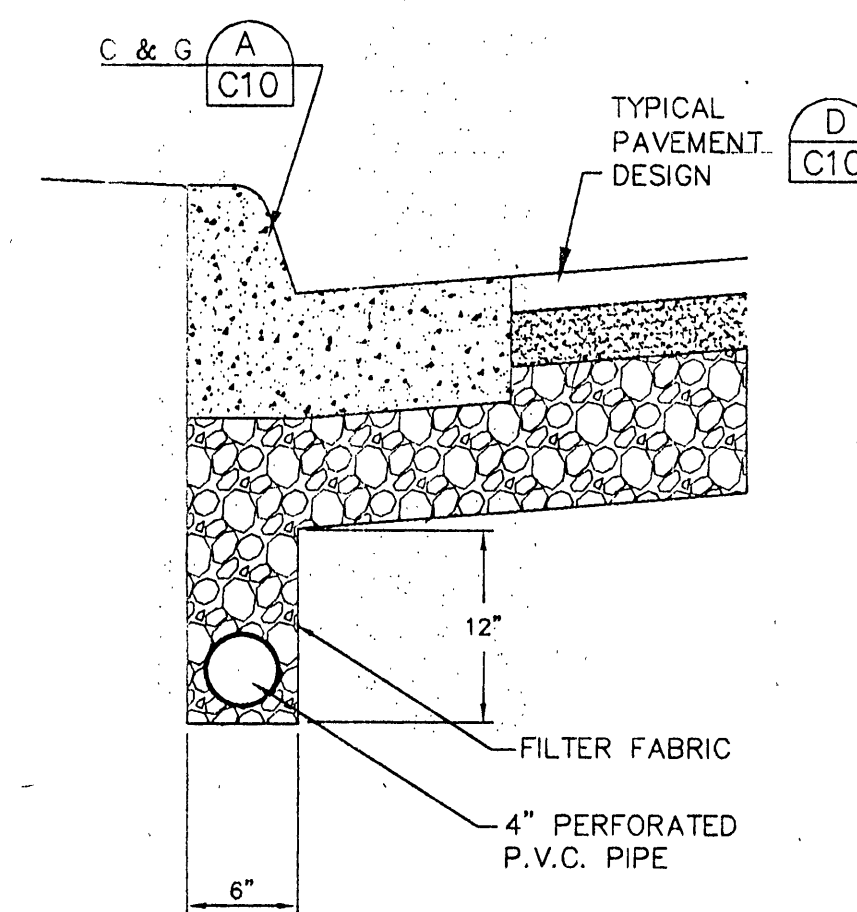

K UNDERDRAIN
C10 NO SCALE

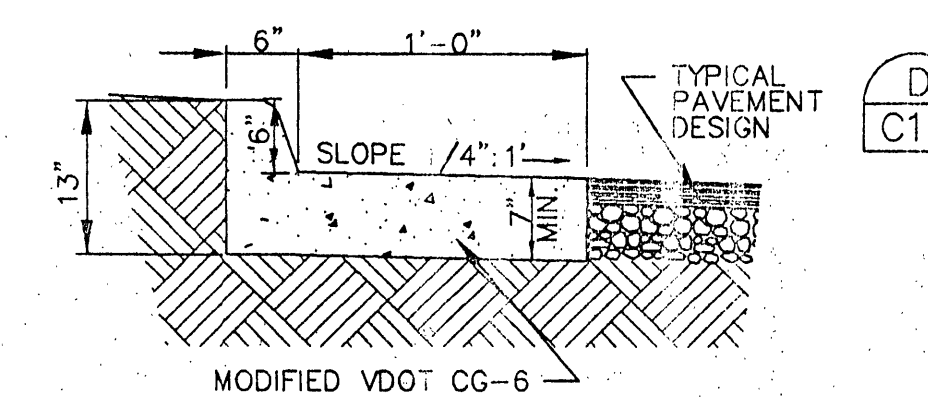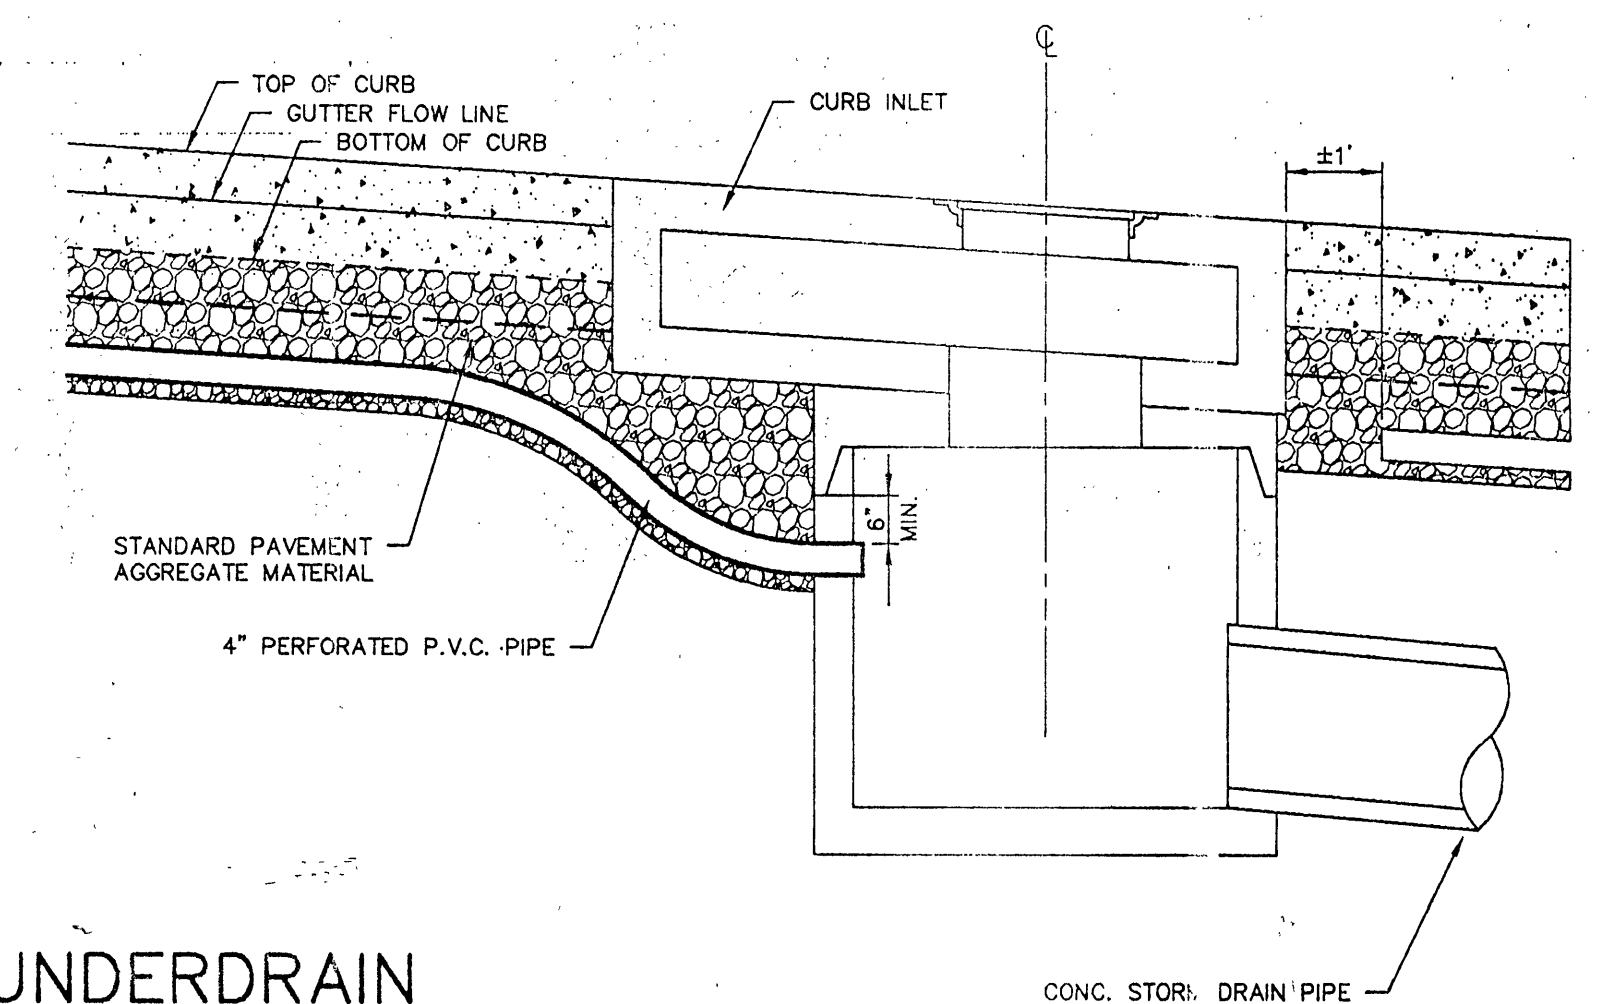


N DRY CURB & GUTTER
C10 NO SCALE

INSPECTOR'S AS-BUILTS 1995

WWW.IDP.8DLUZ

REVISED 9-22-94, per Roanoke County Utility Department

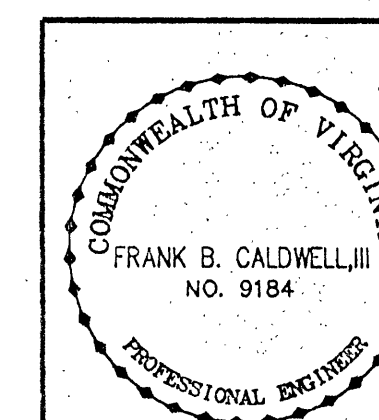

DESIGNED BY J.V. JUDY
DRAWN BY JJ/CADD
CHECKED BY F.B.C.
W.O. # 92-1085
N.B. G-94
DATE MAR. 14, 1994

CIVIL DETAIL SHEET
ROANOKE COUNTY WATER TREATMENT FACILITY
FOR
ROANOKE COUNTY BOARD OF SUPERVISORS
SITUATE U.S. ROUTES 11 & 460
COUNTY OF ROANOKE, VIRGINIA

TPP&S
ENGINEERS
SURVEYORS
PLANNERS

T. P. PARKER & SON
816 Boulevard
Post Office Box 39
Salem, Virginia 24153
Telephone: 703-387-1153
FAX: 703-389-5767