




CONTROLLER
PROCESS

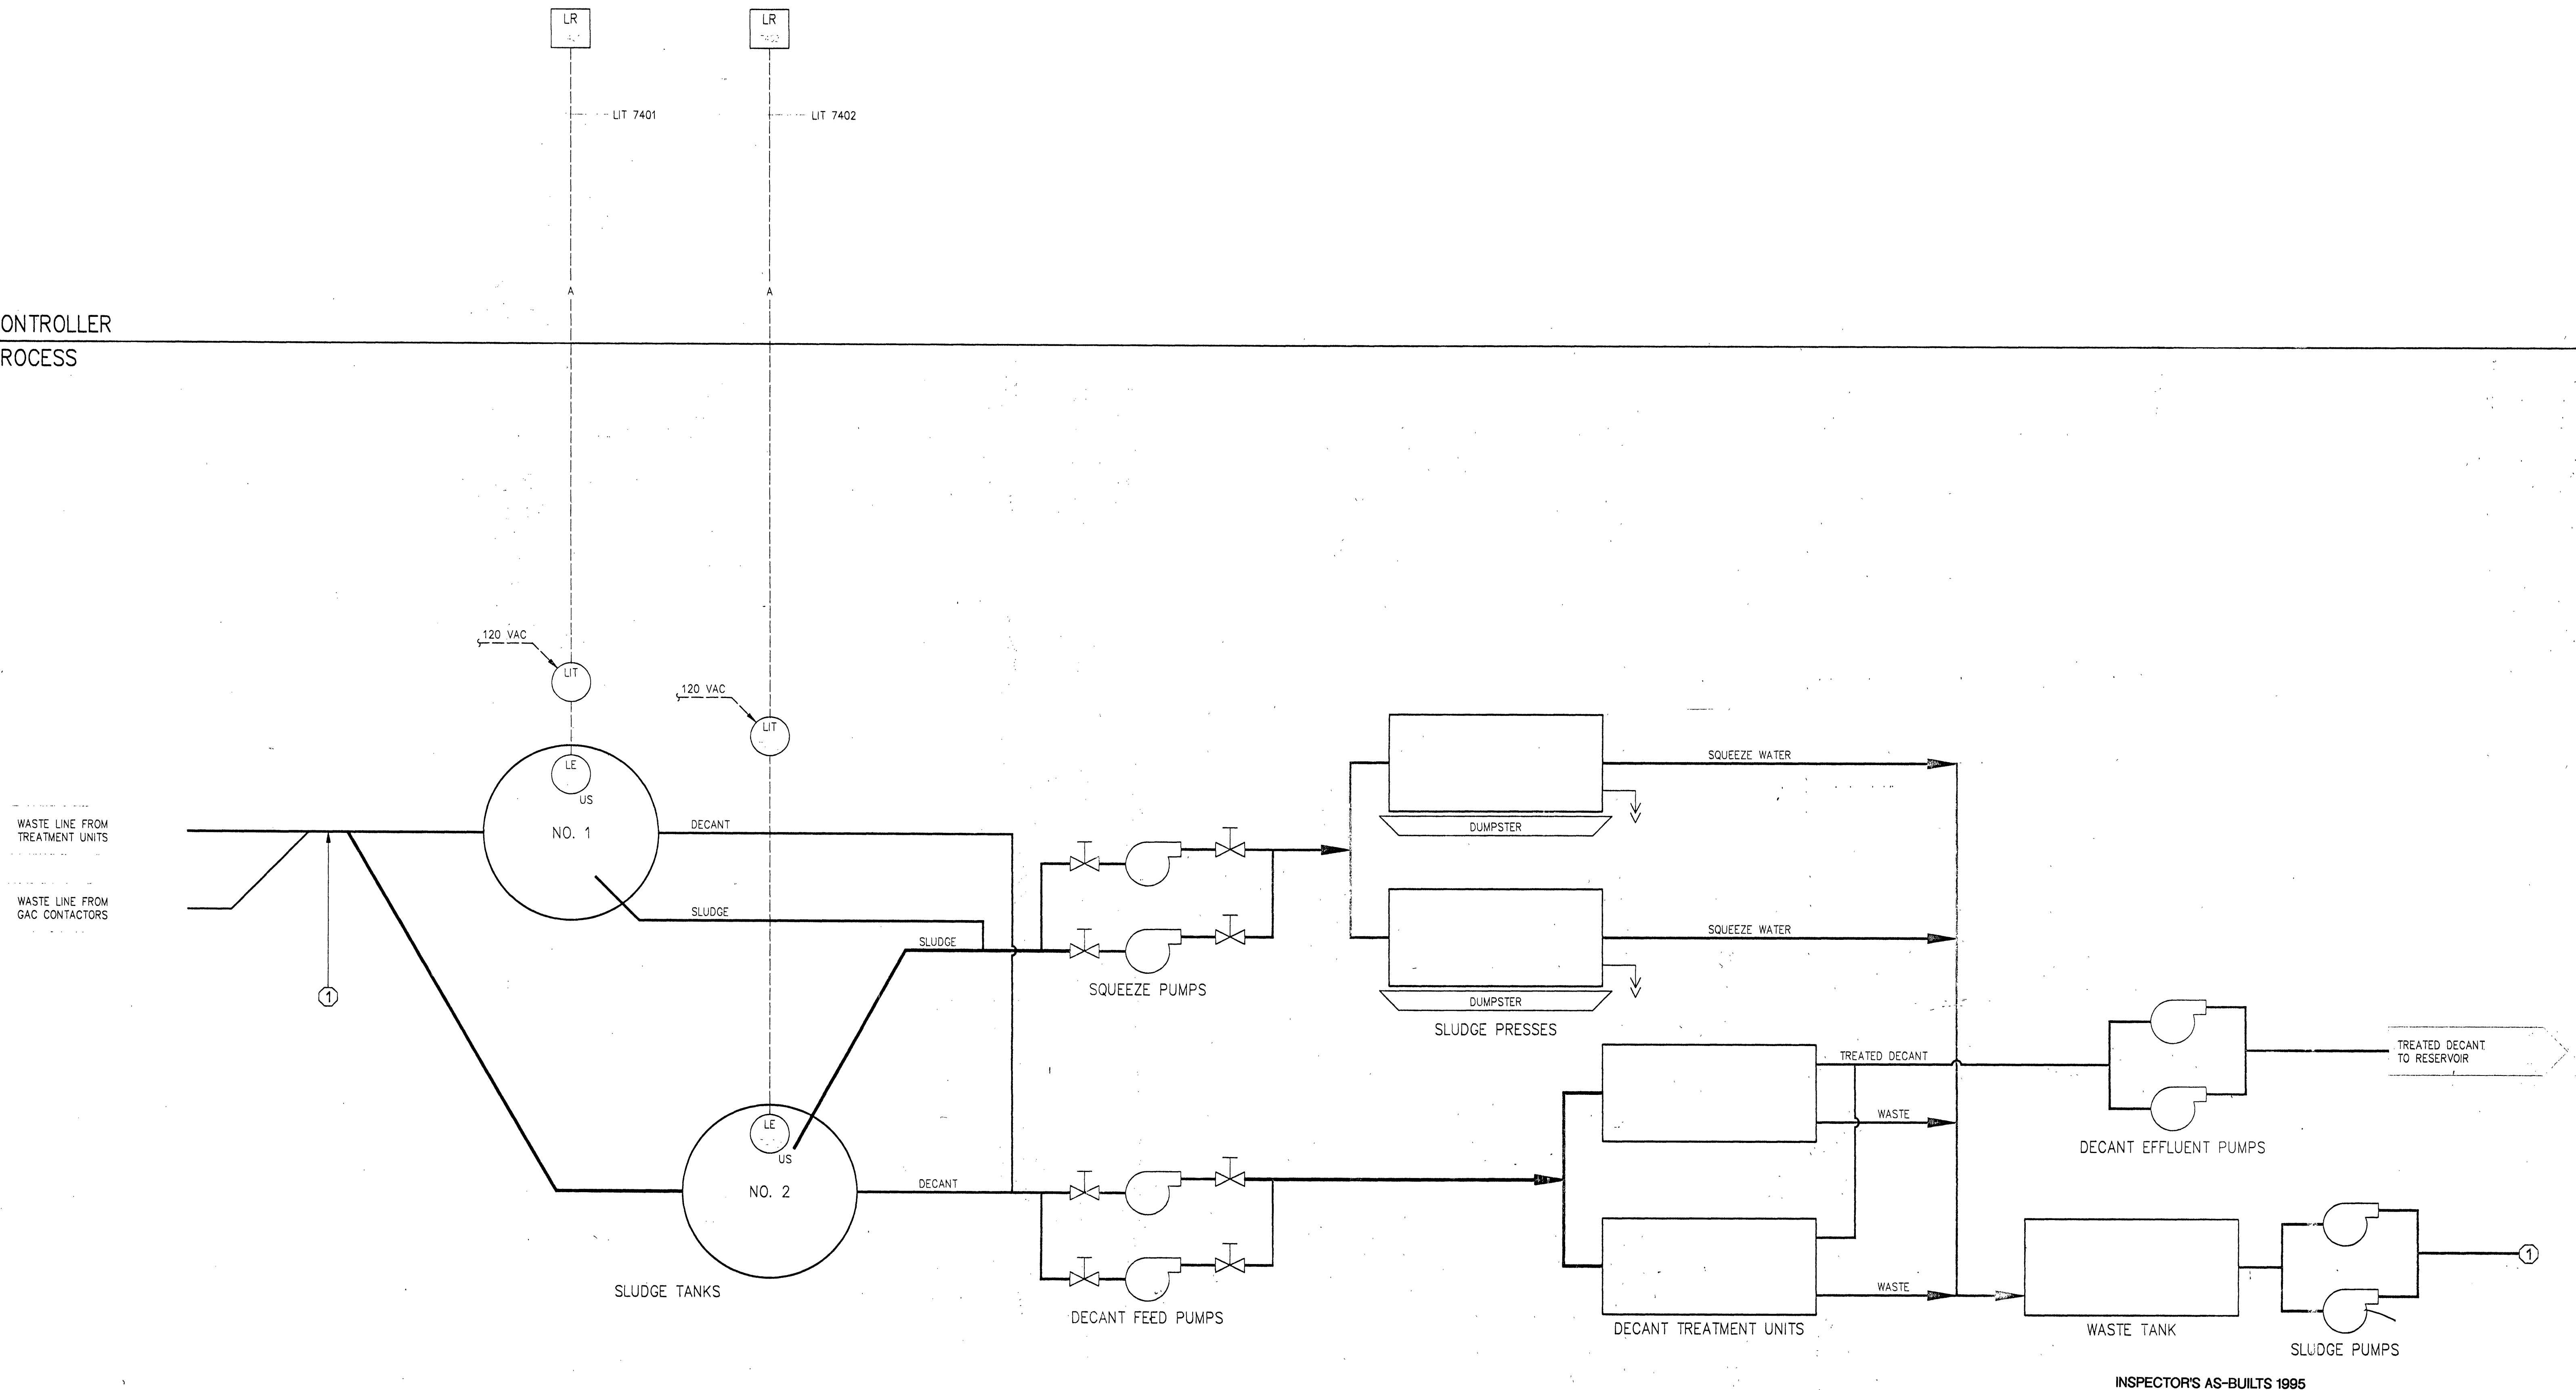

INSPECTOR'S AS-BUILTS 1995

WVWA ID# 8LDLW

DESIGNED	DBE
DRAWN	AMD
CHECKED	DBE
PROJ. ENGR.	DBE
APPROVED	DBE
NO.	ISSUED FOR
2	CONSTRUCTION
1	REGULATORY APPROVAL
NO.	ISSUED FOR
DATE	BY
9-23-94	DBE
8-9-94	DBE
DATE	BY
9/23/94	DBE
DATE	BY
9/23/94	DBE

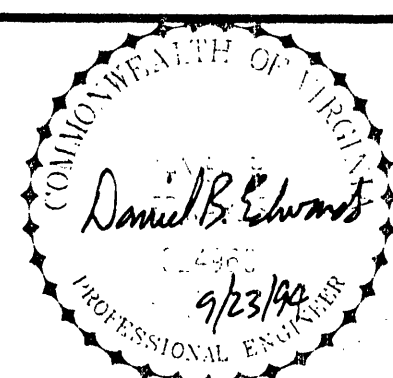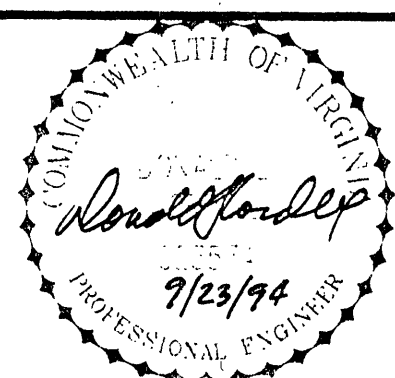

HAZEN AND SAWYER
Environmental Engineers & Scientists
RALEIGH, NC CHARLOTTE, NC RICHMOND, VA

ROANOKE COUNTY, VIRGINIA
UTILITY DEPARTMENT
WATER TREATMENT FACILITY

SLUDGE AND DECANT TREATMENT
INSTRUMENTATION
PROCESS & INSTRUMENTATION DIAGRAM

THE SCALE BAR SHOWN BELOW MEASURES ONE INCH LONG ON THE ORIGINAL DRAWING.	DATE SEPT 1994
CONTRACT NUMBER	H & S JOB NUMBER 3276
DRAWING NUMBER	1-6
SHEET	OF