


CONTROLLER
PROCESS


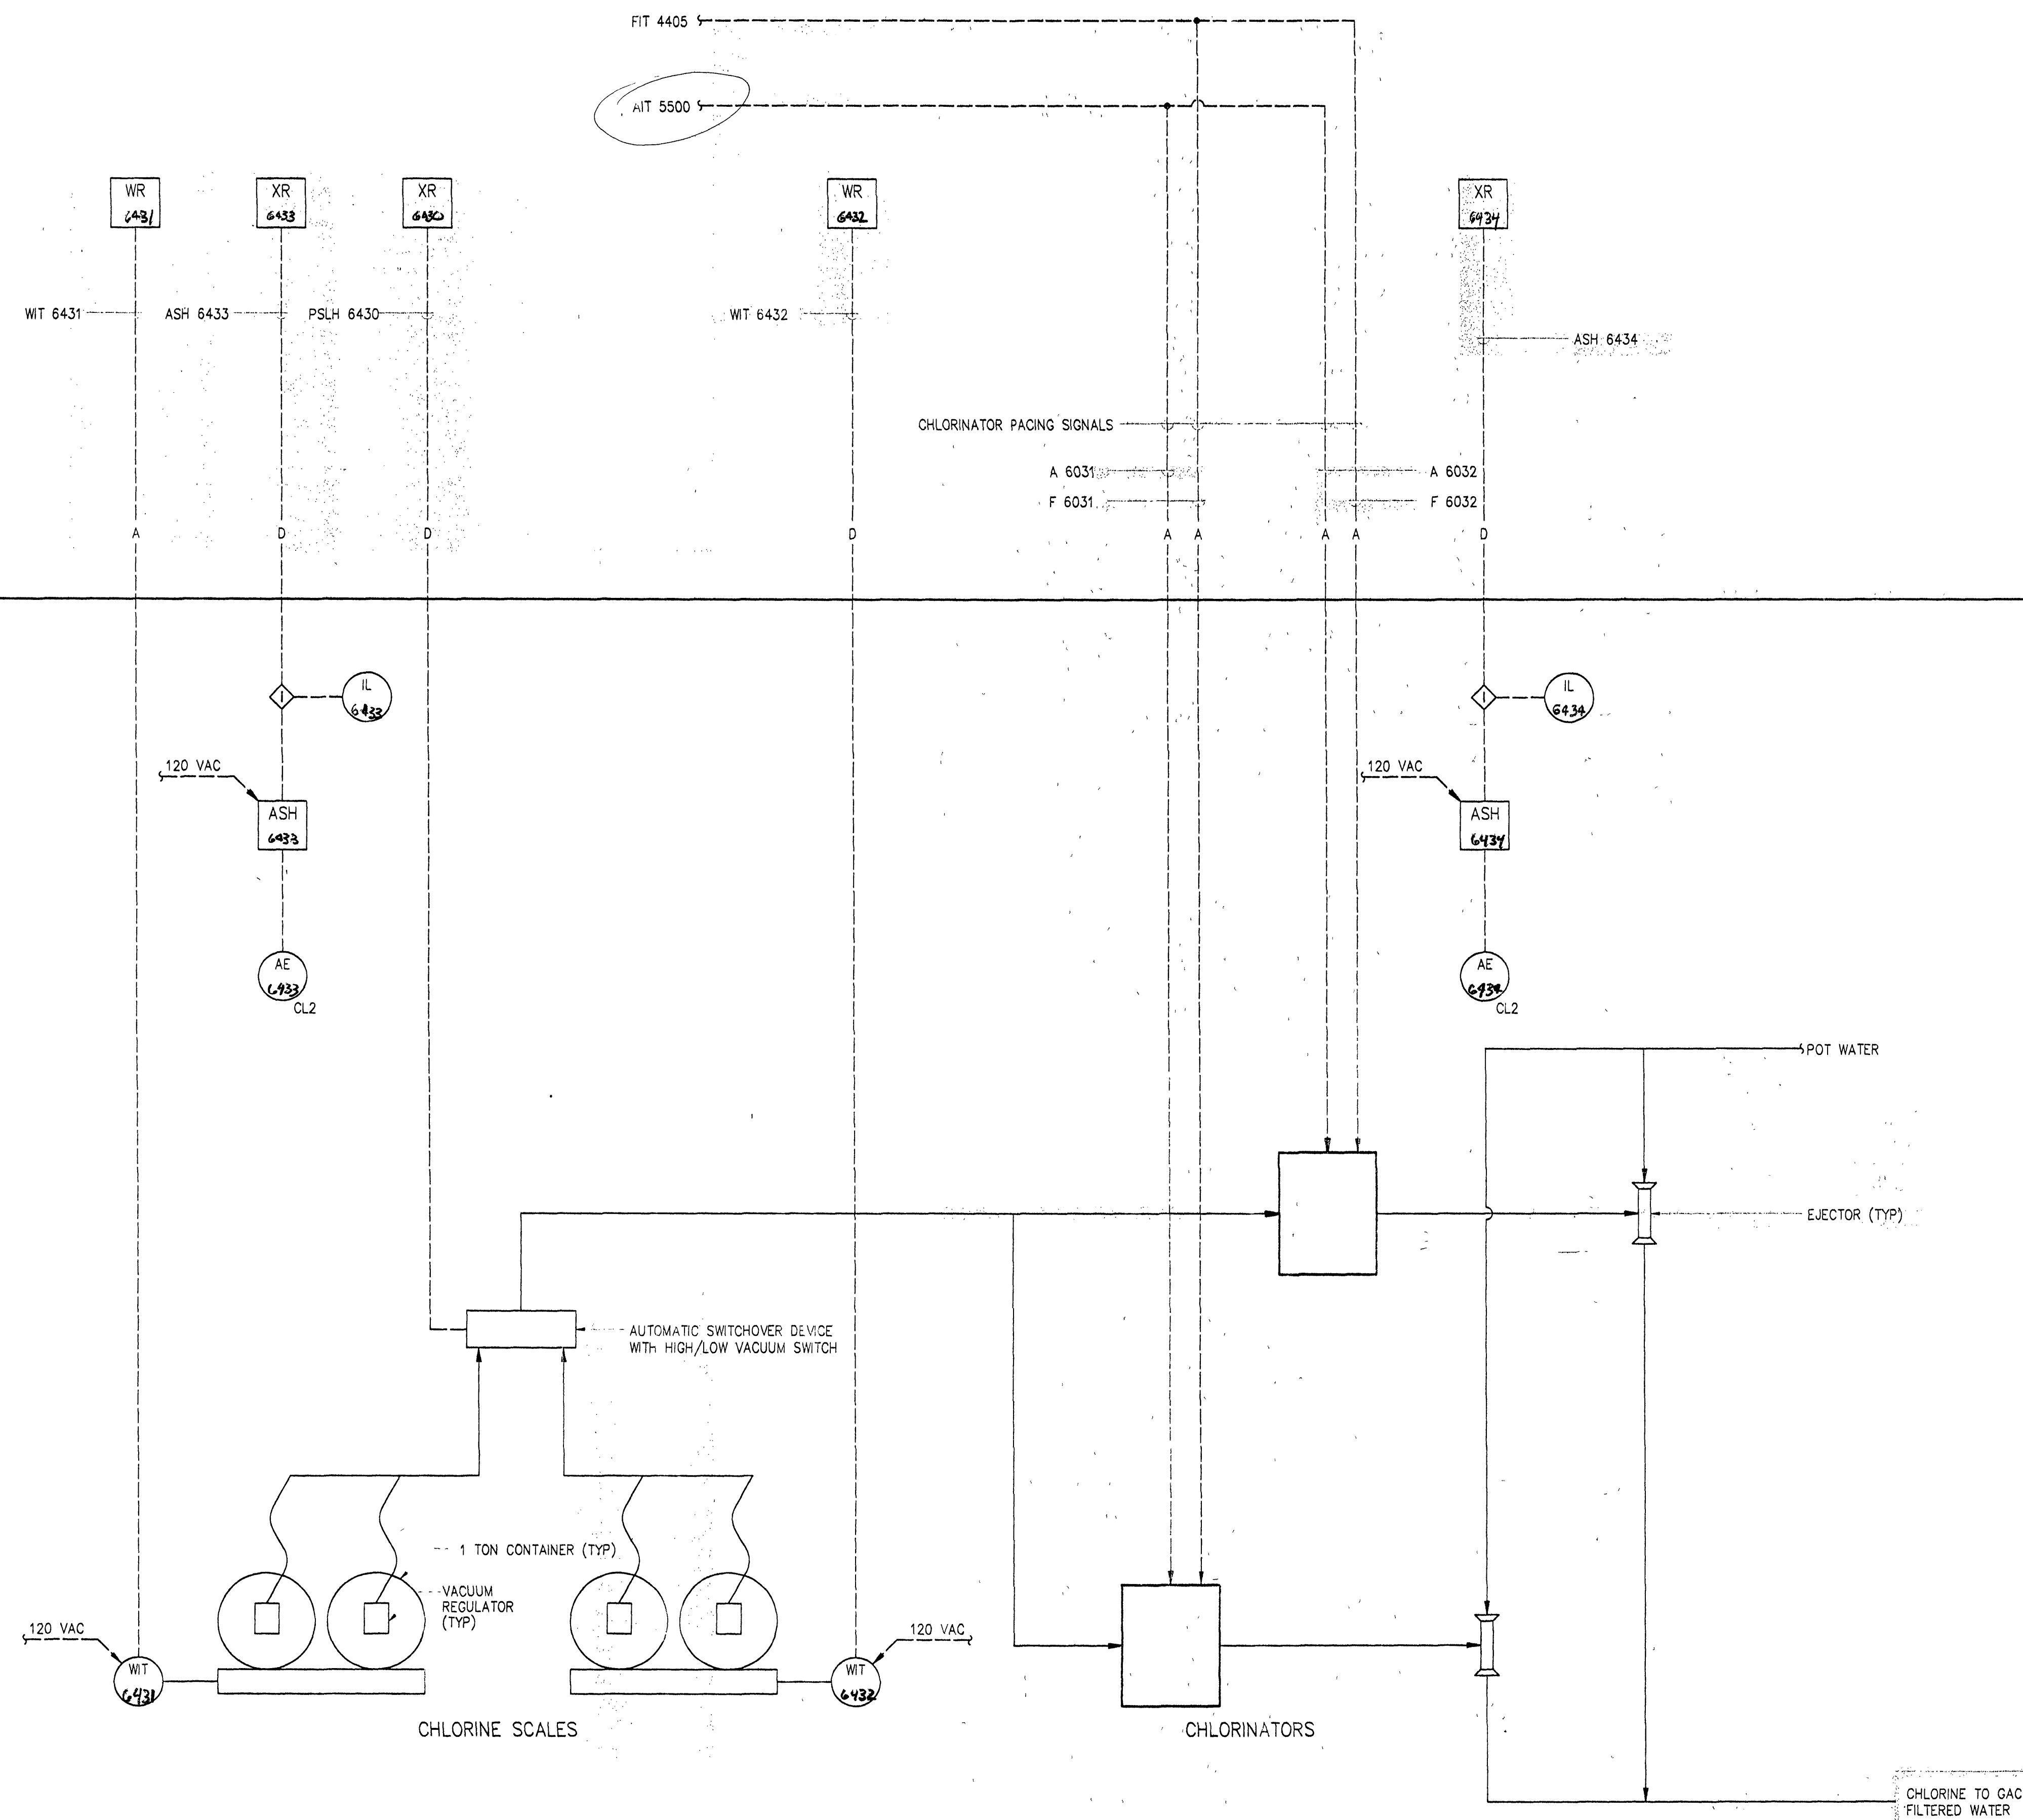


INSPECTOR'S AS-BUILTS 1995

WWW.ID# 8LDLUZ

NO.	ISSUED FOR	DATE	BY	APPROVED
2	CONSTRUCTION	9-23-94	DBE	
1	REGULATORY APPROVAL	8-9-94	DBE	

DESIGNED	DBE
DRAWN	AMD
CHECKED	DBE
PROJ. ENGR.	DBE
APPROVED	

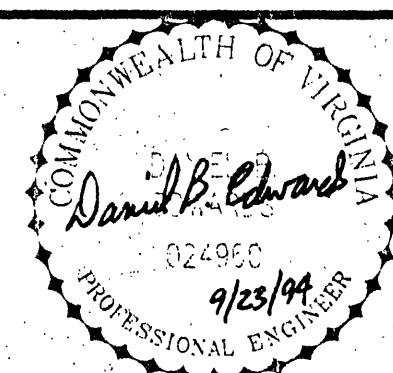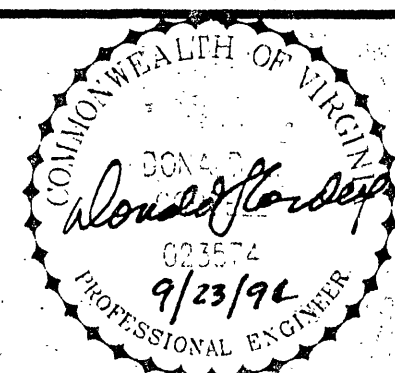

HAZEN AND SAWYER
Environmental Engineers & Scientists
RALEIGH, NC CHARLOTTE, NC RICHMOND, VA

ROANOKE COUNTY, VIRGINIA
UTILITY DEPARTMENT

WATER TREATMENT FACILITY

CHLORINE FEED SYSTEM
INSTRUMENTATION
PROCESS & INSTRUMENTATION DIAGRAM

THE SCALE BAR SHOWN BELOW MEASURES ONE INCH LONG ON THE ORIGINAL DRAWING.	DATE: SEPT 1994
CONTRACT NUMBER	H. & S JOB NUMBER: 3276
DRAWING NUMBER	1-8
SHEET	OF