
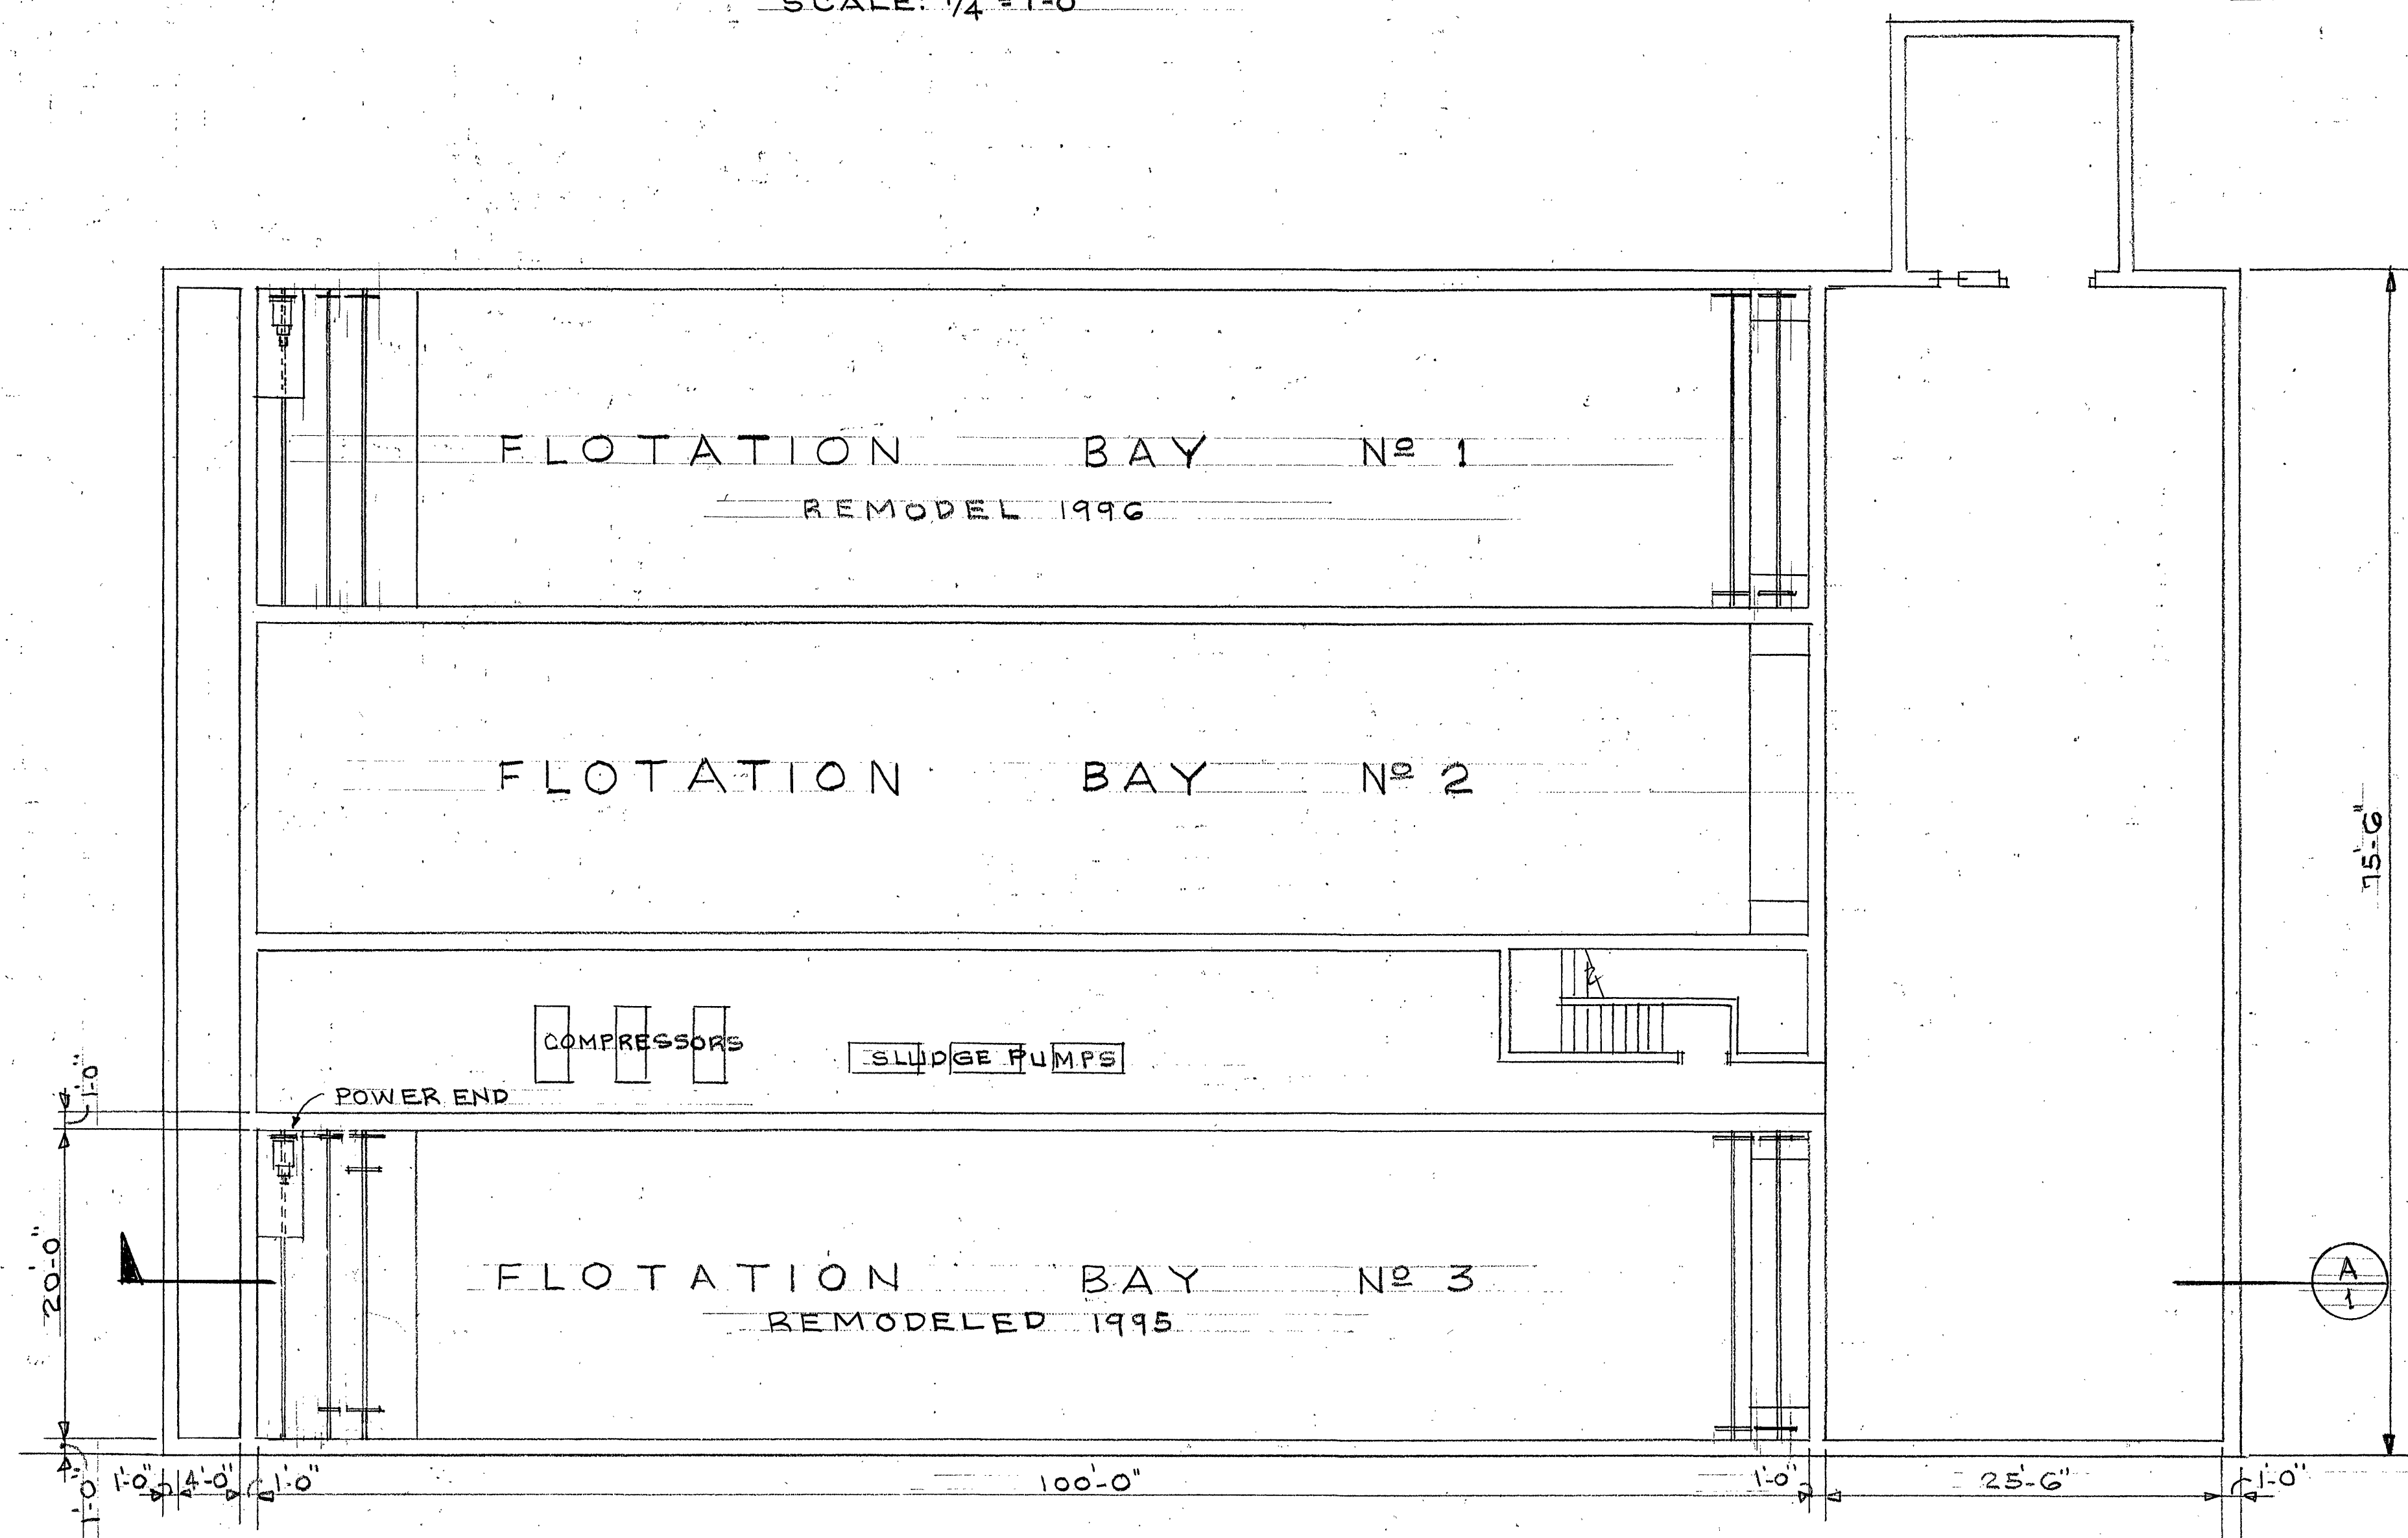


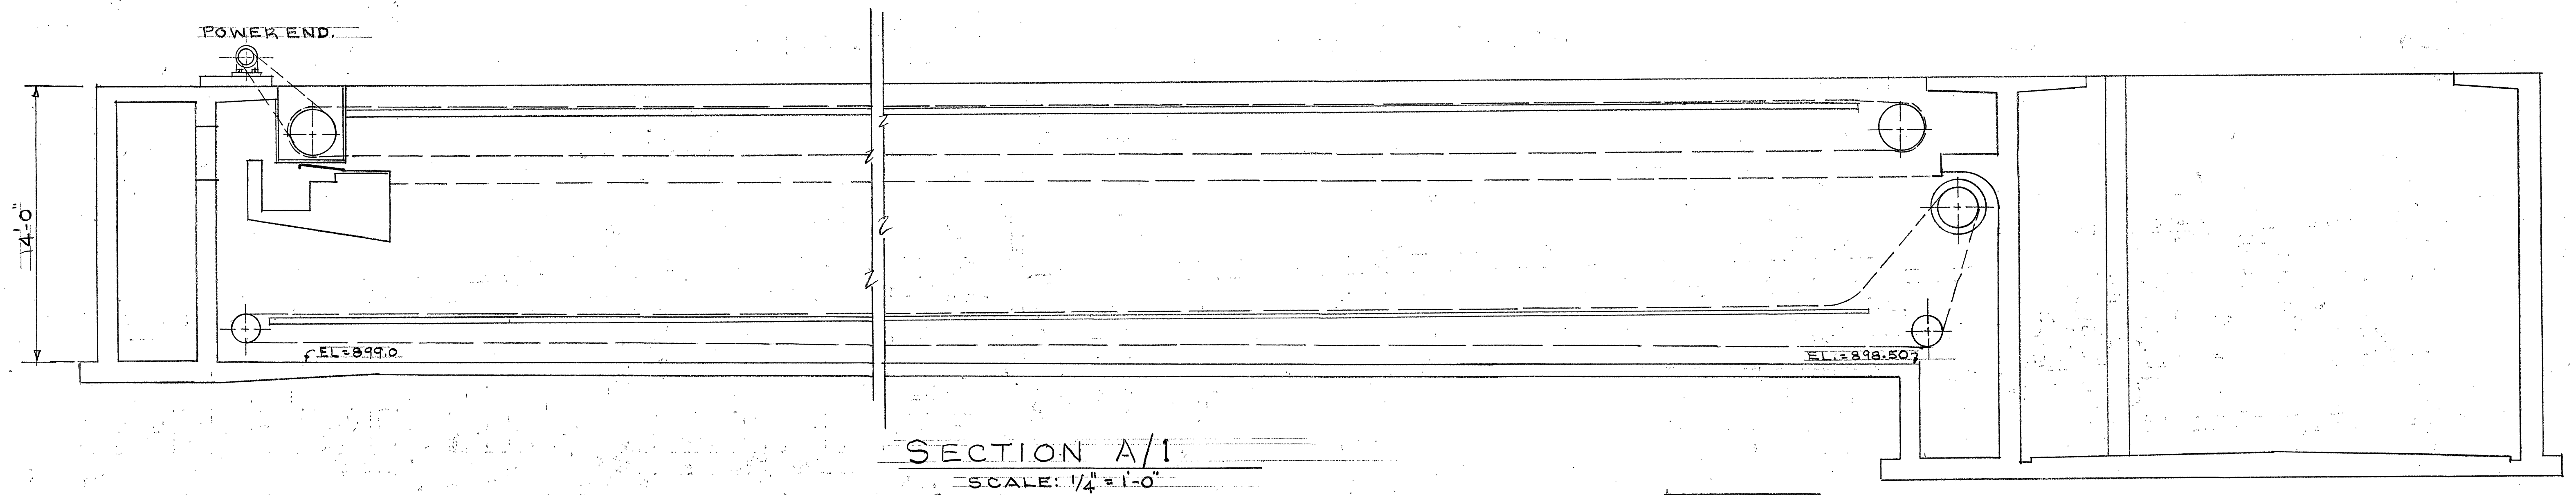

6-2496	1	ADD BAY 1	L.B.C.
10-12	10-12	10-12	10-12
Charles M. Buffing			CITY ENGINEER
COLLECTION EQUIPMENT			L.B.C.
INSTALLATION			10-12
WATER POLLUTION CONTROL PLANT			4-10-95
1402 BENNINGTON ST., S.E.			1995A
ROANOKE, VIRGINIA			1
10-12			1
10-12			1
10-12			1