

REMOVE CURB & GUTTER AND REPLACE		
FROM	TO	APPROX. LENGTH
1	2	120'
3	4	175'
5	6	482' (SH. 5)
7	8	225'

PB-1
BEND, Δ=153'23'03"
CP# 2000

PB-2
BEND, Δ=159'46'32"
CP# 2001

PB-3
BEND, Δ=159'18'34"
CP# 2002

PB-4
BEND, Δ=169'46'05"
CP# 2003

SB-1
BEND, Δ=101'01'11"
CP# 2100


BAF-INF-1
BEND, Δ=101'54'17"
CP# 2200

EXIST. PRIMARY BY-PASS
48" RCP

NEW SECONDARY BY-PASS
36" GRAVITY LINE

NEW BAF INFLUENT
24" FORCE MAIN

REFER TO SHEET G9 FOR
GENERAL SITE PLAN NOTES
AND STAKING DATA.

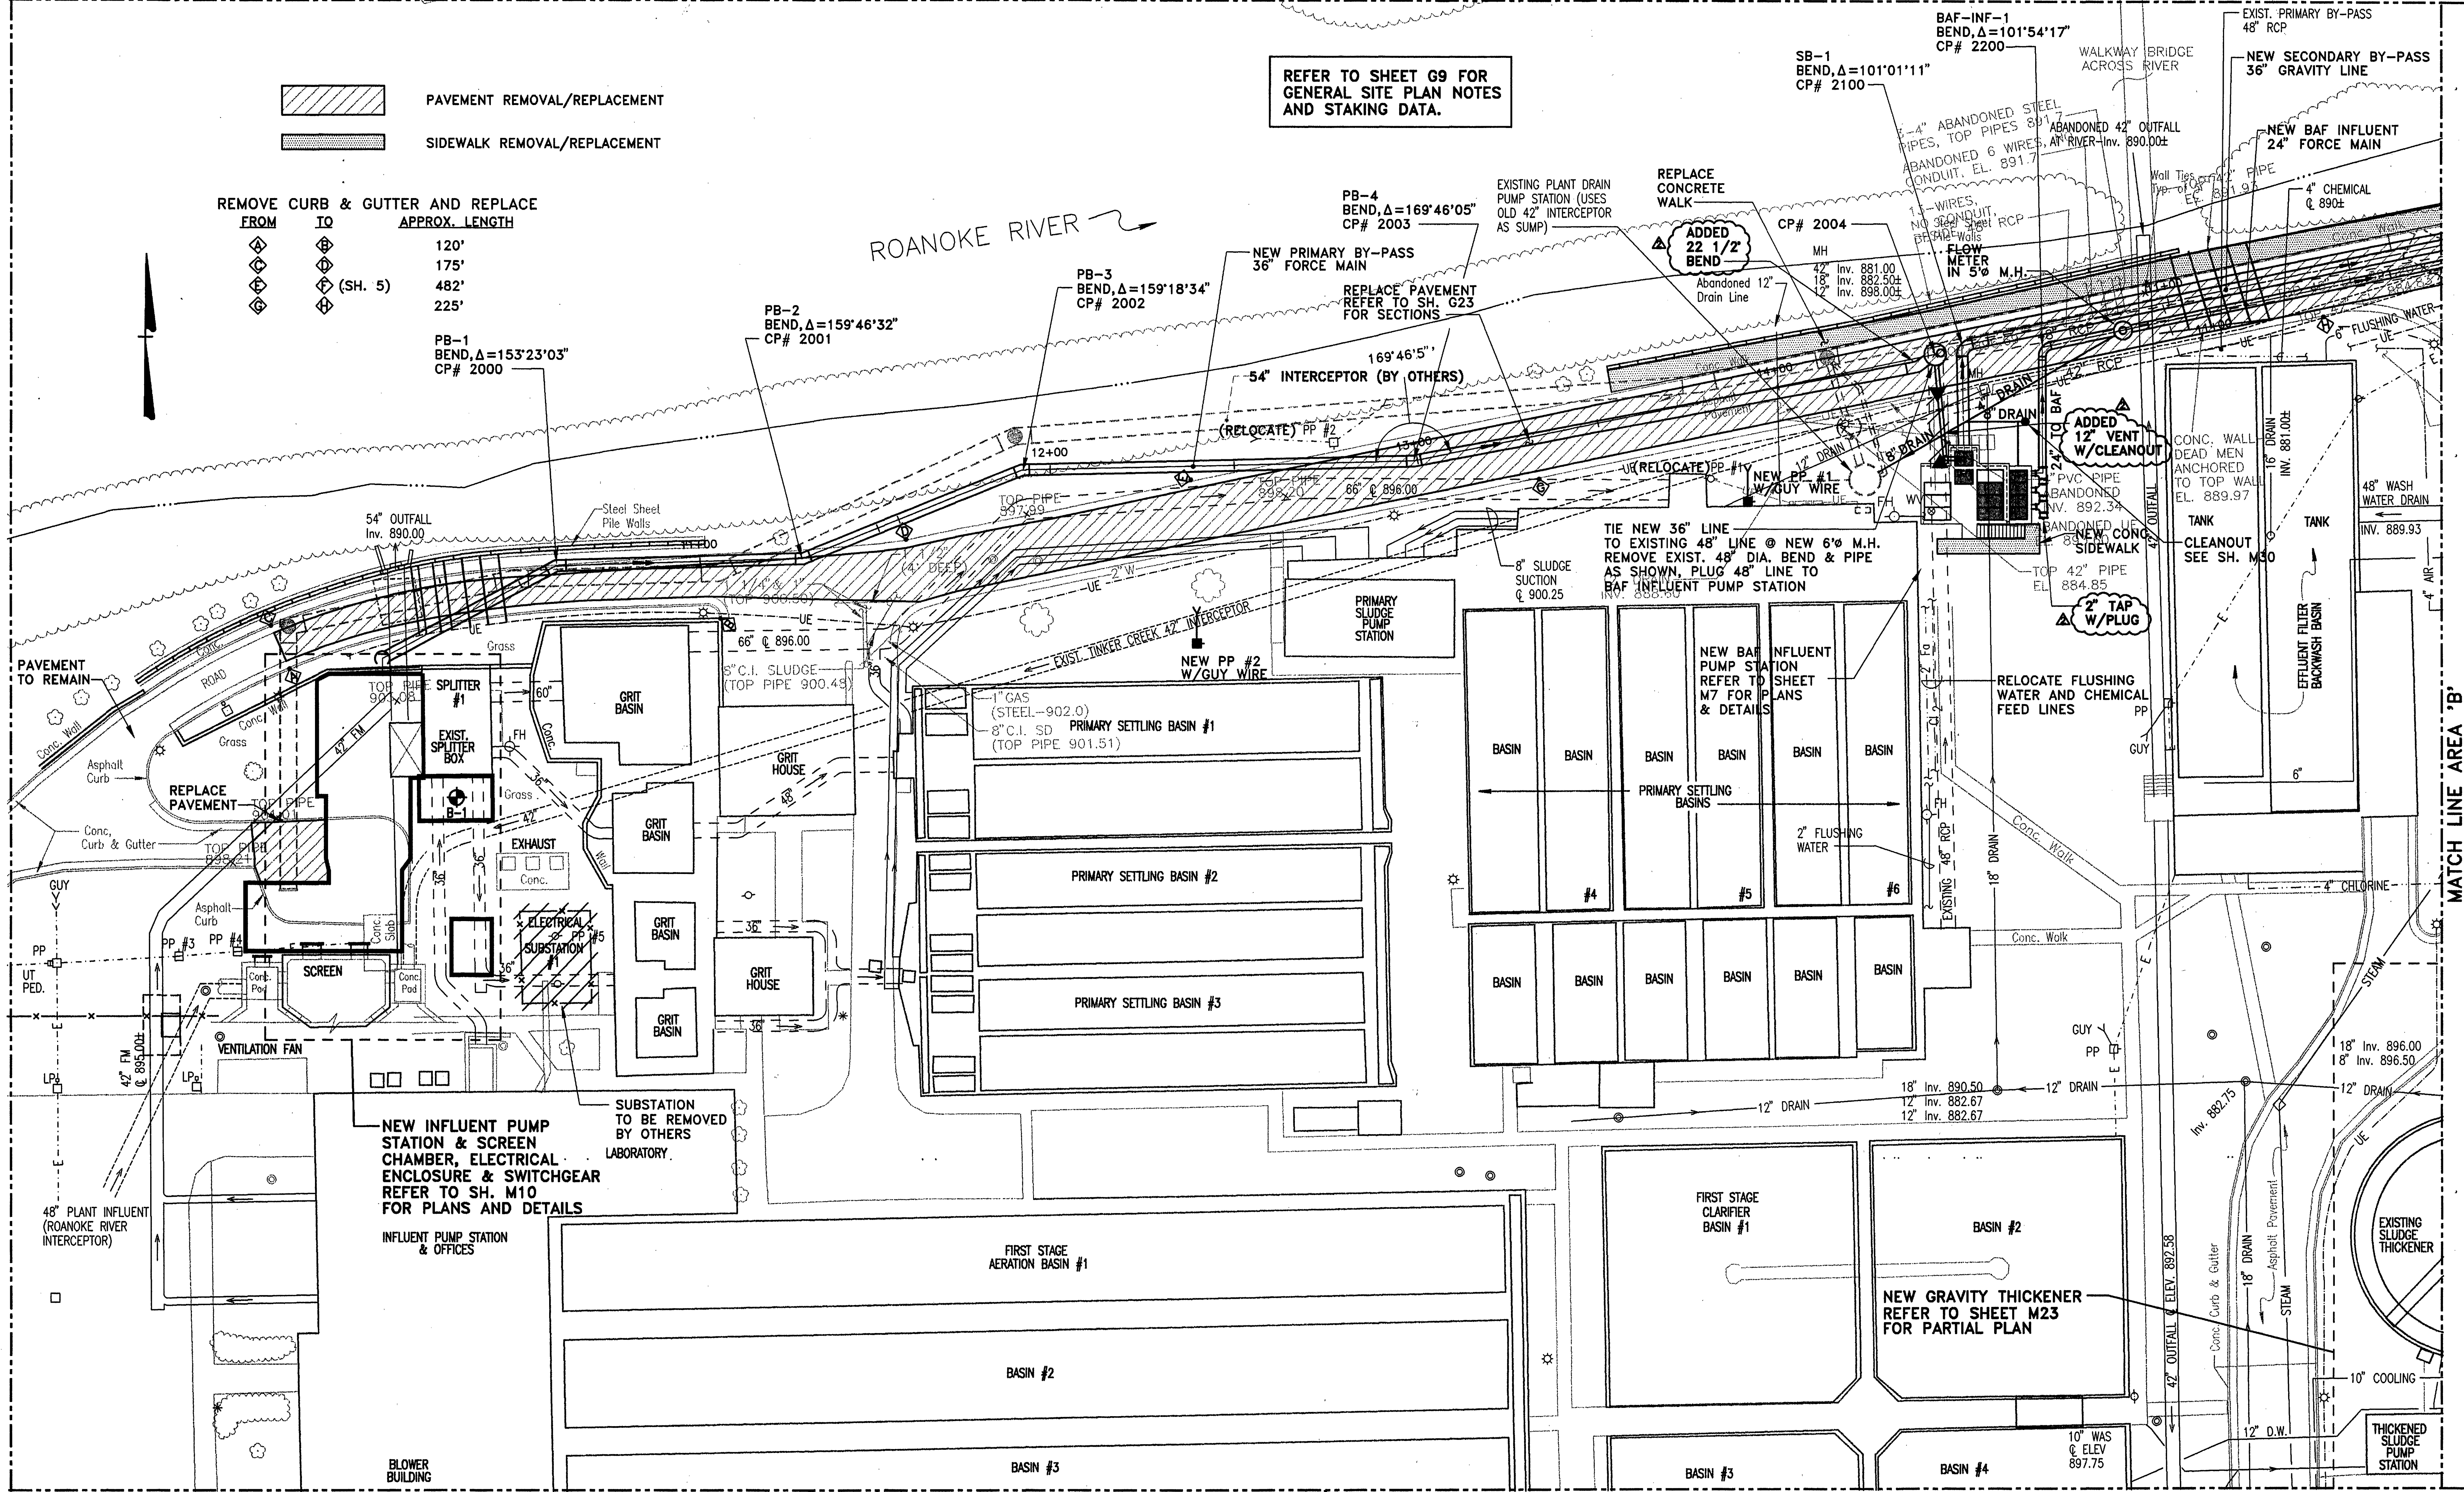

		<table border="1"> <thead> <tr> <th>NO.</th> <th>BY</th> <th>DATE</th> <th>REVISIONS</th> <th>REMARKS</th> </tr> </thead> <tbody> <tr> <td>1</td> <td>SWH</td> <td>2/12/98</td> <td>REVISED YARD PIPING, BAF P.S.</td> <td></td> </tr> <tr> <td>2</td> <td>ARB</td> <td>JAN. 2000</td> <td>RECORD DRAWINGS</td> <td></td> </tr> </tbody> </table>		NO.	BY	DATE	REVISIONS	REMARKS	1	SWH	2/12/98	REVISED YARD PIPING, BAF P.S.		2	ARB	JAN. 2000	RECORD DRAWINGS		DES. WTA DWN. LDL, ARB CKD. SWH		CITY OF ROANOKE, VIRGINIA WATER POLLUTION CONTROL PLANT UPGRADE AND EXPANSION	SITE PLAN LAYOUT, YARD PIPING, AND UTILITIES AREA 'A' 1"=20'	DATE MAY, 1997
		NO.	BY	DATE	REVISIONS	REMARKS																	
		1	SWH	2/12/98	REVISED YARD PIPING, BAF P.S.																		
		2	ARB	JAN. 2000	RECORD DRAWINGS																		
G SHEET 4 OF 23																							
CAD REF. NO. G4.DWG																							