
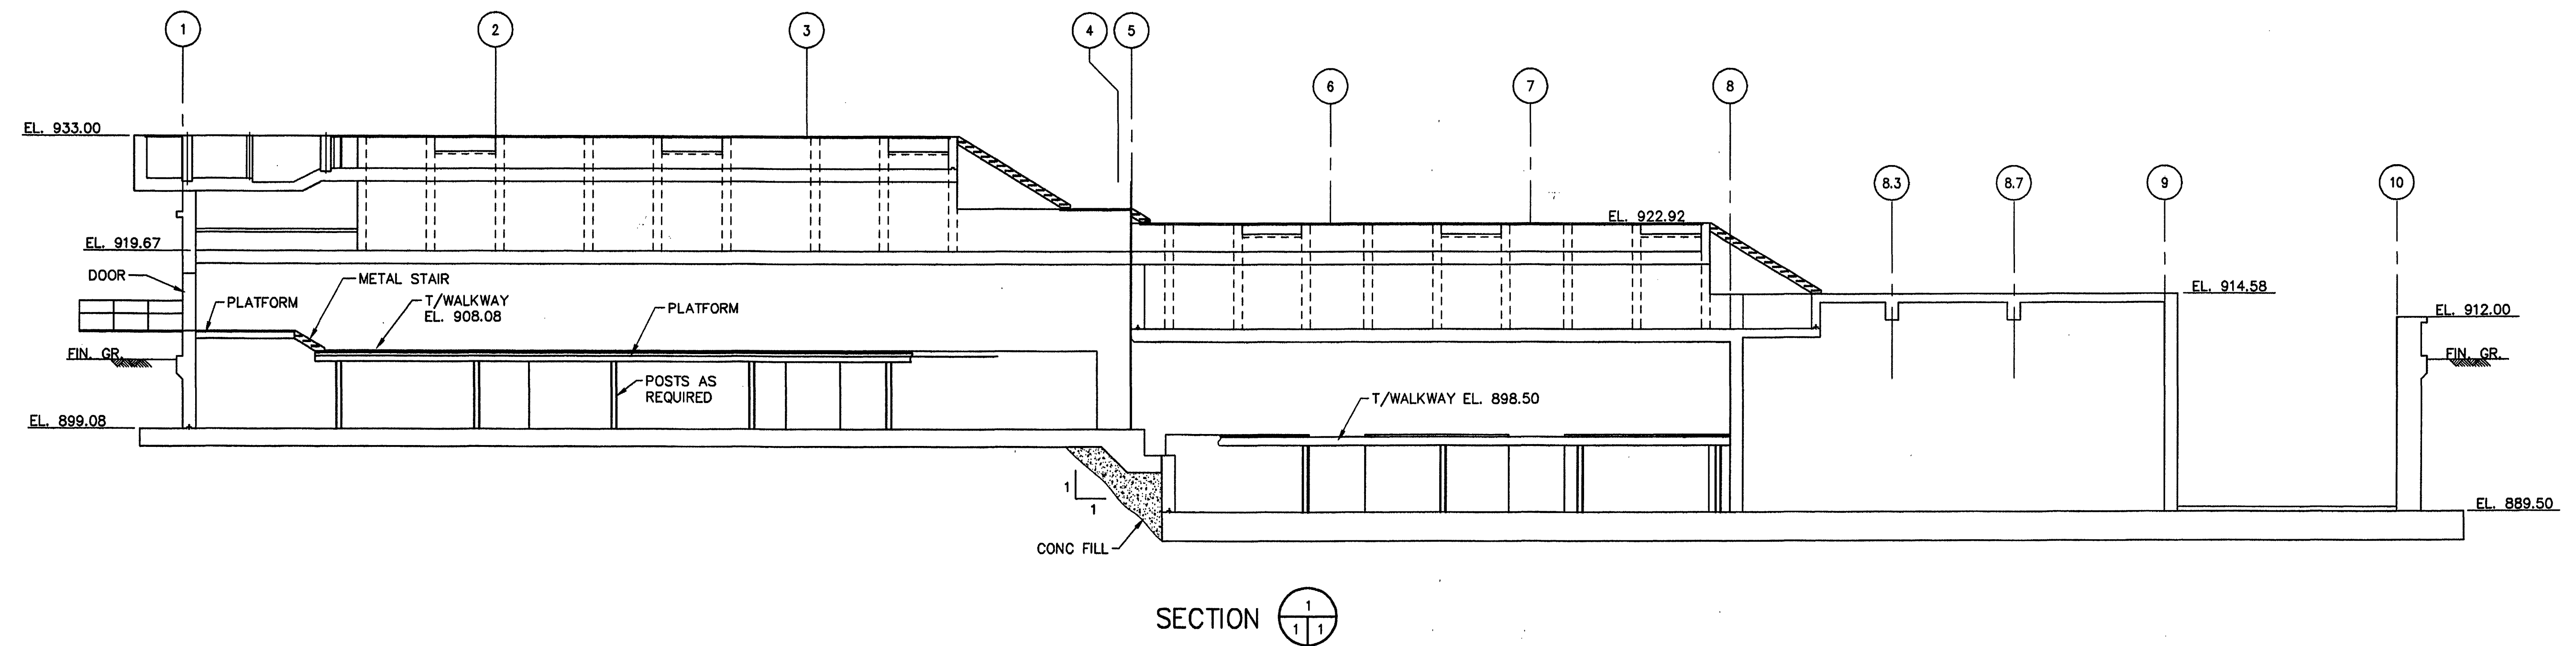


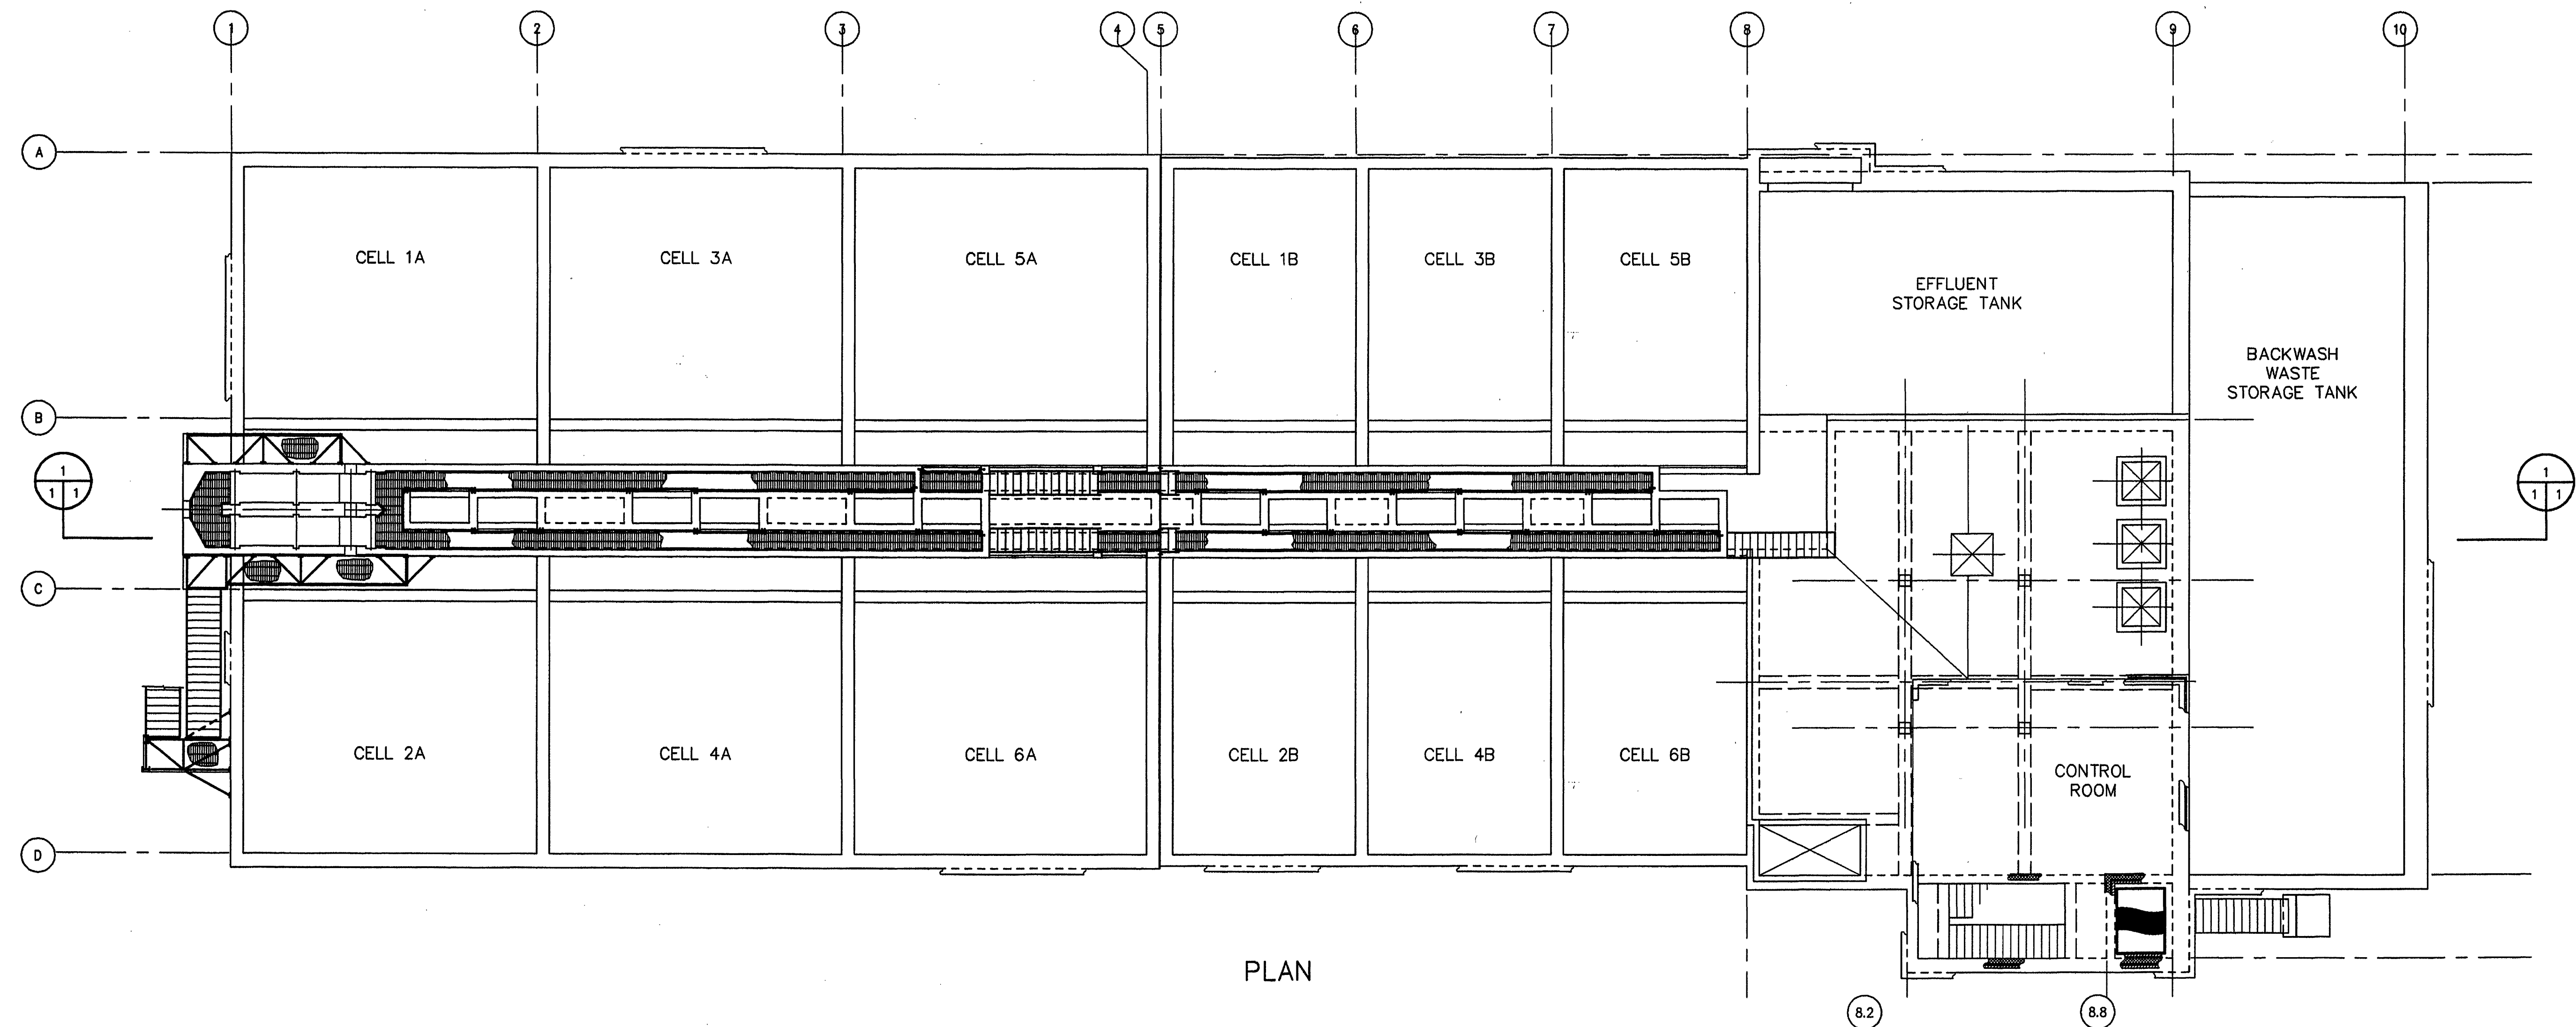

GENERAL NOTE:

NOT ALL BAF EQUIPMENT, PIPING, VALVES AND APPURTENANCES ARE SHOWN.
SEE SPECIFICATIONS AND BAF MANUFACTURER'S SHOP DRAWINGS FOR ADDITIONAL
ITEMS AND SCOPE OF EQUIPMENT, PIPING, VALVES AND APPURTENANCES
SUPPLIED TO THE CONTRACTOR BY THE BAF MANUFACTURER.

**MALCOLM
PIRNIE**
11832 Rock Landing Drive, Suite 400
Newport News, Virginia 23606

REVISIONS				DES	DWN	CKD
NO.	BY	DATE	REMARKS			
1	ARB	JAN. 2000	RECORD DRAWING	DB	DRK	DB



CITY OF ROANOKE, VIRGINIA
WATER POLLUTION
CONTROL PLANT
UPGRADE AND EXPANSION

BIOLOGICAL AERATED FILTER
KEY PLAN &
SECTION
3/32"=1'-0"

COPYRIGHT © 1997
MALCOLM PIRNIE, INC.
DATE MAY 1997
S SHEET 1 OF 44
CAD REF. NO. 00805351

4571 256400000 L:\CADD\00805351\00805351.dwg Scale: 1/1 Date: 05/06/1997 Time: 13:11