




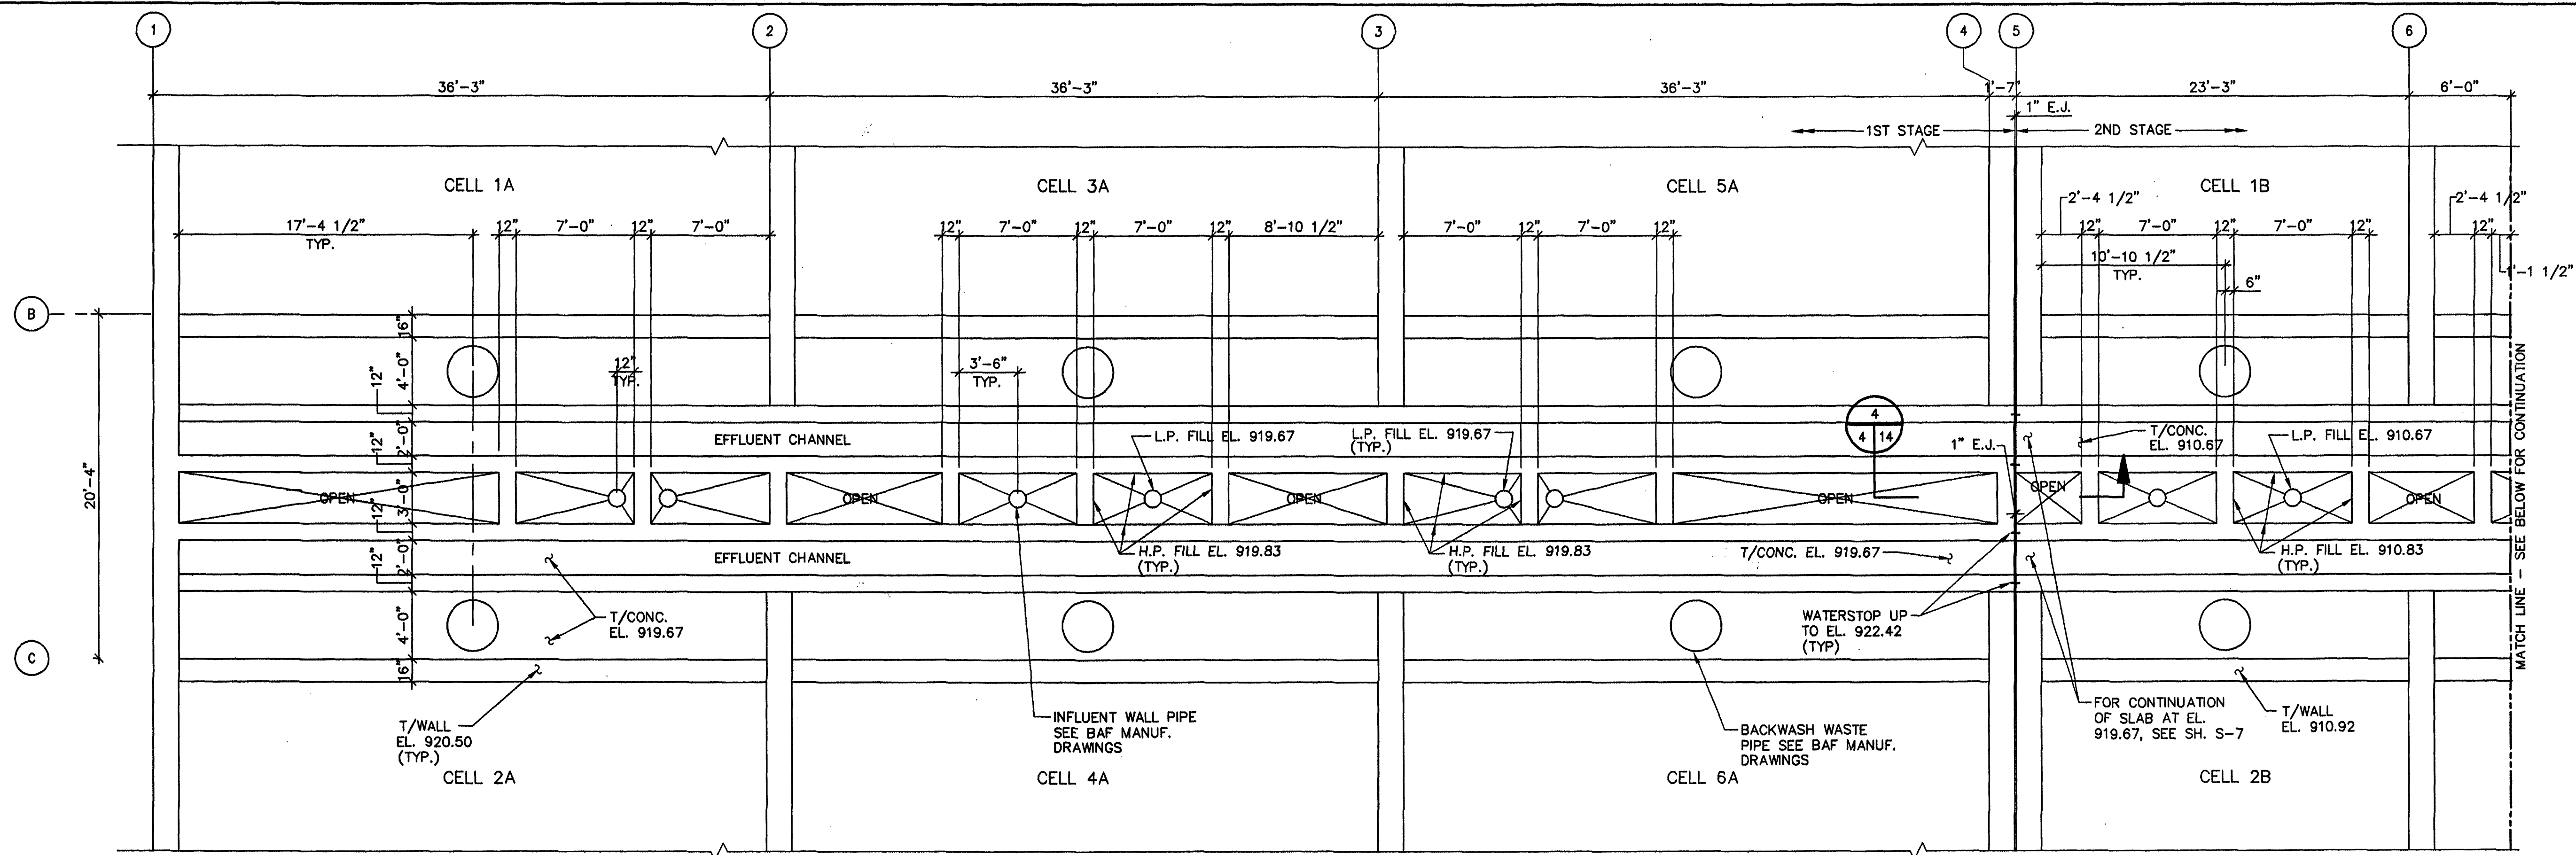

EFFLUENT CHANNEL PART. PLAN
EL. 919.67 (1ST STAGE) & EL. 910.67 (2ND STAGE)

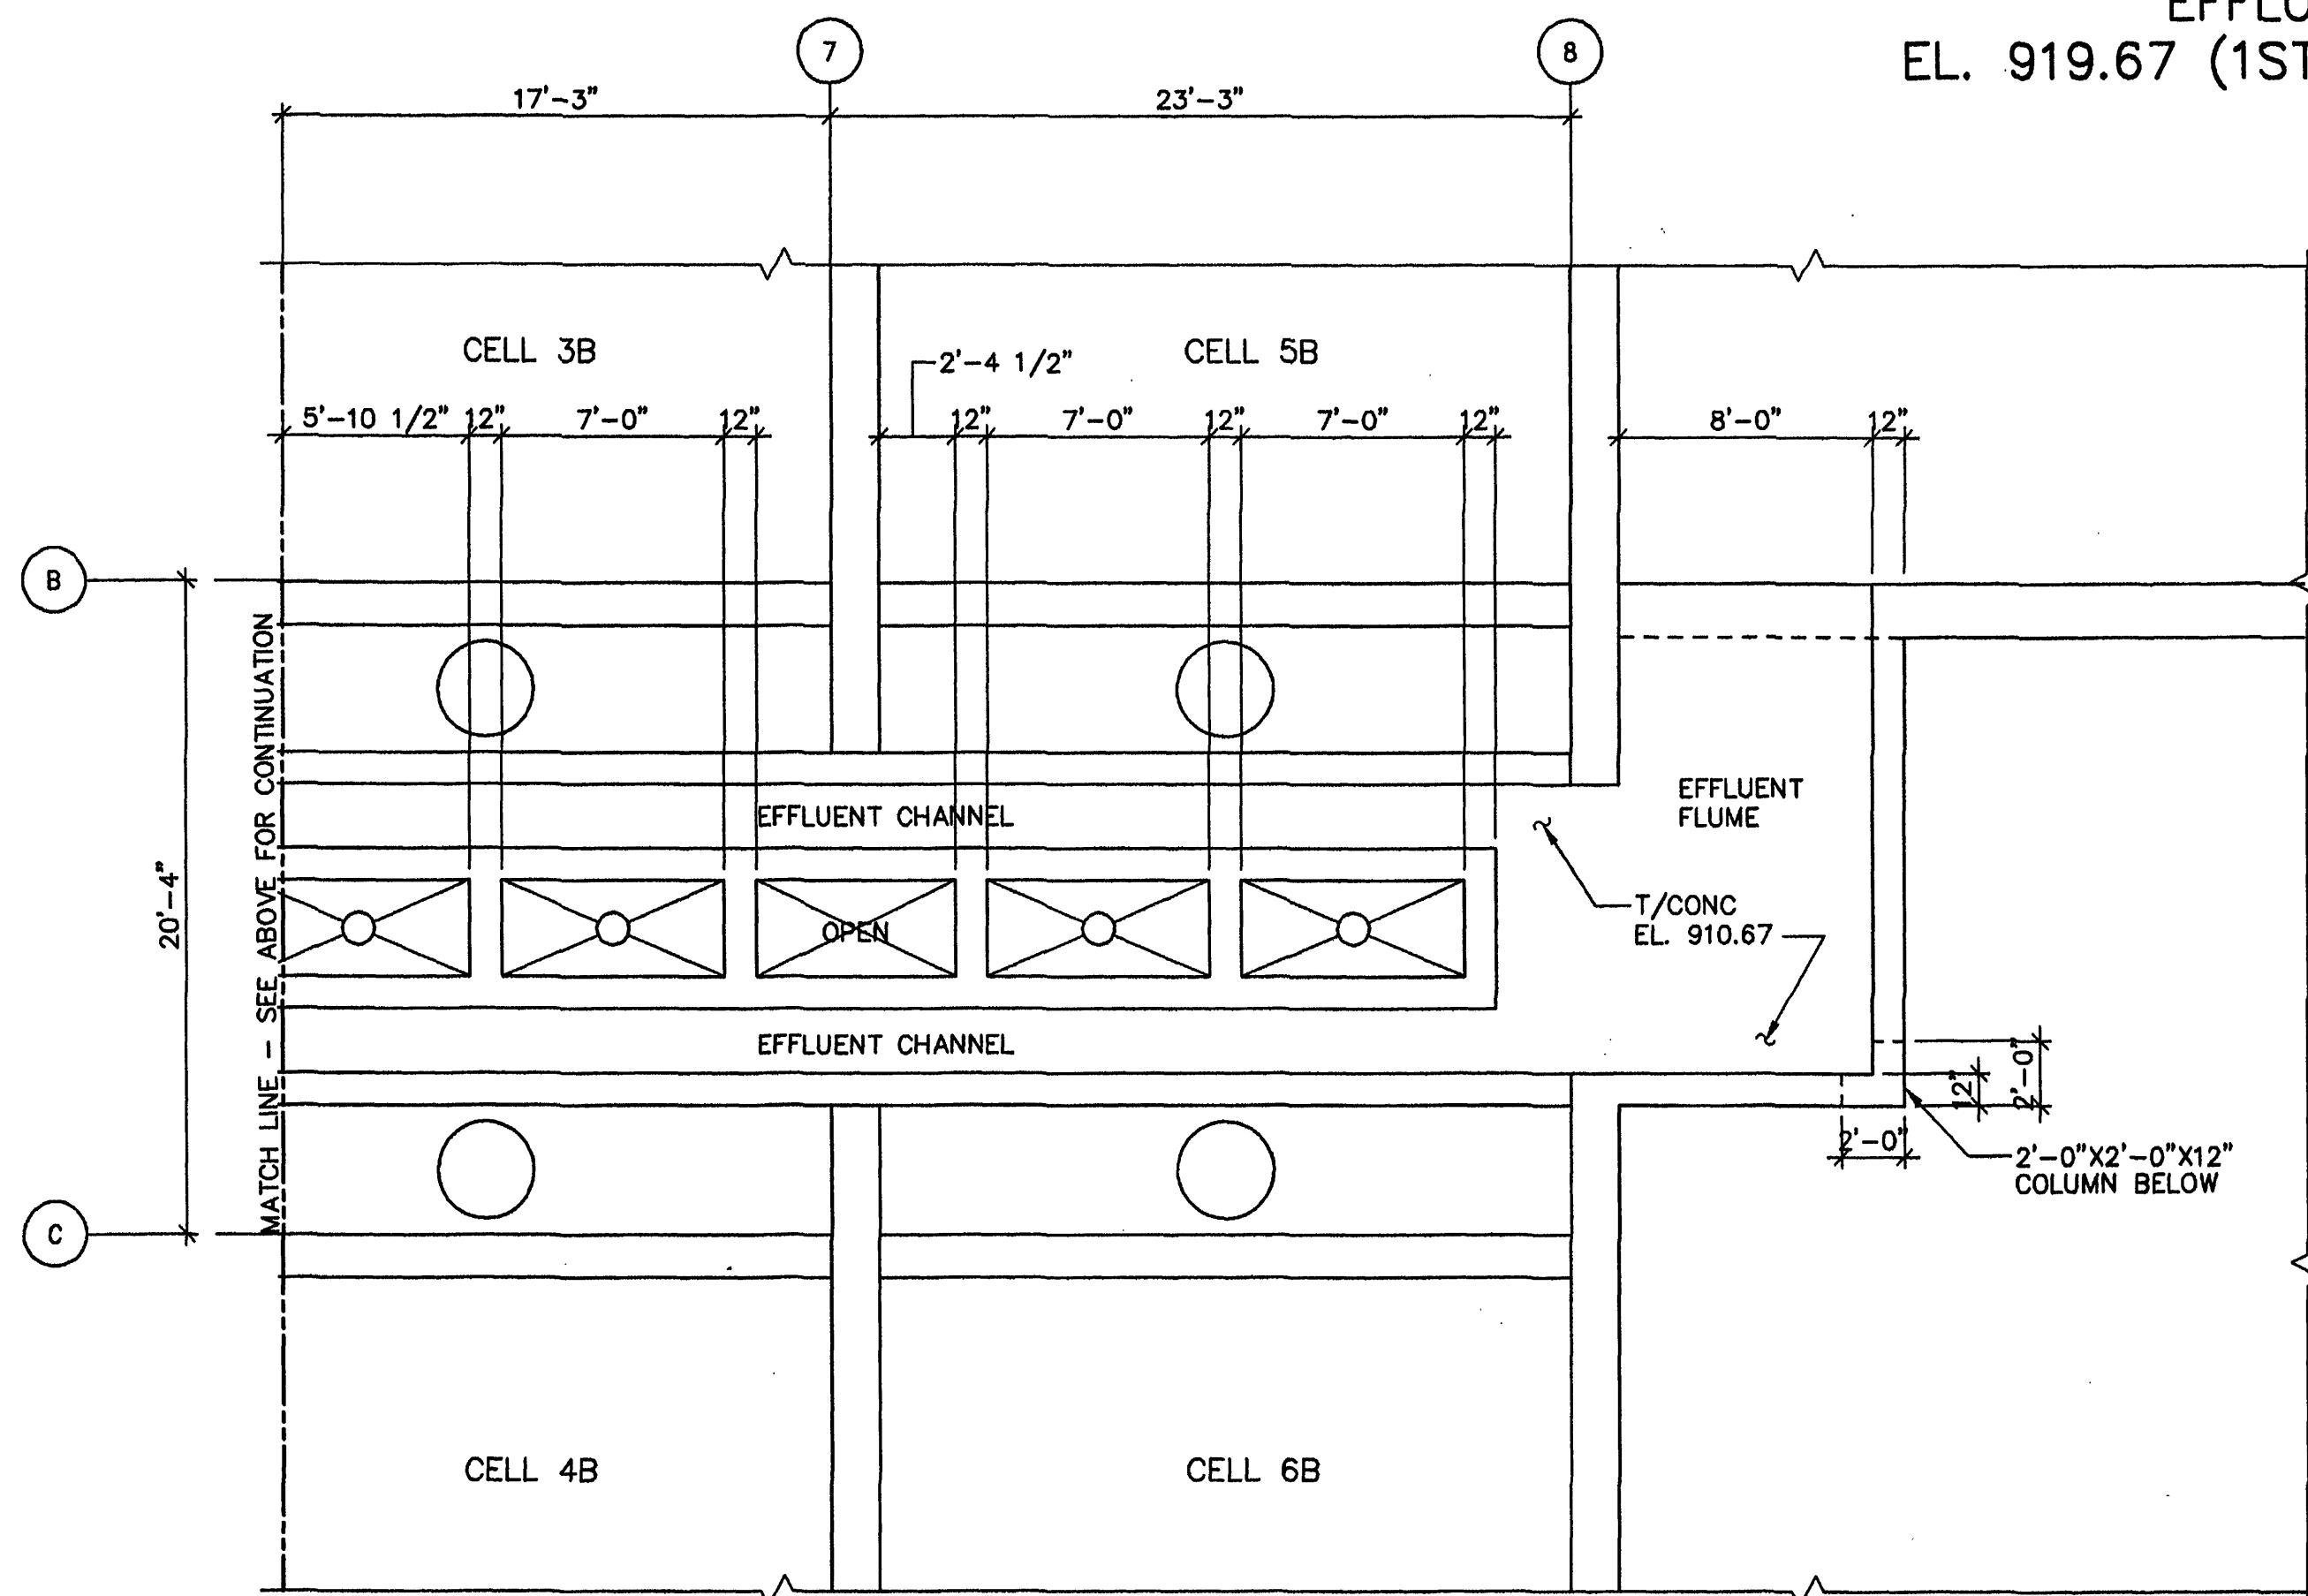

EFFLUENT CHANNEL PART. PLAN (CONT'D)
EL. 919.67 (1ST STAGE) & EL. 910.67 (2ND STAGE)

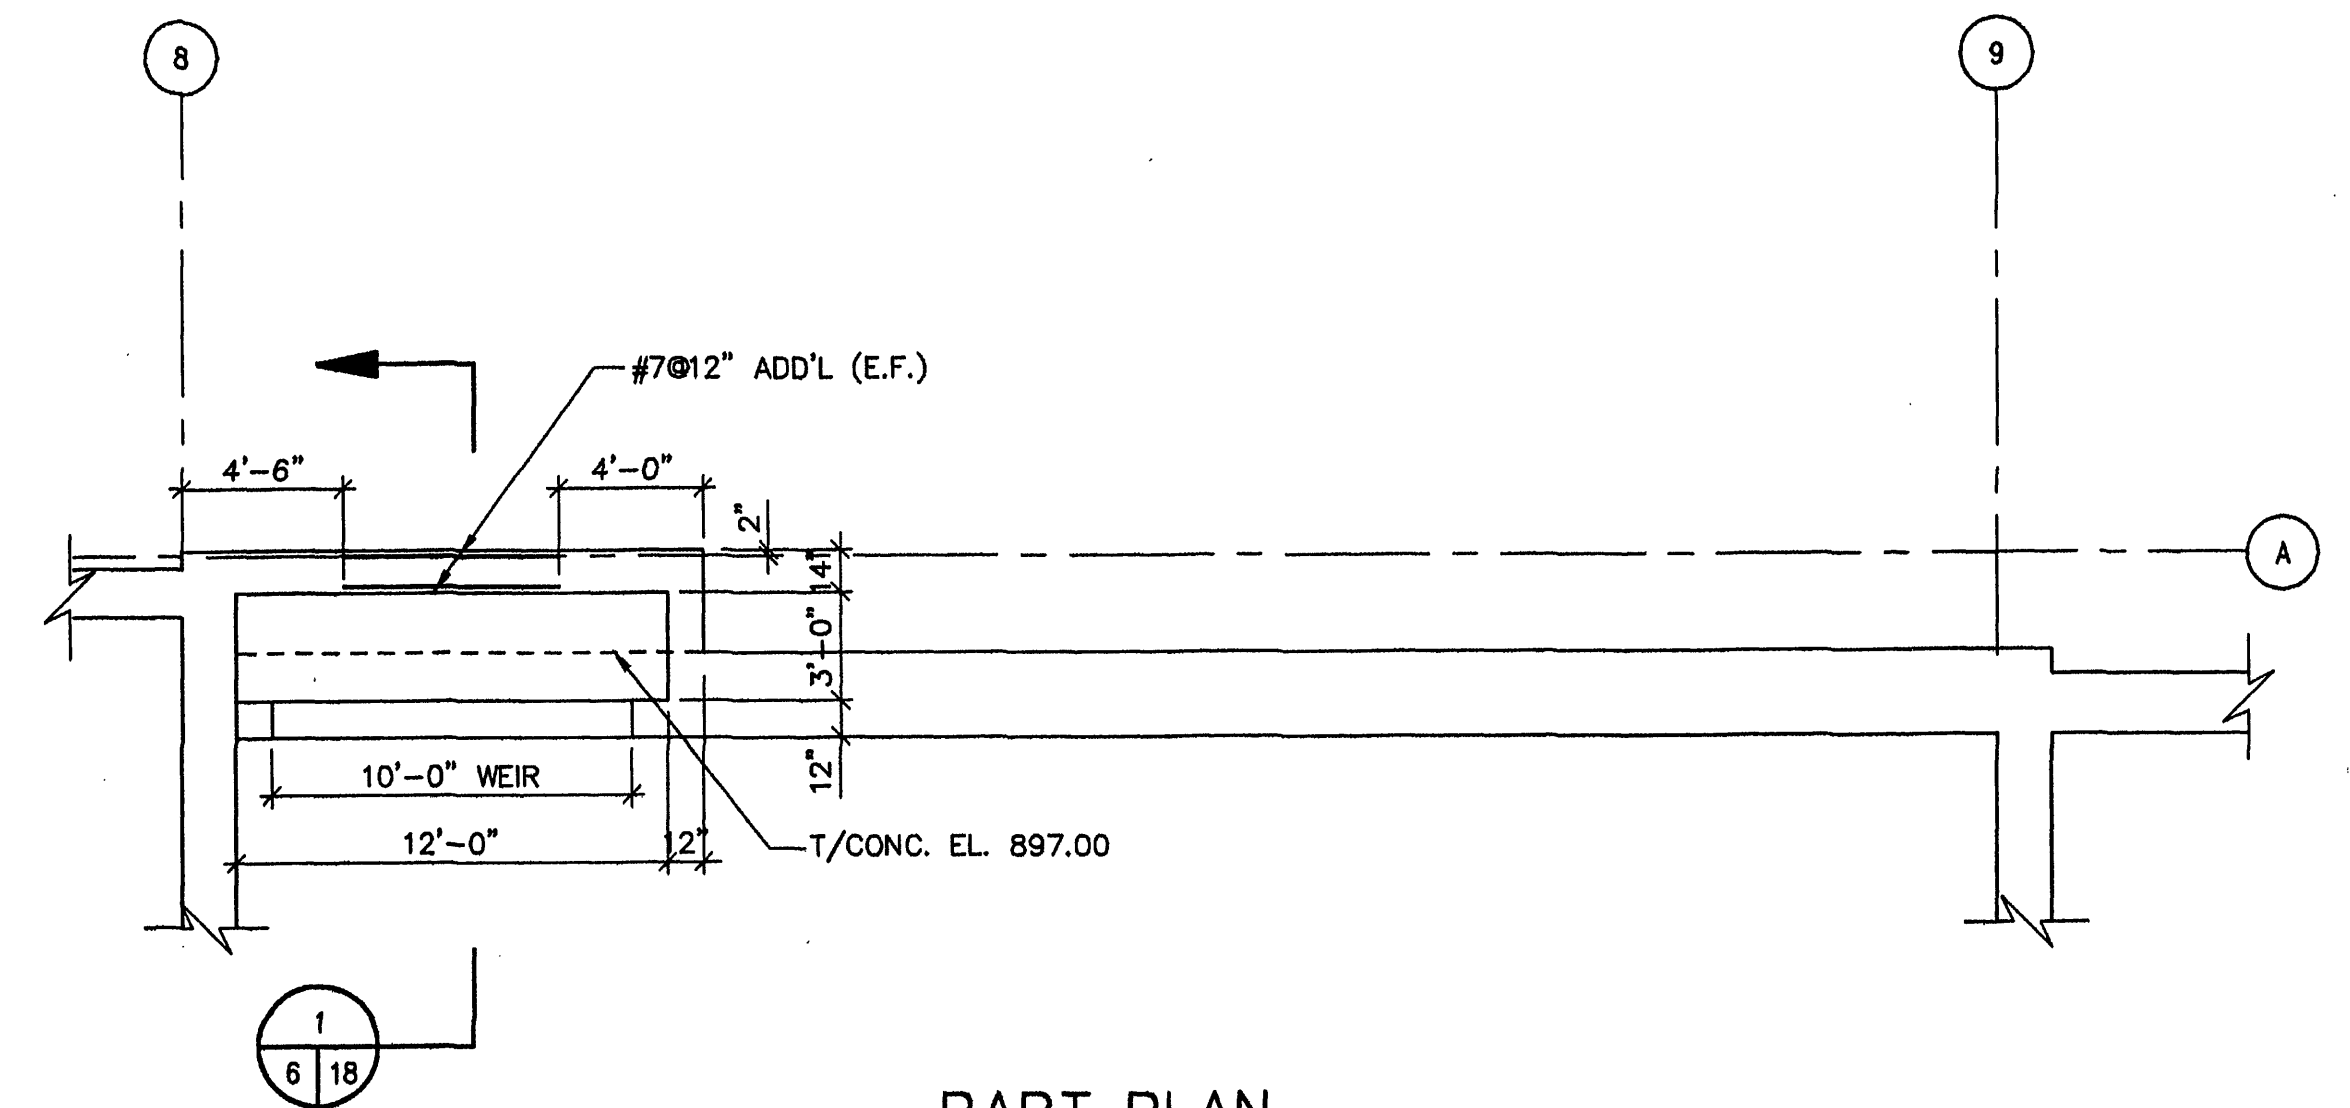

PART PLAN
EFFLUENT OVERFLOW CHAMBER

GENERAL NOTE:

NOT ALL BAF EQUIPMENT, PIPING, VALVES AND APPURTENANCES ARE SHOWN.
SEE SPECIFICATIONS AND BAF MANUFACTURER'S SHOP DRAWINGS FOR ADDITIONAL
ITEMS AND SCOPE OF EQUIPMENT, PIPING, VALVES AND APPURTENANCES
SUPPLIED TO THE CONTRACTOR BY THE BAF MANUFACTURER.

**MALCOLM
PIRNIE**
11832 Rock Landing Drive, Suite 400
Newport News, Virginia 23606

REVISIONS				REMARKS
NO.	BY	DATE	DESCRIPTION	
1	ARB	JAN. 2000	RECORD DRAWING	

DES --- MMZ ---
DWN --- CBM ---
CKD --- DB ---



CITY OF ROANOKE, VIRGINIA
WATER POLLUTION
CONTROL PLANT
UPGRADE AND EXPANSION

BIOLOGICAL AERATED FILTER
EFFLUENT CHANNELS
PART. PLANS & SECTIONS
SCALE: 3/16"=1'-0"

COPYRIGHT © 1997
MALCOLM PIRNIE, INC.
DATE --- MAY 1997 ---
S SHEET 6 OF 44 ---
CAD REF. NO. 00605356