



4873 0060028592 I:\ACAD\PROJ\00600285\00600376 Scale: 1:11 Date: 05/01/1997 Time: 08:45

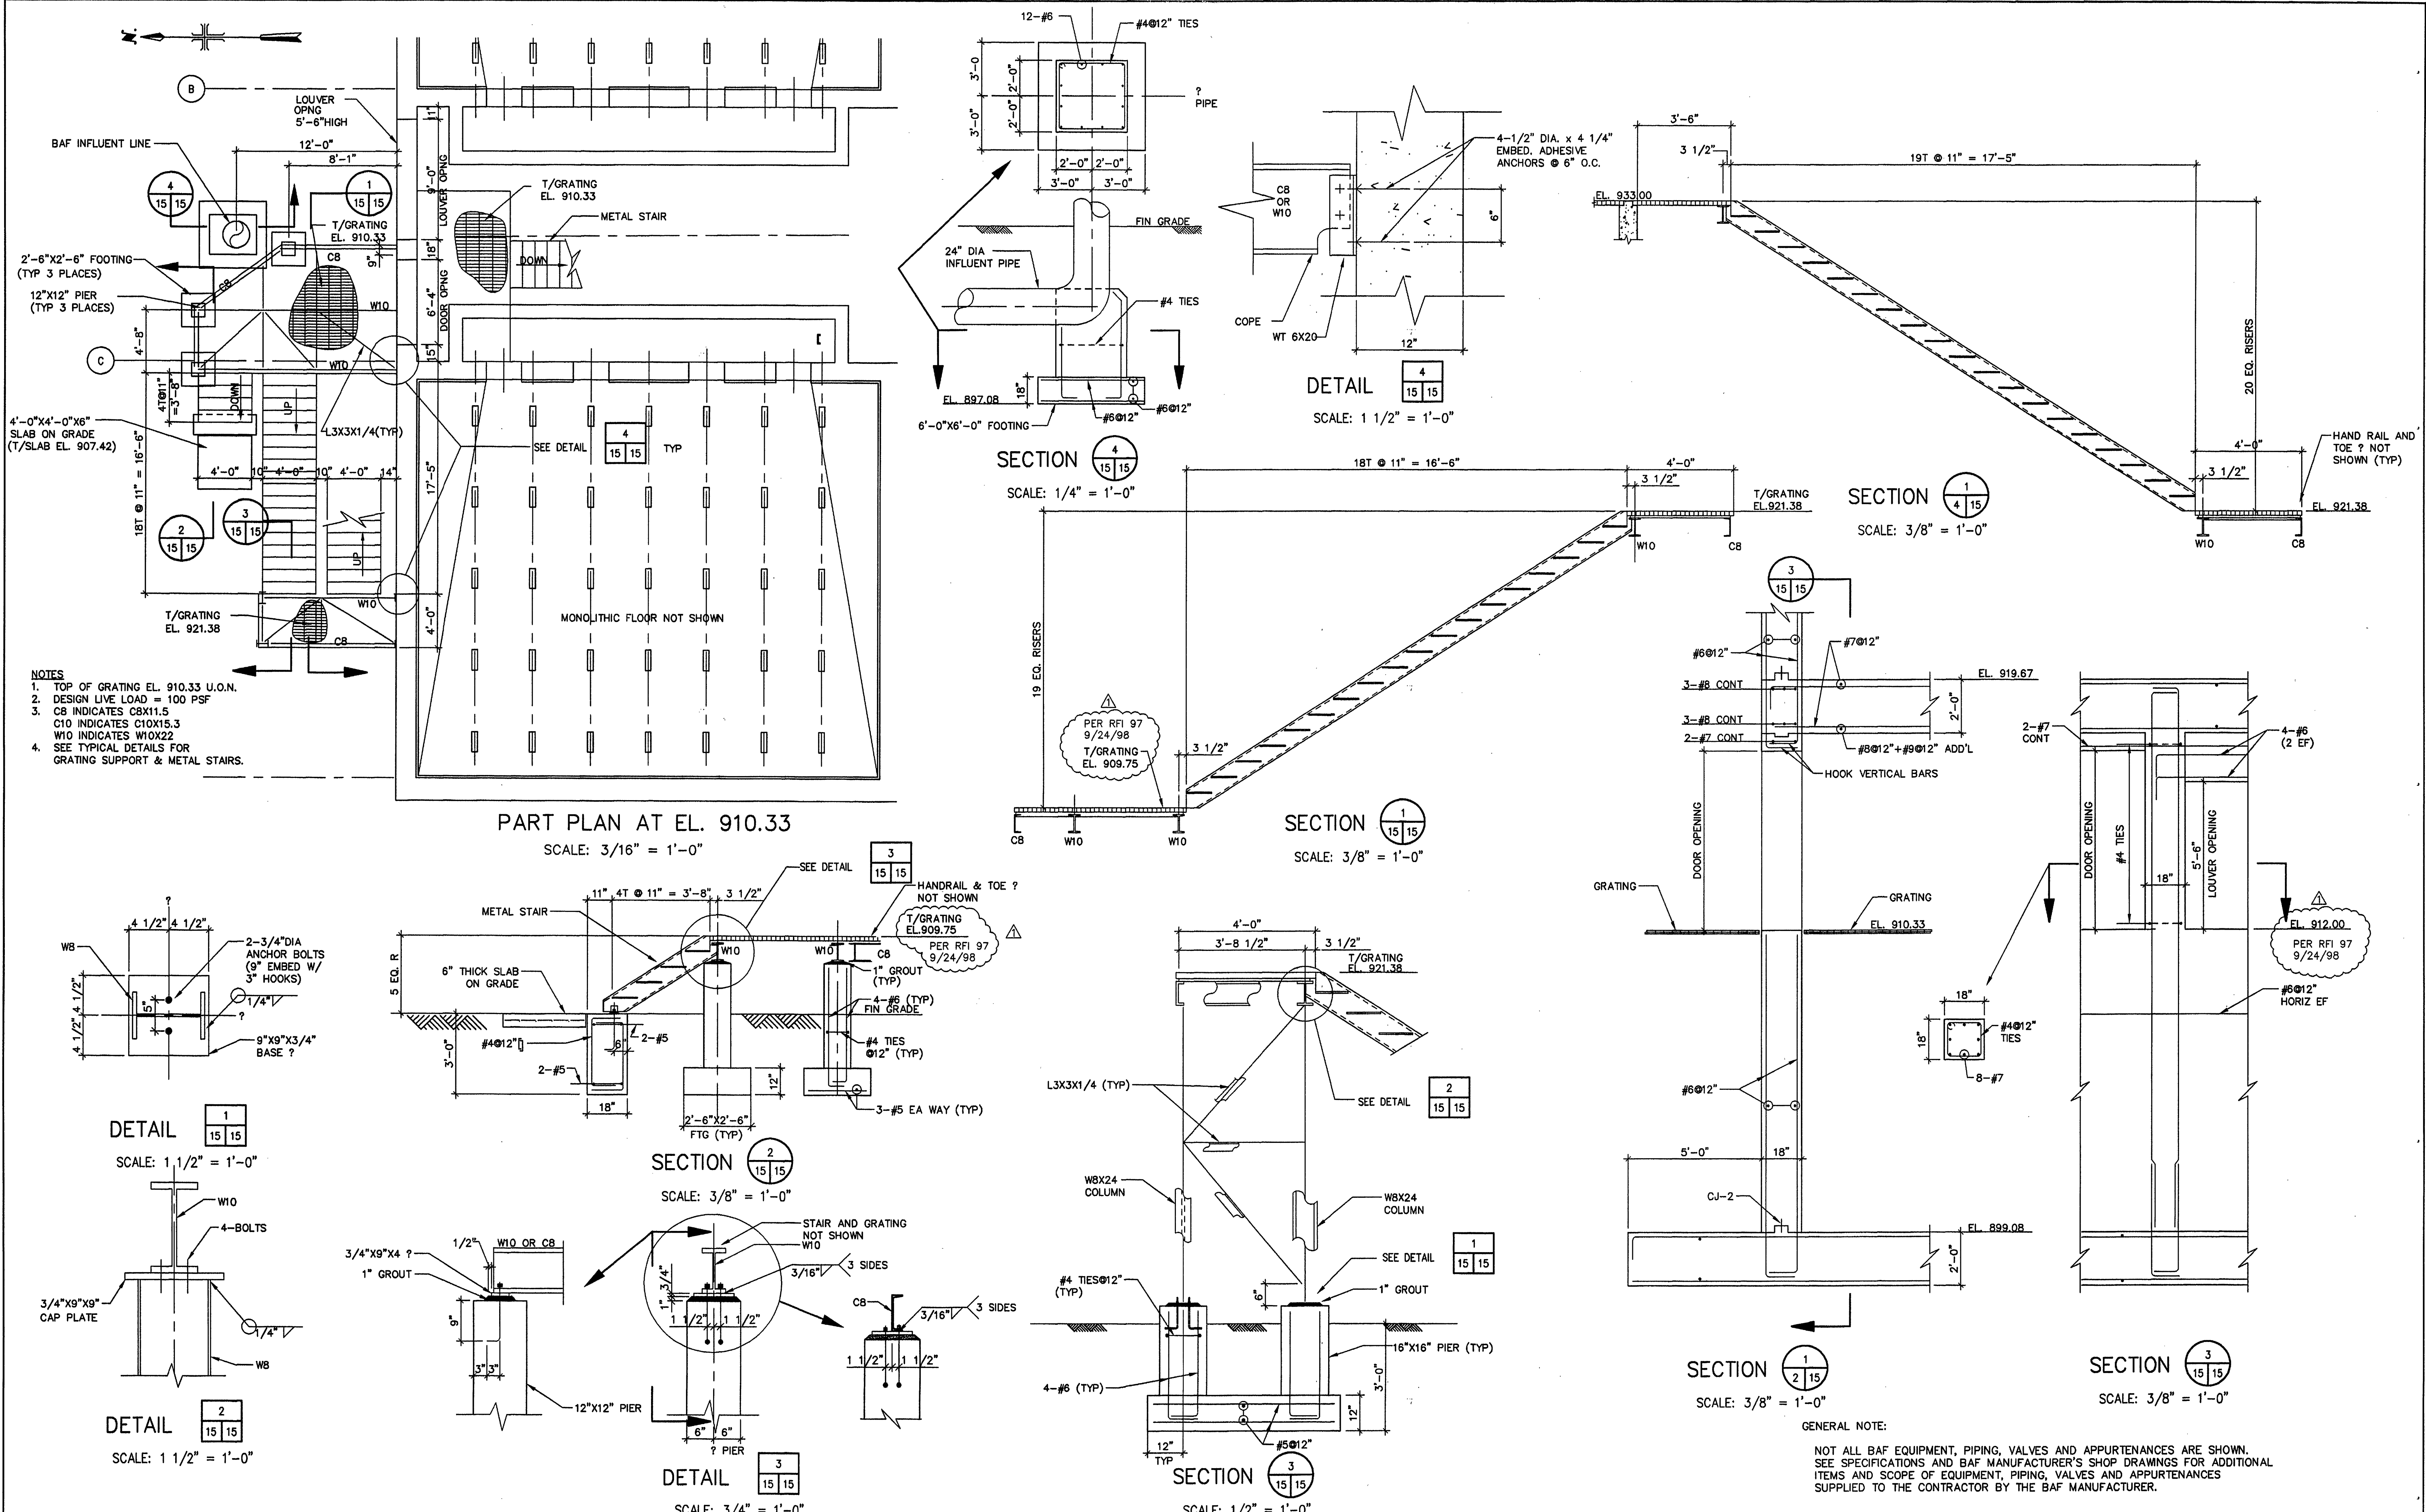

MALCOLM PIRNIE
11832 Rock Landing Drive, Suite 400
Newport News, Virginia 23606

REVISIONS				REMARKS
NO.	BY	DATE	DESCRIPTION	
1	ARB	JAN. 2000	RECORD DRAWING	

DES -- DB --
DWN -- CBM --
CKD -- DB --

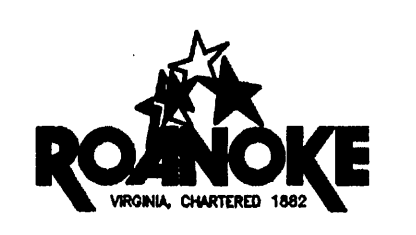

CITY OF ROANOKE, VIRGINIA
**WATER POLLUTION
CONTROL PLANT
UPGRADE AND EXPANSION**

**BIOLOGICAL AERATED FILTER
PART. PLAN, SECTIONS & DETAILS**
SCALE AS NOTED

COPYRIGHT © 1997
MALCOLM PIRNIE, INC.
DATE -- MAY 1997 --
S SHEET 15 OF 44 --
CAD REF. NO. 00600376