



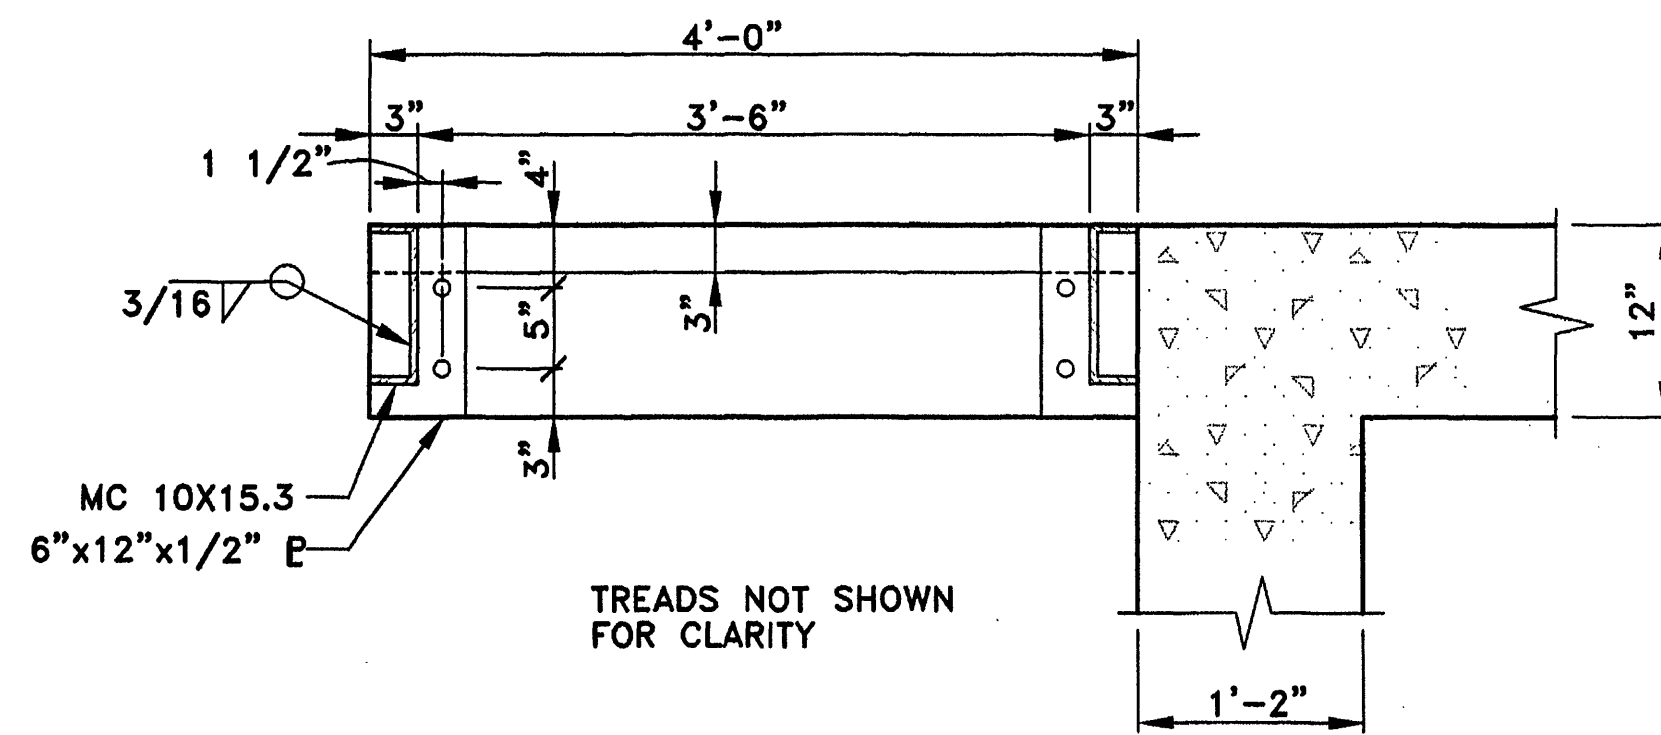


SECTION
SCALE: 1"=1'-0"

1
23/23

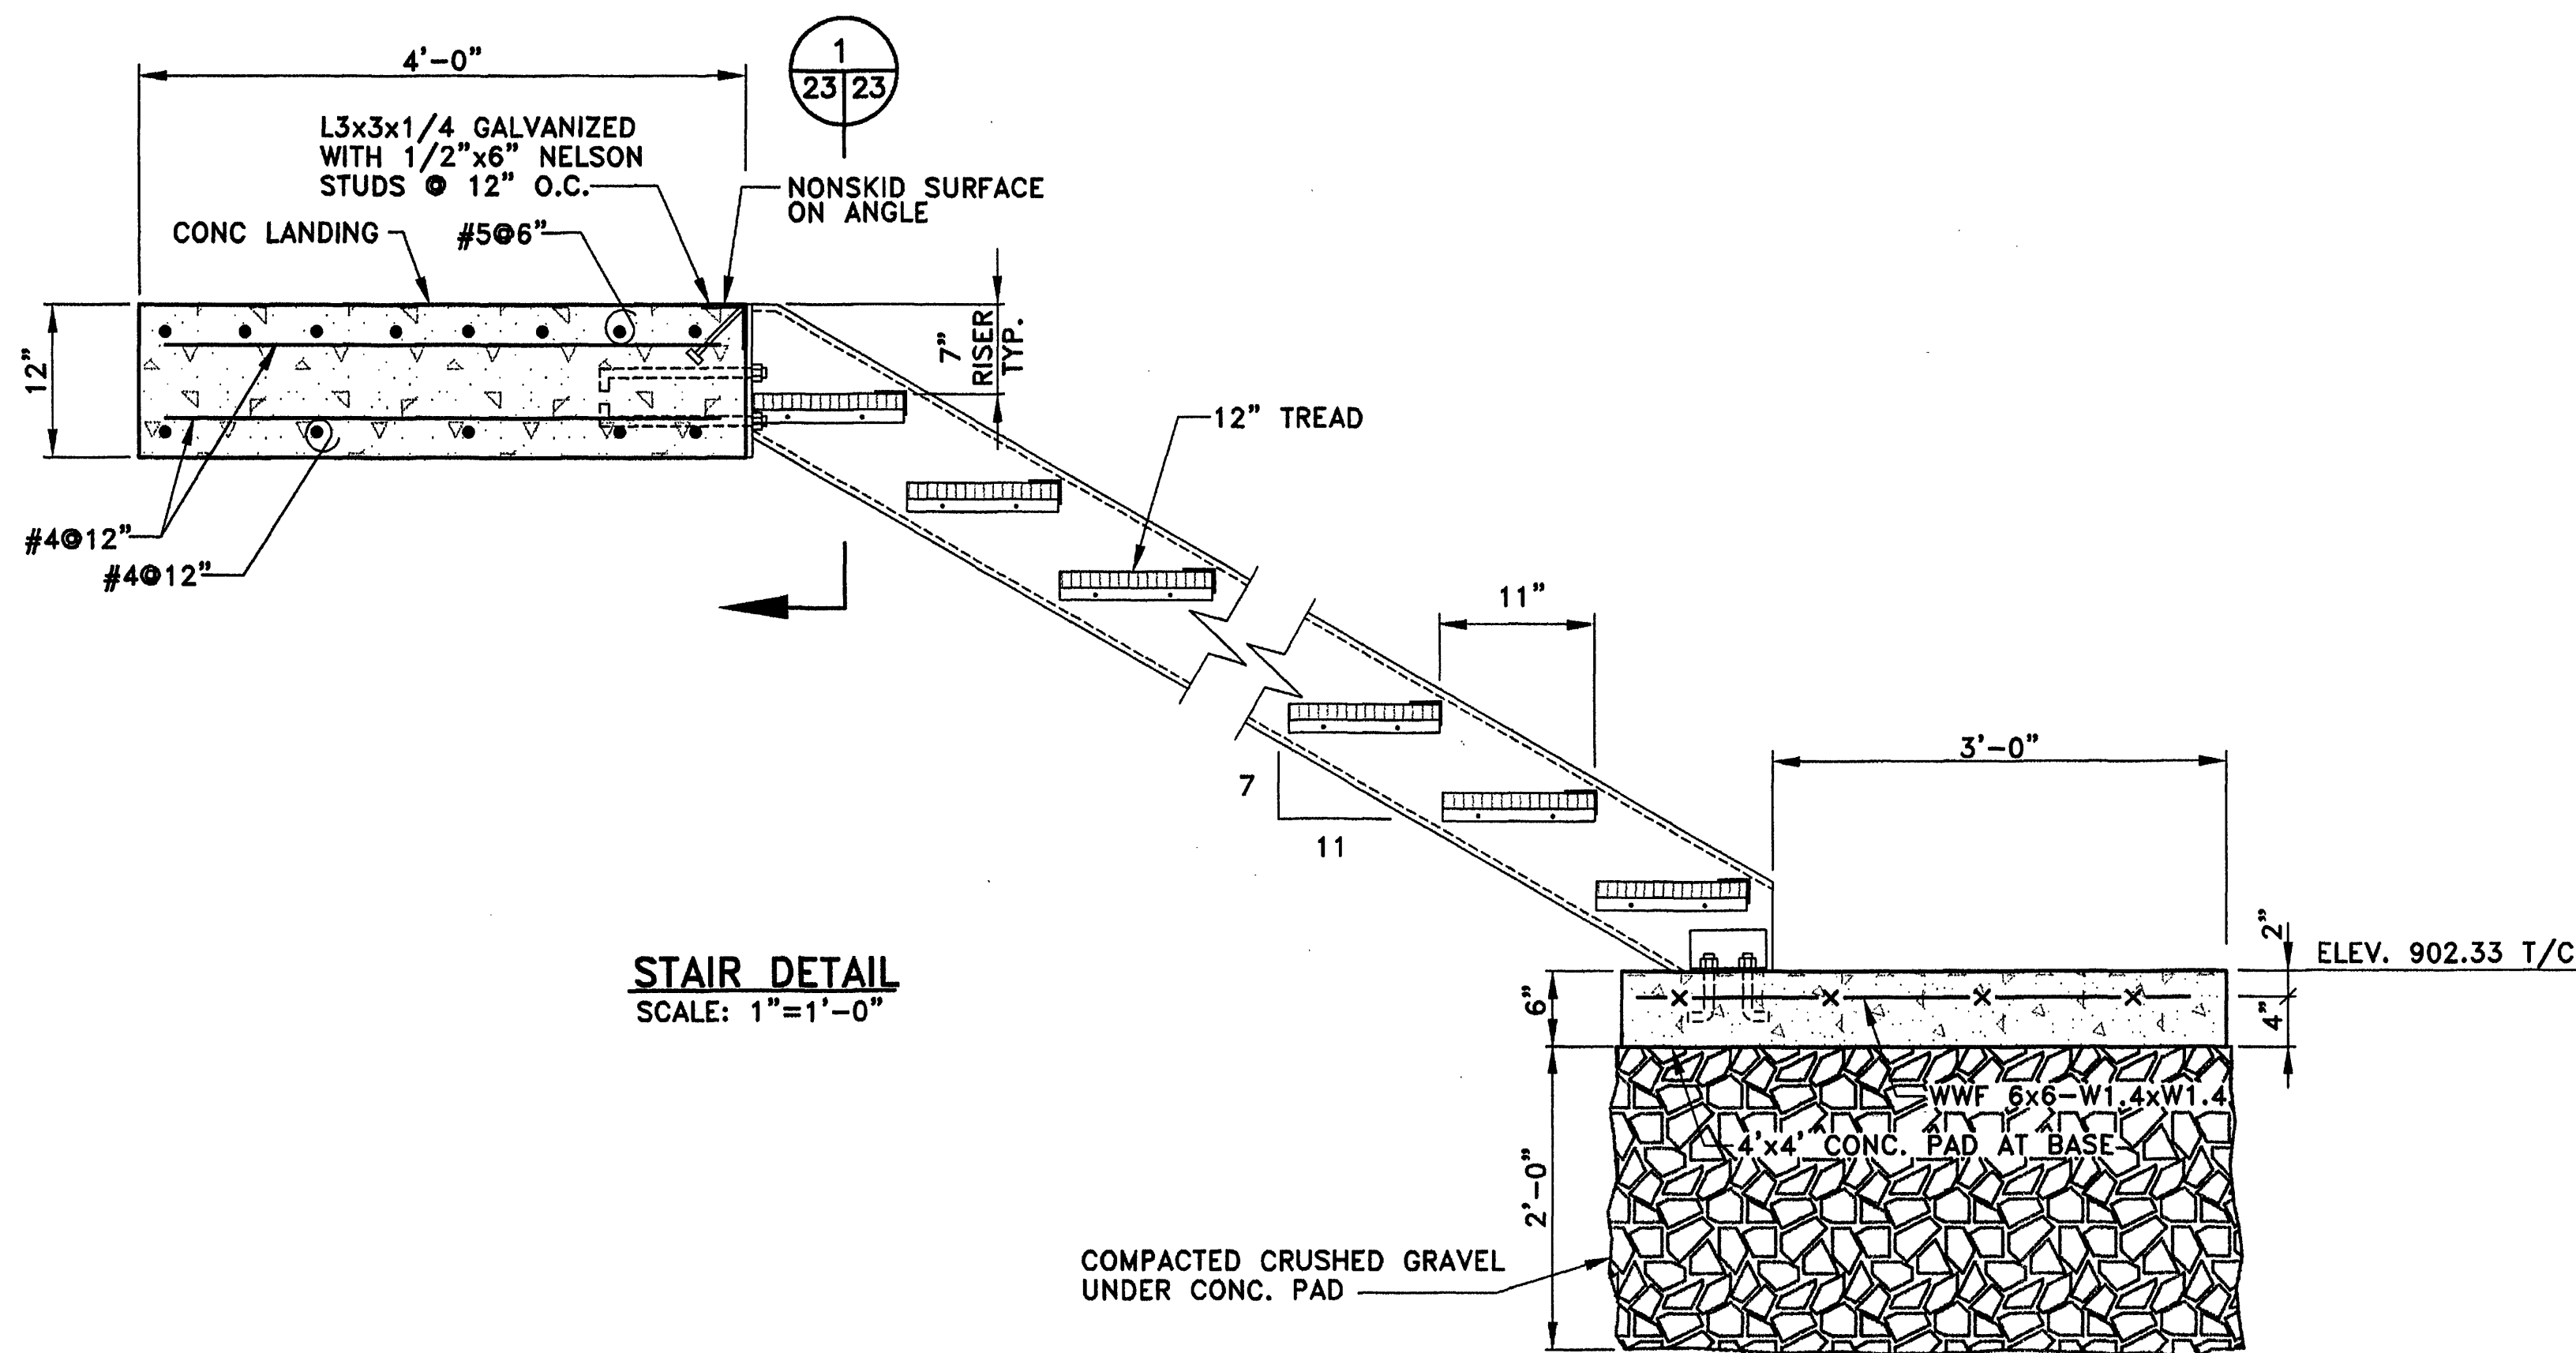


STAIR DETAIL
SCALE: 1"=1'-0"

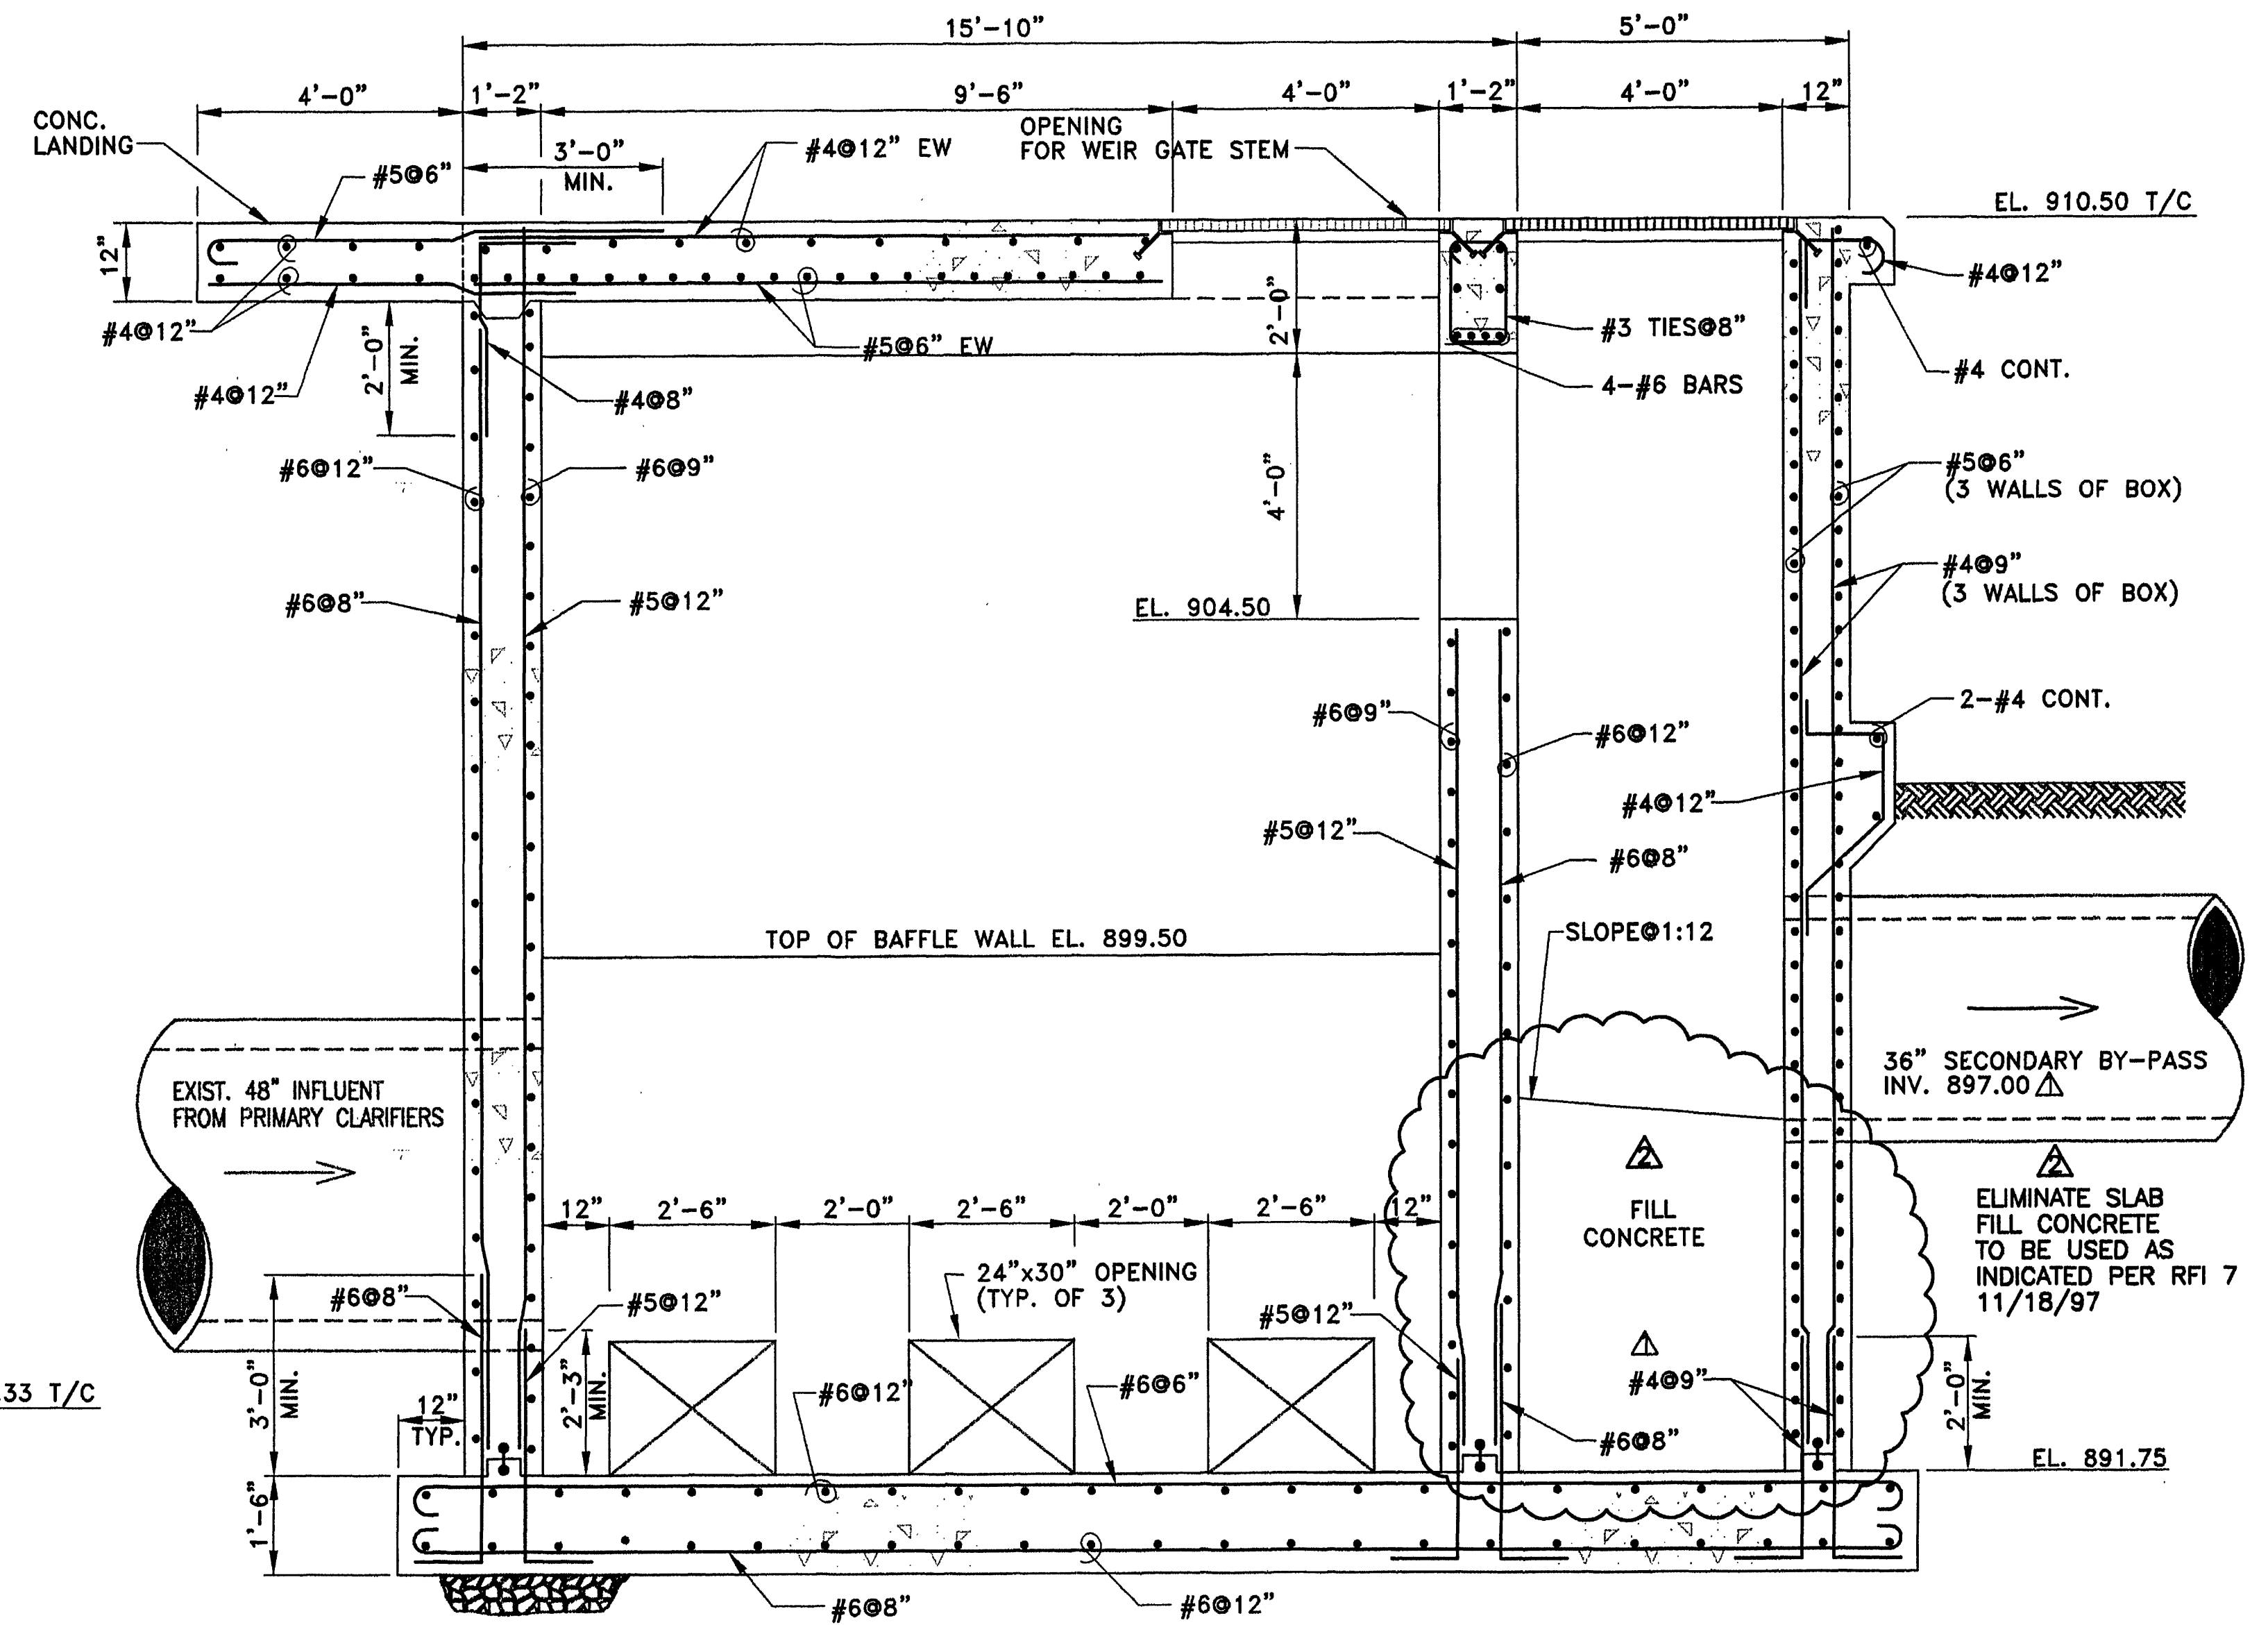

SECTION
SCALE: 1/2"=1'-0"

3
21/23

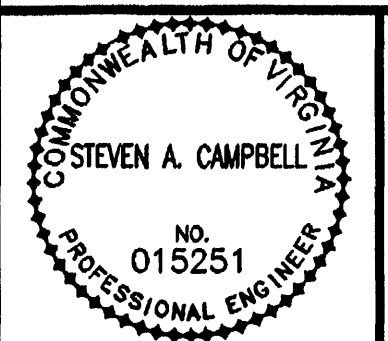

Mattern & Craig, Inc.
CONSULTING ENGINEERS - SURVEYORS
700 FIRST FLOOR, S.W.
ROANOKE, VIRGINIA 24006
804-546-0944
804-546-7061 FAX

NO.	BY	DATE	REVISIONS	REMARKS
1	SWH	2/25/98	REVISE INVERT OF 36" PIPE	
2	SWH	JAN. 2000	RECORD DRAWING	

DES: NAB,GPH
DWN: ARB,LDL
CKD: GPH,SAC



CITY OF ROANOKE, VIRGINIA,
WATER POLLUTION
CONTROL PLANT
UPGRADE AND EXPANSION

BAF INFLUENT PUMP STATION

MISCELLANEOUS DETAILS
SCALE: AS SHOWN

DATE: MAY, 1997
SHEET 23 OF 44
CAD REF. NO. S23.DWG