
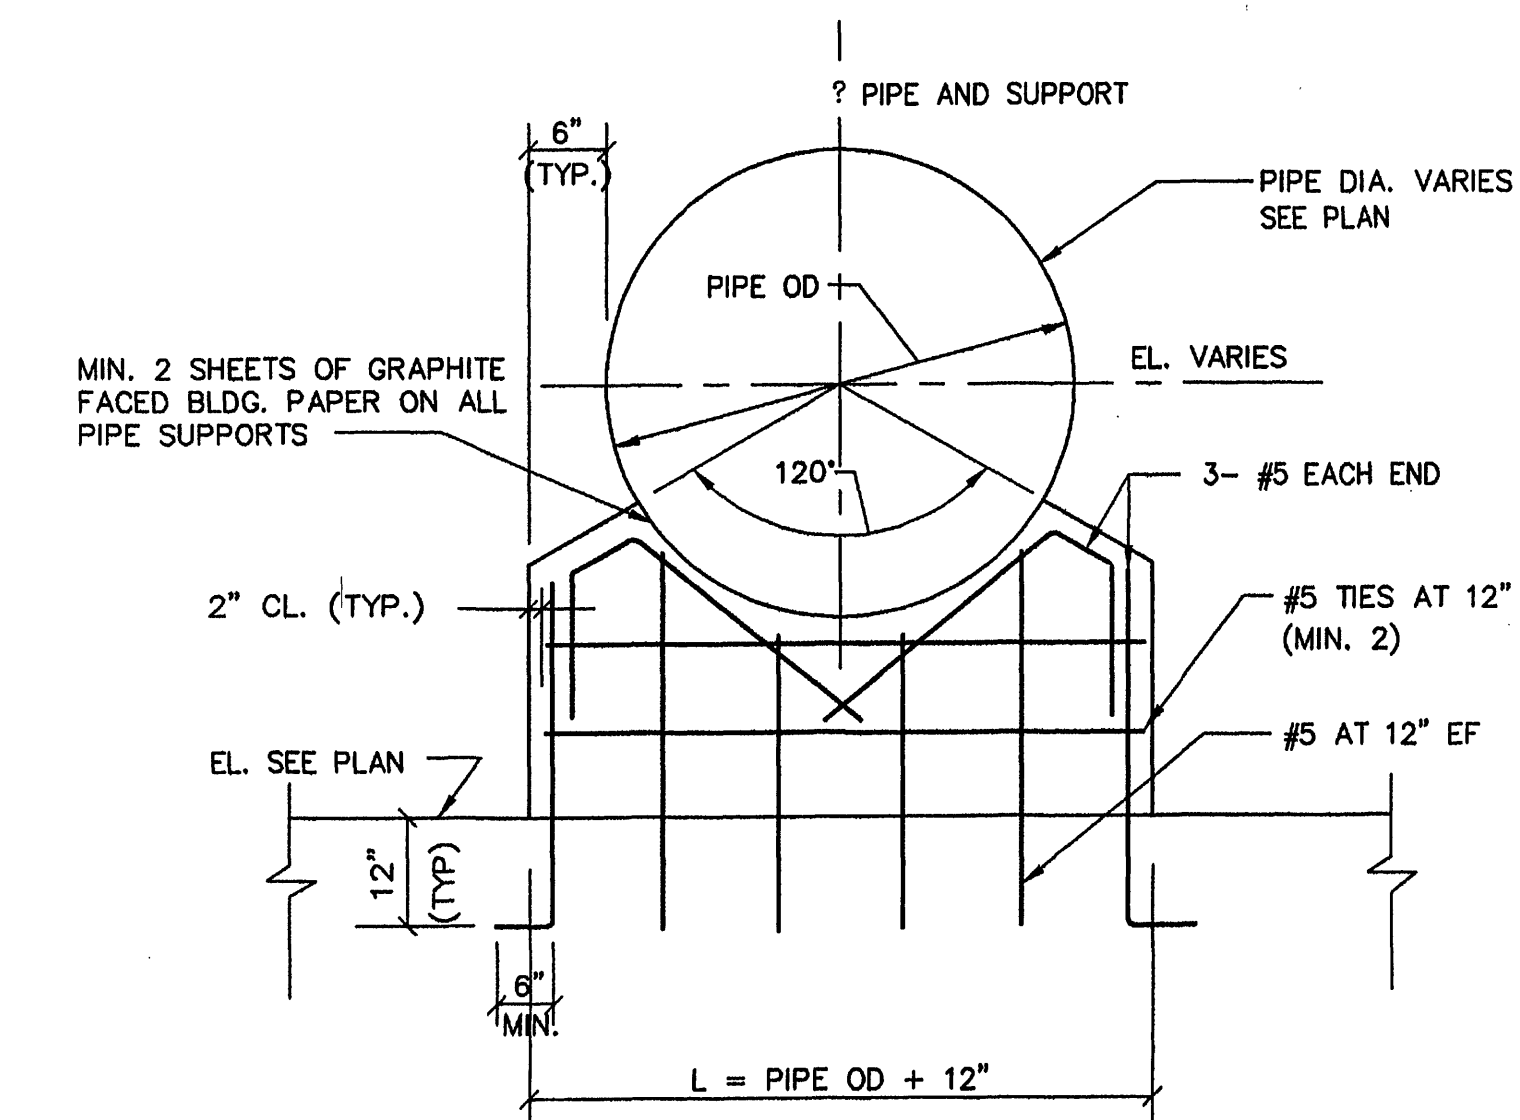
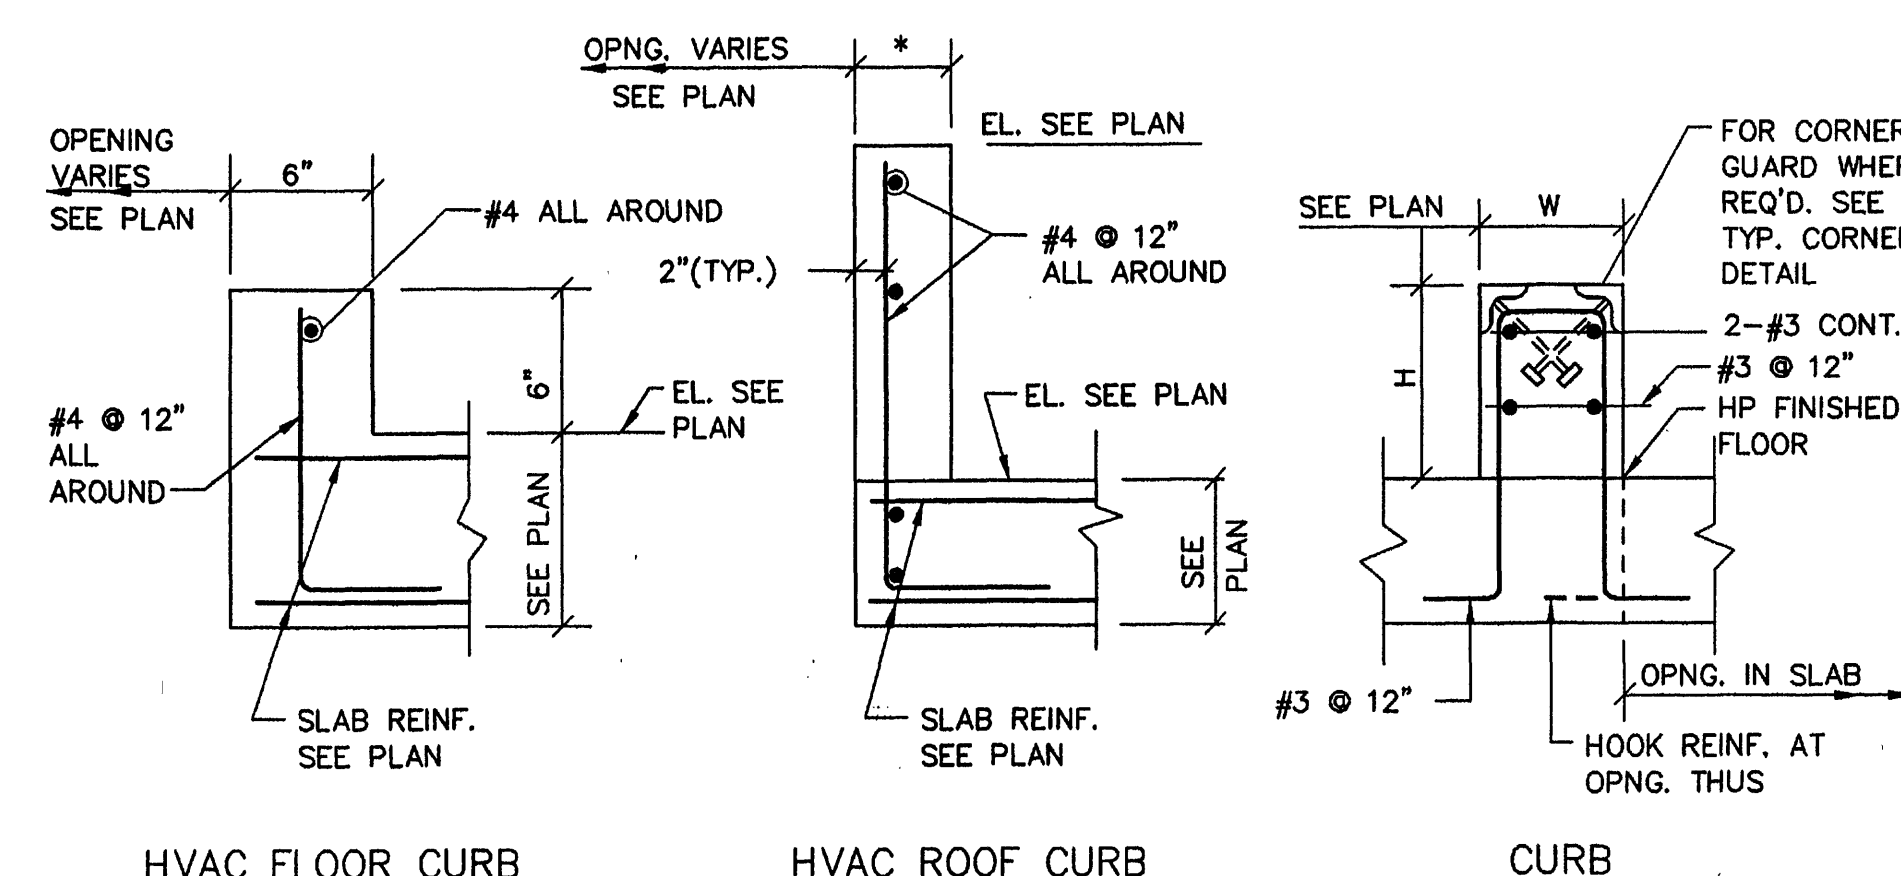
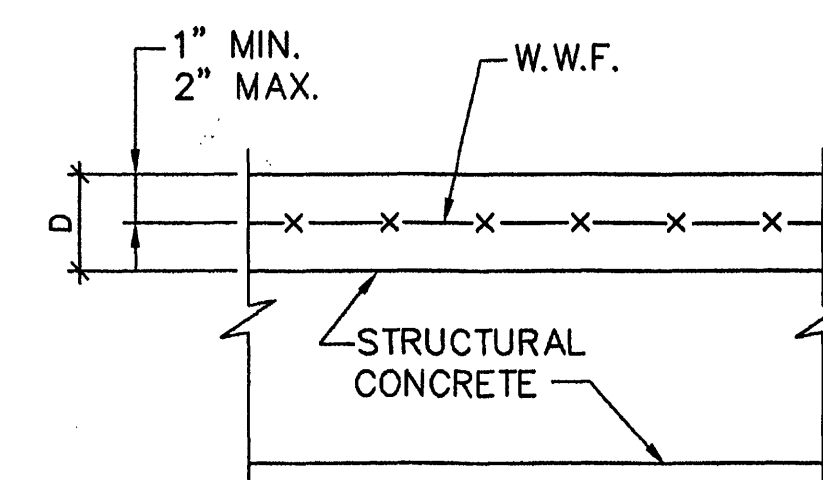
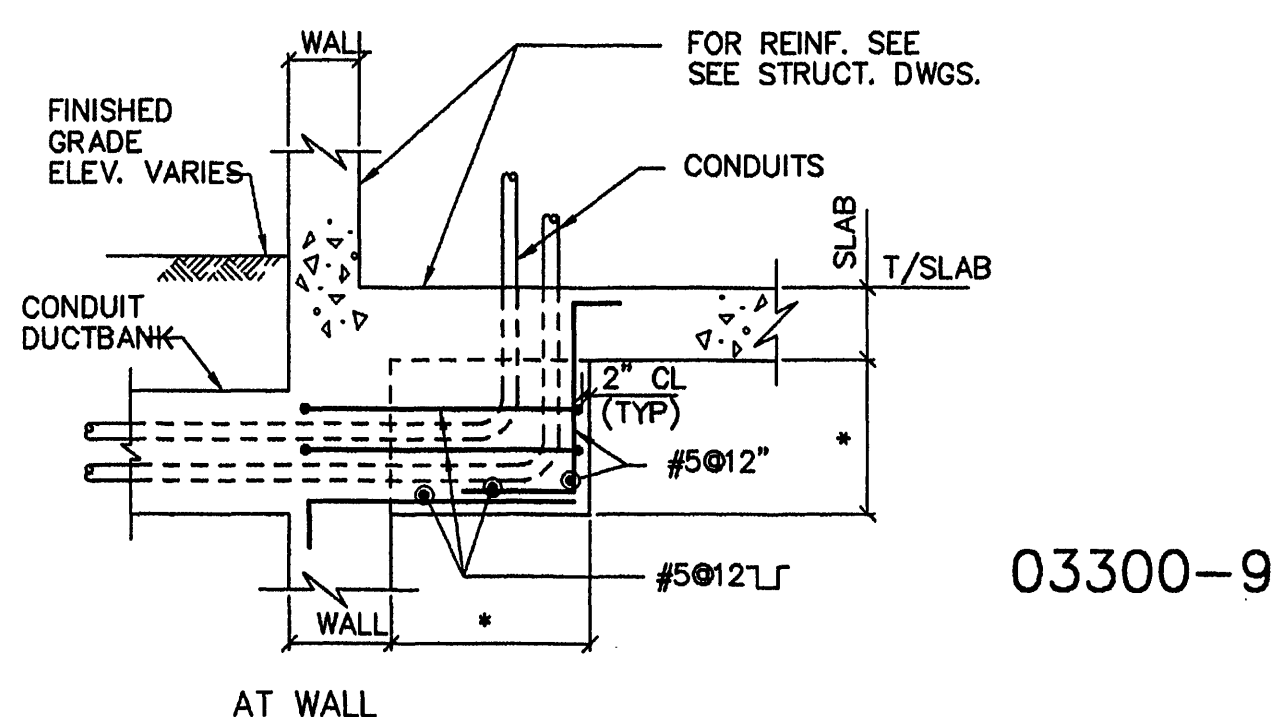
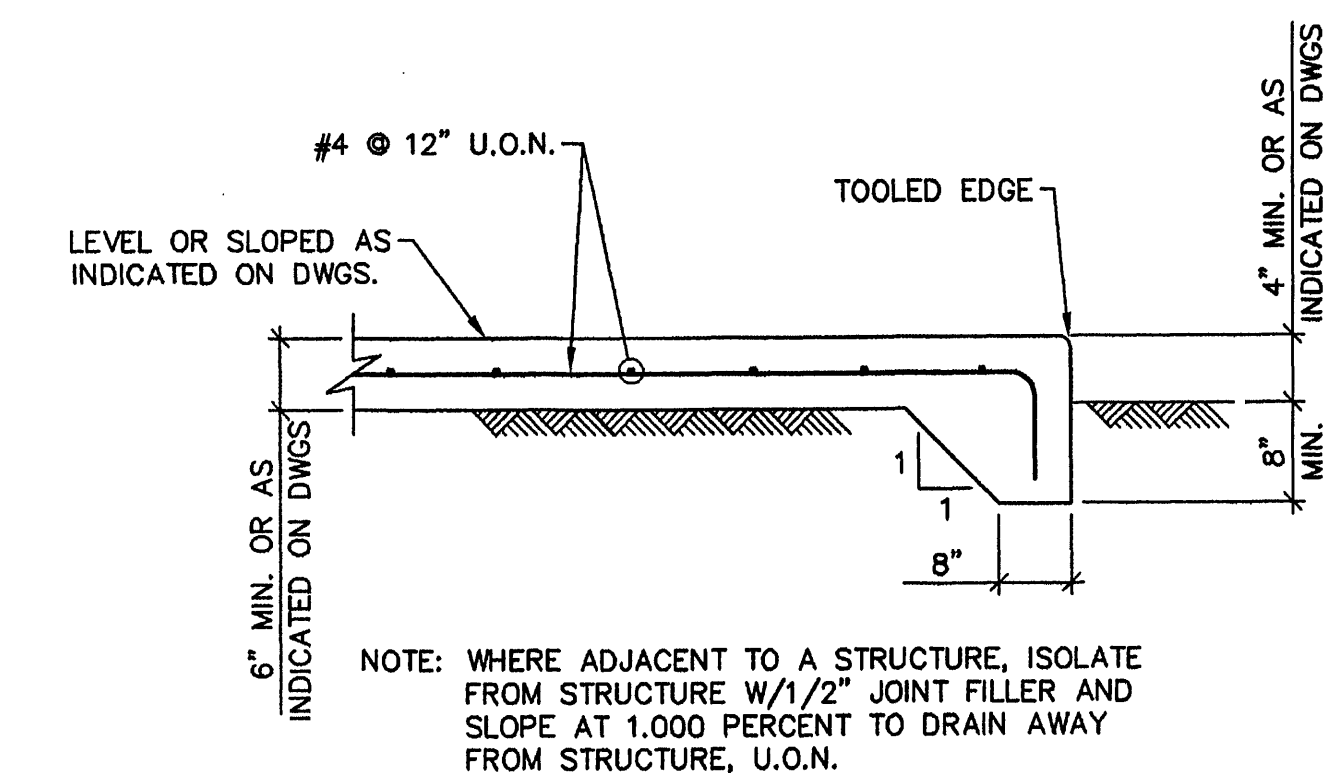
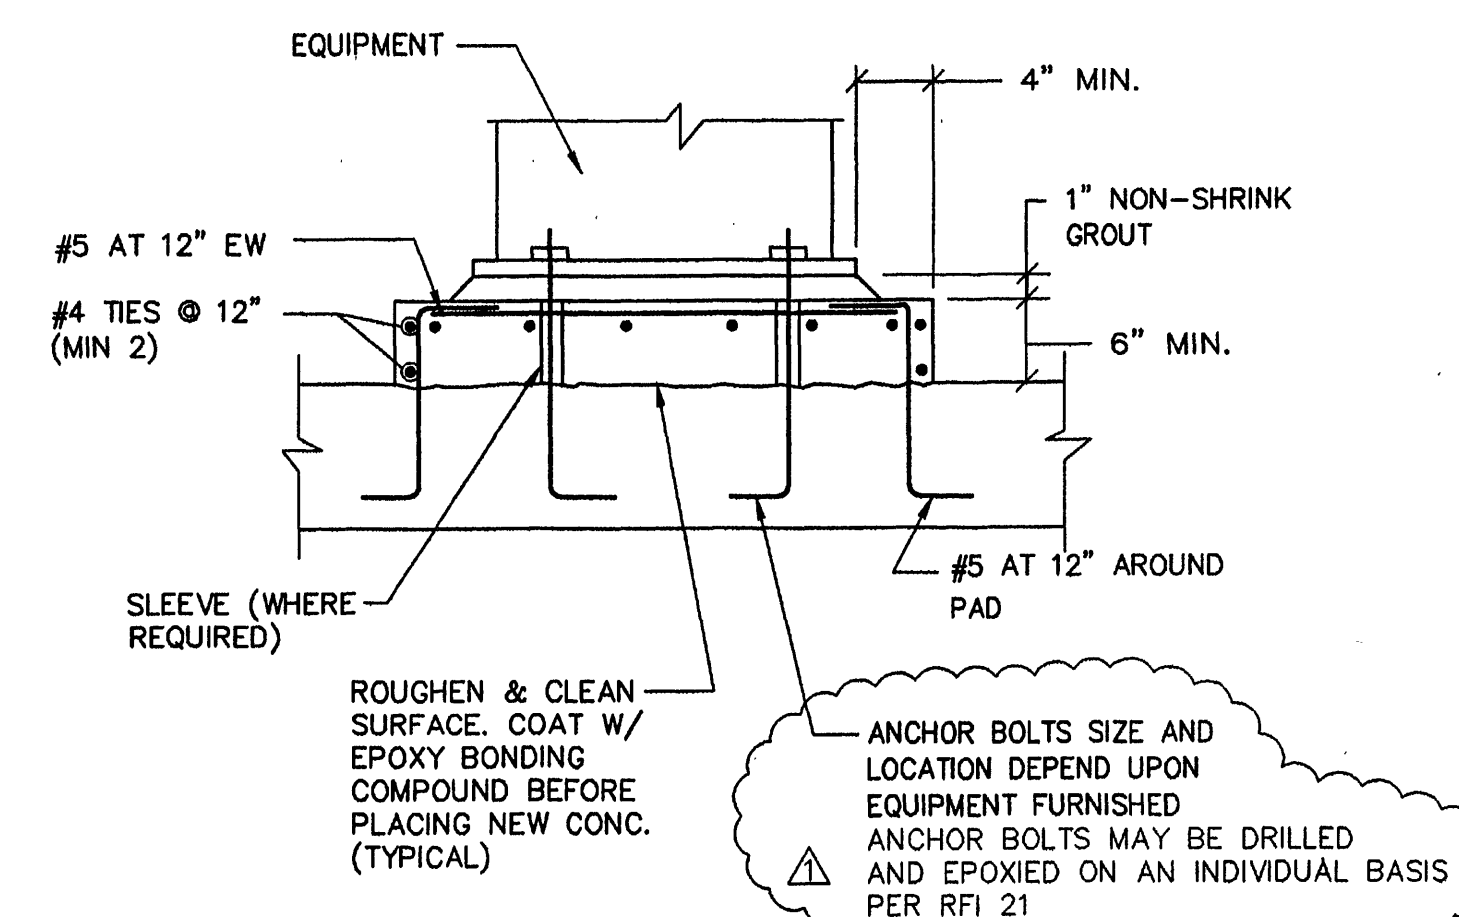
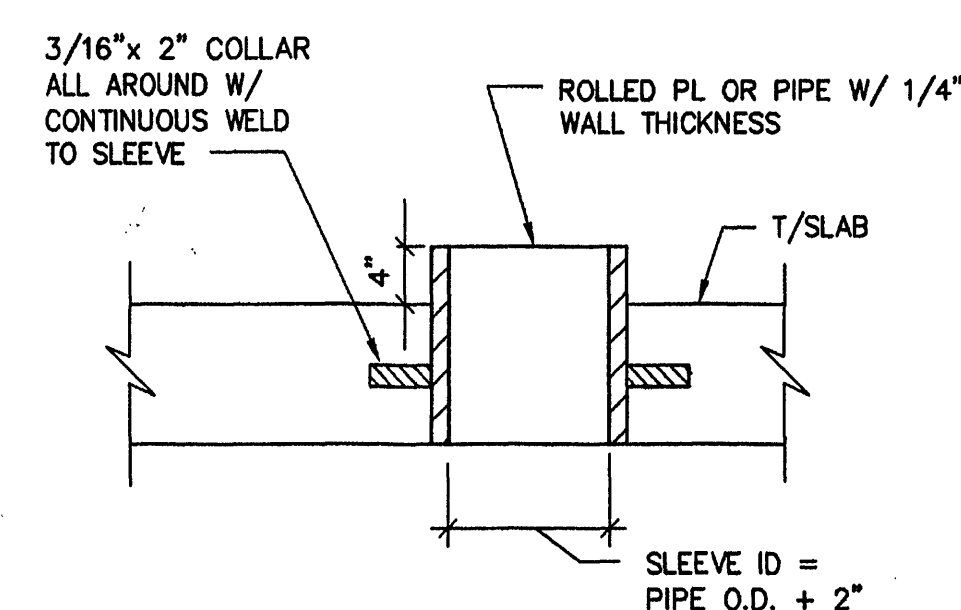
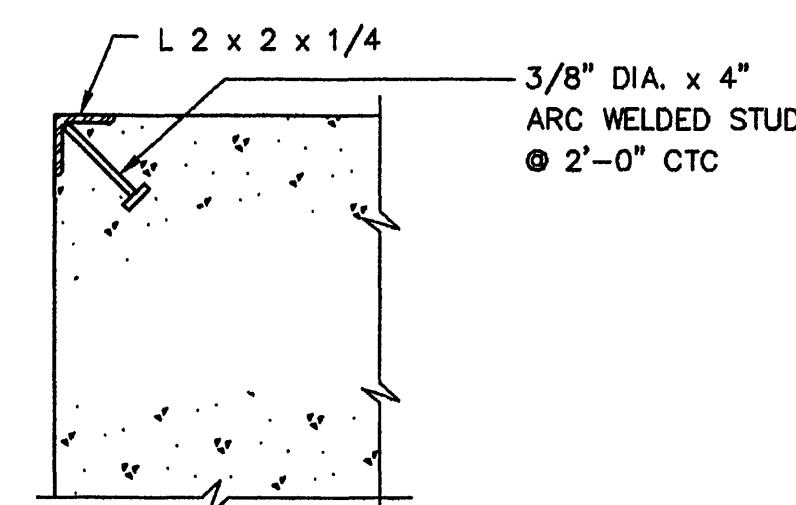
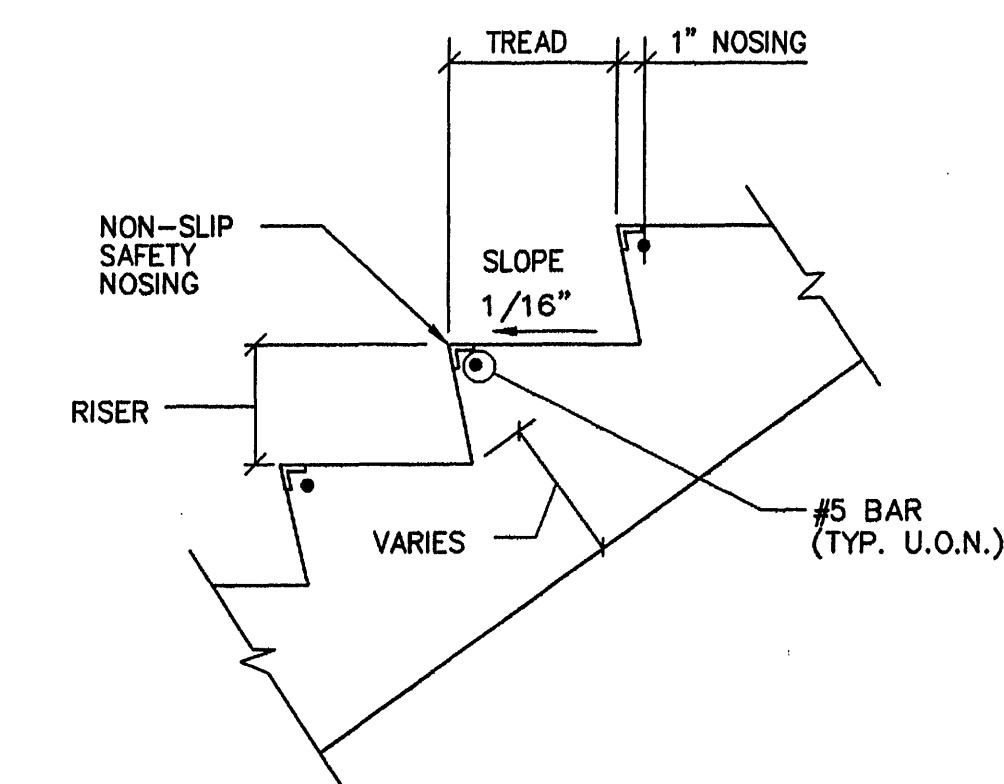
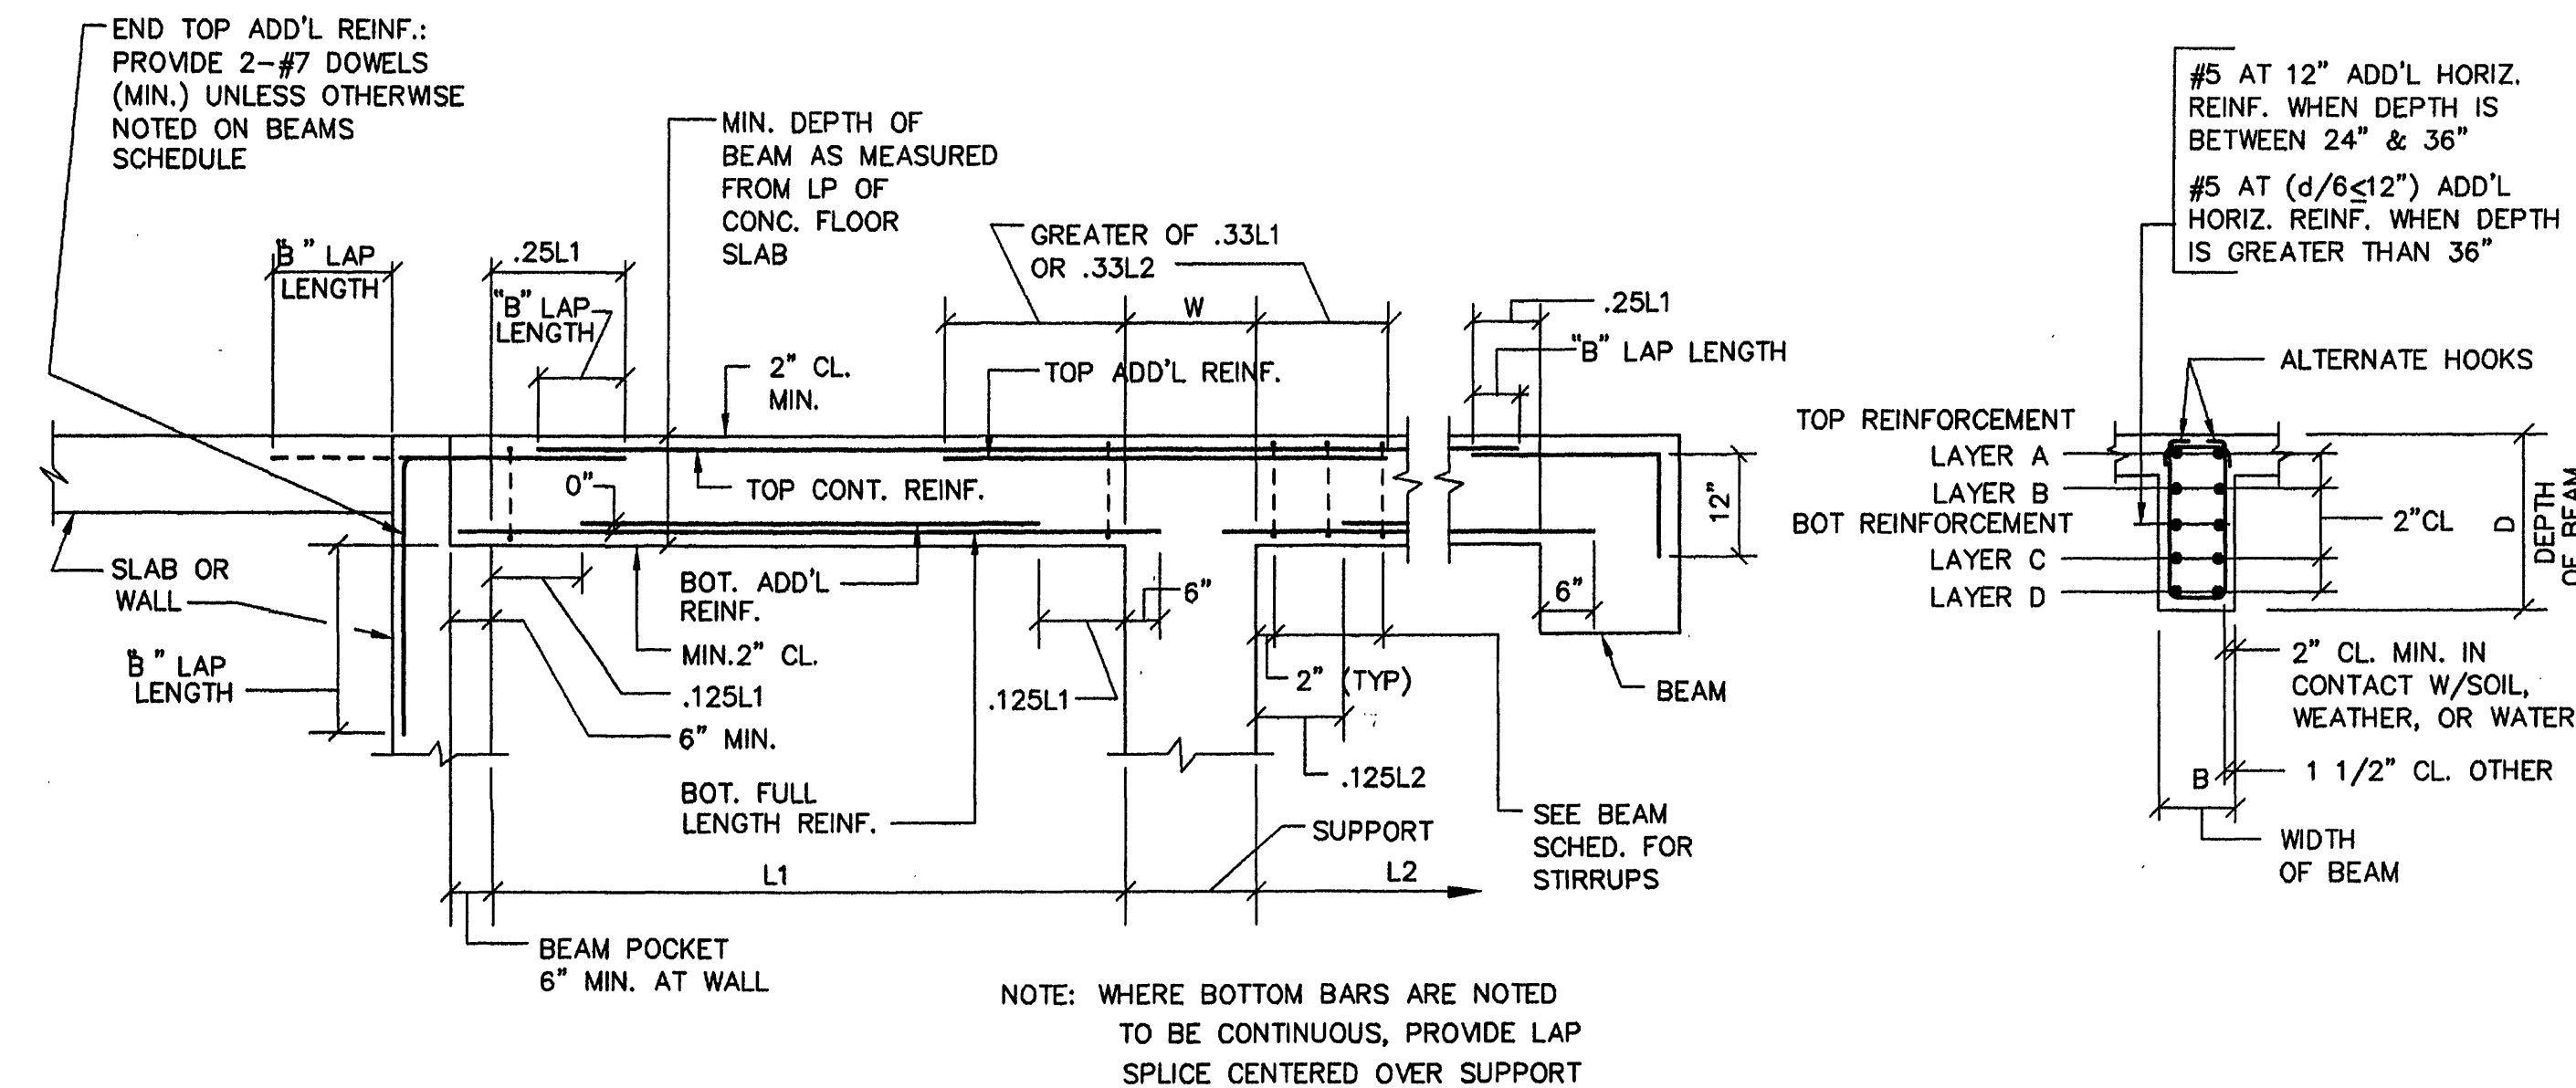


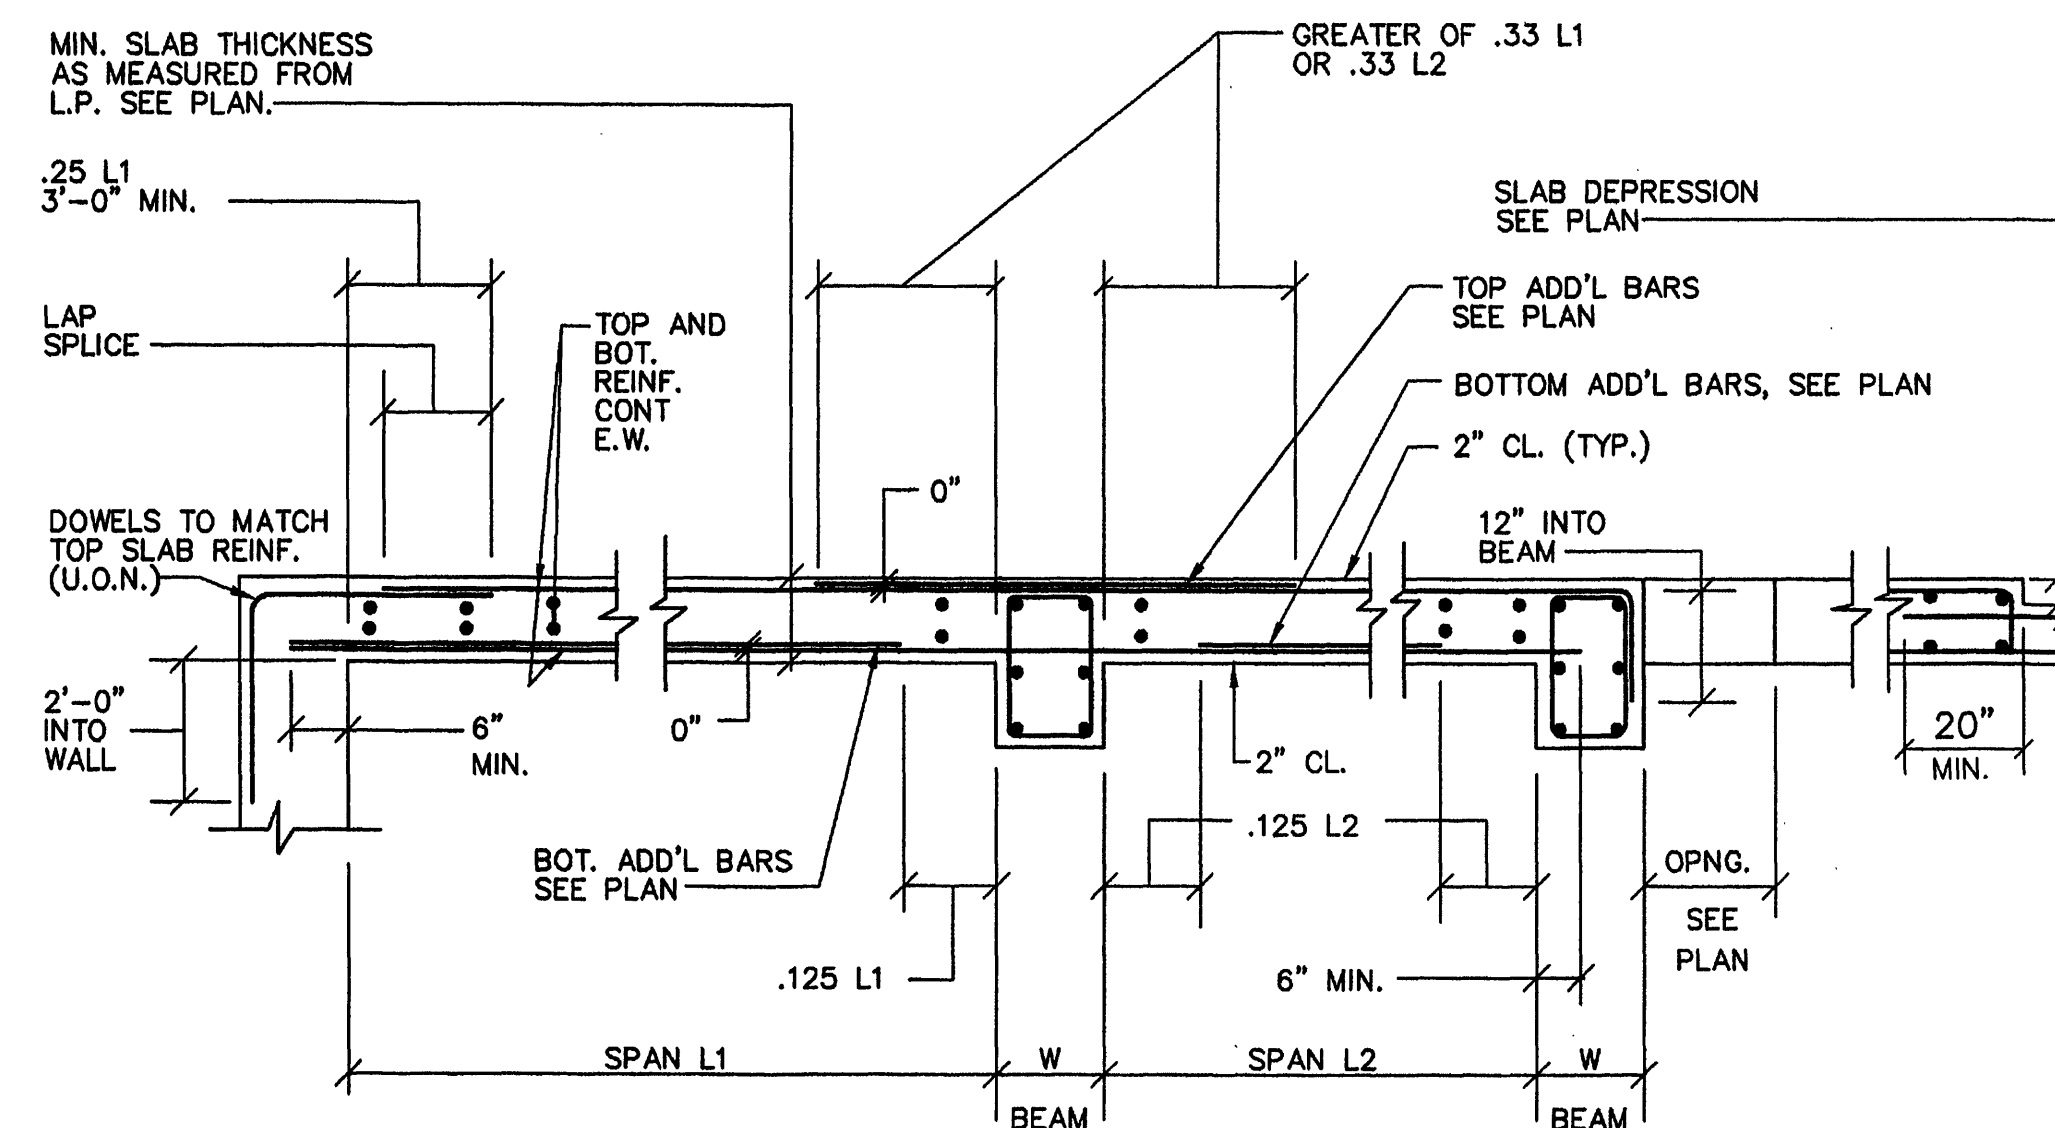

D	W.W.F.
2" TO 4"	6x6 - W 1.4 x W 1.4
5" TO 8"	6x6 - W 2.0 x W 2.0
9" PLUS	6x6 - W 2.9 x W 2.9